



CONSTRUCTION SUMMARY

Lot: 110

Model: 50.05 B KNIGHTSWOOD

Project/Phase: Pine Valley Forevergreen / 1

CONCRETE AND DRAIN

Invoice	Qty.	Description
2232 31700 23Mar20 NoCat	1	BACK-FLOW PREVENTER VALVE

FORMING

Invoice	Qty.	Description
2232 31702 23Mar20 NoCat	1	OPTIONAL SERVICE STAIRS TO BASEMENT

MISC.

Invoice	Qty.	Description
2232 31703 23Mar20 NoCat	1	

WINDOWS - BASEMENT

Invoice	Qty.	Description
2232 31701 23Mar20	4	BASEMENT WINDOWS - UPGRADE BASEMENT WINDOW SIZE TO 30 " X 24" - 10" FRAME (PINEVALLEY 50 FOOT LOTS ONLY)

This Document is Extremely Time Sensitive - Printed 23 Mar 20 at 10:22

SCHEDULE 'F'




PV-110
MAR 26 2020

The Knightswood 50' SERIES

Elevation A • 4,445 sq.ft.
4,475 sq.ft. Opt. Elevator / 4,575 sq.ft. Opt. Service Stairs
Elevation B • 4,440 sq.ft.
4,475 sq.ft. Opt. Elevator / 4,575 sq.ft. Opt. Service Stairs
Elevation C • 4,525 sq.ft.
4,560 sq.ft. Opt. Elevator / 4,660 sq.ft. Opt. Service Stairs

BACK FLOW PREVENTER VALVE

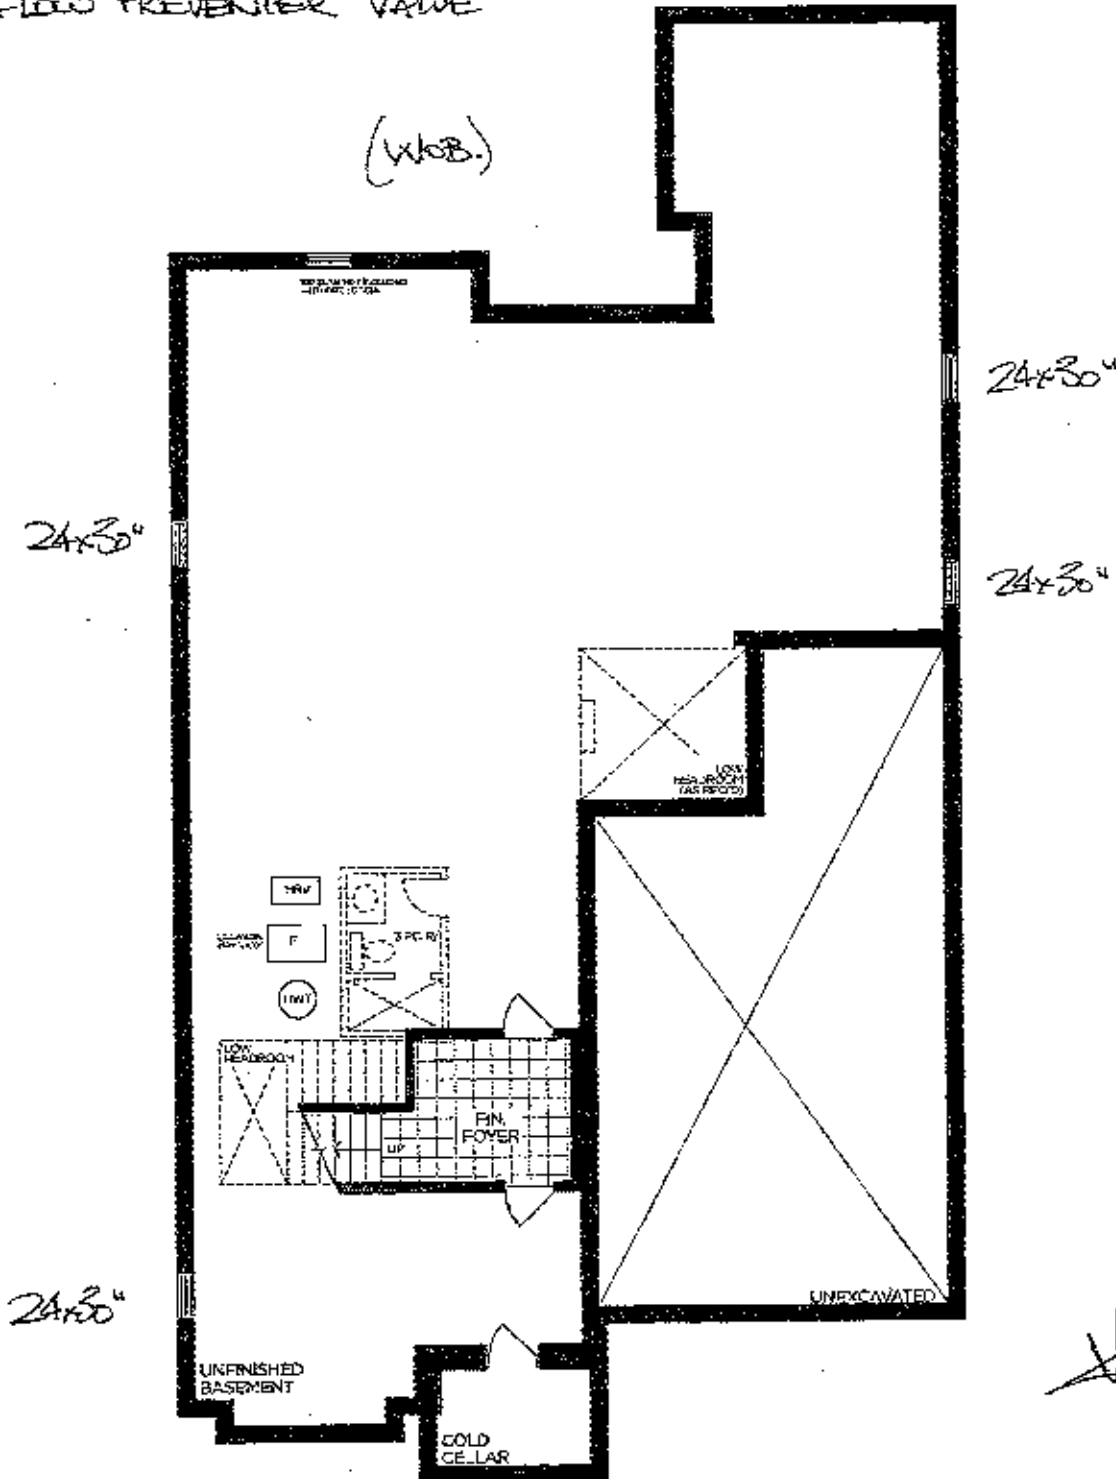

BASEMENT | ELEV. A

VENDOR

PURCHASER

PURCHASER

GOLDPARK
WORTH MORE™

Prices, figures, illustrations, sizes, features and finishes are subject to change without notice. Areas and dimensions are approximate and actual usable floor space may vary from the stated area. Layout may be reverse of the unit purchased. E. & O.E. 5005


SCHEDULE 'F'



PV-110
March 20 2020

The Knightswood 50' SERIES


Elevation A • 4,445 sq.ft.
4,475 sq.ft. Opt. Elevator / 4,575 sq.ft. Opt. Service Stairs
→ Elevation B • 4,440 sq.ft.
4,475 sq.ft. Opt. Elevator / 4,575 sq.ft. Opt. Service Stairs
Elevation C • 4,525 sq.ft.
4,560 sq.ft. Opt. Elevator / 4,660 sq.ft. Opt. Service Stairs

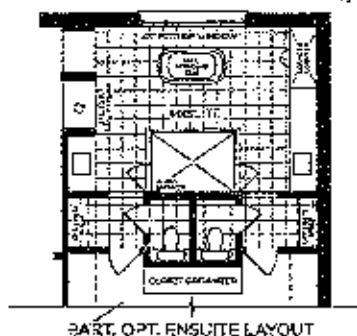


PART. OPT. ENSUITE LAYOUT




PART. OPT. WET BAR SITTING AREA

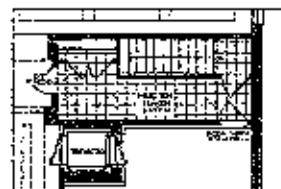


OPT. PART. GROUND FLOOR SERVICE STAIR W/ ELEVATOR | ELEV.

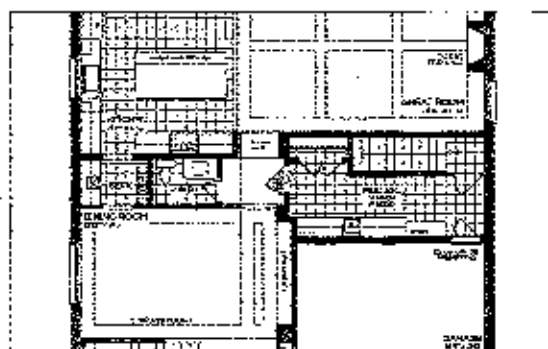


OPT. PART. GROUND FLOOR W/ SERVICE STAIR | ELEV.A

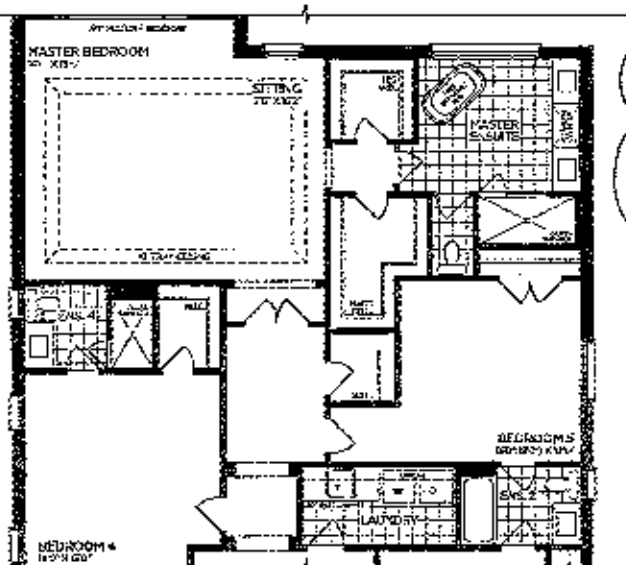


PART. OPT. SECOND FLOOR | ELEV. A (5 BEDROOMS)

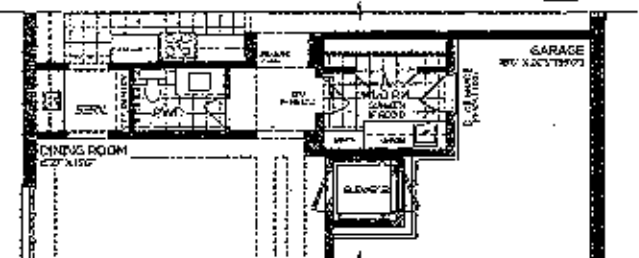

PART. OPT. GROUND FLOOR | ELEV. A (ELEVATOR)

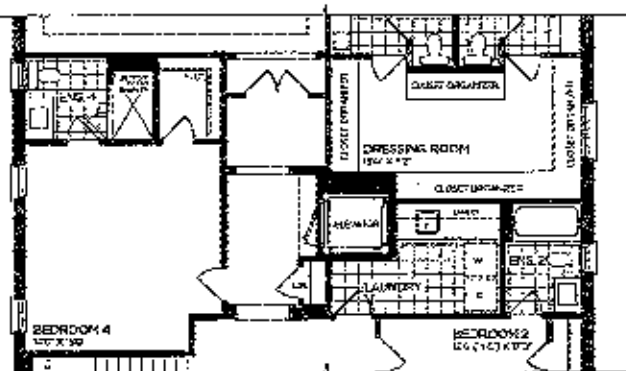

PART. OPT. SECOND FLOOR | ELEV. A (ELEVATOR)

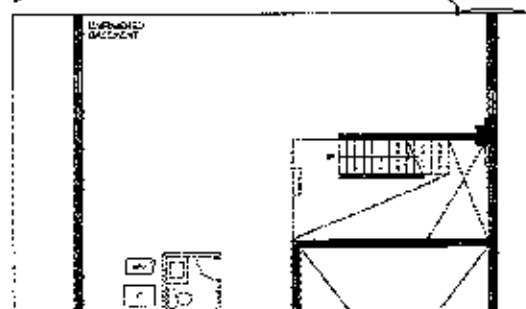

OPT. PART. BASEMENT W/ SERVICE STAIR | ELEV. A

GOLDPARK
WORTH MORE™

VENDOR
PURCHASER
PURCHASER

Prices, figures, illustrations, sizes, features and finishes are subject to change without notice. Areas and dimensions are approximate and actual usable floor space may vary from the stated area. Layout may be reverse of the unit purchased. E. & O.E. 5005


SCHEDULE 'F'



PV-110
March 26 2020

The Knightswood 50' SERIES

Elevation A • 4,445 sq.ft.
4,475 sq.ft. Opt. Elevator / 4,575 sq.ft. Opt. Service Stairs
Elevation B • 4,440 sq.ft.
4,475 sq.ft. Opt. Elevator / 4,575 sq.ft. Opt. Service Stairs
Elevation C • 4,525 sq.ft.
4,560 sq.ft. Opt. Elevator / 4,660 sq.ft. Opt. Service Stairs

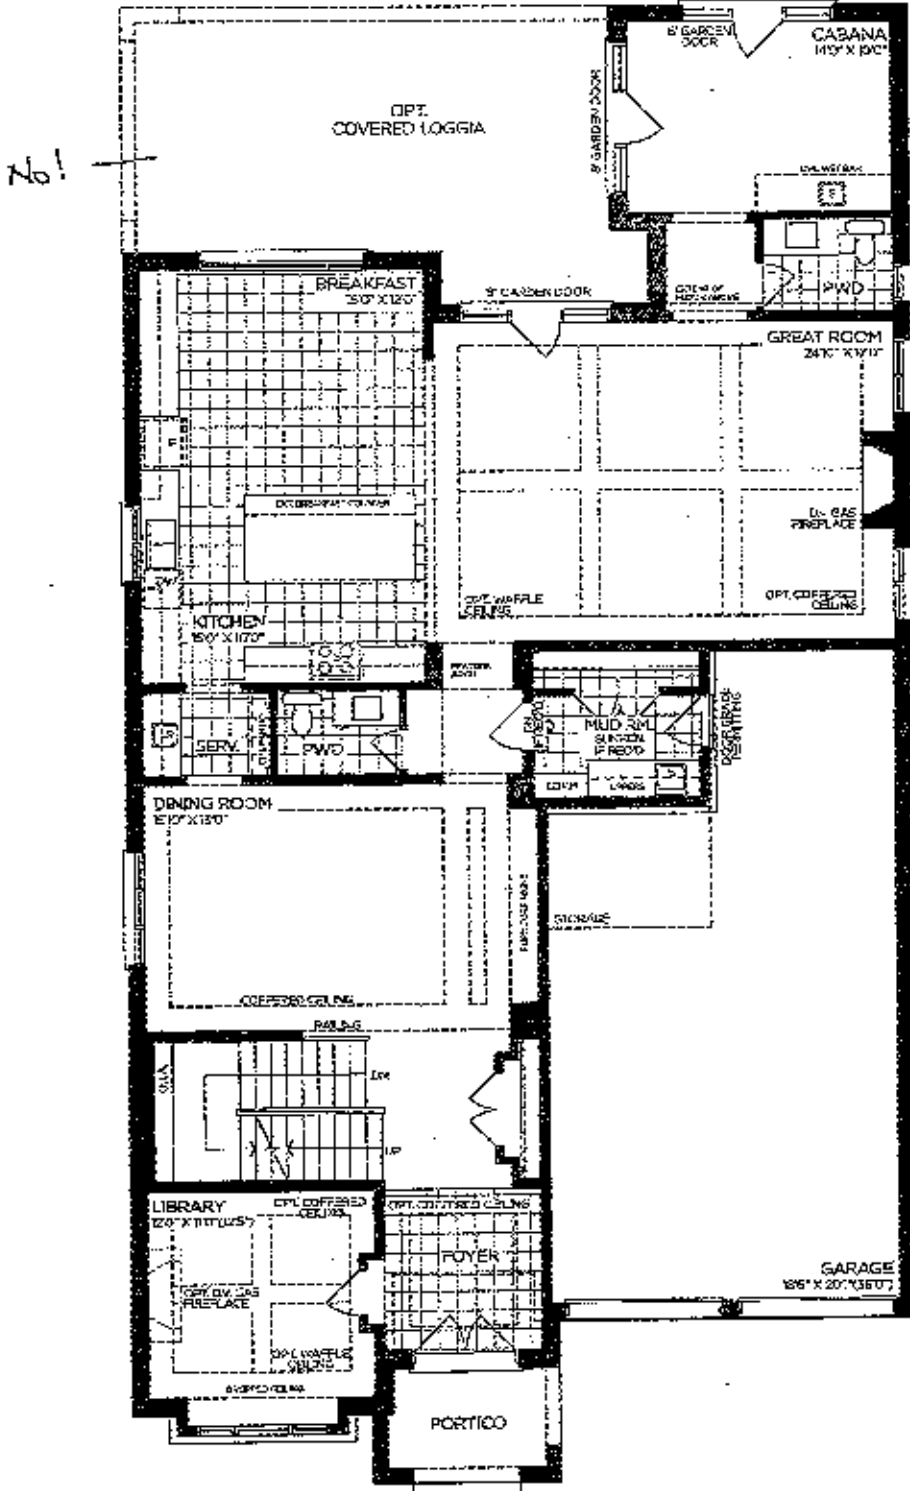

GROUND FLOOR | ELEV. A

VENDOR

PURCHASER

PURCHASER


GOLDPARK
WORTH MORE™

Prices, figures, illustrations, sizes, features and finishes are subject to change without notice. Areas and dimensions are approximate and actual usable floor space may vary from the stated area. Layout may be reverse of the unit purchased. E. & O.E. 5305

PINE VALLEY
FOOTVILLAGE

PV-110
MAR 20 2020

4,560 sq.ft. Opt. Elevator / 4,660 sq.ft. Opt. Service Stairs

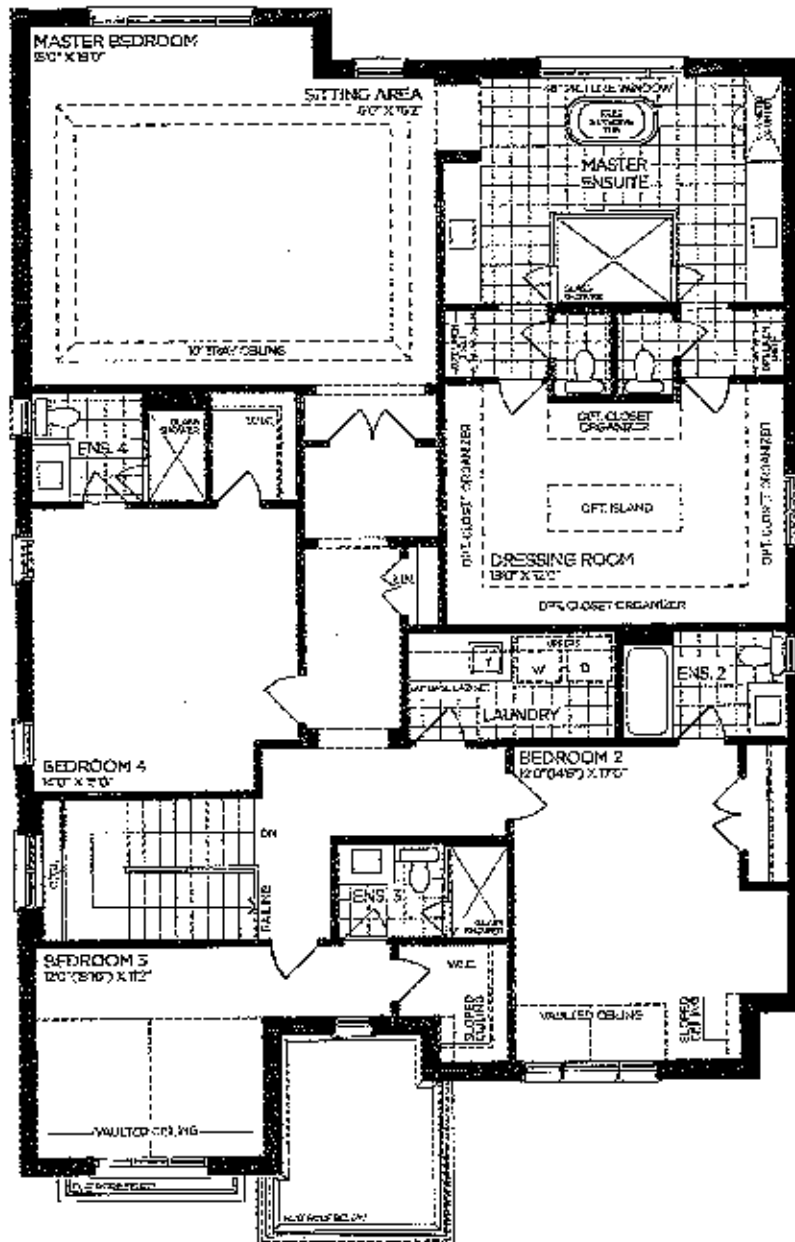

SECOND FLOOR [ELEV. A

~~Handwritten signature~~

VENDOR _____
PURCHASER _____
PURCHASER _____

GOLD PARK
WORTH MORE™

Prices, figures, illustrations, sizes, features and finishes are subject to change without notice. Areas and dimensions are approximate and actual usable floor space may vary from the stated area. Layout may be reverse of the unit purchased. E & O.E. 5005

SCHEDULE 'F'



TV-110

MAR 20 2020

The Knightswood 50' SERIES

Elevation A • 4,445 sq.ft.


4,475 sq.ft. Opt. Elevator / 4,575 sq.ft. Opt. Service Stairs

→ Elevation B • 4,440 sq.ft.


4,475 sq.ft. Opt. Elevator / 4,575 sq.ft. Opt. Service Stairs

Elevation C • 4,525 sq.ft.


4,560 sq.ft. Opt. Elevator / 4,660 sq.ft. Opt. Service Stairs

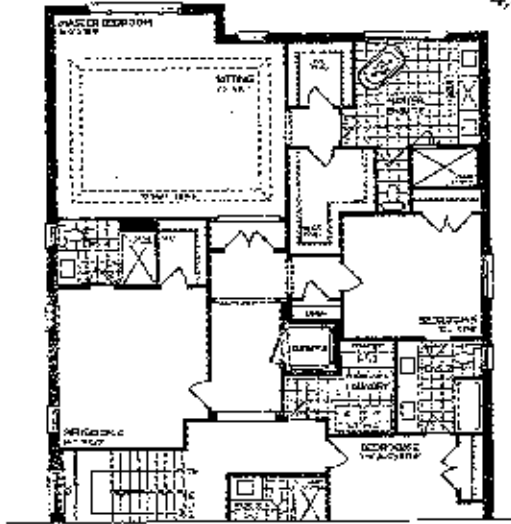


PART, 2ND FLOOR | ELEV. A (5 BEDROOMS - ELEVATOR)

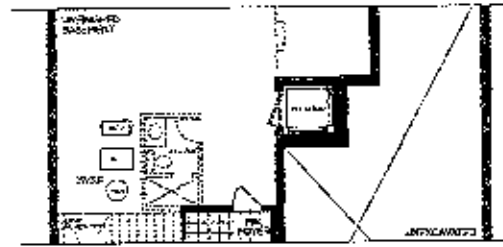

PART, OPT. BASEMENT | ELEV. A (ELEVATOR)

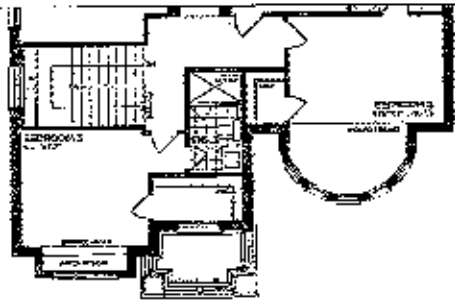


PART, SECOND FLOOR | ELEV. B

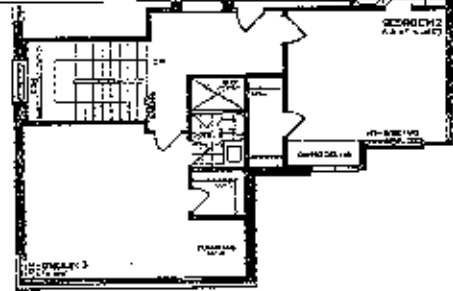


PART, SECOND FLOOR | ELEV. C




PART, GROUND FLOOR | ELEV. B

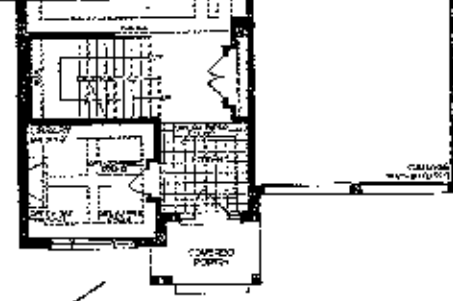

PART, GROUND FLOOR | ELEV. C

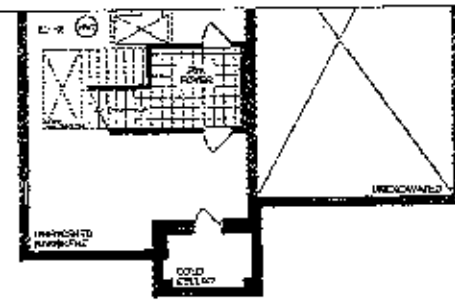

PART, EASEMENT | ELEV. B

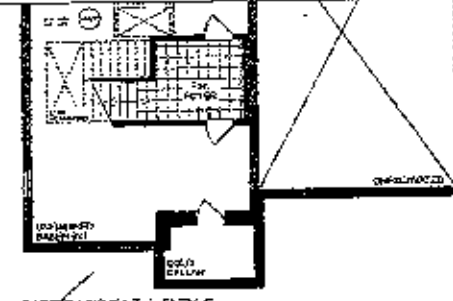

PART, BASEMENT | ELEV. C

VENDOR

PURCHASER

PURCHASER

GOLDPARK
WORTH MORE™

Prices, figures, illustrations, sizes, features and finishes are subject to change without notice. Areas and dimensions are approximate and actual usable floor space may vary from the stated area. Layout may be reverse of the unit purchased, E. & C.E. 5005