

CONCRETE AND DRAIN

Invoice Qty. Description

2236 31718 23Mar20 NoCat	1	BACK-FLOW PREVENTER VALVE
-----------------------------------	---	---------------------------

DRYWALL

Invoice Qty. Description

2236 31720 23Mar20 **	2	BASEMENT WINDOWS - UPGRADE BASEMENT WINDOW SIZE TO 30 " X 24" - 8" FRAME
--------------------------------	---	--

ELECTRICAL

Invoice Qty. Description

2236 31720 23Mar20 **	2	BASEMENT WINDOWS - UPGRADE BASEMENT WINDOW SIZE TO 30 " X 24" - 8" FRAME
--------------------------------	---	--

FORM - FORMING

Invoice Qty. Description

2236 31720 23Mar20 **	2	BASEMENT WINDOWS - UPGRADE BASEMENT WINDOW SIZE TO 30 " X 24" - 8" FRAME
--------------------------------	---	--

FORMING

Invoice Qty. Description

2236 31717 23Mar20	1	PINE VALLEY MODEL 42.03 FORESTCREST FLRV A - 9 FOOT BASEMENT CEILING HEIGHT IN LIEU OF STANDARD 8 FOOT CEILING.
--------------------------	---	---

INTERIOR TRIM /MOULDINGS

Invoice Qty. Description

2236 31720 23Mar20 **	2	BASEMENT WINDOWS - UPGRADE BASEMENT WINDOW SIZE TO 30 " X 24" - 8" FRAME
--------------------------------	---	--

MISC.

Invoice Qty. Description

2236 31719 23Mar20 NoCat	-	
-----------------------------------	---	--

PAINTING

Invoice Qty. Description

2236 31720 23Mar20 **	-	
--------------------------------	---	--



CONSTRUCTION SUMMARY

Lot: 100

Model: 42.03 A FORESTCREST

Project/Phase: Pine Valley Forevergreen / 1

PANL - FRAMING

Invoice	Qty.	Description
2236 31720 23Mar20 **	2	BASEMENT WINDOWS - UPGRADE BASEMENT WINDOW SIZE TO 30 " X 24" - 8" FRAME

ROUGH CARPENTRY

Invoice	Qty.	Description
2236 31720 23Mar20 **	2	BASEMENT WINDOWS - UPGRADE BASEMENT WINDOW SIZE TO 30 " X 24" - 8" FRAME

WINDOWS - BASEMENT

Invoice	Qty.	Description
2236 31720 23Mar20	2	BASEMENT WINDOWS - UPGRADE BASEMENT WINDOW SIZE TO 30 " X 24" - 8" FRAME
2236 31720 23Mar20	2	BASEMENT WINDOWS - UPGRADE BASEMENT WINDOW SIZE TO 30 " X 24" - 8" FRAME

This Document is Extremely Time Sensitive - Printed 23 Mar 20 at 11:18

SCHEDULE 'F'




PV-100
March 22 2020

see attach

The Forestcrest 42' SERIES

→ Elevation A - 3,800 sq.ft.
Elevation B - 3,785 sq.ft.
Elevation C - 3,800 sq.ft.

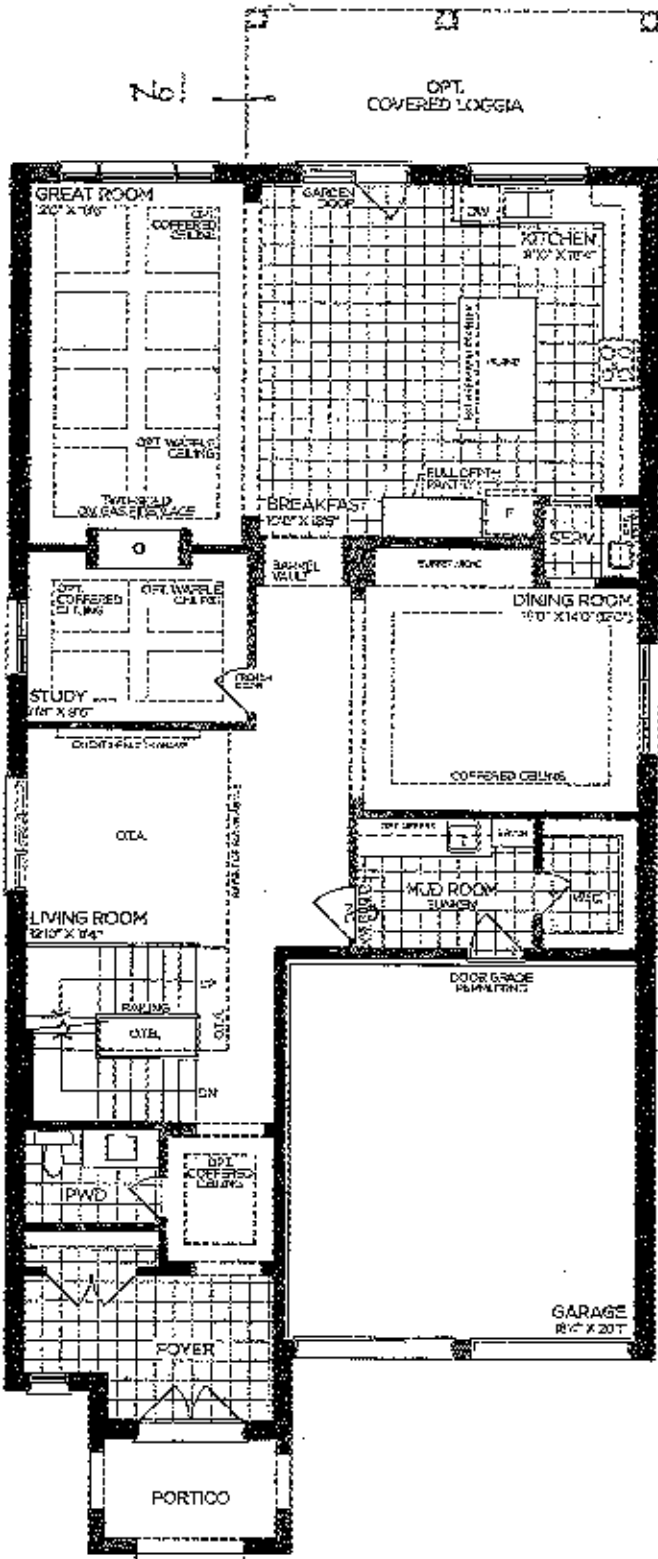

GROUND FLOOR | ELEV. A

Handwritten signature or initials.

VENDOR

PURCHASER

PURCHASER


GOLDPARK
WORTH MORE

Prices, figures, illustrations, sizes, features and finishes are subject to change without notice. Areas and dimensions are approximate and actual usable floor space may vary from the stated area. Layout may be reverse of the unit purchased. E. & O.E. 4203

PINE VALLEY
FOUNDED 1908

PV-100
MAR 22 2020

→ Elevation A = 3,800 sq.ft.
Elevation B = 3,785 sq.ft.
Elevation C = 3,800 sq.ft.

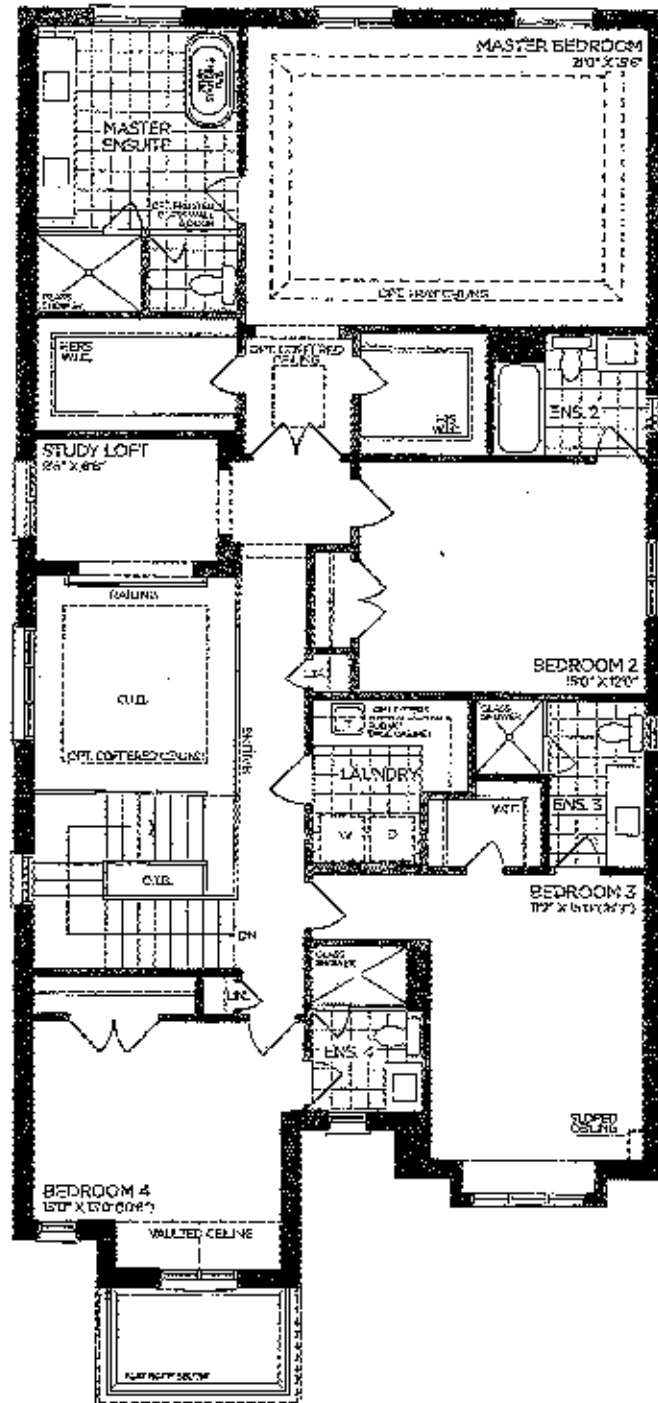

SECOND FLOOR | ELEV. A

PURCHASER

Prices, figures, illustrations, sizes, features and finishes are subject to change without notice. Areas and dimensions are approximate and actual usable floor space may vary from the stated area. Layout may be reverse of the unit purchased. E. & O.E. 4203

SCHEDULE 'F'



FV-100


MARCH 22 2020

The
Forestcrest
42' SERIES

→ Elevation A • 3,800 sq.ft.
Elevation B • 3,785 sq.ft.
Elevation C • 3,800 sq.ft.

Back Flow
Preventer Valve

9' CEILING
in BASEMENT

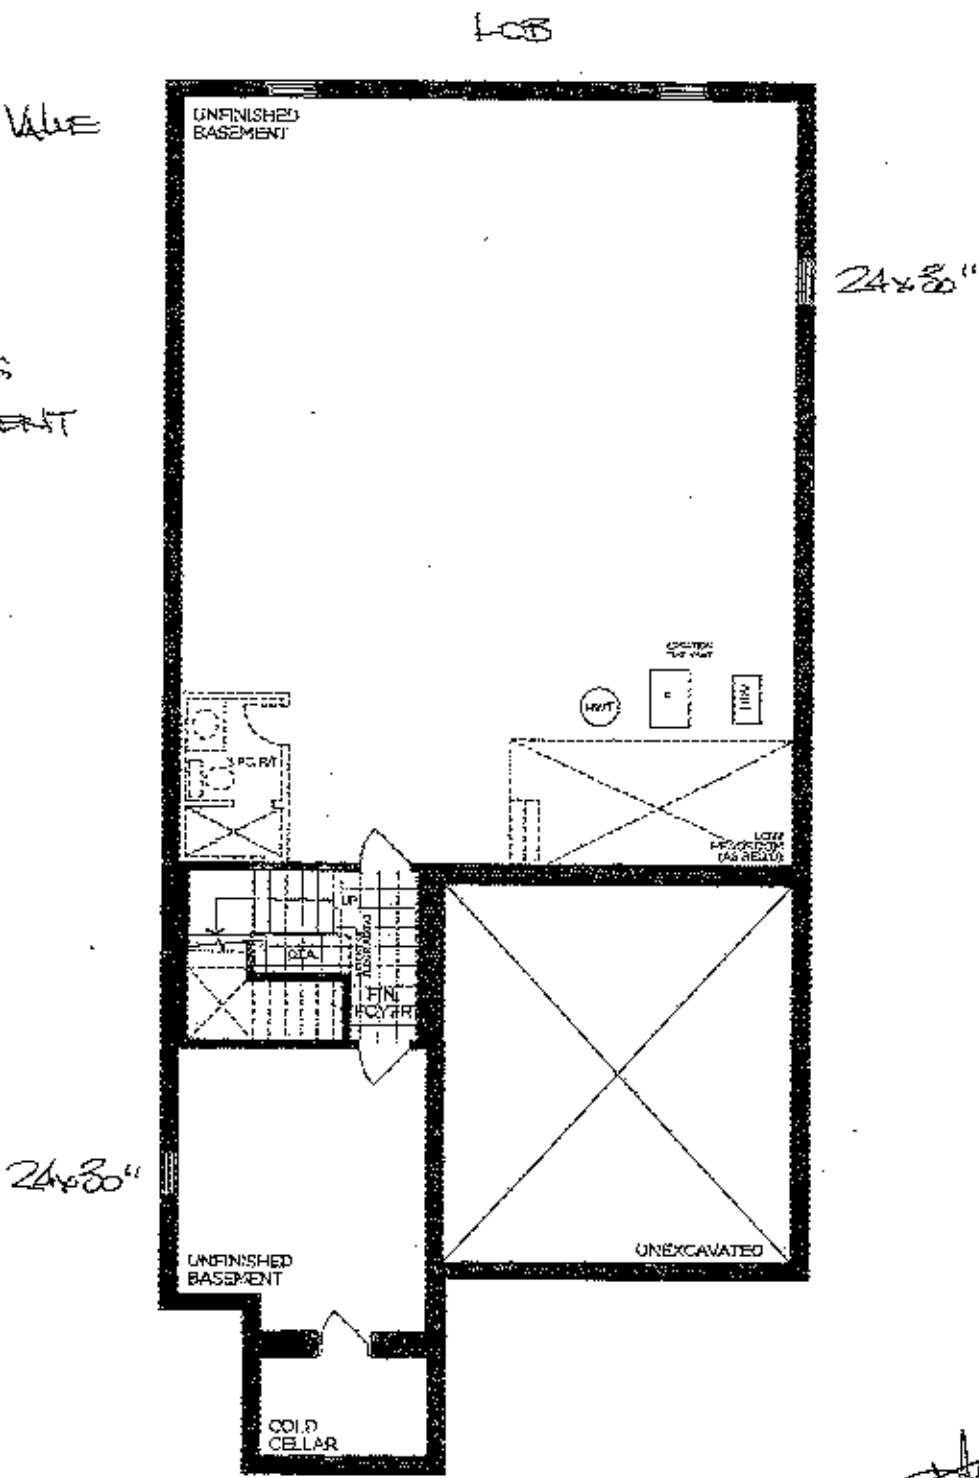

BASEMENT | ELEV. A

VENDOR	
PURCHASER	
PURCHASER	

GOLDPARK
WORTH MORE

Prices, figures, illustrations, sizes, features and finishes are subject to change without notice. Areas and dimensions are approximate and actual usable floor space may vary from the stated area. Layout may be reverse of the unit purchased. E. & D.E. 4203

Yolande Somerville

From: Selvy K <selvy_kn@hotmail.com>
Sent: Sunday, March 22, 2020 2:42 PM
To: Yolande Somerville
Subject: Re: PV-100 Pre-structural order

Hi Yolande,

It was nice speaking to you as well.

We approve of the attached pre-structural order we discussed. Once I have access to a printer, we shall sign and get it back to you.

Thank you,

Selvy

Sent from my iPhone

On Mar 22, 2020, at 1:20 PM, Yolande Somerville <YSomerville@goldparkhomes.com> wrote:

Hi Selvy and Elamaran,

It was so nice speaking with you!

Please find attached pre-structural order as discussed.

You mentioned that your printer isn't working so please reply back to this email as confirmation.

Thank you so much and stay safe!!

-Yola

<SKMBT_22320032213260.pdf>

This email has been scanned for spam and viruses by Proofpoint Essentials. Click [here](#) to report this email as spam.