

CONCRETE AND DRAIN

Invoice	Qty.	Description
2216 31723 23Mar20 NoCat	1	BACK-FLOW PREVENTER VALVE

DRYWALL

Invoice	Qty.	Description
2216 31722 23Mar20 **	2	BASEMENT WINDOWS - UPGRADE BASEMENT WINDOW SIZE TO 30 " X 24" - 8" FRAME

ELECTRICAL

Invoice	Qty.	Description
2216 31722 23Mar20 **	2	BASEMENT WINDOWS - UPGRADE BASEMENT WINDOW SIZE TO 30 " X 24" - 8" FRAME

FORM - FORMING

Invoice	Qty.	Description
2216 31722 23Mar20 **	2	BASEMENT WINDOWS - UPGRADE BASEMENT WINDOW SIZE TO 30 " X 24" - 8" FRAME

INTERIOR TRIM /MOULDINGS

Invoice	Qty.	Description
2216 31722 23Mar20 **	2	BASEMENT WINDOWS - UPGRADE BASEMENT WINDOW SIZE TO 30 " X 24" - 8" FRAME

MISC.

Invoice	Qty.	Description
2216 31724 23Mar20 NoCat	1	

PAINTING

Invoice	Qty.	Description
2216 31722 23Mar20 **		

PANL - FRAMING

Invoice	Qty.	Description
2216 31722 23Mar20 **	2	BASEMENT WINDOWS - UPGRADE BASEMENT WINDOW SIZE TO 30 " X 24" - 8" FRAME



CONSTRUCTION SUMMARY

Lot: 101

Model: 40.00 A BRIARWOOD

Project/Phase: Pine Valley Forevergreen / 1

ROUGH CARPENTRY

Invoice	Qty.	Description
2216 31722 23Mar20 **	2	BASEMENT WINDOWS - UPGRADE BASEMENT WINDOW SIZE TO 30 " X 24" - 8" FRAME

WINDOWS - BASEMENT

Invoice	Qty.	Description
2216 31722 23Mar20	2	BASEMENT WINDOWS - UPGRADE BASEMENT WINDOW SIZE TO 30 " X 24" - 8" FRAME
2216 31722 23Mar20	2	BASEMENT WINDOWS - UPGRADE BASEMENT WINDOW SIZE TO 30 " X 24" - 8" FRAME

This Document is Extremely Time Sensitive - Printed 23 Mar 20 at 11:17



PV-101
March 22, 2020

SCHEDULE 'F'

f aw

The Briarwood

40' SERIES


→ Elevation A • 2,870 sq.ft.
Elevation B • 2,860 sq.ft.

LOB

Back-Flow
Preventer Valve

24x30"

24x30"

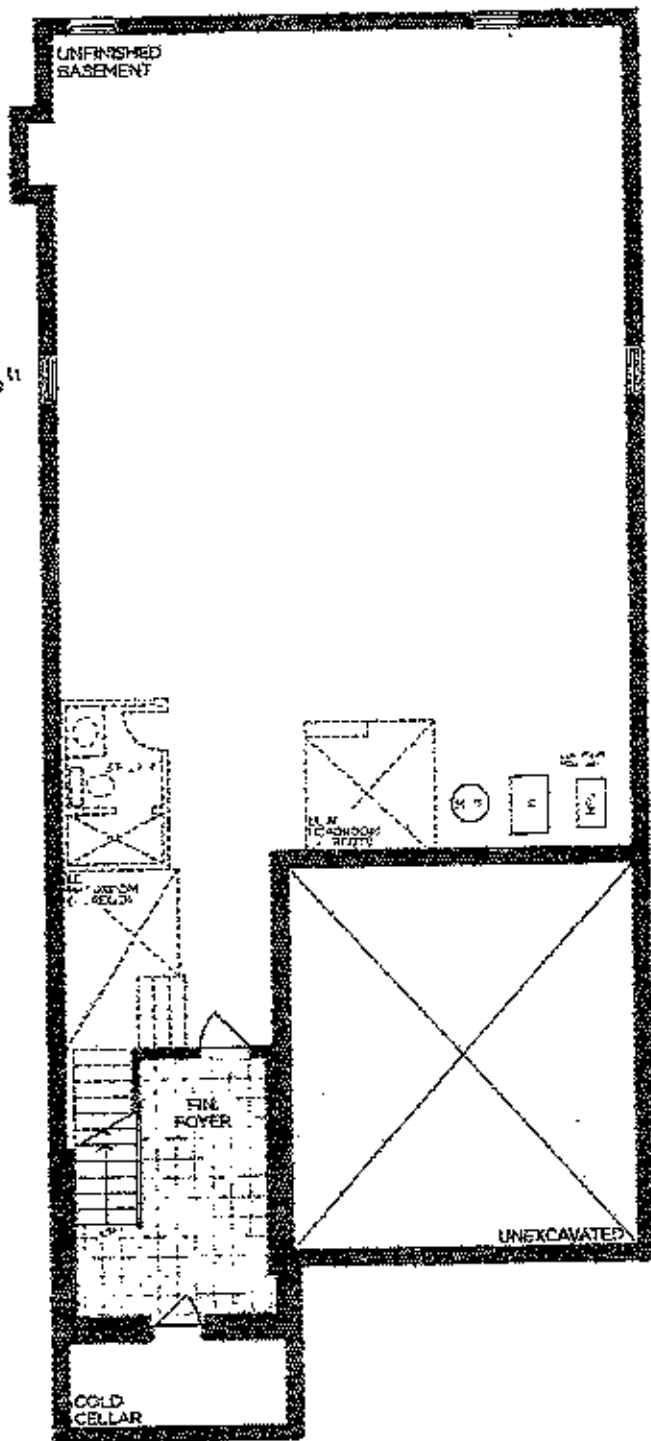

BASEMENT | ELEV. A & B

[Handwritten signature]

VENDOR

PURCHASER

PURCHASER

GOLD

WORTH MORE

Price, figures, illustrations, size, features and finishes are subject to change without notice. Areas and dimensions are approximate and actual on-site floor space may vary from the stated area. L.V. 24x30" is the size of the unit purchased. E & O.E. 4000




2
SCHEDULE 'F'

FV-101
MARCH 22 2020
F 05

The
Briarwood
40' SERIES

Elevation A • 2,870 sq.ft.
Elevation B • 2,860 sq.ft.

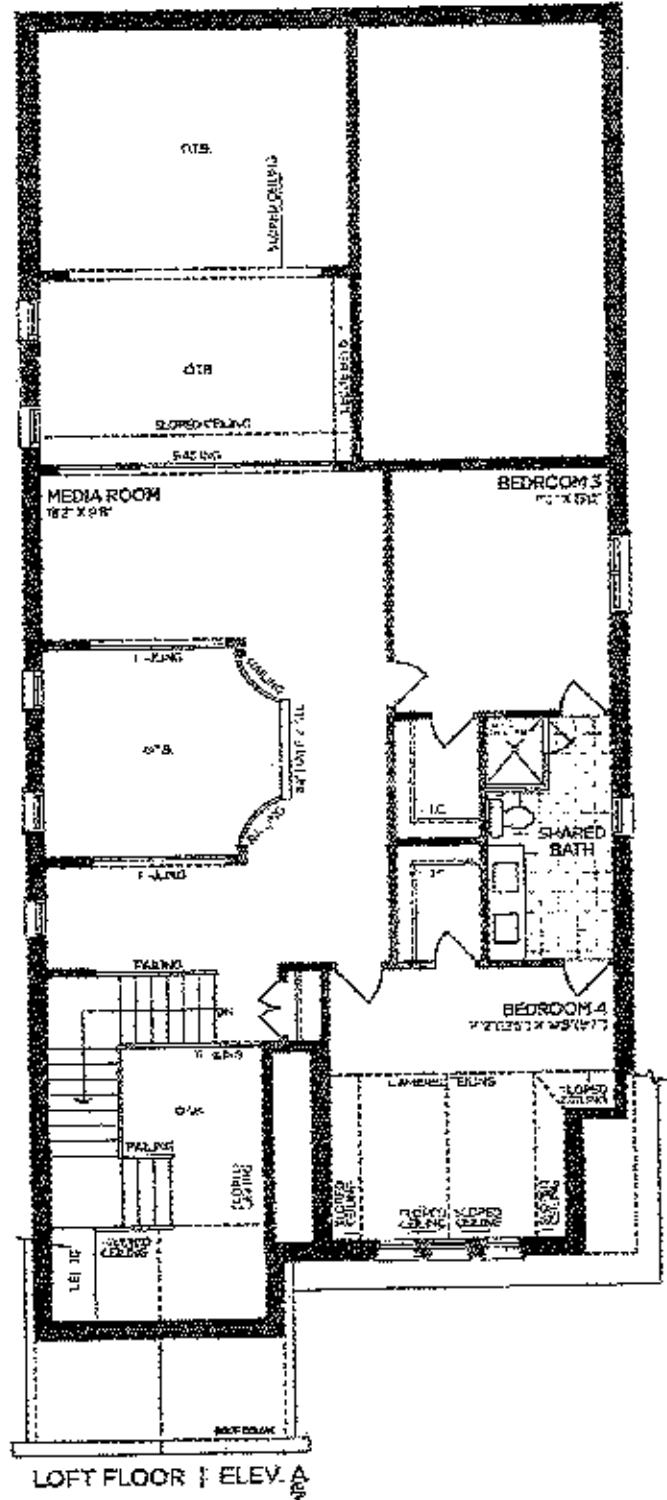

VENDOR
PURCHASER
PURCHASER

GOLD
WORTH MORE

From figures, dimensions, sizes, features and finishes are subject to change without notice. Areas and dimensions are approximate and actual on site may vary from the stated area. Layout may be reverse of the unit purchased. E. & O.E. 4000

SCHEDULE 'F'




PL-101

MARCH 22 2020


The Briarwood 40' SERIES

Elevation A • 2,870 sq.ft.


Elevation B • 2,860 sq.ft.

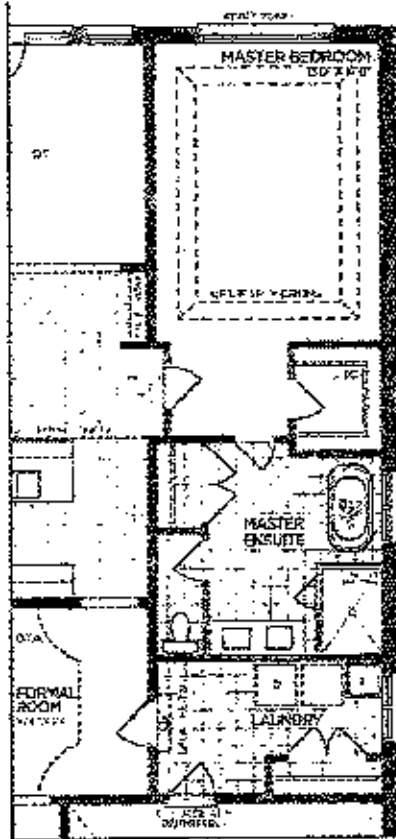


PART, OPT. GROUND FLOOR | ELEV. A
(ELEV. B SIMILAR)

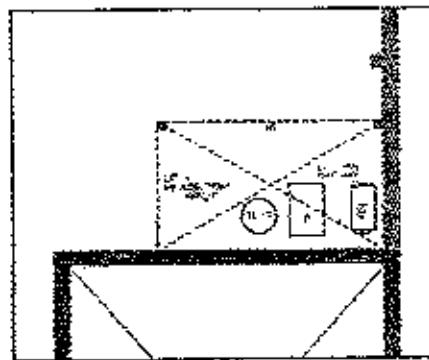

PART, BASEMENT | ELEV. A

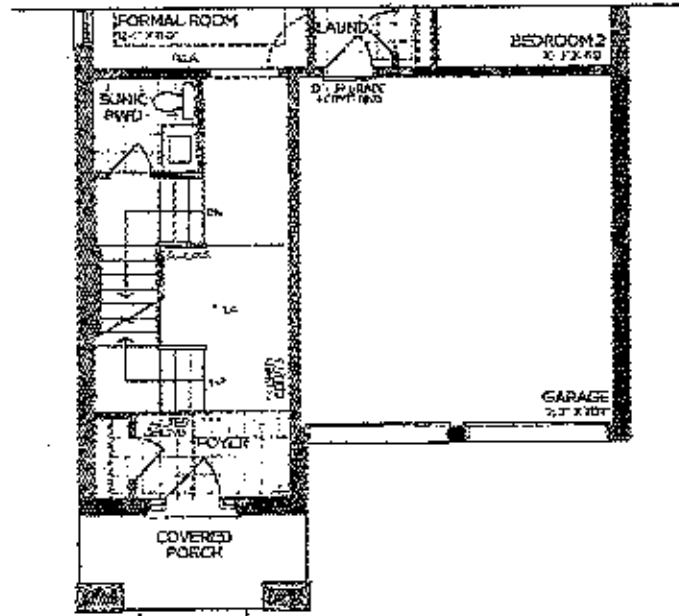

PART, GROUND FLOOR | ELEV. B

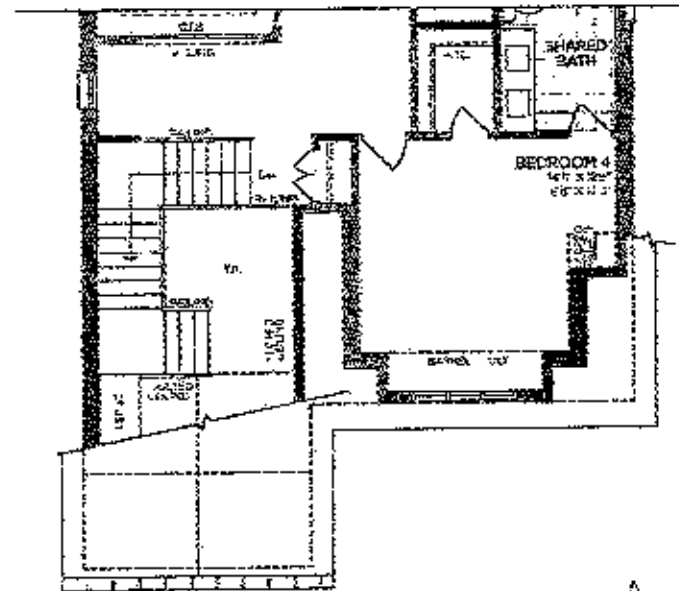

PART, LOFT FLOOR | ELEV. B

VENDOR

PURCHASER

PURCHASER

GOLD

WORTH MORE

Prices, figures, illustrations, sizes, features and finishes are subject to change without notice. Areas and dimensions are approximate and actual square foot totals may vary by 5% in the stated area. Lot, set back, be not over of the unit purchased. E. & O. 4000