

DRYWALL

Invoice	Qty.	Description
2231 31691 23Mar20 **	1	BASEMENT WINDOWS - UPGRADE BASEMENT WINDOW SIZE TO 30 " X 24" - 8" FRAME SIDE ELEVATION - REAR SEE PLAN FOR LOCATION

ELECTRICAL

Invoice	Qty.	Description
2231 31691 23Mar20 **	1	BASEMENT WINDOWS - UPGRADE BASEMENT WINDOW SIZE TO 30 " X 24" - 8" FRAME SIDE ELEVATION - REAR SEE PLAN FOR LOCATION

FORM - FORMING

Invoice	Qty.	Description
2231 31691 23Mar20 **	1	BASEMENT WINDOWS - UPGRADE BASEMENT WINDOW SIZE TO 30 " X 24" - 8" FRAME SIDE ELEVATION - REAR SEE PLAN FOR LOCATION

INTERIOR TRIM /MOULDINGS

Invoice	Qty.	Description
2231 31691 23Mar20 **	1	BASEMENT WINDOWS - UPGRADE BASEMENT WINDOW SIZE TO 30 " X 24" - 8" FRAME SIDE ELEVATION - REAR SEE PLAN FOR LOCATION

MISC.

Invoice	Qty.	Description
2231 31692 23Mar20 No Cost	1	

PAINTING

Invoice	Qty.	Description
2231 31691 23Mar20 **		

PANL - FRAMING

Invoice	Qty.	Description
2231 31691 23Mar20 **	1	BASEMENT WINDOWS - UPGRADE BASEMENT WINDOW SIZE TO 30 " X 24" - 8" FRAME SIDE ELEVATION - REAR SEE PLAN FOR LOCATION

ROUGH CARPENTRY

Invoice	Qty.	Description
2231 31691 23Mar20 **	1	BASEMENT WINDOWS - UPGRADE BASEMENT WINDOW SIZE TO 30 " X 24" - 8" FRAME SIDE ELEVATION - REAR SEE PLAN FOR LOCATION

WINDOWS - BASEMENT


Invoice	Qty.	Description
2231 31691 23Mar20	1	BASEMENT WINDOWS - UPGRADE BASEMENT WINDOW SIZE TO 30 " X 24" - 8" FRAME SIDE ELEVATION - REAR SEE PLAN FOR LOCATION
2231 31691 23Mar20	1	BASEMENT WINDOWS - UPGRADE BASEMENT WINDOW SIZE TO 30 " X 24" - 8" FRAME SIDE ELEVATION - REAR SEE PLAN FOR LOCATION

This Document is Extremely Time Sensitive - Printed 23 Mar 20 at 10:59

SCHEDULE 'F'



PV-137
March 18 2020

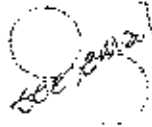


The Brookside 40' SERIES

Elevation A • 3,380 sq.ft.

Elevation B • 3,350 sq.ft.

No. 1

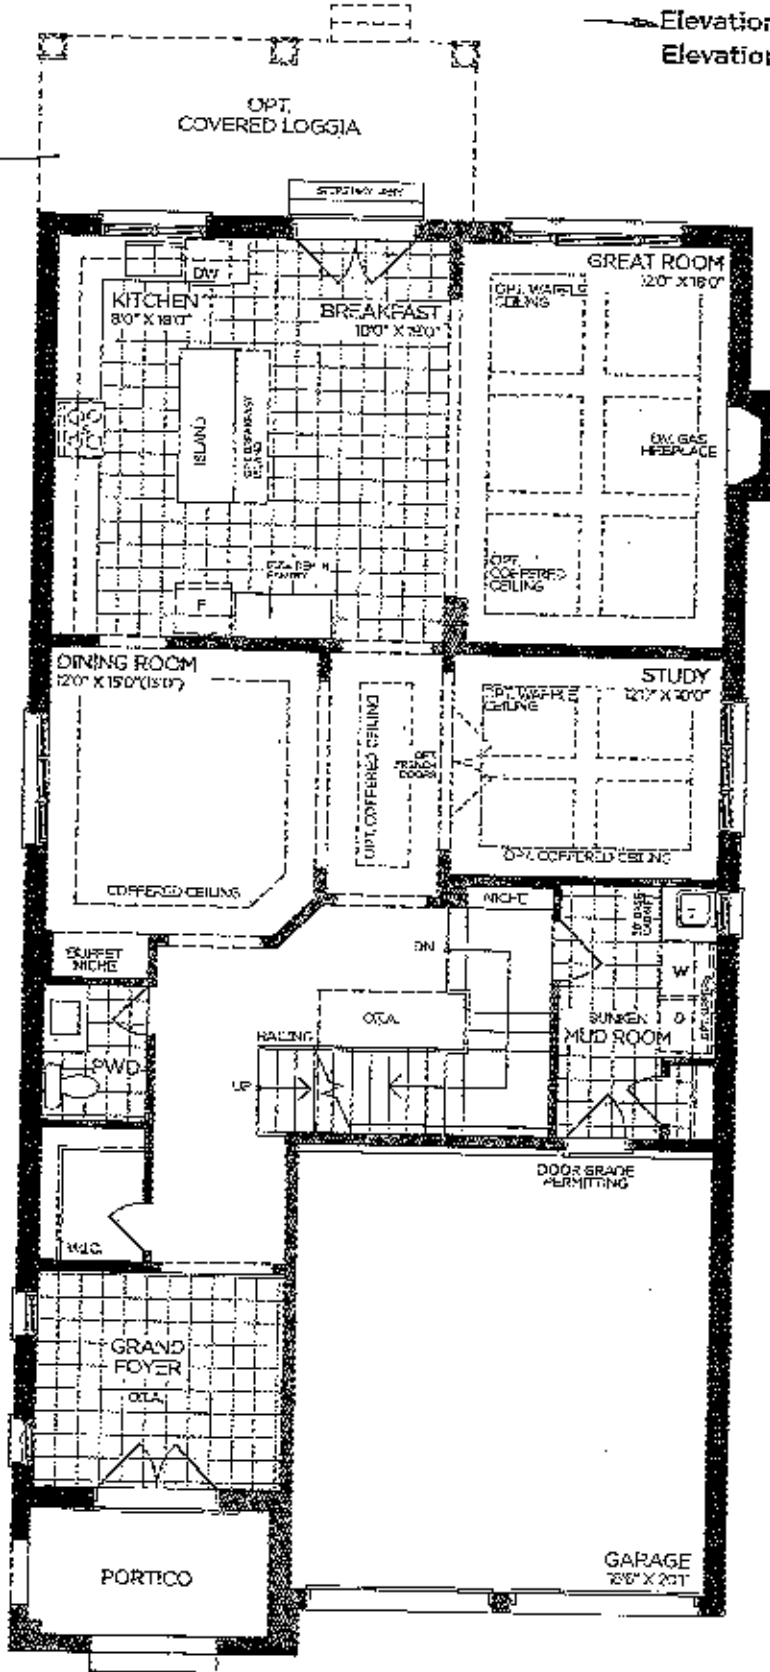

GROUND FLOOR | ELEV. A

VENDOR

PURCHASER

PURCHASER

GOLDPARK
WORTH MORE

Prices, figures, illustrations, sizes, features and finishes are subject to change without notice. Areas and dimensions are approximate and actual usable floor space may vary from the stated area. Layout may be reverse of the unit purchased. S. & O.E. 4003

SCHEDULE 'F'




PN-137
MAR 18 2020

See *encl*

The Brookside 40' SERIES

→ Elevation A • 3,380 sq.ft.
Elevation B • 3,350 sq.ft.

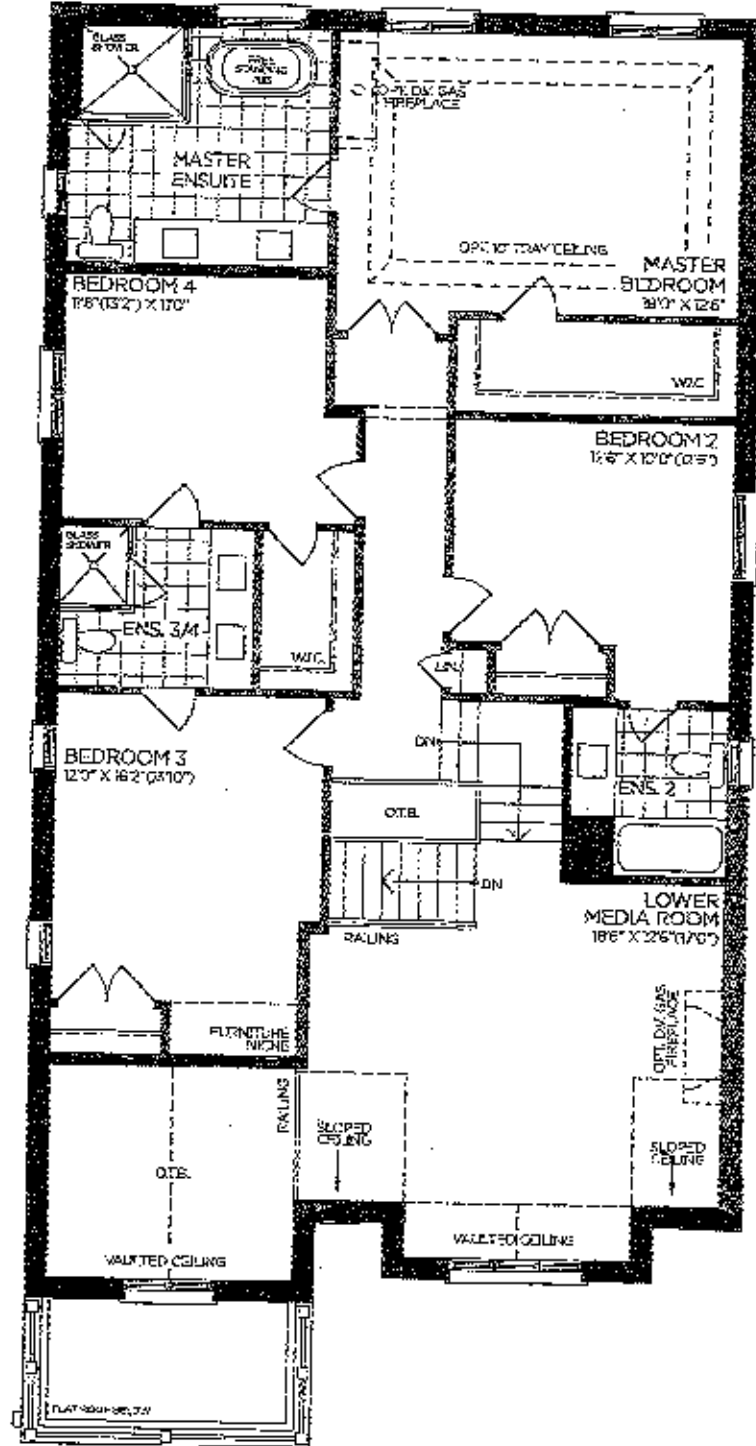

SECOND FLOOR | ELEV. A

[Handwritten signature]

VENDOR	
PURCHASER	
PURCHASER	

GOLDPARK
WORTH MORE™

Prices, figures, illustrations, sizes, features and finishes are subject to change without notice. Areas and dimensions are approximate and actual usable floor space may vary from the stated area. Layout may be reverse of the unit purchased. E. & C.E. 4003


SCHEDULE 'F'



PV-137 *see model*
 March 19 2020

The Brookside 40' SERIES

Elevation A • 3,380 sq.ft.
 Elevation B • 3,350 sq.ft.

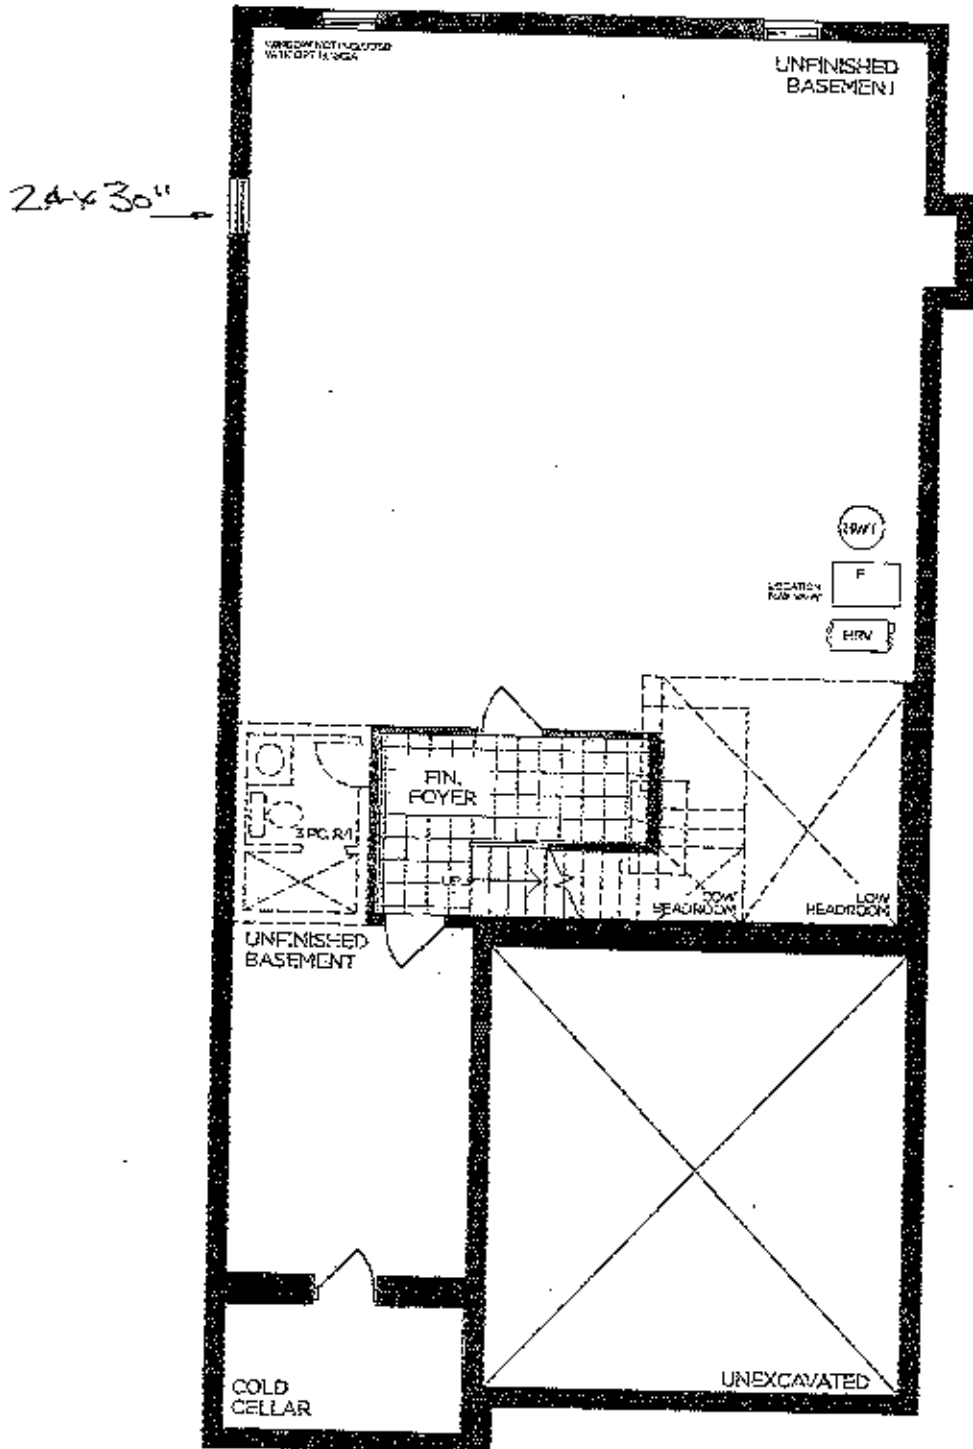

BASEMENT | ELEV. A

[Handwritten signature]

VENDOR	
PURCHASER	
PURCHASER	

GOLDPARK
 WORTH MORE

Prices, figures, illustrations, sizes, features and finishes are subject to change without notice. Areas and dimensions are approximate and actual usable floor space may vary from the stated area. Layout may be reversal of the unit purchased. E. & O.E. 4003

Yolande Somerville

From: Victor Da Silva <vdasilva399@gmail.com>
Sent: Friday, March 20, 2020 5:59 PM
To: Yolande Somerville
Subject: Re: PV-137 Pre-structural order

Hi Yolande

Thanks for getting back to us so quickly. ~~We would like to go with the larger window 47x35.~~

Thanks

On Thu, Mar 19, 2020 at 5:46 PM Yolande Somerville <YSomerville@goldparkhomes.com> wrote:

Hi Victor and Dana,

It was nice speaking with you!

I've attached the pre-structural order for the larger basement window.

You mentioned that you ~~don't have access to a scanner, so please, reply to this email confirming the order.~~

Thanks!

Yola

This email has been scanned for spam and viruses by Proofpoint Essentials. Click [here](#) to report this email as spam.