

**FORMING**

Invoice	Qty.	Description		
2201 31224	1	ADD OPTIONAL COLD CELLAR - MUST PURCHASE OPTIONAL LOGGLA		
		FORMING	72,166	FORMING

**MISC.**

Invoice	Qty.	Description		
2201 31358	1			
NoCat				

**WINDOWS - BASEMENT**

Invoice	Qty.	Description		
2201 31356	1	BASEMENT WINDOWS - EGRESS BASEMENT WINDOW 47" X 35" - 10" FRAME ( PINEVALLEY 50 FOOT LOTS ONLY)		
		WINDOWS - BASEMENT REAR ONLY	72,678	WINDOWS - BASEMENT
2201 31357	3	BASEMENT WINDOWS - UPGRADE BASEMENT WINDOW SIZE TO 30" X 24" - 10" FRAME ( PINEVALLEY 50 FOOT LOTS ONLY)		
		WINDOWS - BASEMENT	72,675	WINDOWS - BASEMENT

**This Document is Extremely Time Sensitive - Printed 23 Mar 20 at 11:37**

PV LOT # 133

SCHEDULE 'F'




PV-133  
March 2020

The Silverwood

50' SERIES

Elevation A • 3,545 sq.ft.  
Elevation B • 3,465 sq.ft.

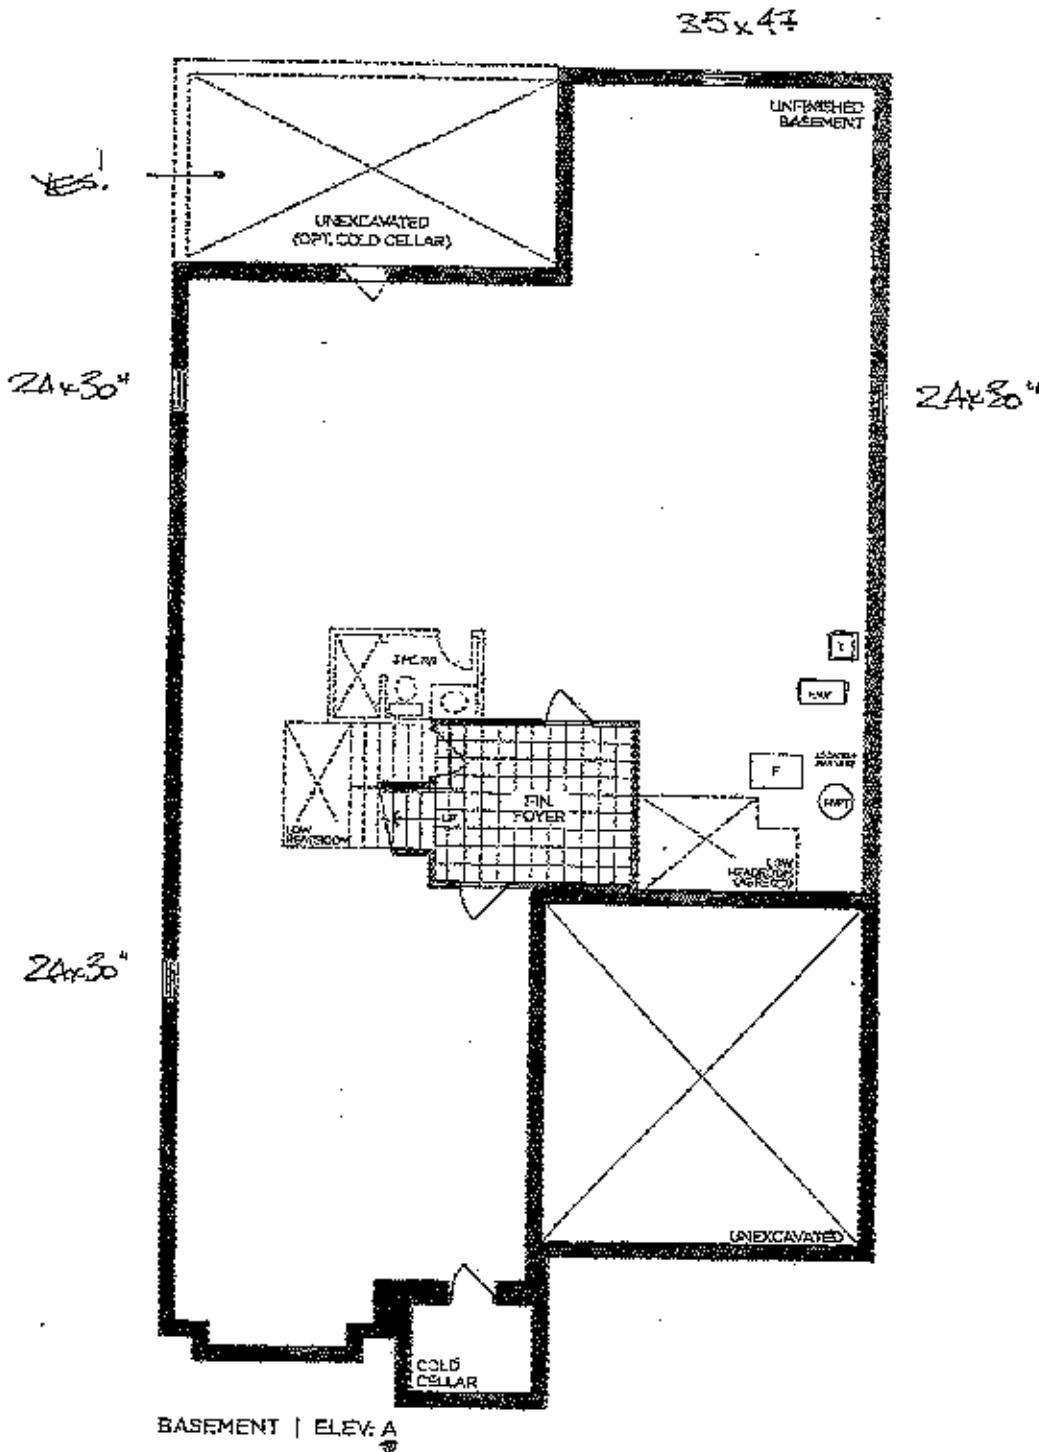

VENDOR

PURCHASER

PURCHASER

GOLDPARK  
WORTH MORE

Prices, figures, illustrations, sizes, features and finishes are subject to change without notice. Areas and dimensions are approximate and actual usable floor space may vary from the stated area. Layout may be reverse of the unit purchased. E. & O.E. 5/05

# PV Lot #133


## SCHEDULE 'F'



PV-133  
March 16 2020

# The Silverwood 50' SERIES

→ Elevation A • 3,545 sq.ft.  
Elevation B • 3,465 sq.ft.

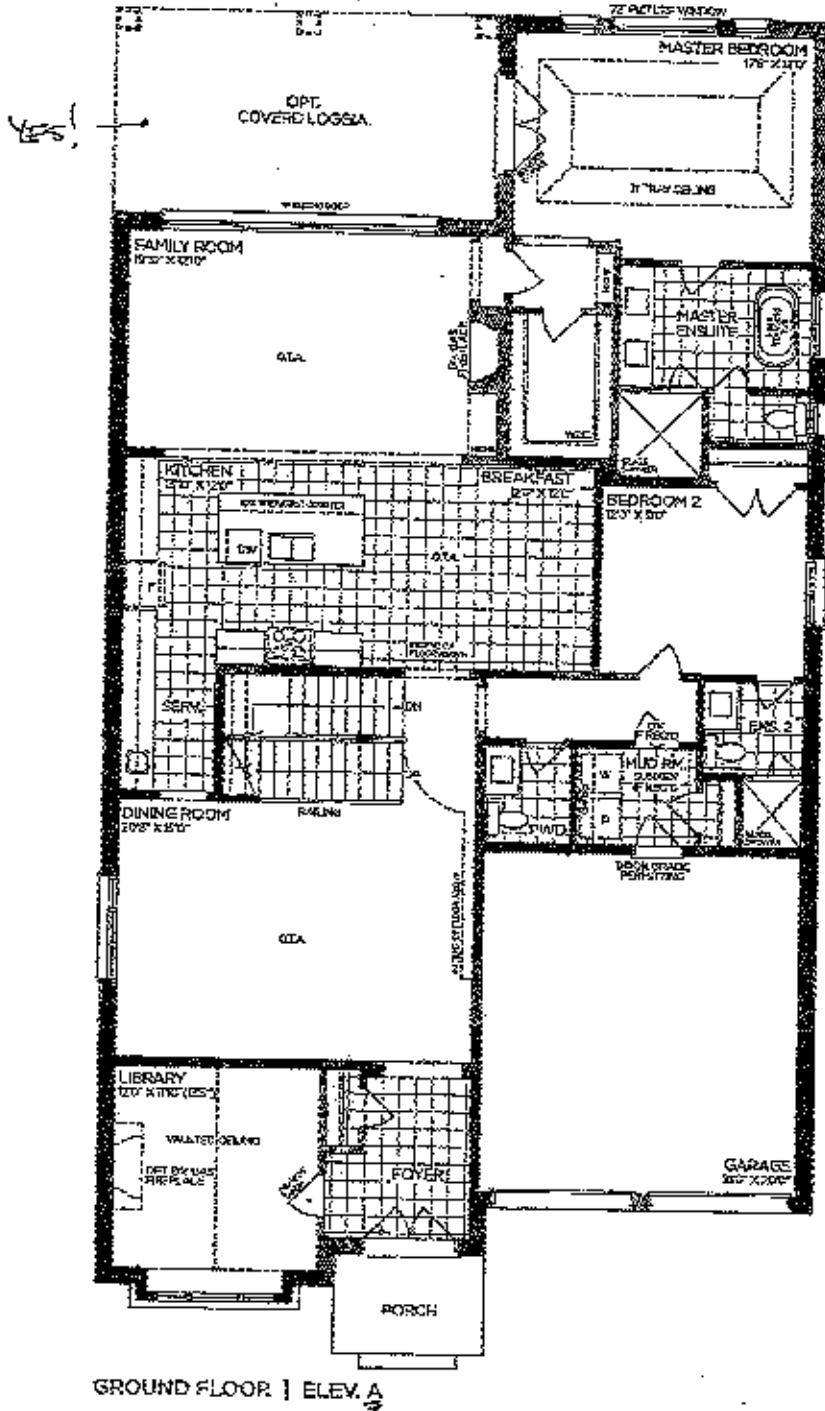

VENDOR   
PURCHASER   
PURCHASER

### GOLDPARK


WORTH MORE

Prices, features, illustrations, sizes, features and finishes are subject to change without notice. Areas and dimensions are approximate and actual usable floor space may vary from the stated area. Layout may be reverse of the unit purchased. E. & O.E. 5005

PV. Lq # 133

SCHEDULE 'F'




PV-133  
March 16 2020 

# The Silverwood

## 50' SERIES

→ Elevation A - 3,545 sq.ft.  
Elevation B - 3,465 sq.ft.

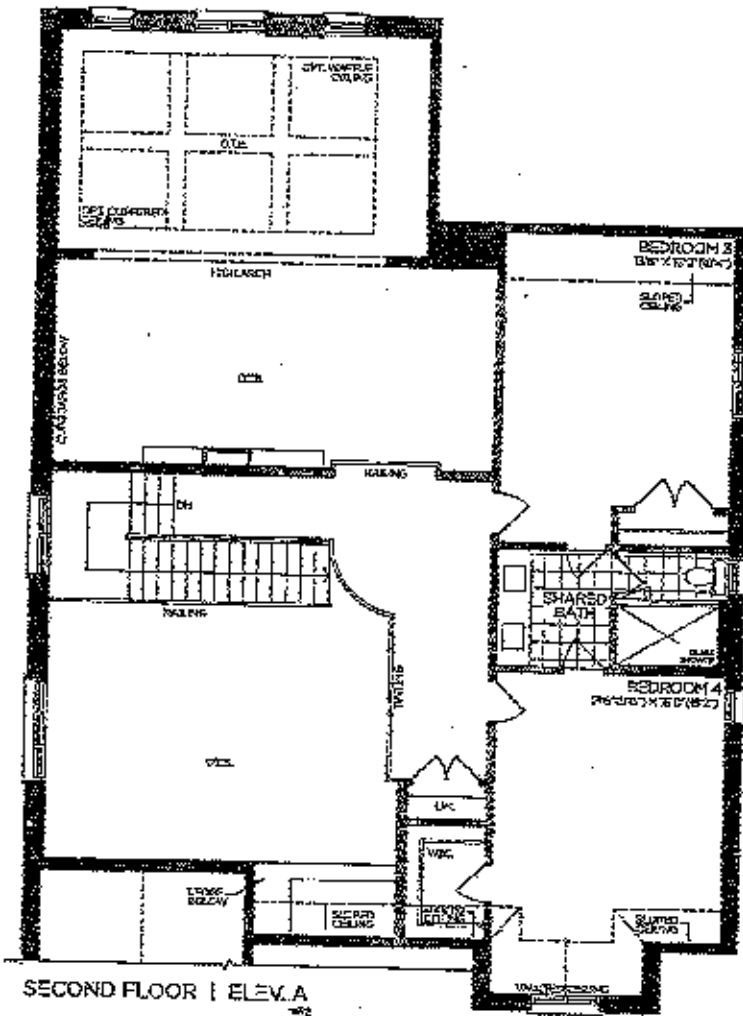

VENDOR

PURCHASER

PURCHASER

**GOLDPARK**  
WORTH MORE™

Prices, figures, illustrations, sizes, features and finishes are subject to change without notice. Areas and dimensions are approximate and actual usable floor space may vary from the stated area. Layout may be reverse of the unit purchased. E & Q.E. 5005