



CONSTRUCTION SUMMARY

Lot: 104
Model: 50.03 B OAKGROVE
Project/Phase: Pine Valley Forevergreen / 1

CONCRETE AND DRAIN

Invoice	Qty.	Description
2237 31730 24Mar20 NoCat	1	BACK-FLOW PREVENTER VALVE

MISC.

Invoice	Qty.	Description
2237 31731 24Mar20 NoCat	1	LINEAL FOOTAGE

WINDOWS - BASEMENT

Invoice	Qty.	Description
2237 31732 24Mar20	3	BASEMENT WINDOWS - UPGRADE BASEMENT WINDOW SIZE TO 30 " X 24" - 10" FRAME (PINEVALLEY 50 FOOT LOTS ONLY)

This Document is Extremely Time Sensitive - Printed 24 Mar 20 at 10:14


SCHEDULE 'F'



PV-104 ^{599 sq. ft.}
MAR 22 2020

The
Oakgrove
50' SERIES

Elevation A • 3,920 sq.ft.
→ Elevation B • 3,905 sq.ft.
Elevation C • 3,915 sq.ft.

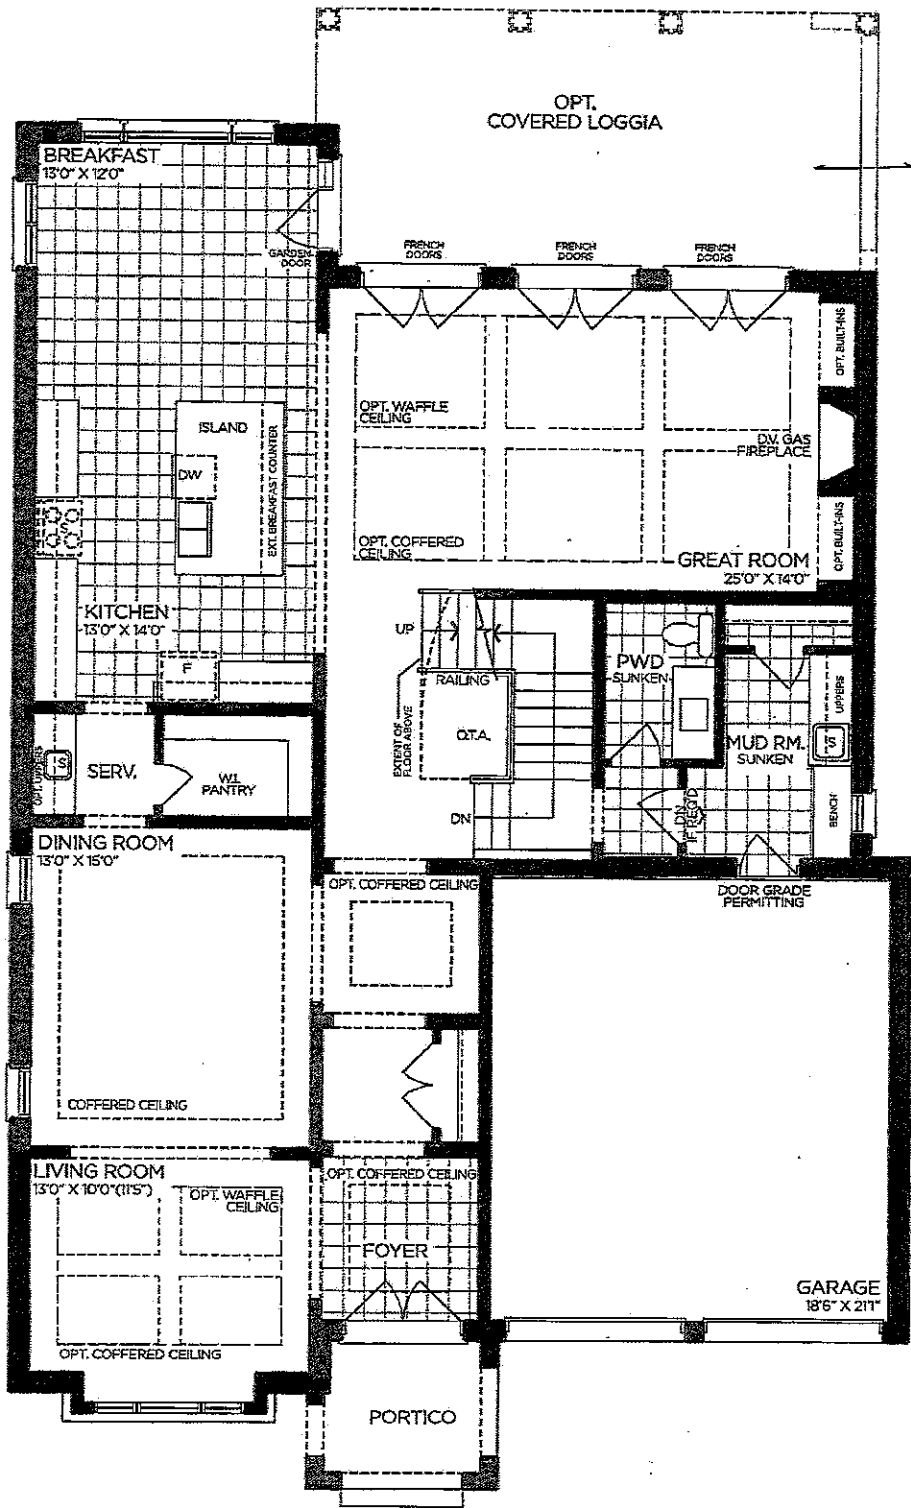

GROUND FLOOR | ELEV. A

VENDOR

PURCHASER

PURCHASER

GOLDPARK
WORTH MORE™

Prices, figures, illustrations, sizes, features and finishes are subject to change without notice. Areas and dimensions are approximate and actual usable floor space may vary from the stated area. Layout may be reverse of the unit purchased. E. & O.E. 5003









SCHEDULE 'F'



PV-104 *see sketch*
MAR. 22 2020

The
Oakgrove
50' SERIES

Elevation A • 3,920 sq.ft.
→ Elevation B • 3,905 sq.ft.
Elevation C • 3,915 sq.ft.

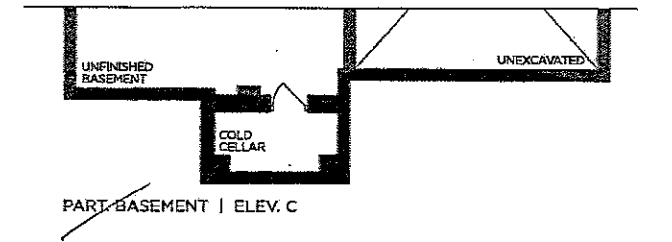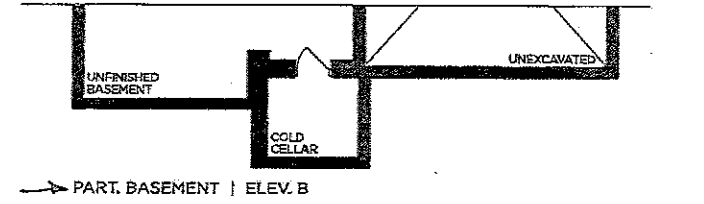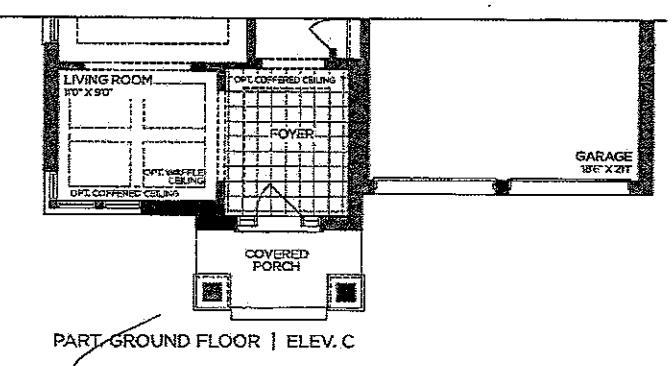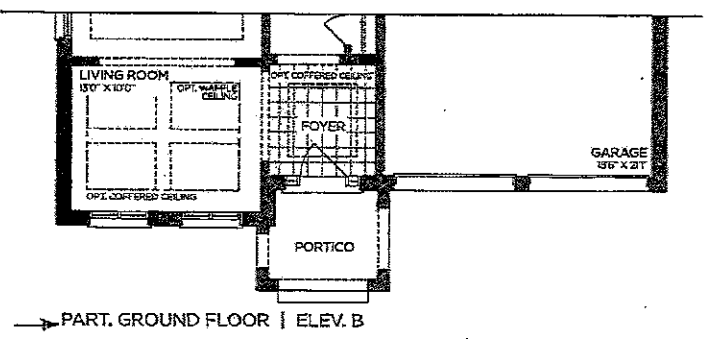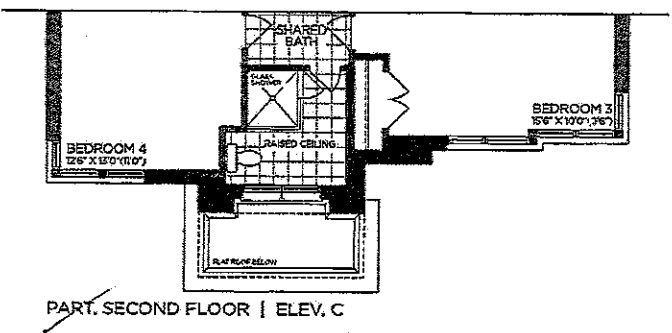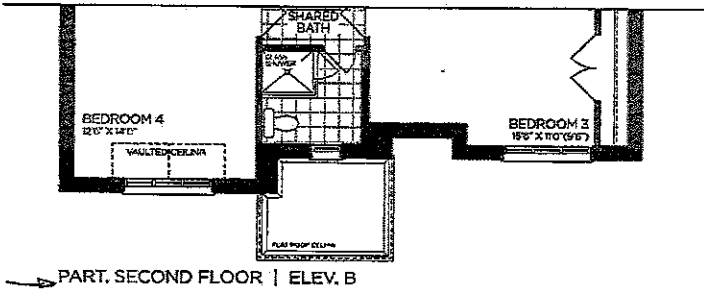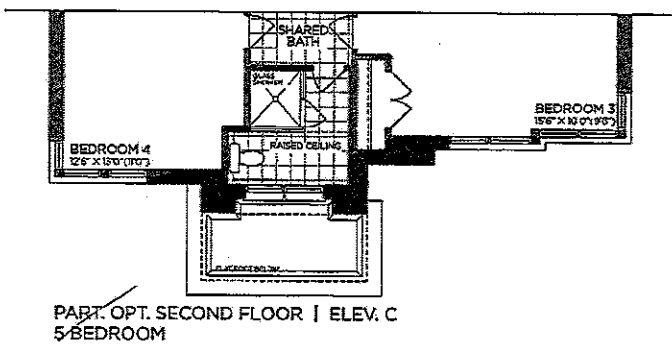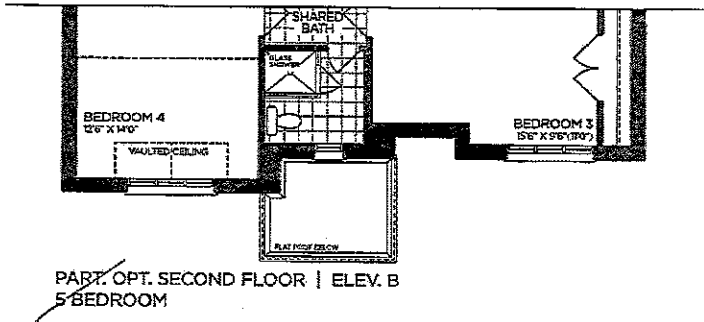

VENDOR

PURCHASER

PURCHASER

GOLDPARK
WORTH MORE™

Prices, figures, illustrations, sizes, features and finishes are subject to change without notice. Areas and dimensions are approximate and actual usable floor space may vary from the stated area. Layout may be reverse of the unit purchased. E. & O.E. 5003


FV-104 ~~see~~ stock
March 22 2020

The Oakgrove 50' SERIES

Elevation A • 3,920 sq.ft.

→ Elevation B • 3,905 sq.ft.

Elevation C • 3,915 sq.ft.

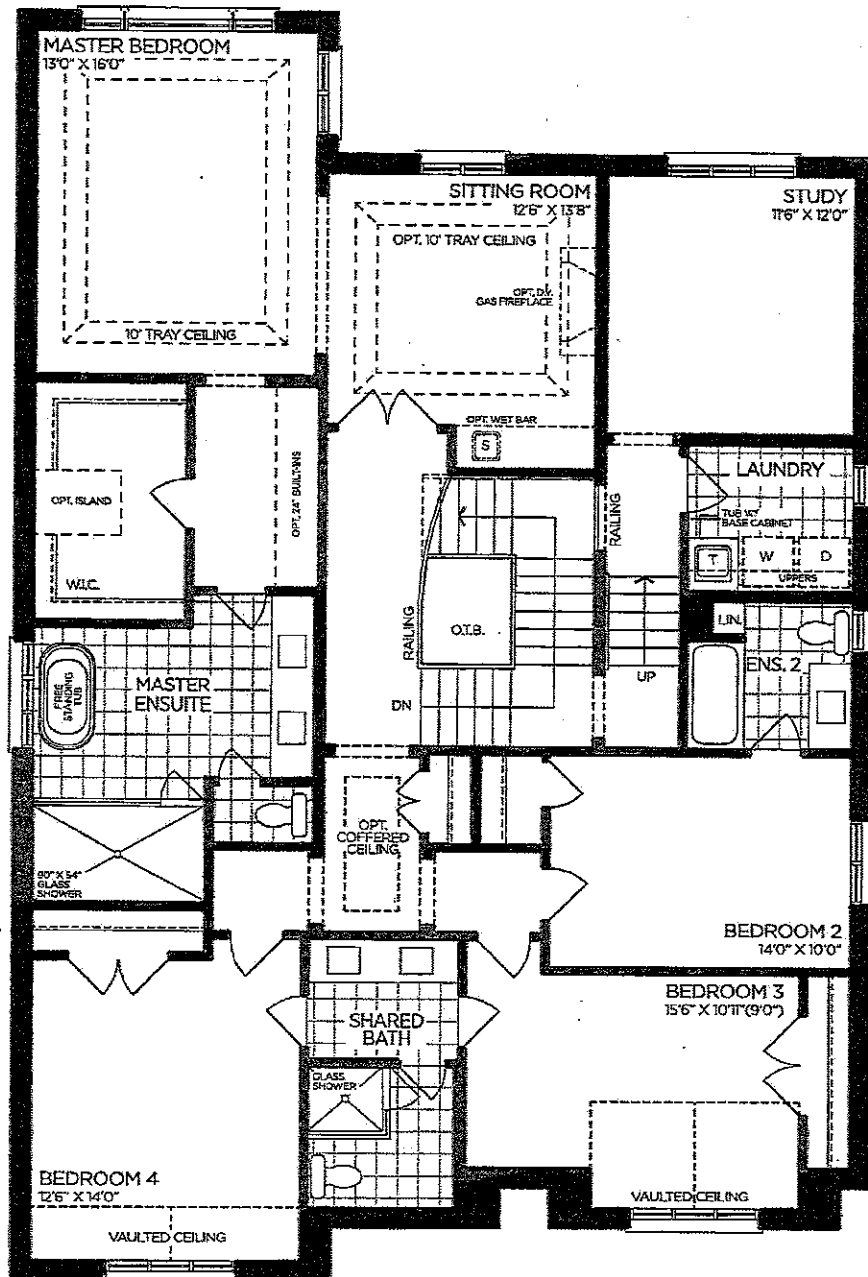

SECOND FLOOR | ELEV. A

VENDOR

PURCHASER

PURCHASER

GOLD PARK
WORTH MORE

WORTH MORE

Prices, figures, illustrations, sizes, features and finishes are subject to change without notice. Areas and dimensions are approximate and actual usable floor space may vary from the stated area. Layout may be reverse of the unit purchased. E. & O.E. 5003

SCHEDULE 'F'



PV-104 *all other*
March 22 2020

The Oakgrove


50' SERIES

Elevation A • 3,920 sq.ft.

→ Elevation B • 3,905 sq.ft.

Elevation C • 3,915 sq.ft.

BACKFLOW
PREVENTER
VALVE

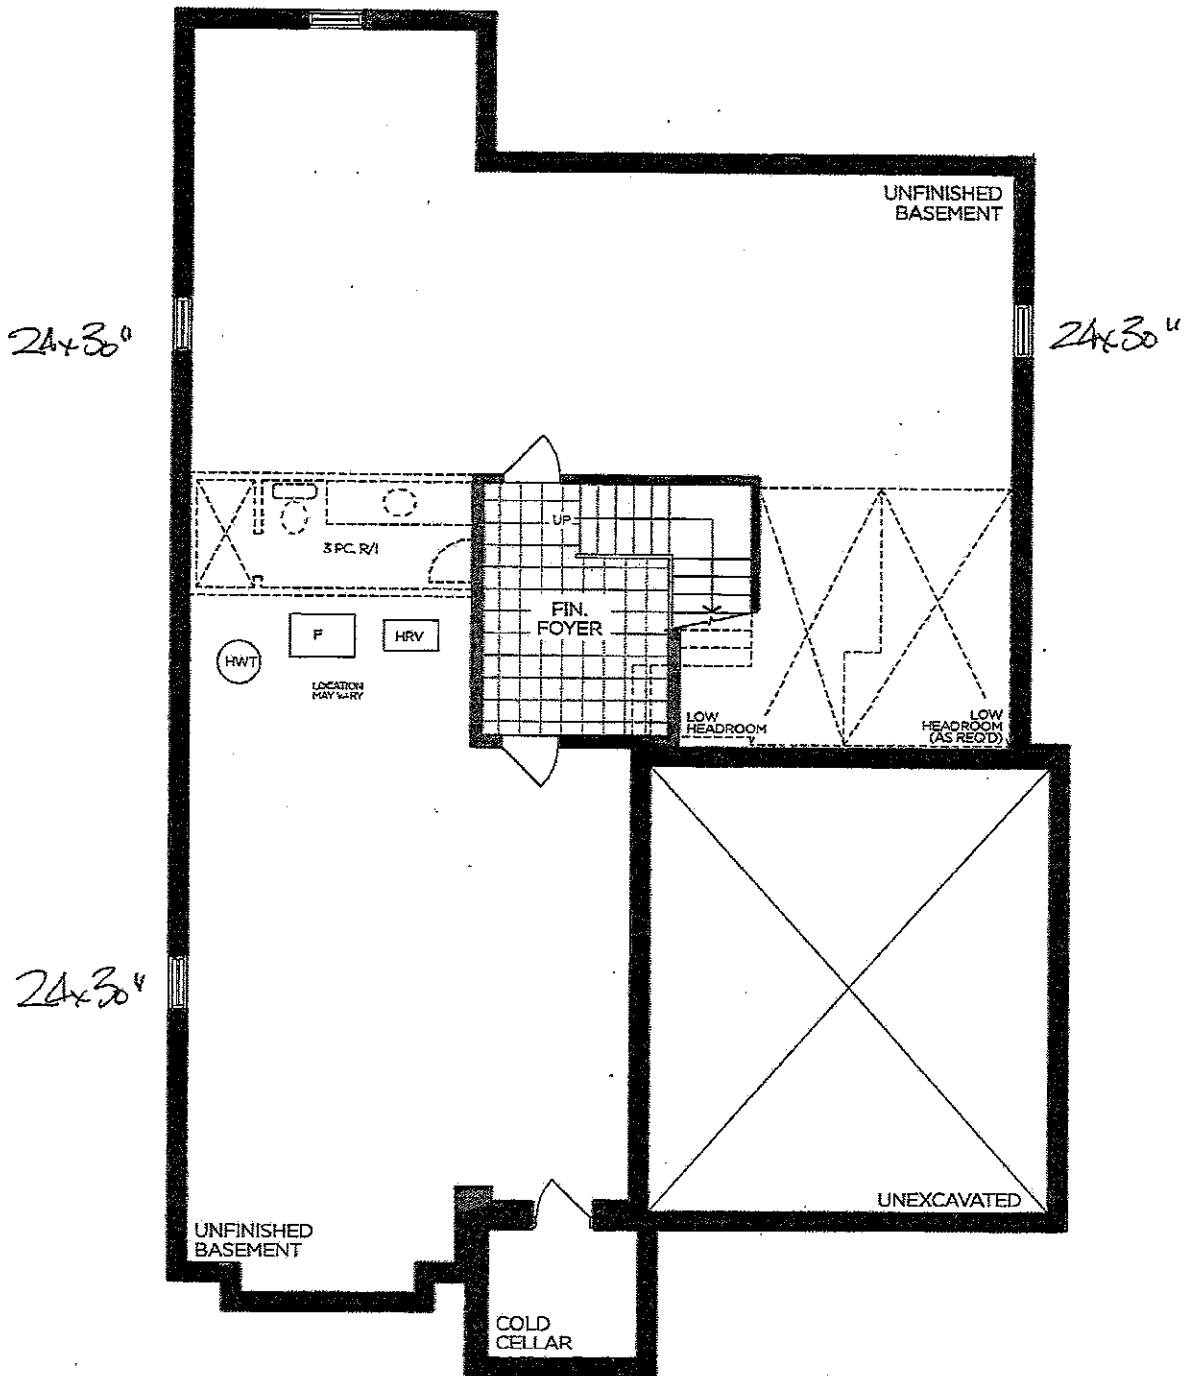

BASEMENT | ELEV. A

VENDOR

PURCHASER

PURCHASER

GOLDPARK

WORTH MORE™

Prices, figures, illustrations, sizes, features and finishes are subject to change without notice. Areas and dimensions are approximate and actual usable floor space may vary from the stated area. Layout may be reverse of the unit purchased. E. & O.E. 5003

Yolande Somerville

From: Monika . <monikakarimi@gmail.com>
Sent: Sunday, March 22, 2020 9:42 PM
To: Yolande Somerville
Subject: Re: PV-104 Pre-structural Order

Hi Yola
I hope all is well with you.
It was great speaking with you as well.
~~I would like to confirm the order.~~

Thank you so much .

Have a great evening.

Monika Karimi

This email has been scanned for spam and viruses by Proofpoint Essentials. Click [here](#) to report this email as spam.