



CONSTRUCTION SUMMARY

Lot: 102
Model: 42.01 A MAPLEWOOD
Project/Phase: Pine Valley Forevergreen / 1

CONCRETE AND DRAIN

Invoice	Qty.	Description
2212 31727 24Mar20 NoCat	1	BACK-FLOW PREVENTER VALVE

DRYWALL

Invoice	Qty.	Description
2212 31726 24Mar20 **		

ELECTRICAL

Invoice	Qty.	Description
2212 31726 24Mar20 **	2	BASEMENT WINDOWS - UPGRADE BASEMENT WINDOW SIZE TO 30 " X 24" - 8" FRAME

FORM - FORMING

Invoice	Qty.	Description
2212 31726 24Mar20 **	2	BASEMENT WINDOWS - UPGRADE BASEMENT WINDOW SIZE TO 30 " X 24" - 8" FRAME

FORMING

Invoice	Qty.	Description
2212 31725 24Mar20	1	PINE VALLEY MODEL 42.01 MAPLEWOOD ELEV A OR B - 9 FOOT BASEMENT CEILING HEIGHT IN LIEU OF STANDARD 8 FOOT CEILING.

INTERIOR TRIM /MOULDINGS

Invoice	Qty.	Description
2212 31726 24Mar20 **		

MISC.

Invoice	Qty.	Description
2212 31728 24Mar20 NoCat		

PAINTING

Invoice	Qty.	Description
2212 31726 24Mar20 **	1	

**Lot: 102**

Model: 42.01 A MAPLEWOOD

Project/Phase: Pine Valley Forevergreen / 1

PANL - FRAMING

Invoice	Qty.	Description
2212 31726 24Mar20 **		

ROUGH CARPENTRY

Invoice	Qty.	Description
2212		
31726		
24Mar20		
**		

WINDOWS - BASEMENT

Invoice	Qty.	Description
2212 31726 24Mar20	2	BASEMENT WINDOWS - UPGRADE BASEMENT WINDOW SIZE TO 30 " X 24" - 8" FRAME
2212 31726 24Mar20	2	BASEMENT WINDOWS - UPGRADE BASEMENT WINDOW SIZE TO 30 " X 24" - 8" FRAME

This Document is Extremely Time Sensitive - Printed 24 Mar 20 at 11:00

SCHEDULE 'F'




PV-102 *see sketch*
MAR 22 2020

The
Maplewood
42' SERIES

Elevation A • 2,770 sq.ft.

Elevation B • 2,725 sq.ft.

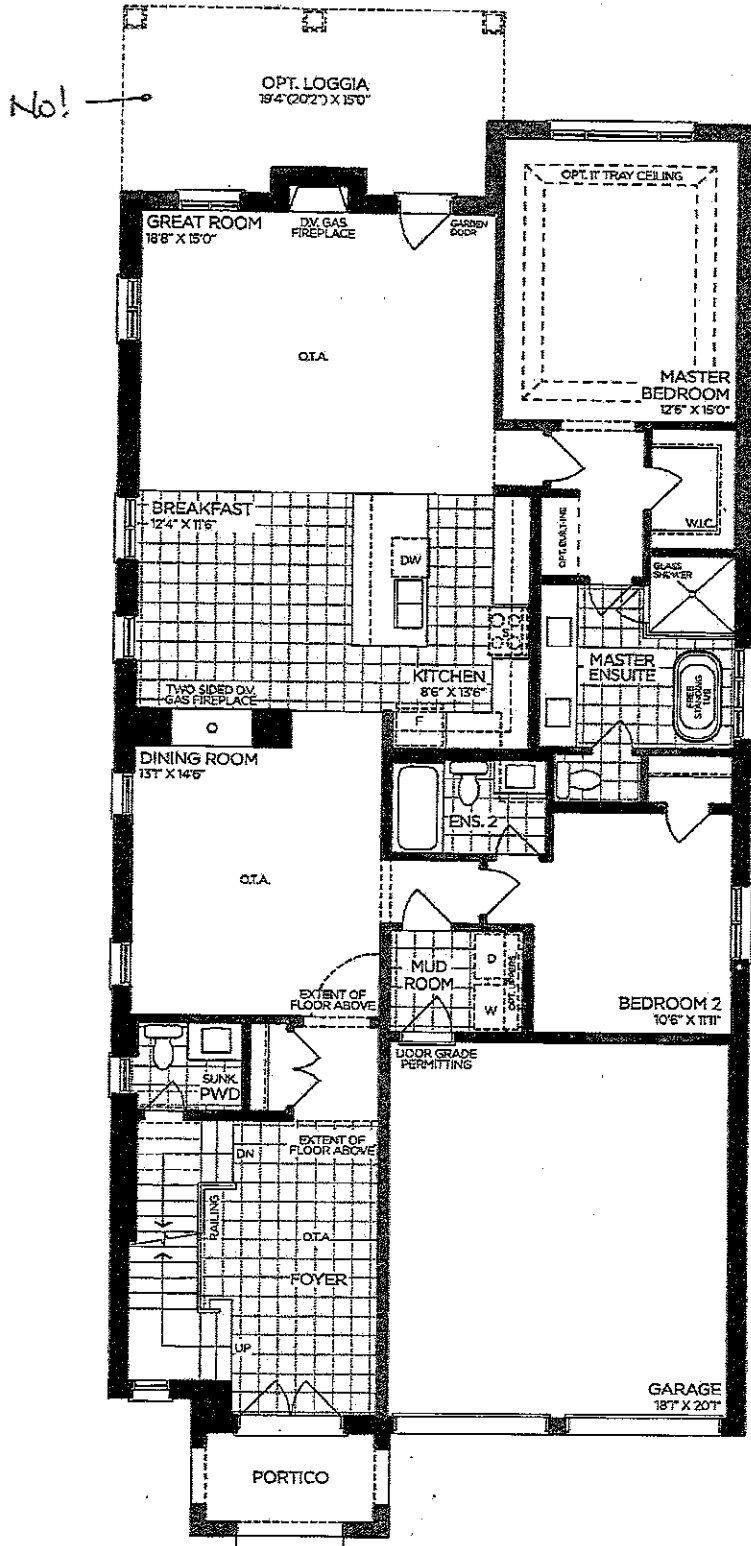

GROUND FLOOR | ELEV. A

[Handwritten signature]

VENDOR	
PURCHASER	
PURCHASER	

GOLDPARK
WORTH MORE™

Prices, figures, illustrations, sizes, features and finishes are subject to change without notice. Areas and dimensions are approximate and actual usable floor space may vary from the stated area. Layout may be reverse of the unit purchased. E. & O.E. 4201


SCHEDULE 'F'



PV-102 *el el el*
March 22 2020

The
Maplewood
42' SERIES

→ Elevation A • 2,770 sq.ft.
Elevation B • 2,725 sq.ft.

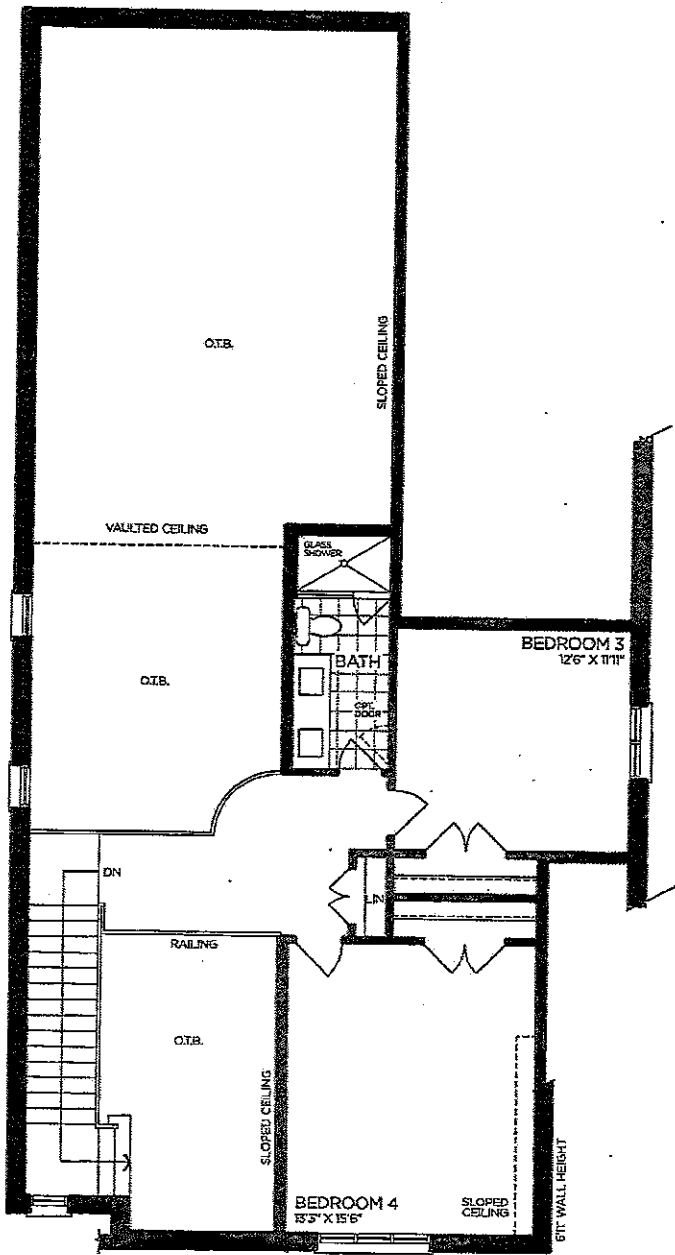

LOFT | ELEV. A

VENDOR	
PURCHASER	
PURCHASER	

GOLDPARK
WORTH MORE™

Prices, figures, illustrations, sizes, features and finishes are subject to change without notice. Areas and dimensions are approximate and actual usable floor space may vary from the stated area. Layout may be reverse of the unit purchased. E. & O.E. 4201

SCHEDULE 'F'



PV-102 *see attach*
March 22 2020

The Maplewood

42' SERIES

Elevation A • 2,770 sq.ft.


Elevation B • 2,725 sq.ft.

BACK FLOW
PREVENTER VALVE

9' BASEMENT
CEILING HEIGHT

24x30"

24x30"

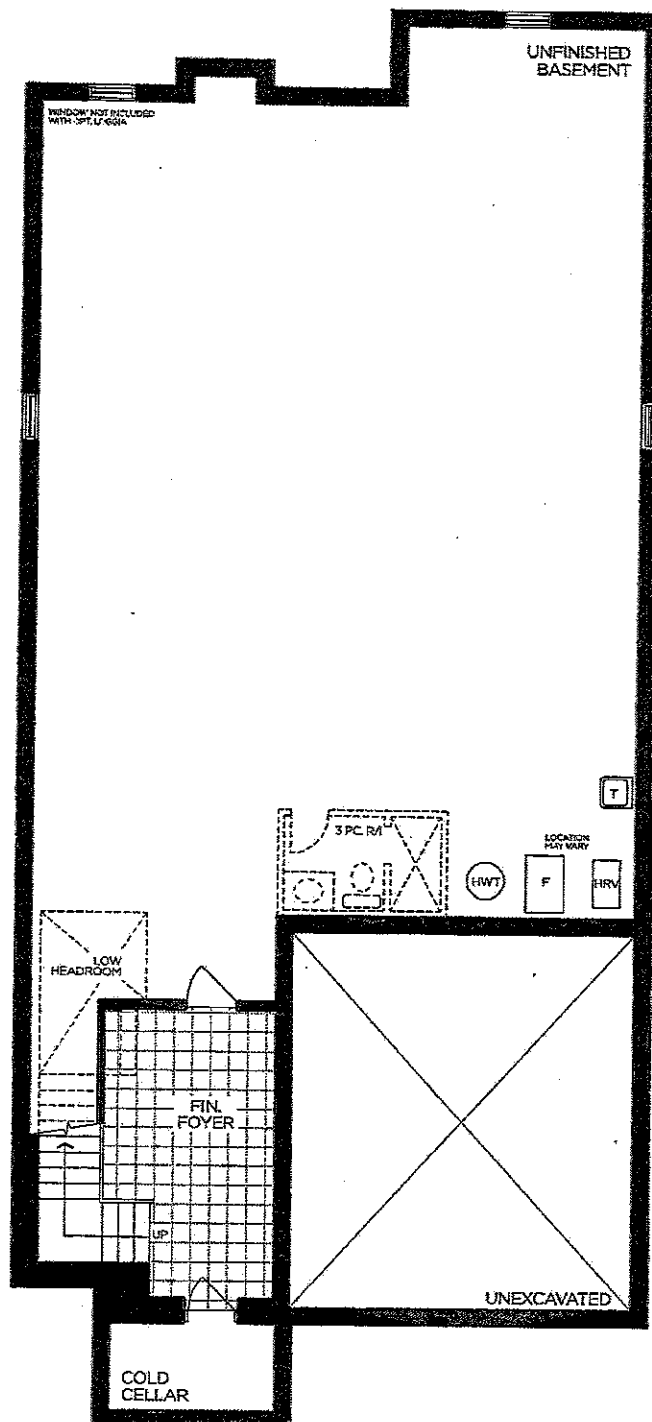

BASEMENT | ELEV. A

VENDOR
PURCHASER
PURCHASER

GOLDPARK

WORTH MORE™

Prices, figures, illustrations, sizes, features and finishes are subject to change without notice. Areas and dimensions are approximate and actual usable floor space may vary from the stated area. Layout may be reverse of the unit purchased. E. & O.E. 4201