



CONSTRUCTION SUMMARY

Lot: 122
Model: 40.02 A VALLEYVIEW
Project/Phase: Pine Valley Forevergreen / 1

CONCRETE AND DRAIN

Invoice	Qty.	Description
2208 31293 18Mar20 NoCat	1	BACK-FLOW PREVENTER VALVE

FRAMING

Invoice	Qty.	Description
2208 31296 18Mar20 NoCat	1	9' BASEMENT CEILING HEIGHT IN LIEU OF STANDARD 8' CEILING.

MISC.

Invoice	Qty.	Description
2208 31297 18Mar20 NoCat	1	-

PLUMBING

Invoice	Qty.	Description
2208 31627 18Mar20 NoCat	1	BACK-FLOW PREVENTER VALVE

WINDOWS - BASEMENT

Invoice	Qty.	Description
2208 31294 18Mar20 NoCat	2	UPGRADE EXISTING *REAR* BASEMENT WINDOWS - 47X35 MAY REQUIRE WINDOW WELL
2208 31295 18Mar20	2	UPGRADE EXISTING *SIDE* WINDOW TO 30X24 INCHES MAY REQUIRE WINDOW WELLS

This Document is Extremely Time Sensitive - Printed 18 Mar 20 at 15:21

PV Lot #122

SCHEDULE 'F'



PV-122

MAR 9 2020

The
Valleyview
40' SERIES

Elevation A • 3,145 sq.ft.
Elevation B • 3,170 sq.ft.


* 9' BASEMENT

* BACK FLOW
PREVENTER
VALVE

24x30"

47x35"

47x35"

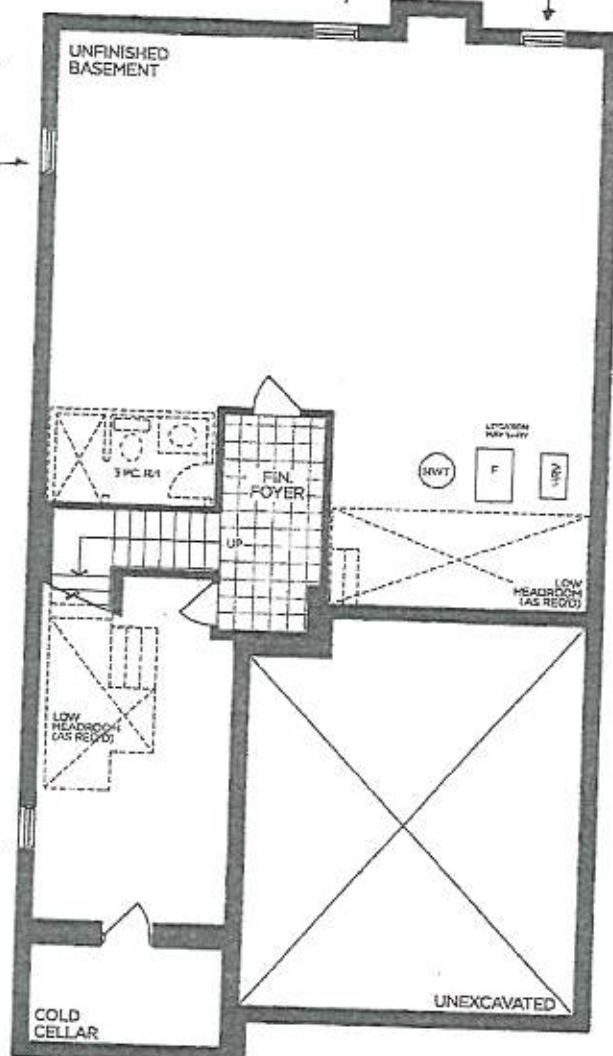

BASEMENT | ELEV. A

VENDOR
PURCHASER
PURCHASER

GOLDPARK
WORTH MORE

Prices, figures, illustrations, sizes, features and finishes are subject to change without notice. Areas and dimensions are approximate and actual usable floor space may vary from the stated area. Layout may be reverse of the unit purchased. E & OE. 0002

PV Lot #122

SCHEDULE 'F'




PV-122
March 9 2020



The
Valleyview
40' SERIES

→ Elevation A • 3,145 sq.ft.
Elevation B • 3,170 sq.ft.

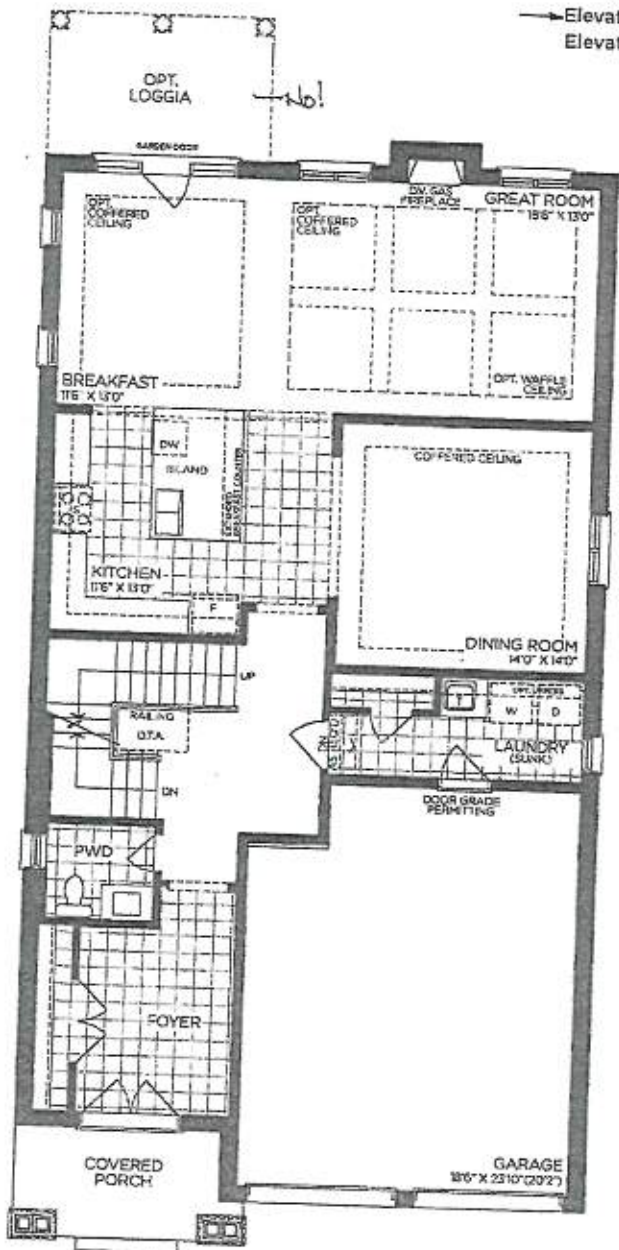

GROUND FLOOR | ELEV. A

VENDOR
PURCHASER
PURCHASER

GOLDPARK
WORTH MORE™

Prices, figures, illustrations, sizes, features and finishes are subject to change without notice. Area and dimensions are approximate and actual usable floor space may vary from the stated area. Layout may be reverse of the unit purchased. E & OE. 4002

PV Lot # 122

SCHEDULE 'P'




PV-122
MAR 9 2020

BB
2

The
Valleyview
40' SERIES

Elevation A • 3,145 sq.ft.
Elevation B • 3,170 sq.ft.

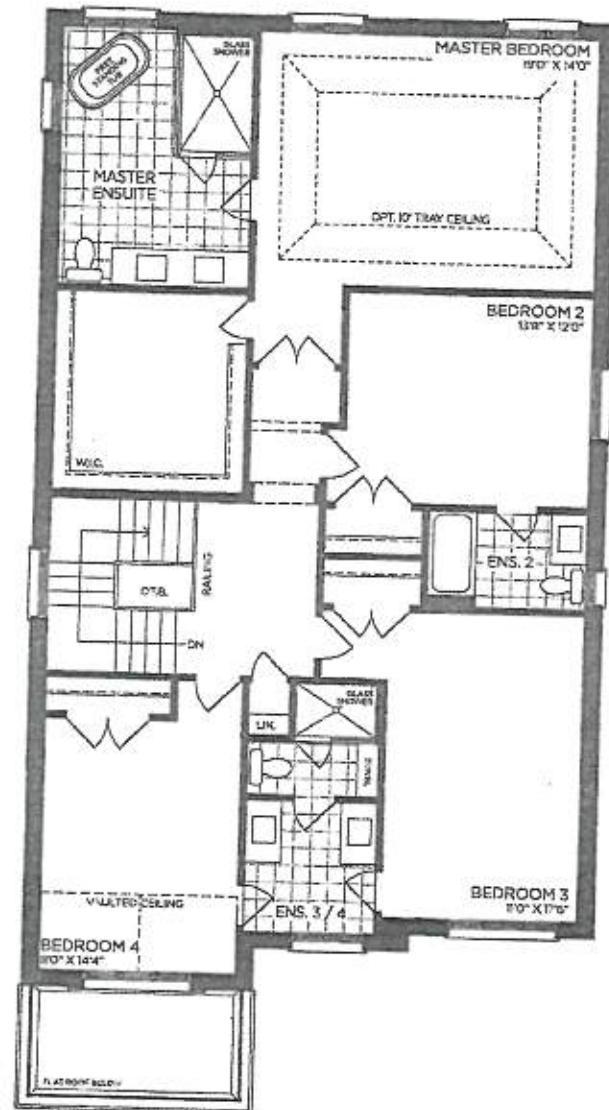

SECOND FLOOR | ELEV. A

VENDOR
PURCHASER
PURCHASER

GOLDPARK
WORTH MORE™

Prices, figures, illustrations, sizes, features and finishes are subject to change without notice. Areas and dimensions are approximate and actual usable floor space may vary from the stated area. Layout may be reverse of the unit purchased. E. & O.E. 4002