

CONCRETE AND DRAIN

Invoice	Qty.	Description
2202 31629 18Mar20 NoCat	1	BACK-FLOW PREVENTER VALVE

DRYWALL

Invoice	Qty.	Description
2202 31359 18Mar20 **	3	BASEMENT WINDOWS - UPGRADE BASEMENT WINDOW SIZE TO 30 " X 24" - 8" FRAME

ELECTRICAL

Invoice	Qty.	Description
2202 31359 18Mar20 **	3	BASEMENT WINDOWS - UPGRADE BASEMENT WINDOW SIZE TO 30 " X 24" - 8" FRAME

FORM - FORMING

Invoice	Qty.	Description
2202 31359 18Mar20 **	3	BASEMENT WINDOWS - UPGRADE BASEMENT WINDOW SIZE TO 30 " X 24" - 8" FRAME

INTERIOR TRIM /MOULDINGS

Invoice	Qty.	Description
2202 31359 18Mar20 **	3	BASEMENT WINDOWS - UPGRADE BASEMENT WINDOW SIZE TO 30 " X 24" - 8" FRAME

MISC.

Invoice	Qty.	Description
2202 31228 18Mar20 NoCat	1	

PAINTING

Invoice	Qty.	Description
2202 31359 18Mar20 **	3	BASEMENT WINDOWS - UPGRADE BASEMENT WINDOW SIZE TO 30 " X 24" - 8" FRAME

PANL - FRAMING

Invoice	Qty.	Description
2202 31359 18Mar20 **	3	BASEMENT WINDOWS - UPGRADE BASEMENT WINDOW SIZE TO 30 " X 24" - 8" FRAME

PLUMBING

Invoice	Qty.	Description
2202 31227 18Mar20 NoCat	1	BACK-FLOW PREVENTER VALVE
2202 31625 18Mar20 NoCat	1	BACK-FLOW PREVENTER VALVE

ROUGH CARPENTRY

Invoice	Qty.	Description
2202 31359 18Mar20 **	3	BASEMENT WINDOWS - UPGRADE BASEMENT WINDOW SIZE TO 30 " X 24" - 8" FRAME

WINDOWS - BASEMENT

Invoice	Qty.	Description
2202 31359 18Mar20	3	BASEMENT WINDOWS - UPGRADE BASEMENT WINDOW SIZE TO 30 " X 24" - 8" FRAME
2202 31359 18Mar20	3	BASEMENT WINDOWS - UPGRADE BASEMENT WINDOW SIZE TO 30 " X 24" - 8" FRAME

This Document is Extremely Time Sensitive - Printed 18 Mar 20 at 15:38

PV LOT # 126

SCHEDULE 'F'




PV-126
March 11 2020



The
Brookside
40' SERIES

Elevation A • 3,380 sq.ft.

→ Elevation B • 3,350 sq.ft.

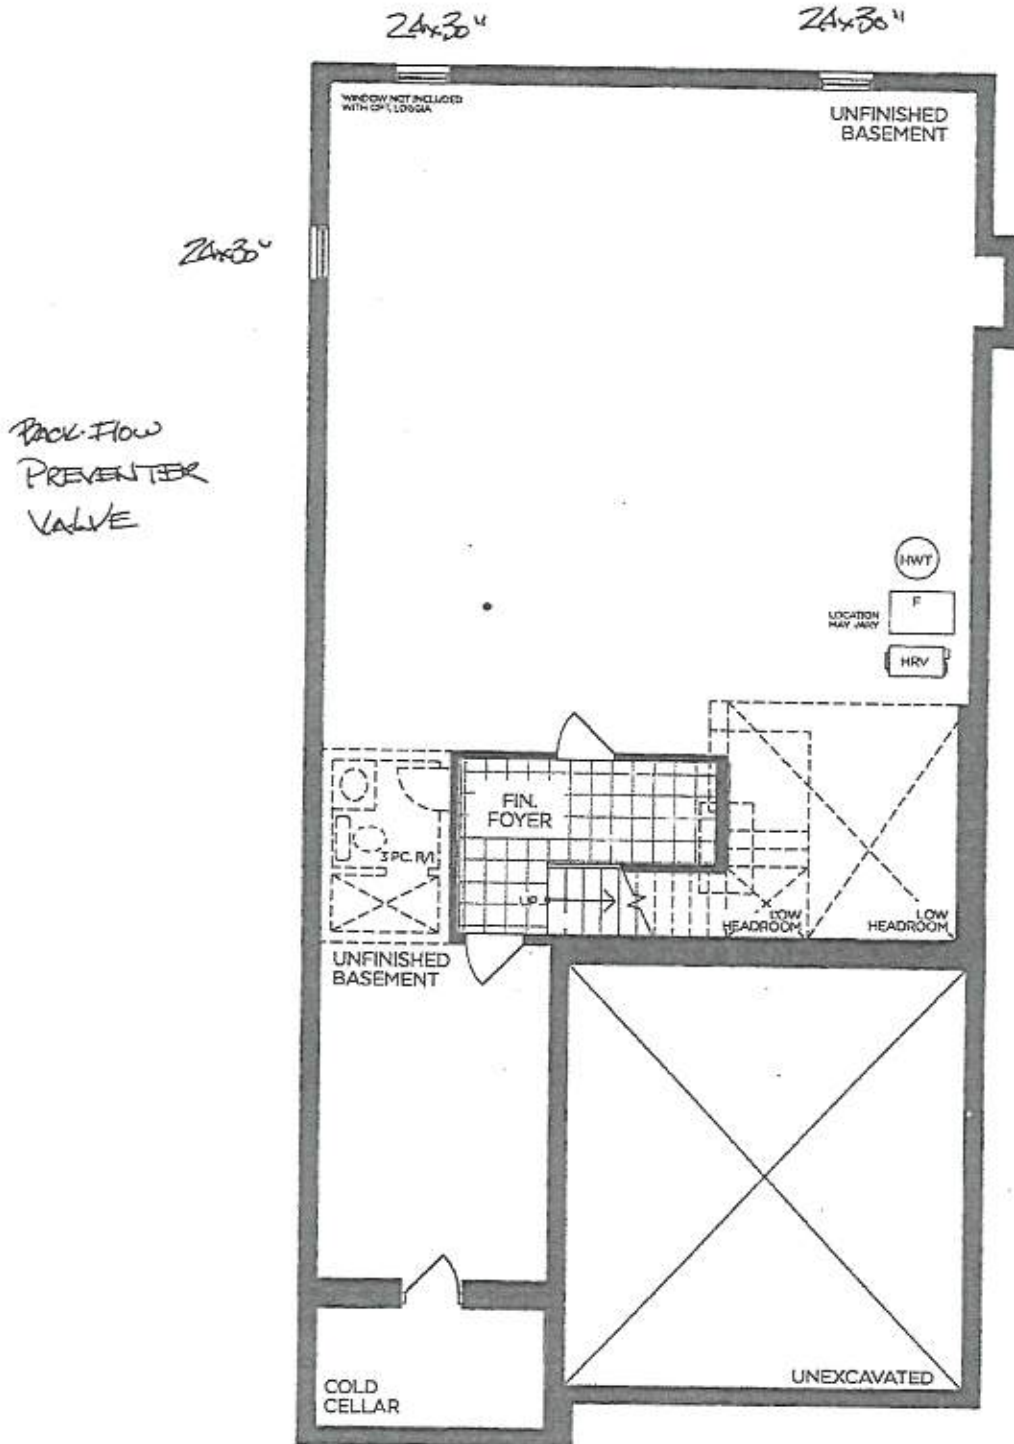

BASEMENT | ELEV. A



VENDOR
PURCHASER
PURCHASER

GOLDPARK
WORTH MORE™

Prices, figures, illustrations, sizes, features and finishes are subject to change without notice. Areas and dimensions are approximate and actual usable floor space may vary from the stated area. Layout may be reverse of the unit purchased. E. & O.E. 4003