



CONSTRUCTION SUMMARY

Lot: 117
Model: 40.06 A LILAC
Project/Phase: Pine Valley Forevergreen / 1

CONCRETE AND DRAIN

Invoice	Qty.	Description
2254 31985 31Mar20 NoCat	1	BACK-FLOW PREVENTER VALVE CONCRETE AND DRAIN

WINDOWS - BASEMENT

Invoice	Qty.	Description
2254 31931 31Mar20	1	BASEMENT WINDOWS - UPGRADE BASEMENT WINDOW SIZE TO 30 " X 24" - 8" FRAME WINDOWS - BASEMENT72,351WINDOWS - BASEMENT
2254 31931 31Mar20	1	BASEMENT WINDOWS - UPGRADE BASEMENT WINDOW SIZE TO 30 " X 24" - 8" FRAME WINDOWS - BASEMENT72,351WINDOWS - BASEMENT

This Document is Extremely Time Sensitive - Printed 31 Mar 20 at 11:22

SCHEDULE 'F'



PV-117
March 30 2020


The Lilac

40' SERIES

→ Elevation A • 3,425 sq.ft.
Elevation B • 3,385 sq.ft.

LOB

24x30⁴

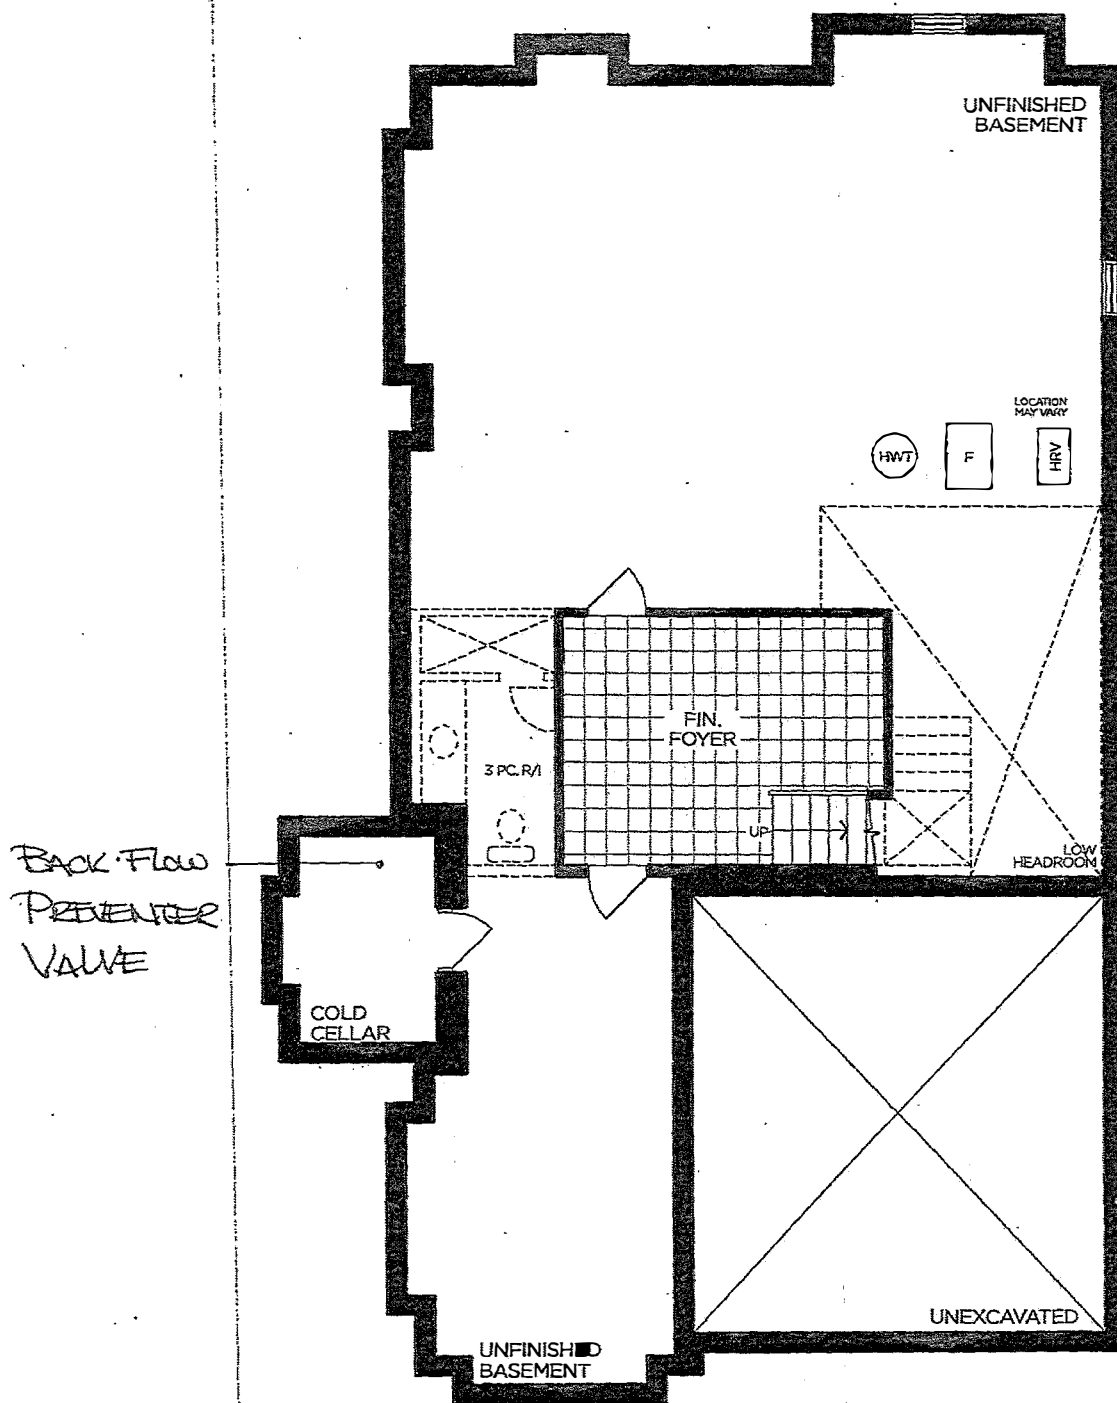

BASEMENT | ELEV. A

VENDOR	
PURCHASER	
PURCHASER	

GOLDPARK
WORTH MORE™

Prices, figures, illustrations, sizes, features and finishes are subject to change without notice. Areas and dimensions are approximate and actual usable floor space may vary from the stated area. Layout may be reverse of the unit purchased. E. & O.E. 4006


SCHEDULE 'F'



PV-117
March 30 2020

The
Lilac
40' SERIES

→ Elevation A • 3,425 sq.ft.
Elevation B • 3,385 sq.ft.

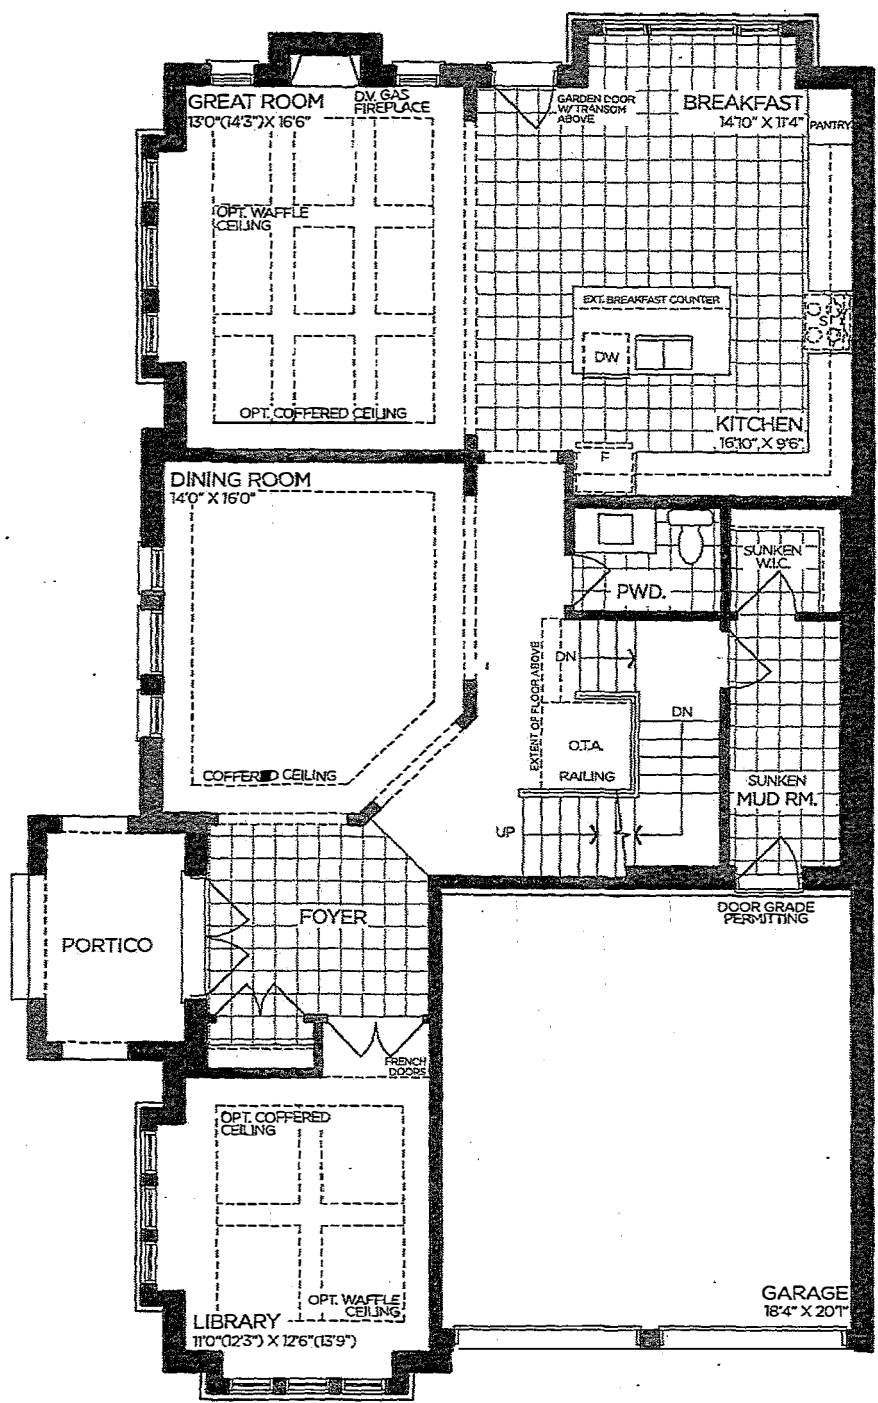

GROUND FLOOR | ELEV. A

VENDOR

PURCHASER

PURCHASER

GOLDPARK
WORTH MORE™

Prices, figures, illustrations, sizes, features and finishes are subject to change without notice. Areas and dimensions are approximate and actual usable floor space may vary from the stated area. Layout may be reverse of the unit purchased. E. & O.E. 4006


SCHEDULE 'F'



PV-117
March 30 2020

The Lilac 40' SERIES

→ Elevation A • 3,425 sq.ft.
Elevation B • 3,385 sq.ft.

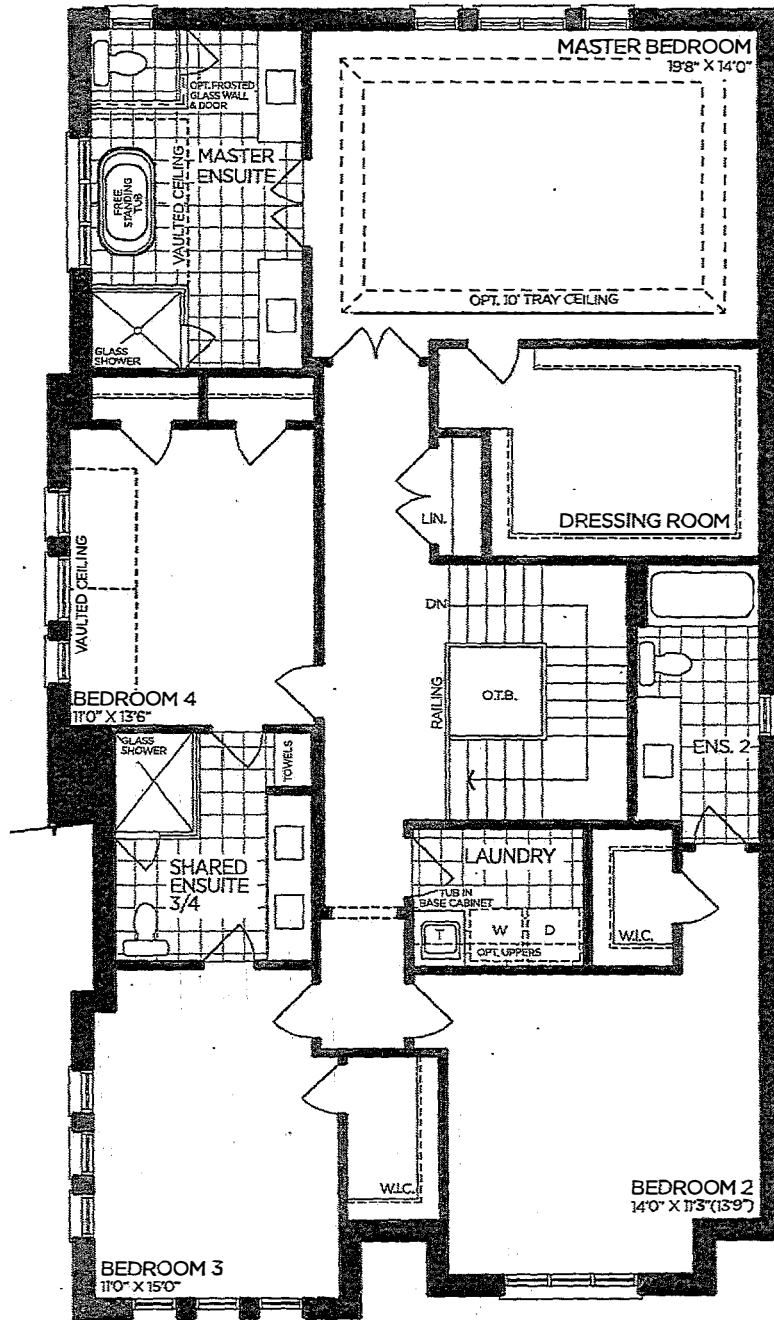

SECOND FLOOR | ELEV. A

VENDOR	
PURCHASER	
PURCHASER	

GOLDPARK
WORTH MORE™

Prices, figures, illustrations, sizes, features and finishes are subject to change without notice. Areas and dimensions are approximate and actual usable floor space may vary from the stated area. Layout may be reverse of the unit purchased. E. & O.E. 4006