

CONCRETE AND DRAIN

Invoice Qty. Description

2258 31986	1	BACK-FLOW PREVENTER VALVE
31Mar20 NoCat		CONCRETE AND DRAIN

WINDOWS - BASEMENT

Invoice Qty. Description

2258 31959	2	BASEMENT WINDOWS - UPGRADE BASEMENT WINDOW SIZE TO 30 " X 24" - 8" FRAME
31Mar20		WINDOWS - BASEMENT 72,351 WINDOWS - BASEMENT

SCHEDULE 'F'




FV-118
 MAR 30 2020

The Valleyview

40' SERIES

→ Elevation A • 3,145 sq.ft.
 Elevation B • 3,170 sq.ft.

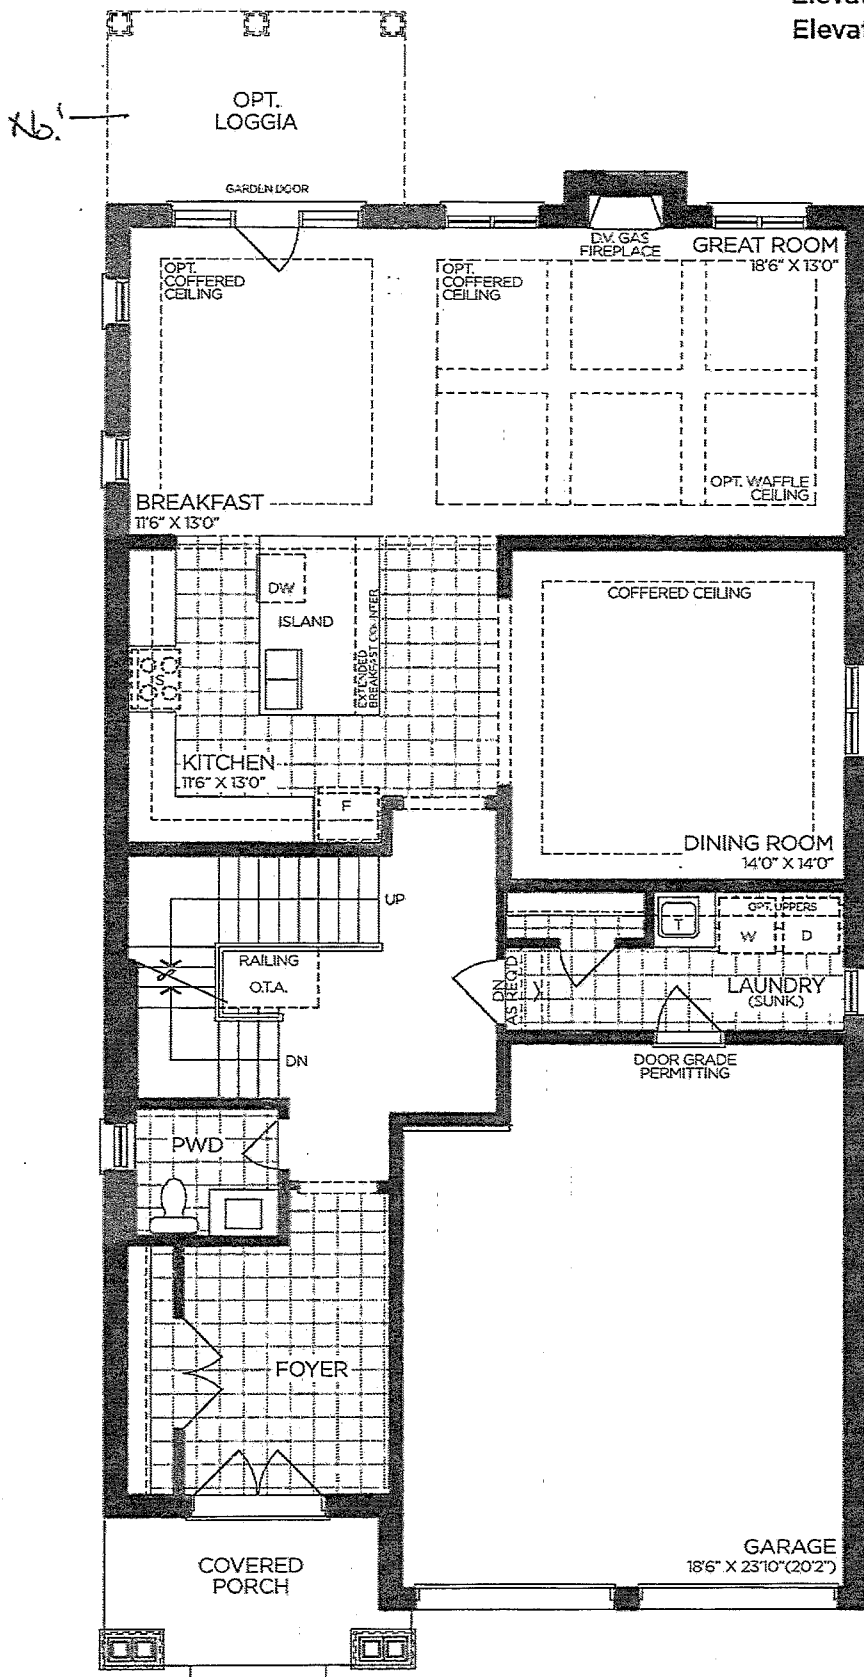

GROUND FLOOR | ELEV. A

VENDOR

PURCHASER

PURCHASER

GOLDPARK
 WORTH MORE™

Prices, figures, illustrations, sizes, features and finishes are subject to change without notice. Areas and dimensions are approximate and actual usable floor space may vary from the stated area. Layout may be reverse of the unit purchased. E. & O.E. 4002


SCHEDULE 'F'



PV-118
 MAR 30 2020

The
Valleyview
 40' SERIES

→ Elevation A • 3,145 sq.ft.
 Elevation B • 3,170 sq.ft.

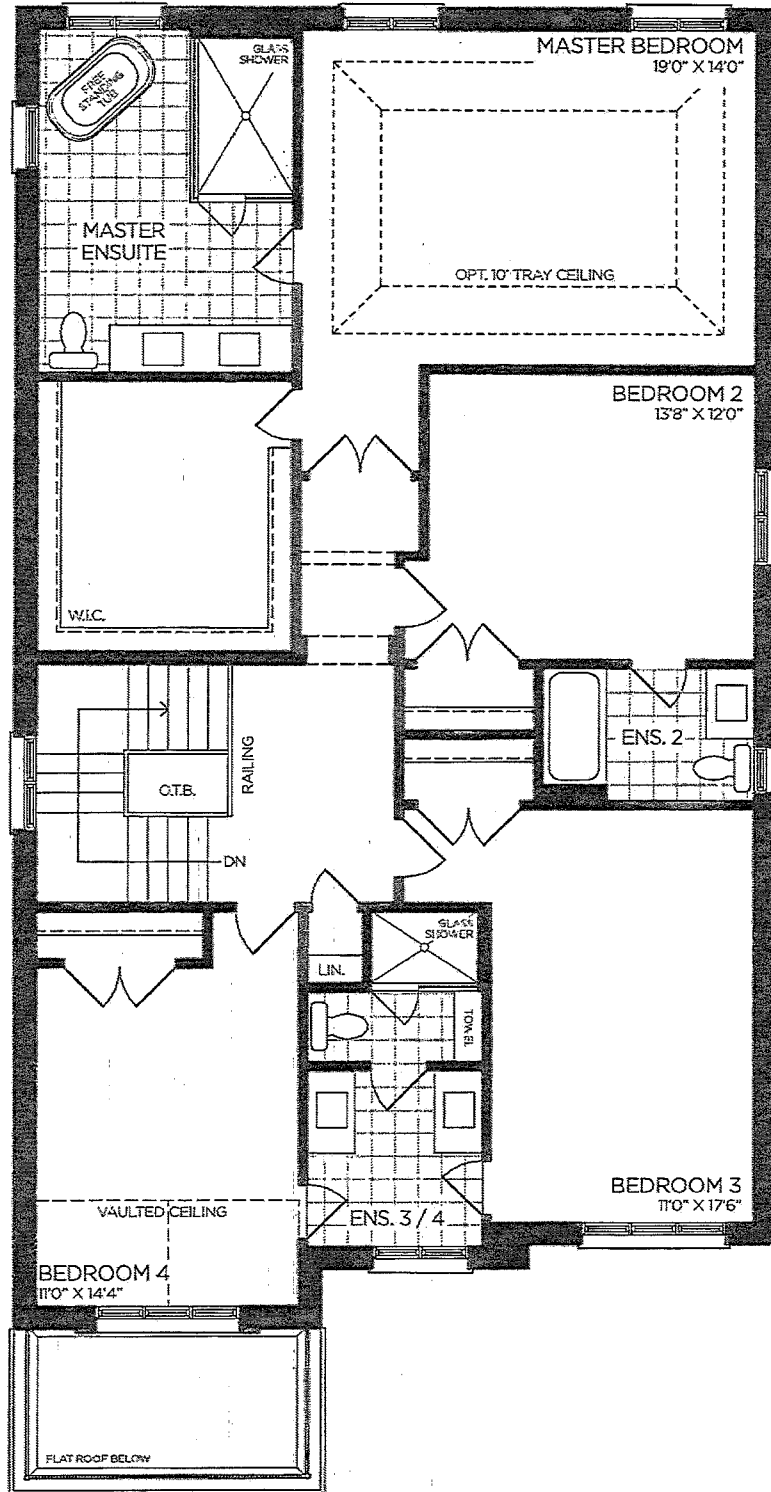

SECOND FLOOR | ELEV. A

VENDOR

PURCHASER

PURCHASER

GOLDPARK
 WORTH MORE™

Prices, figures, illustrations, sizes, features and finishes are subject to change without notice. Areas and dimensions are approximate and actual usable floor space may vary from the stated area. Layout may be reverse of the unit purchased. E. & O.E. 4002

SCHEDULE 'F'




PV1118
March 30 2020

The Valleyview

40' SERIES

→ Elevation A • 3,145 sq.ft.
Elevation B • 3,170 sq.ft.

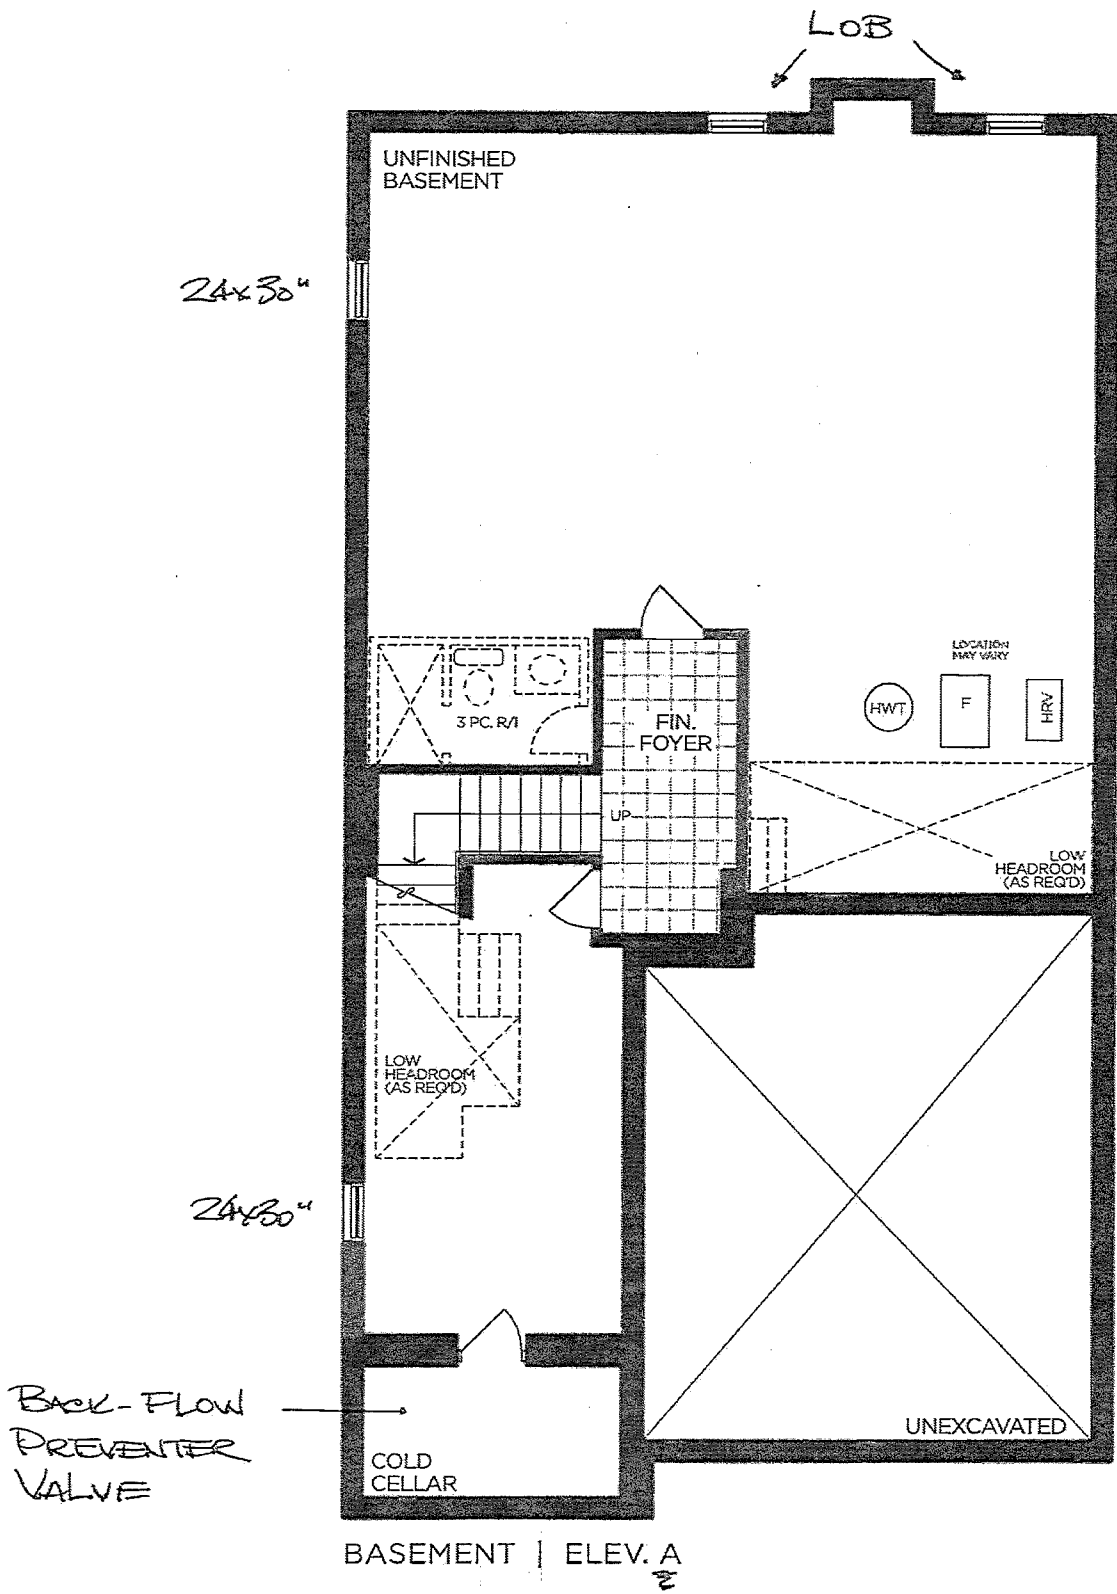

VENDOR

PURCHASER

PURCHASER

GOLDPARK
WORTH MORE™

Prices, figures, illustrations, sizes, features and finishes are subject to change without notice. Areas and dimensions are approximate and actual usable floor space may vary from the stated area. Layout may be reverse of the unit purchased. E. & O.E. 4002