

CONCRETE AND DRAIN

Invoice	Qty.	Description
2262 32004 01Apr20 NoCat	1	BACK-FLOW PREVENTER VALVE CONCRETE AND DRAIN

WINDOWS - BASEMENT

Invoice	Qty.	Description
2262 31960 01Apr20	1	BASEMENT WINDOWS - UPGRADE BASEMENT WINDOW SIZE TO 30 " X 24" - 8" FRAME WINDOWS - BASEMENT72,351WINDOWS - BASEMENT
2262 31960 01Apr20	1	BASEMENT WINDOWS - UPGRADE BASEMENT WINDOW SIZE TO 30 " X 24" - 8" FRAME WINDOWS - BASEMENT72,351WINDOWS - BASEMENT
2262 32003 01Apr20	2	BASEMENT WINDOWS - EGRESS BASEMENT WINDOW 47 " X 35" - 8" FRAME WINDOWS - BASEMENT72,672WINDOWS - BASEMENT

This Document is Extremely Time Sensitive - Printed 1 Apr 20 at 14:35


SCHEDULE 'F'



PV-116
April 1 2020

The
Brookside
40' SERIES

→ Elevation A • 3,380 sq.ft.
Elevation B • 3,350 sq.ft.

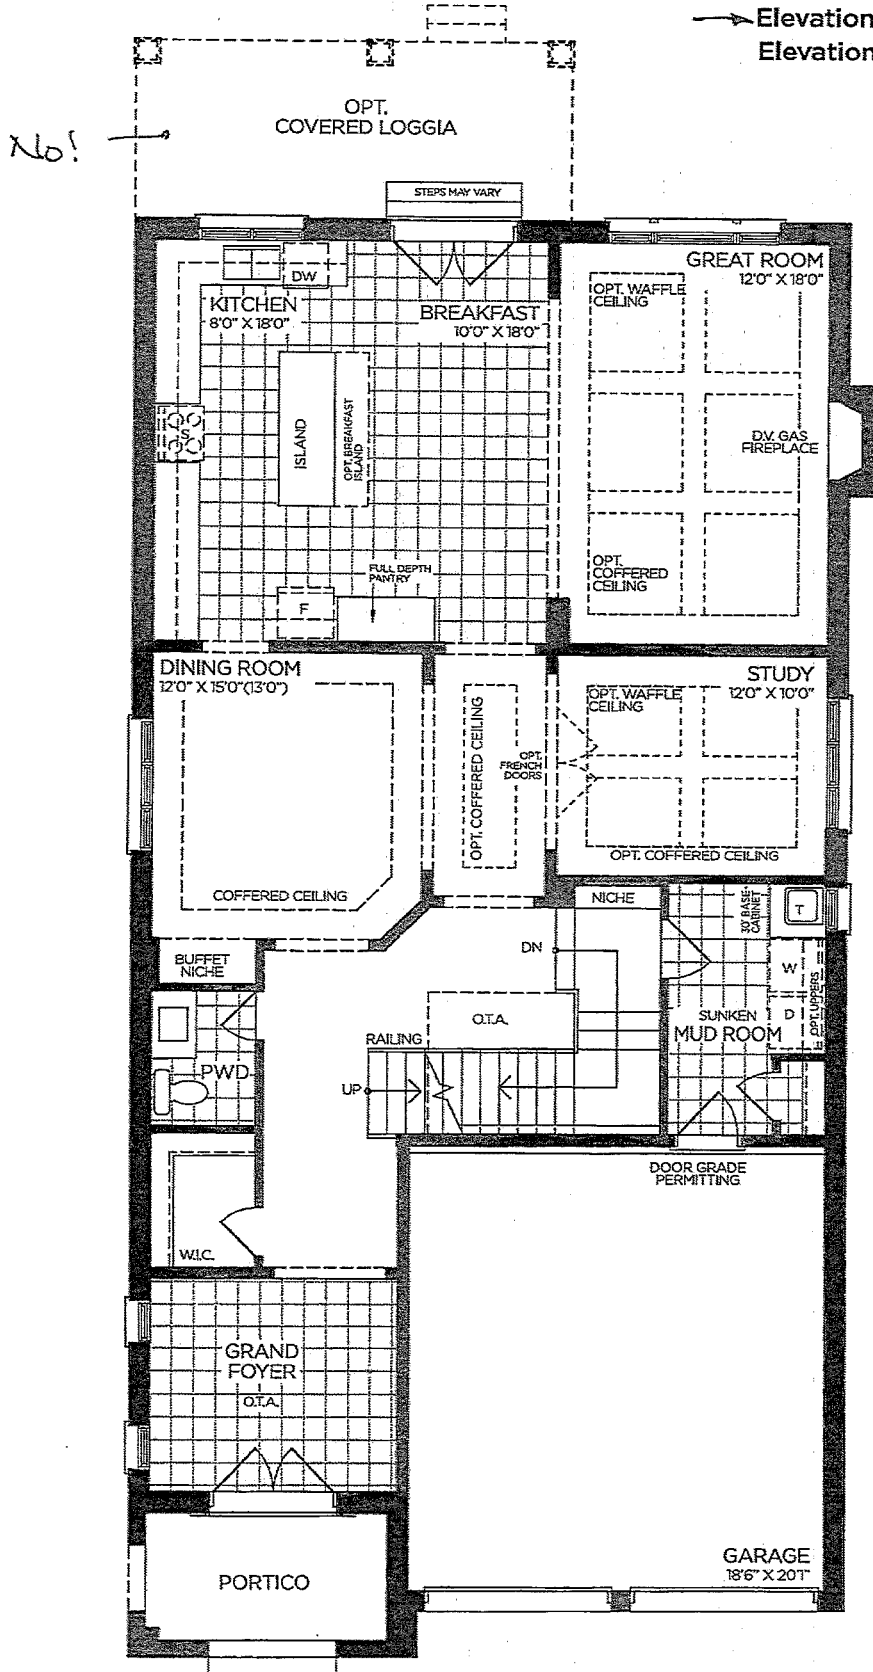

GROUND FLOOR | ELEV. A

VENDOR	
PURCHASER	
PURCHASER	

GOLDPARK
WORTH MORE™

Prices, figures, illustrations, sizes, features and finishes are subject to change without notice. Areas and dimensions are approximate and actual usable floor space may vary from the stated area. Layout may be reverse of the unit purchased. E. & O.E. 4003


SCHEDULE 'F'



PV-116
April 1 2020

The
Brookside
40' SERIES

→ Elevation A • 3,380 sq.ft.
Elevation B • 3,350 sq.ft.

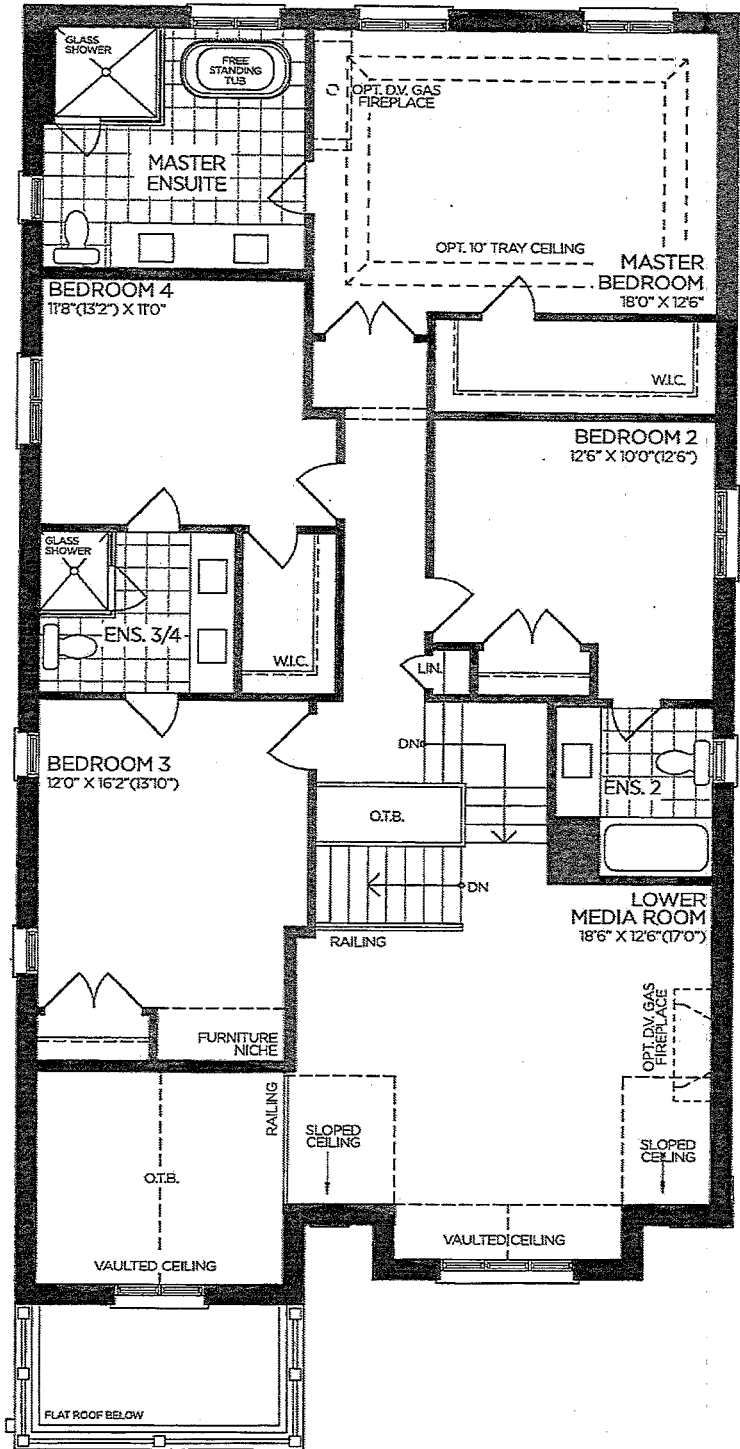

SECOND FLOOR | ELEV. A

VENDOR	
PURCHASER	
PURCHASER	

GOLDPARK
WORTH MORE™

Prices, figures, illustrations, sizes, features and finishes are subject to change without notice. Areas and dimensions are approximate and actual usable floor space may vary from the stated area. Layout may be reverse of the unit purchased. E. & O.E. 4003


SCHEDULE 'F'



PV-116
APRIL 1 2020

The
Brookside
40' SERIES

Elevation A • 3,380 sq.ft.
Elevation B • 3,350 sq.ft.

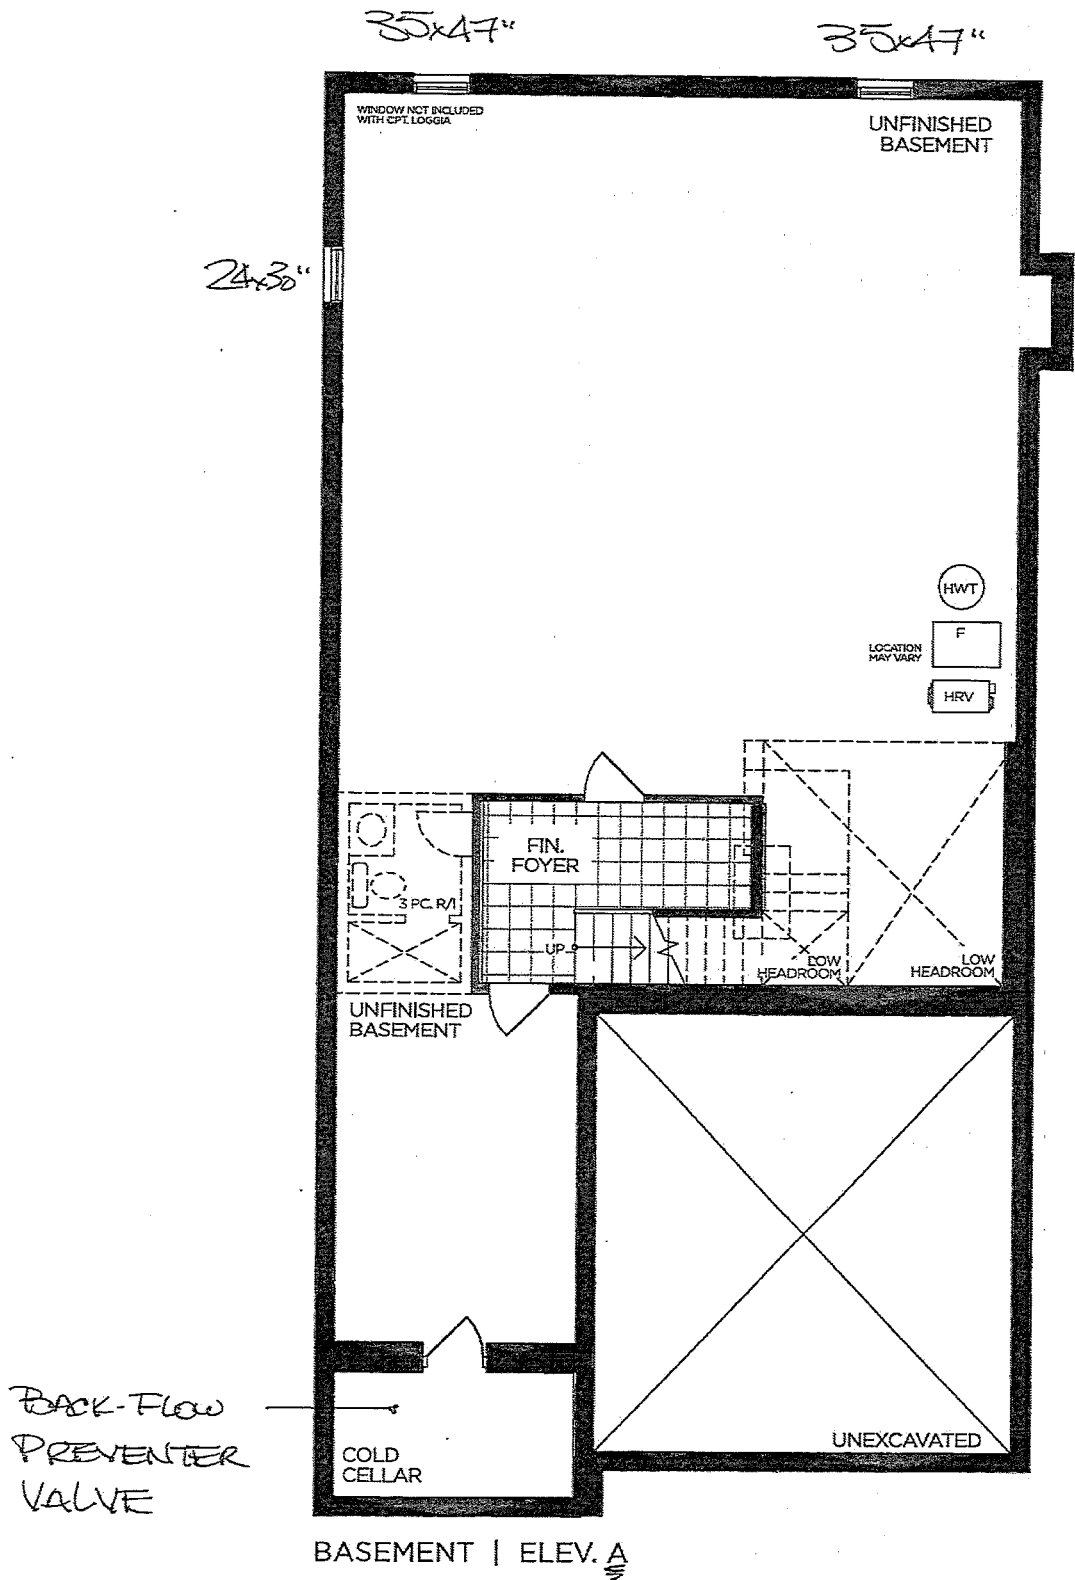

VENDOR

PURCHASER

PURCHASER

GOLDPARK
WORTH MORE™

Prices, figures, illustrations, sizes, features and finishes are subject to change without notice. Areas and dimensions are approximate and actual usable floor space may vary from the stated area. Layout may be reverse of the unit purchased. E. & O.E. 4003