

CONCRETE AND DRAIN

Invoice	Qty.	Description
2261 32001 01Apr20 NoCst	1	BACK-FLOW PREVENTER VALVE CONCRETE AND DRAIN

WINDOWS - BASEMENT

Invoice	Qty.	Description
2261 31999 01Apr20	2	BASEMENT WINDOWS - JGRESS BASEMENT WINDOW 47 " X 35" - 8" FRAME WINDOWS - BASEMENT 72,672 WINDOWS - BASEMENT
2261 32000 01Apr20	1	BASEMENT WINDOWS - UPGRADE BASEMENT WINDOW SIZE TO 30 " X 24" - 8" FRAME WINDOWS - BASEMENT 72,351 WINDOWS - BASEMENT
2261 32000 01Apr20	1	BASEMENT WINDOWS - UPGRADE BASEMENT WINDOW SIZE TO 30 " X 24" - 8" FRAME WINDOWS - BASEMENT 72,351 WINDOWS - BASEMENT

This Document is Extremely Time Sensitive - Printed 1 Apr 20 at 14:35

SCHEDULE 'F'




PV-131
April 1 2020

The Brookvalley

42' SERIES

Elevation A - 3,665 sq.ft.
Elevation B - 3,705 sq.ft.

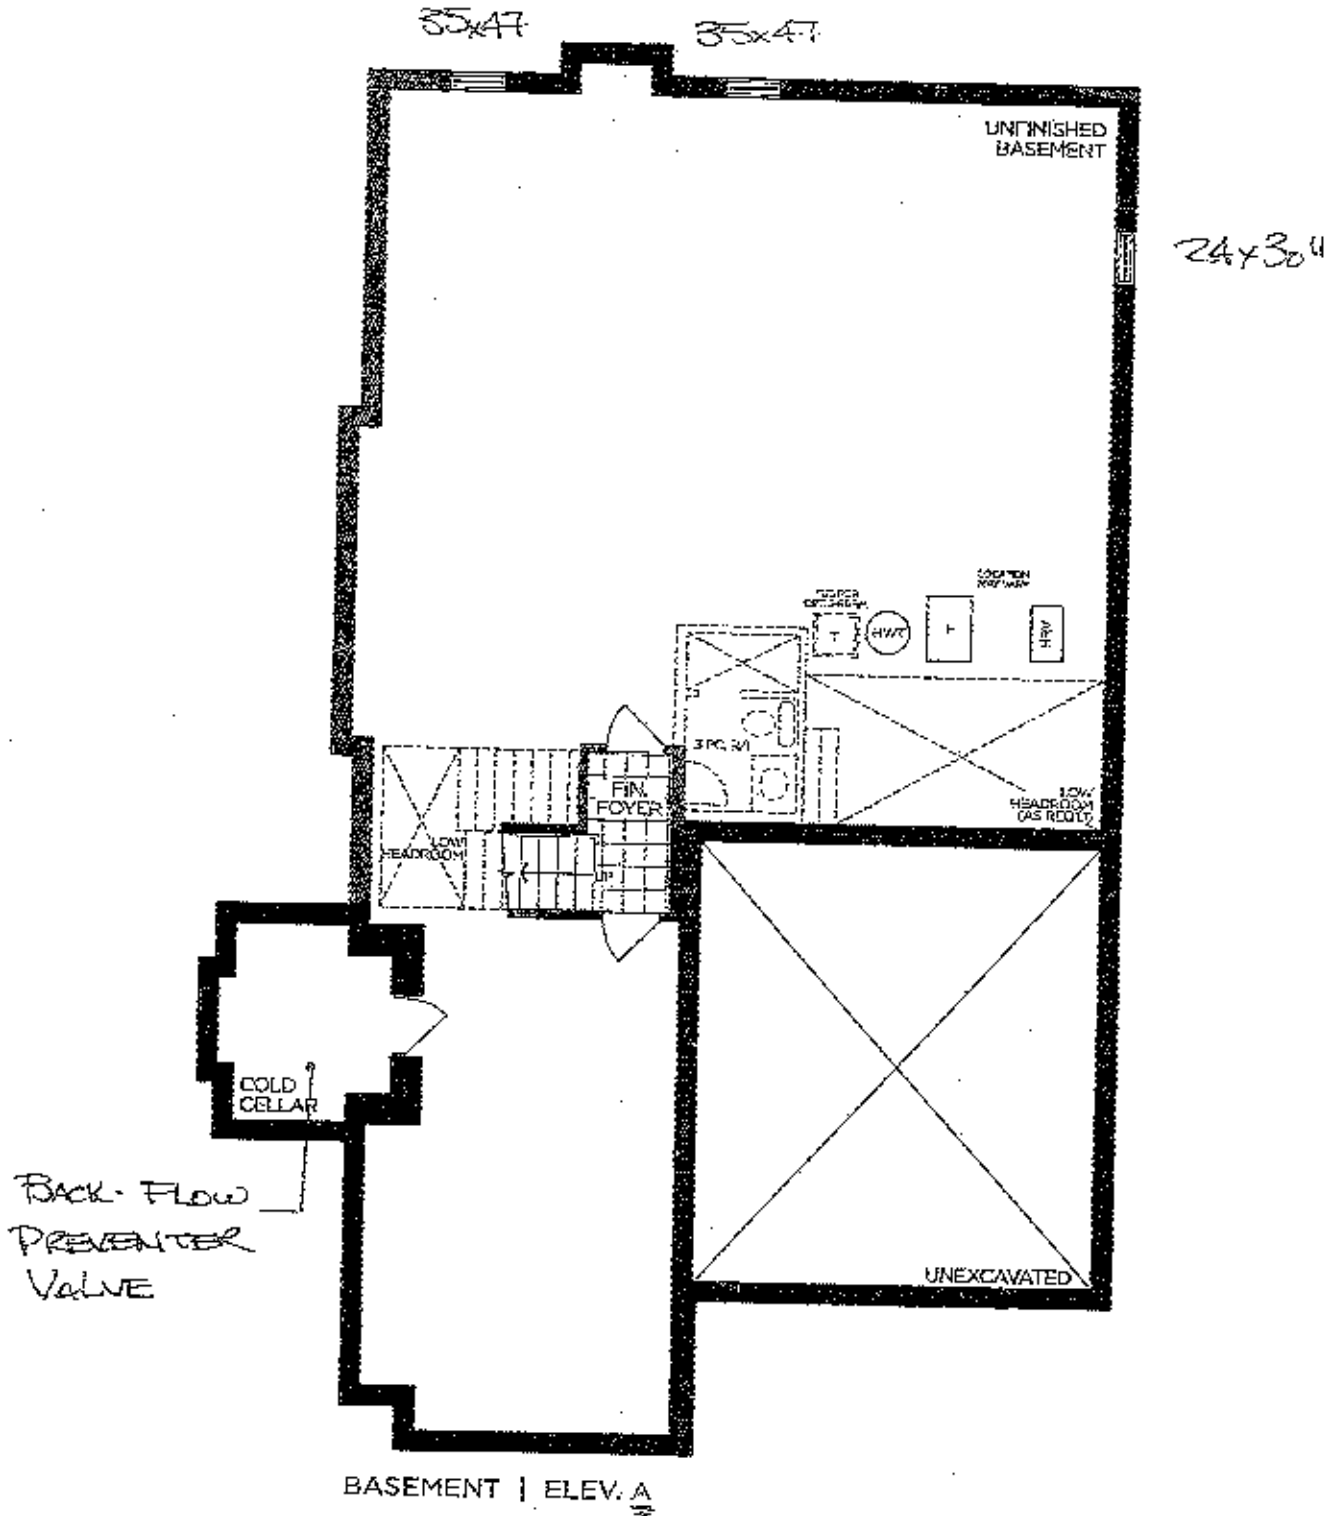

VENDOR	
PURCHASER	
PURCHASER	

GOLDPARK
WORTH MORE

Prices, figures, illustrations, sizes, features and finishes are subject to change without notice. Areas and dimensions are approximate and actual usable floor space may vary from the stated area. Layout may be reverse of the unit purchased. E. & O.E. 4204


SCHEDULE 'F'



FV-131
APRIL 1 2020

The Brookvalley 42' SERIES

Elevation A - 3,665 sq.ft.
Elevation B - 3,705 sq.ft.

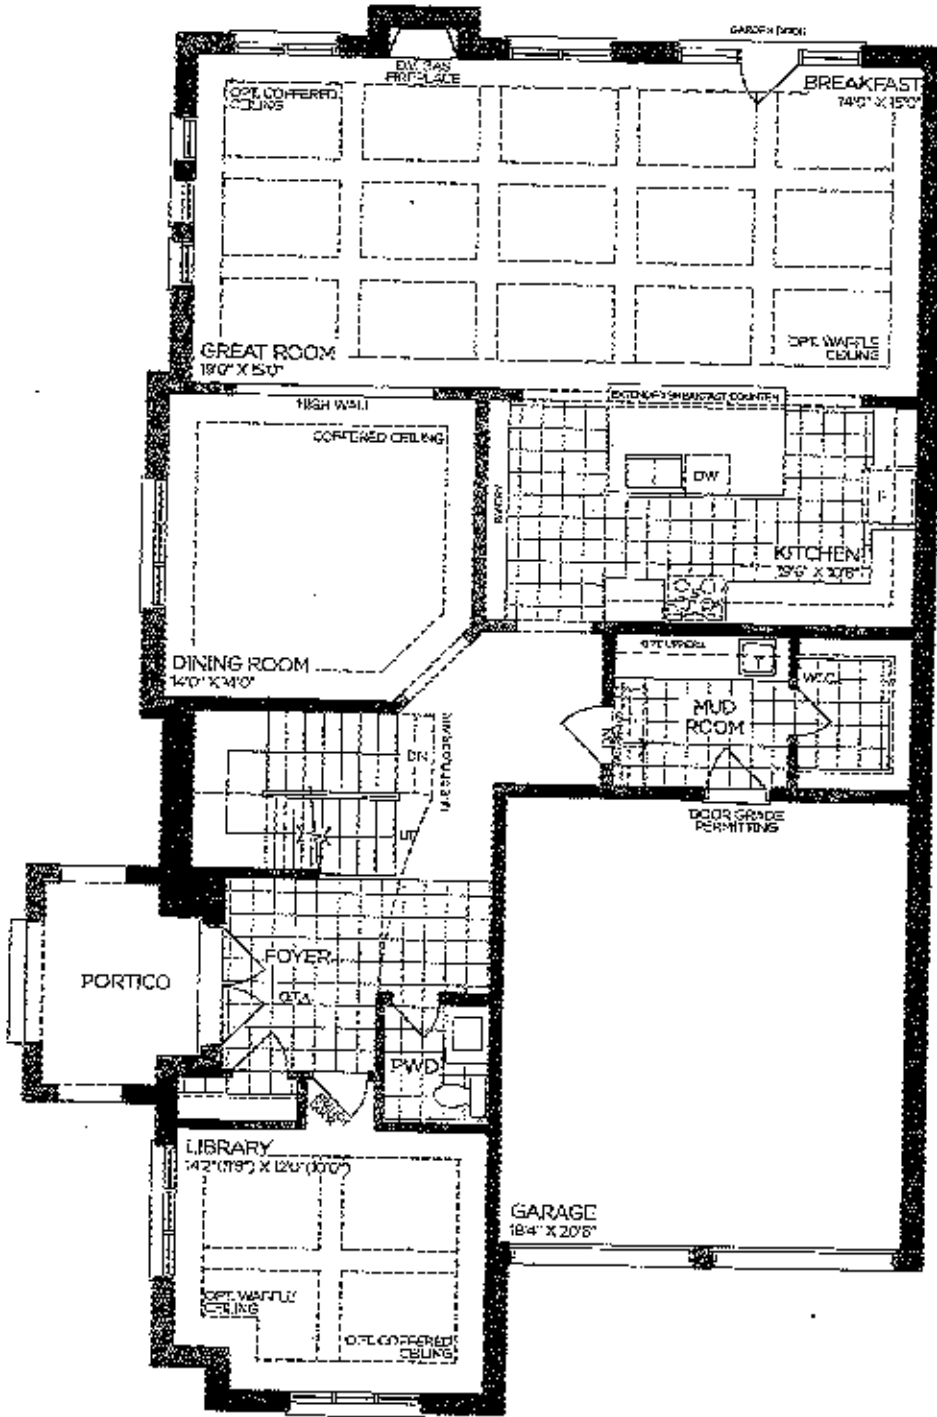

GROUND FLOOR | ELEV. A

VENDOR

PURCHASER

PURCHASER

GOLDPARK
WORTH MORE™

Prices, features, illustrations, sizes, features and finishes are subject to change without notice. Areas and dimensions are approximate and actual usable floor space may vary from the stated area. Layout may be reverse of the unit purchased. E. & O.E. 4204

SCHEDULE 'F'




FV-131
APRIL 1, 2020

The Brookvalley

42' SERIES

Elevation A • 3,665 sq.ft.

Elevation B • 3,705 sq.ft.

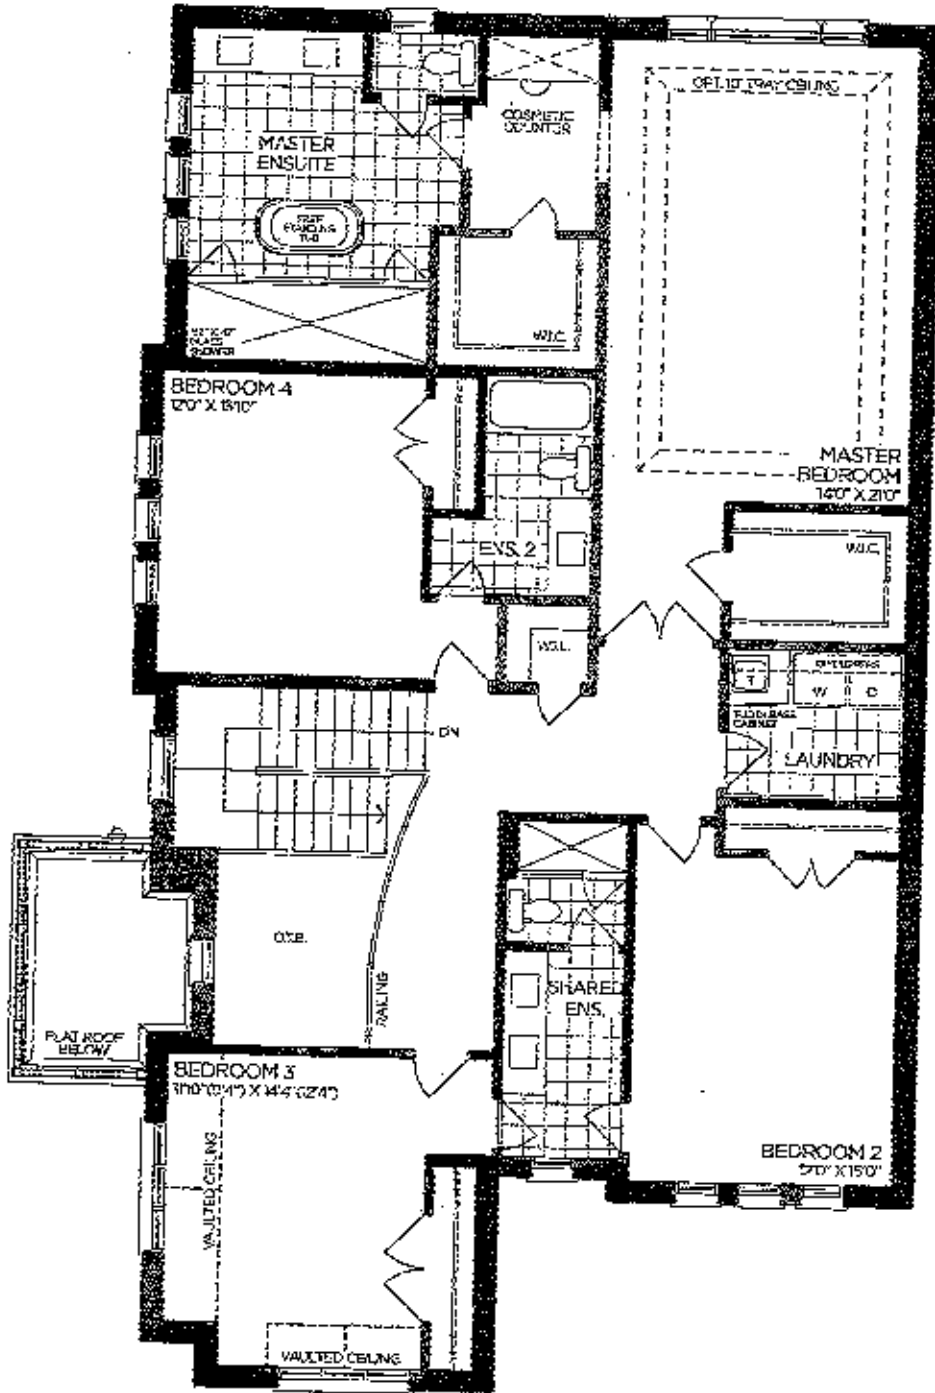

SECOND FLOOR | ELEV. A

VENDOR
PURCHASER
PURCHASER

GOLDPARK
WORTH MORE™

Prices, figures, illustrations, sizes, features and finishes are subject to change without notice. Areas and dimensions are approximate and actual usable floor space may vary from the stated area. Layout may be reverse of the unit purchased. S. & O.S. 4204