

CONCRETE AND DRAIN

| Invoice                           | Qty. | Description               |
|-----------------------------------|------|---------------------------|
| 2270<br>32024<br>06Apr20<br>NoCat | 1    | BACK-FLOW PREVENTER VALVE |

WINDOWS - BASEMENT

| Invoice                  | Qty. | Description                                                              |
|--------------------------|------|--------------------------------------------------------------------------|
| 2270<br>32023<br>06Apr20 | 1    | BASEMENT WINDOWS - UPGRADE BASEMENT WINDOW SIZE TO 30 " X 24" - 8" FRAME |
| 2270<br>32023<br>06Apr20 | 1    | BASEMENT WINDOWS - UPGRADE BASEMENT WINDOW SIZE TO 30 " X 24" - 8" FRAME |

This Document is Extremely Time Sensitive - Printed 6 Apr 20 at 15:33

SCHEDULE 'F'




PV-135 DS JS  
APRIL 3 2020

# The Brookside

## 40' SERIES

Elevation A • 3,380 sq.ft.

Elevation B • 3,350 sq.ft.

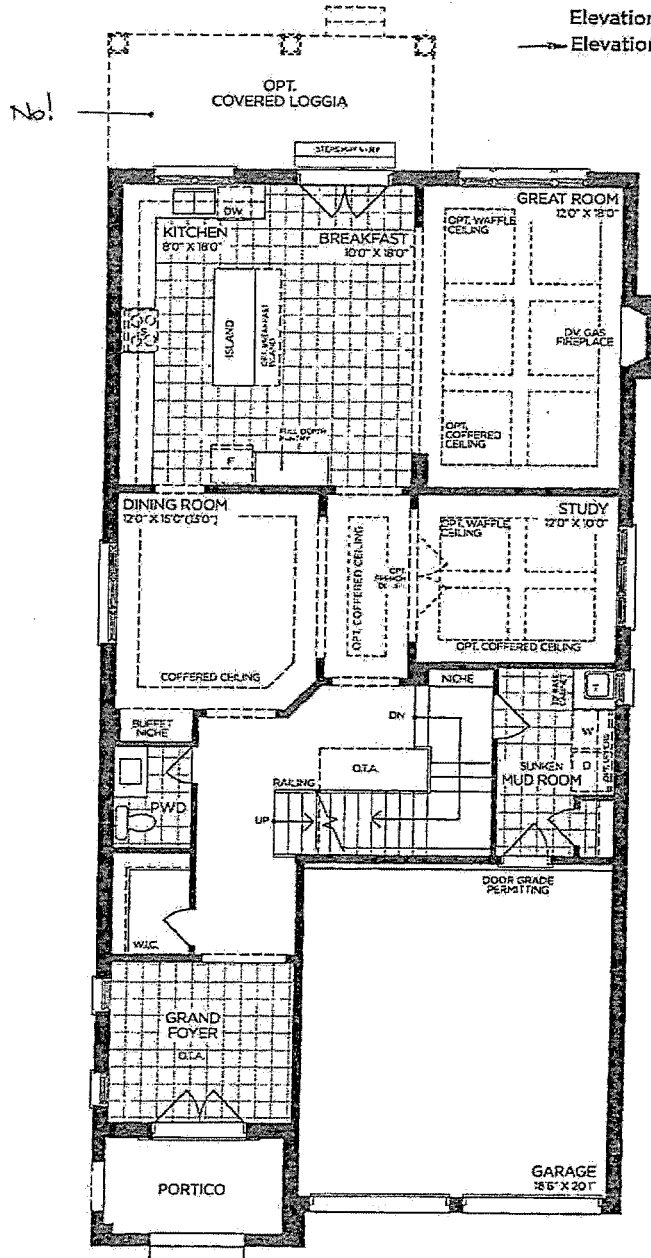

GROUND FLOOR | ELEV. A

VENDOR   
PURCHASER   
PURCHASER

**GOLDPARK**  
WORTH MORE™

Prices, figures, illustrations, sizes, features and finishes are subject to change without notice. Areas and dimensions are approximate and actual usable floor space may vary from the stated area. Layout may be reverse of the unit purchased. E. & C.E. 4003

SCHEDULE 'F'




PV-135. 05 05  
April 3 2020

# The Brookside 40' SERIES

Elevation A • 3,380 sq.ft.

→ Elevation B • 3,350 sq.ft.

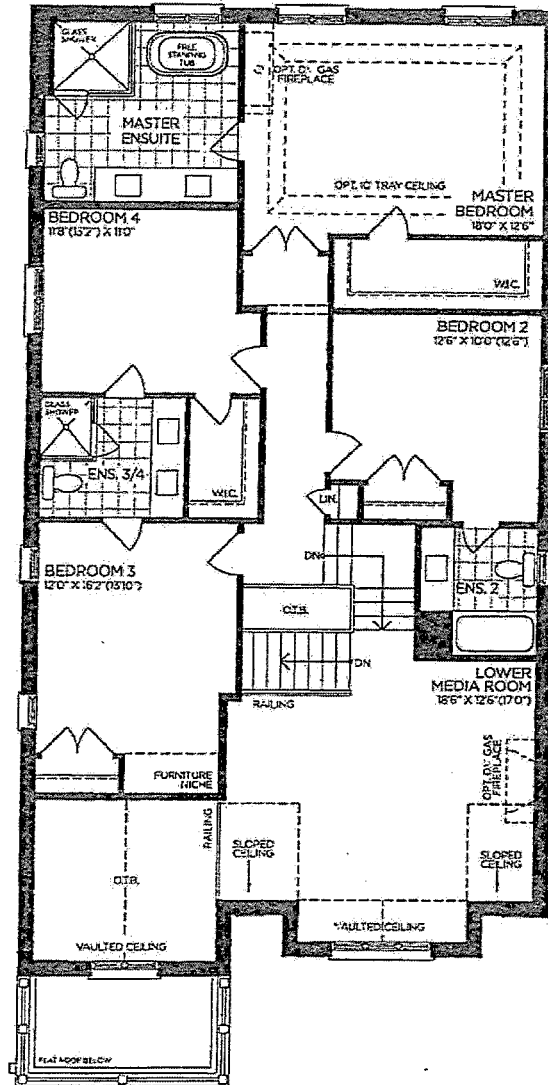

SECOND FLOOR | ELEV. A

VENDOR

PURCHASER

PURCHASER

*[Handwritten signatures and initials over the signature lines]*

**GOLDPARK**  
WORTH MORE™

Prices, figures, illustrations, sizes, features and finishes are subject to change without notice. Areas and dimensions are approximate and actual usable floor space may vary from the stated area. Layout may be reverse of the unit purchased. E. & O.E. 4003

*[Handwritten signature]*

SCHEDULE 'F'




FV-135 *175 J.S.*  
*April 3 22*

# The Brookside


## 40' SERIES

Elevation A • 3,380 sq.ft.


→ Elevation B • 3,350 sq.ft.

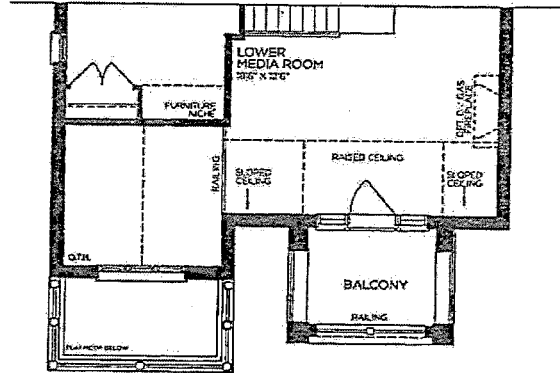


→ PART. SECOND FLOOR | ELEV. B

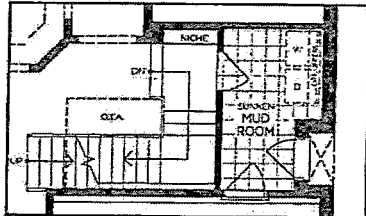

PART. OPT. GROUND FLOOR  
W/ OPT. SIDE ENTRANCE | ELEV. A  
(ELEV. B SIMILAR)

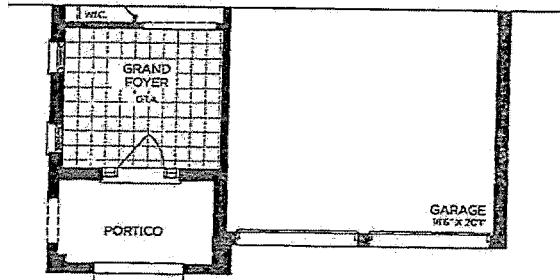

→ PART. GROUND FLOOR | ELEV. B

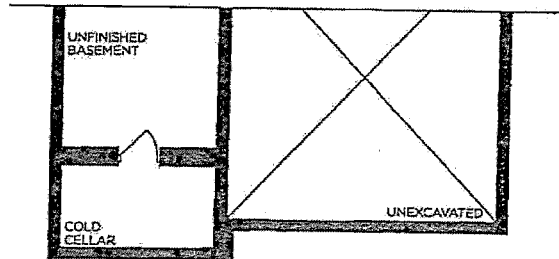

→ PART. BASEMENT | ELEV. B

VENDOR   
PURCHASER *[Signature]*  
PURCHASER *[Signature]*

**GOLDPARK**  
WORTH MORE™

Prices, figures, illustrations, sizes, features and finishes are subject to change without notice. Areas and dimensions are approximate and actual usable floor space may vary from the stated area. Layout may be reverse of the unit purchased. E & O.E. 4003

*[Handwritten signature]*

SCHEDULE 'F'




PV-135 0.5 JS  
April 3 2020

# The Brookside 40' SERIES

Elevation A • 3,380 sq.ft.

→ Elevation B • 3,350 sq.ft.

LOB

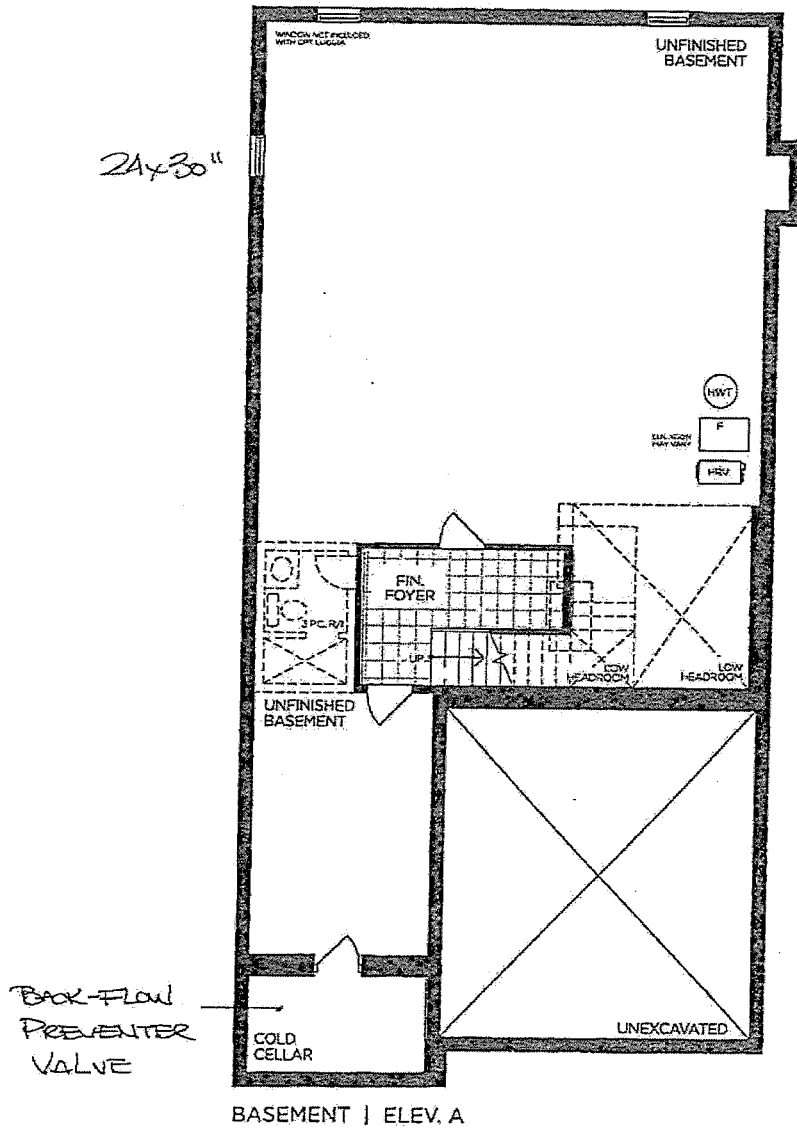

VENDOR \_\_\_\_\_  
PURCHASER ML  
PURCHASER JS

**GOLDPARK**  
WORTH MORE™

Prices, figures, illustrations, sizes, features and finishes are subject to change without notice. Areas and dimensions are approximate and actual usable floor space may vary from the stated area. Layout may be reverse of the unit purchased. E. & O.E. 4003

*[Handwritten signature]*