

**CONCRETE AND DRAIN**

Invoice	Qty.	Description
2268 32011 06Apr20 NoCat	1	BACK-FLOW PREVENTER VALVE

**FORM - FORMING**

Invoice	Qty.	Description
2268 32009 06Apr20 **	2	BASEMENT WINDOWS - UPGRADE BASEMENT WINDOW SIZE TO 30 " X 24" - 8" FRAME

**FORMING**

Invoice	Qty.	Description
2268 32008 06Apr20	1	PINE VALLEY MODEL 40.00 BRIARWOOD ELEV A OR B - 9 FOOT BASEMENT CEILING HEIGHT IN LIEU OF STANDARD 8 FOOT CEILING.

**WINDOWS - BASEMENT**

Invoice	Qty.	Description
2268 32009 06Apr20	2	BASEMENT WINDOWS - UPGRADE BASEMENT WINDOW SIZE TO 30 " X 24" - 8" FRAME
2268 32009 06Apr20	2	BASEMENT WINDOWS - UPGRADE BASEMENT WINDOW SIZE TO 30 " X 24" - 8" FRAME

SCHEDULE 'F'



PV-138  
April 3, 2020

The Briarwood

40' SERIES

Elevation A • 2,870 sq.ft.

→ Elevation B • 2,860 sq.ft.

SAME AS ABOVE →

24x30


LOB

24x48 ← SAME AS ABC

9' BEMENT.

24x30"

24x30"

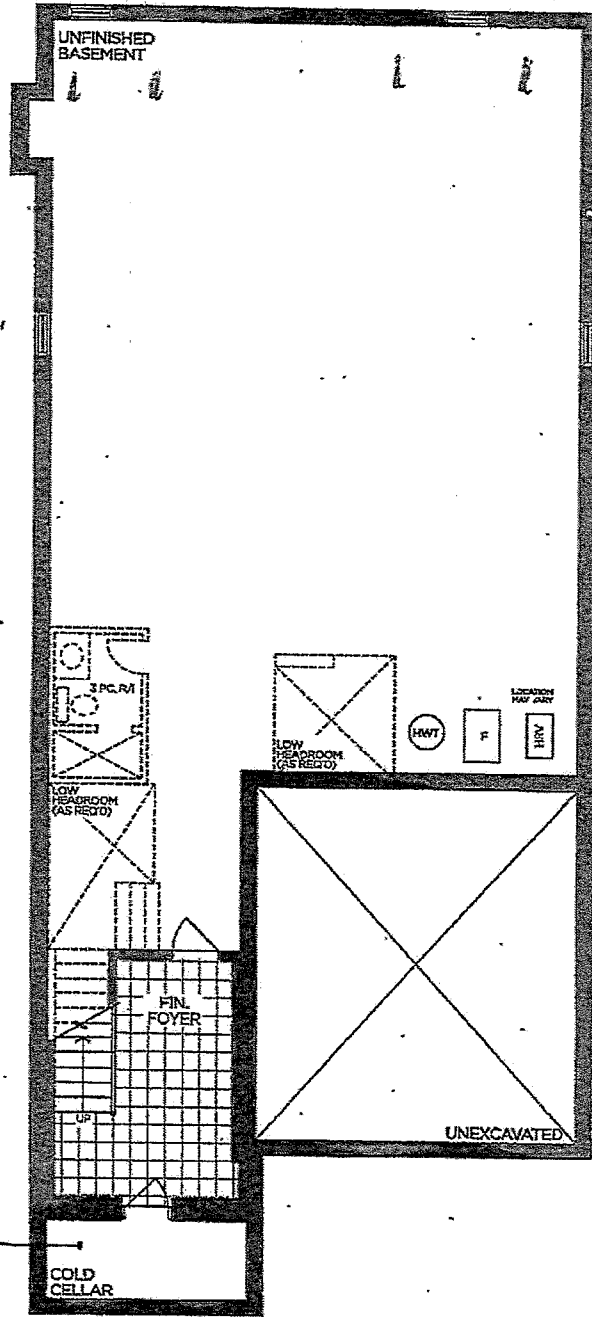

BACK-FLOW PREVENTER VALVE

BASEMENT | ELEV. A & B

VENDOR	
PURCHASER	<i>[Signature]</i>
PURCHASER	

**GOLDPARK**  
WORTH MORE™

Prices, figures, illustrations, sizes, features and finishes are subject to change without notice. Areas and dimensions are approximate and actual usable floor space may vary from the stated area. Layout may be reverse of the unit purchased. E. & O.E. 4000

*[Handwritten signature]*

SCHEDULE 'F'




PV-138  
April 3, 2020

# The Briarwood

40' SERIES

Elevation A • 2,870 sq.ft.

→ Elevation B • 2,860 sq.ft.

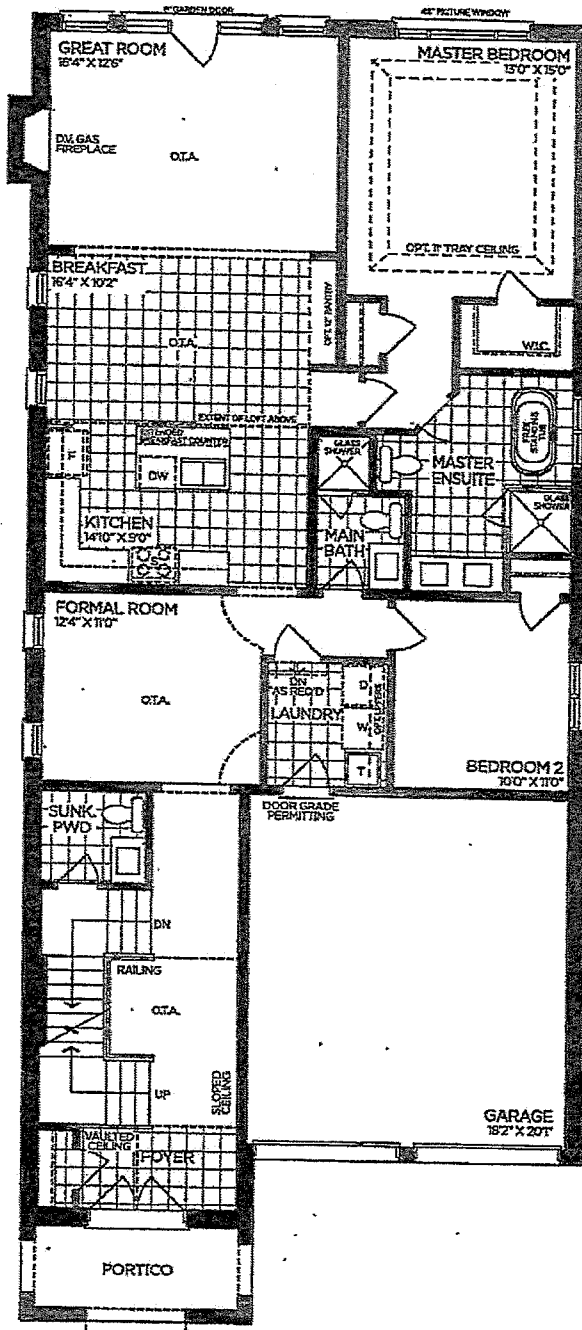

GROUND FLOOR | ELEV. A

VENDOR \_\_\_\_\_  
PURCHASER                       
PURCHASER \_\_\_\_\_

**GOLDPARK**  
WORTH MORE™

Prices, figures, illustrations, sizes, features and finishes are subject to change without notice. Areas and dimensions are approximate and actual usable floor space may vary from the stated area. Layout may be reverse of the unit purchased. E. & O.E. 4000

*[Handwritten signature]*

SCHEDULE 'F'




PV-138  
 April 3, 2020

The Briarwood

40' SERIES

Elevation A • 2,870 sq.ft.

→ Elevation B • 2,860 sq.ft.

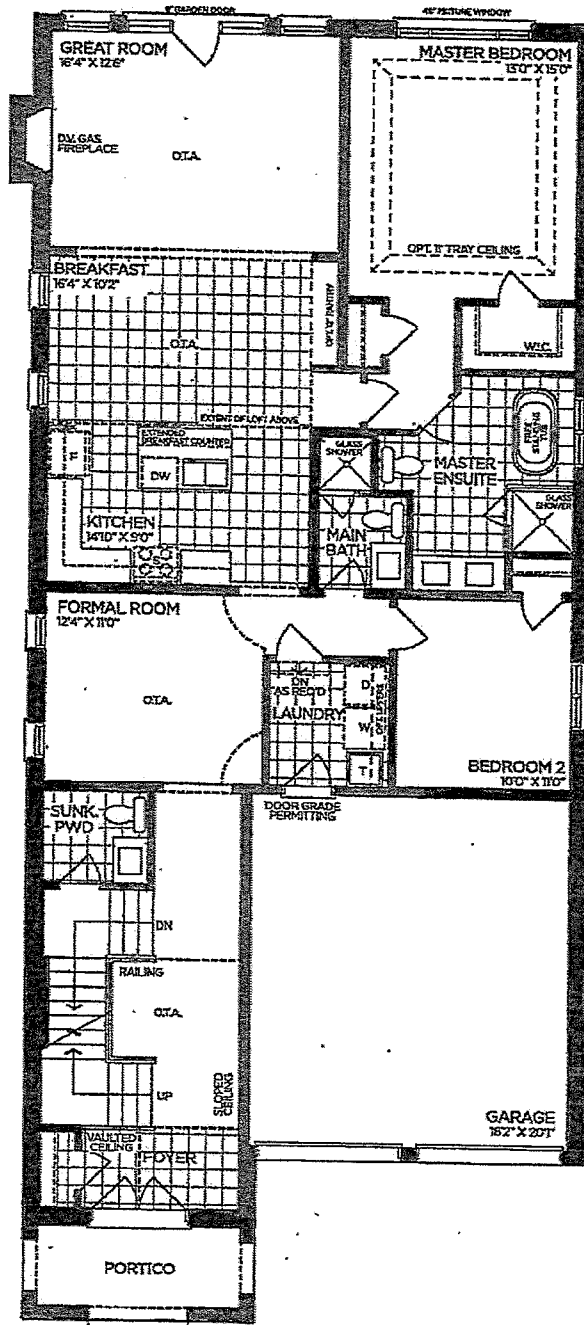

GROUND FLOOR | ELEV. A

VENDOR \_\_\_\_\_  
 PURCHASER                       
 PURCHASER \_\_\_\_\_

**GOLDPARK**  
 WORTH MORE™

Prices, figures, illustrations, sizes, features and finishes are subject to change without notice. Areas and dimensions are approximate and actual usable floor space may vary from the stated area. Layout may be reverse of the unit purchased. E. & O.E. 4000

*[Handwritten signature]*


SCHEDULE 'F'



PV-138  
APRIL 3 2020

The Briarwood  
40' SERIES

Elevation A • 2,870 sq.ft.  
→ Elevation B • 2,860 sq.ft.

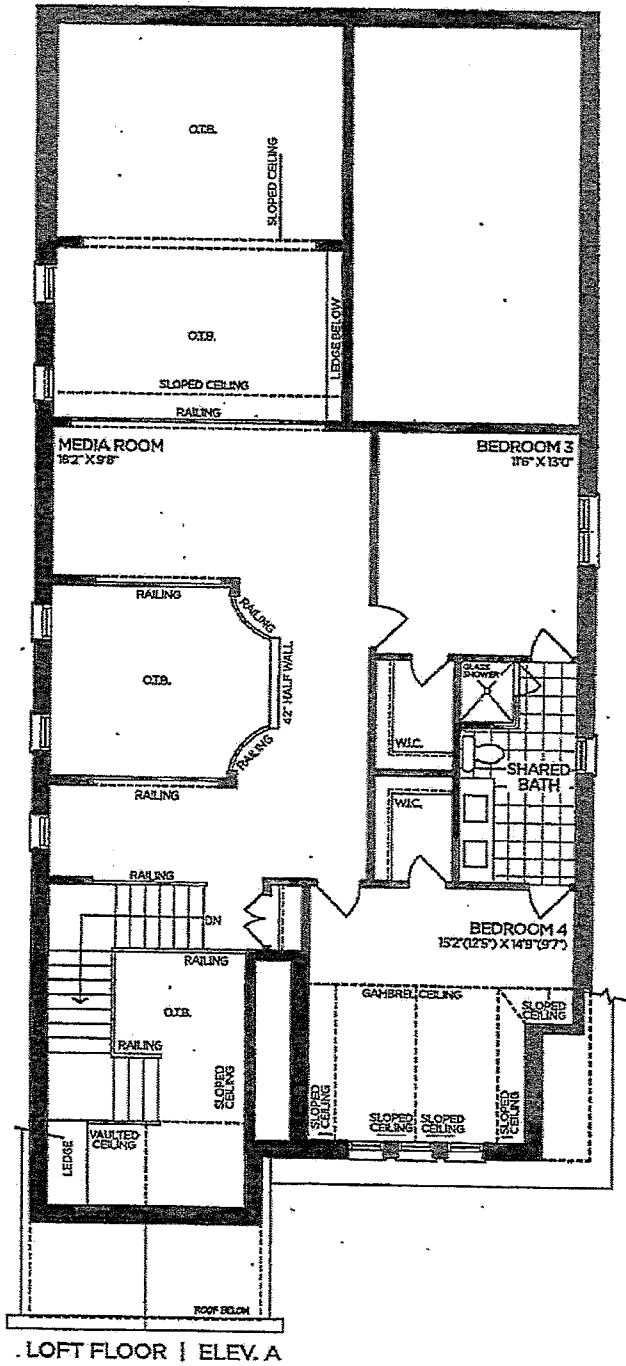

VENDOR \_\_\_\_\_  
PURCHASER OK  
PURCHASER \_\_\_\_\_

**GOLDPARK**  
WORTH MORE™

Prices, figures, illustrations, sizes, features and finishes are subject to change without notice. Areas and dimensions are approximate and actual usable floor space may vary from the stated area. Layout may be reverse of the unit purchased. E. & O.E. 4000

SCHEDULE 'F'




PV-138  
APRIL 3 2020

# The Briarwood


40' SERIES

Elevation A • 2,870 sq.ft.


→ Elevation B • 2,860 sq.ft.

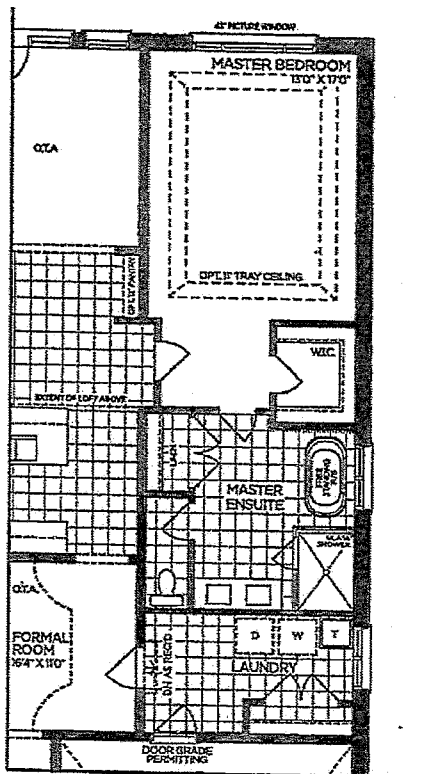


PART. OPT. GROUND FLOOR | ELEV. A  
(ELEV. B SIMILAR)

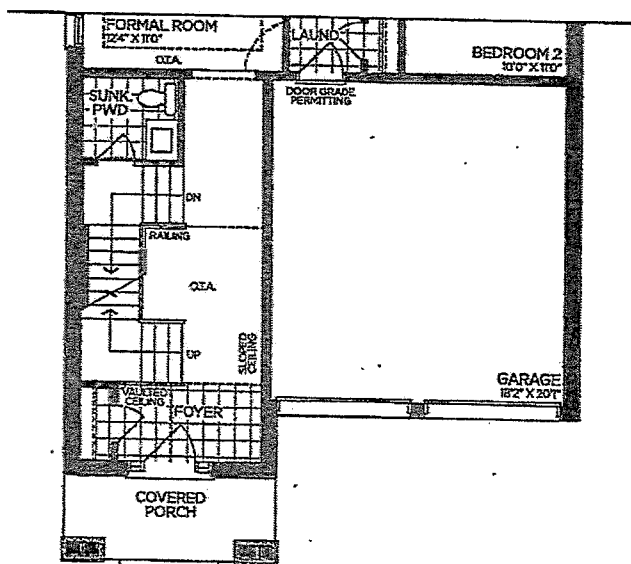


PART. GROUND FLOOR | ELEV. B

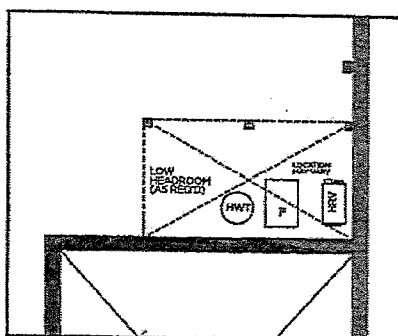

PART. BASEMENT | ELEV. A

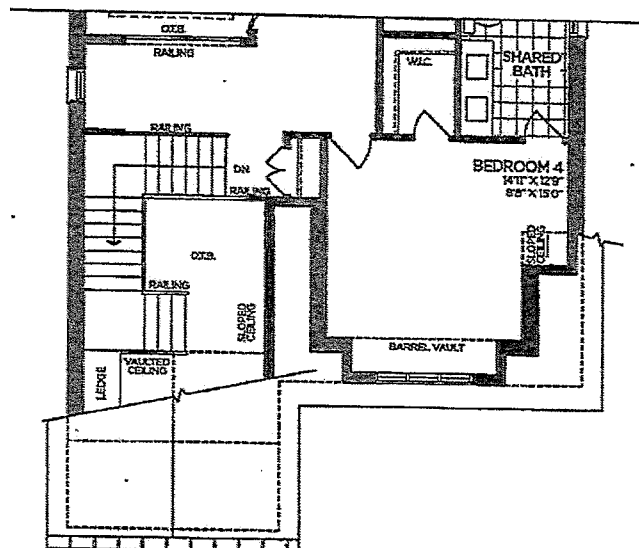

PART. LOFT FLOOR | ELEV. B

VENDOR \_\_\_\_\_  
PURCHASER  \_\_\_\_\_  
PURCHASER \_\_\_\_\_

**GOLDPARK**  
WORTH MORE™

Prices, figures, illustrations, sizes, features and finishes are subject to change without notice. Areas and dimensions are approximate and actual usable floor space may vary from the stated area. Layout may be reverse of the unit purchased. E. & O.E. 4000