

DRYWALL

Invoice	Qty.	Description
2267 32005 08Apr20 **	1	

ELECTRICAL

Invoice	Qty.	Description
2267 32005 08Apr20 **		

FORM - FORMING

Invoice	Qty.	Description
2267 32005 08Apr20 **	2	BASEMENT WINDOWS - UPGRADE BASEMENT WINDOW SIZE TO 30 " X 24" - 8" FRAME

FORMING

Invoice	Qty.	Description
2267 32006 08Apr20	1	PINE VALLEY MODEL 40.02 VALLEYVIEW ELEV A - 9 FOOT BASEMENT CEILING HEIGHT IN LIEU OF STANDARD 8 FOOT CEILING.
2267 32041 08Apr20 NoCat	1	***REVISED LAYOUT*** MOVE REAR GARAGE WALL APPROX 3' (SQUARE OFF REAR OF GARAGE) TO CREATE LARGER LAUNDRY ROOM. MOVE DOOR FROM GARAGE TO HOUSE CLOSER TO EXTERIOR WALL. SEE PLAN FOR LOCATION. COMPLETE WITH STANDARD LEVEL FINISHES

WINDOWS - BASEMENT

Invoice	Qty.	Description
2267 32005 08Apr20	2	BASEMENT WINDOWS - UPGRADE BASEMENT WINDOW SIZE TO 30 " X 24" - 8" FRAME
2267 32005 08Apr20	2	BASEMENT WINDOWS - UPGRADE BASEMENT WINDOW SIZE TO 30 " X 24" - 8" FRAME


SCHEDULE 'F'



PV 142 JV
APRIL 3 2023 AM

The Valleyview
40' SERIES

Elevation A • 3,145 sq.ft.
Elevation B • 3,170 sq.ft.

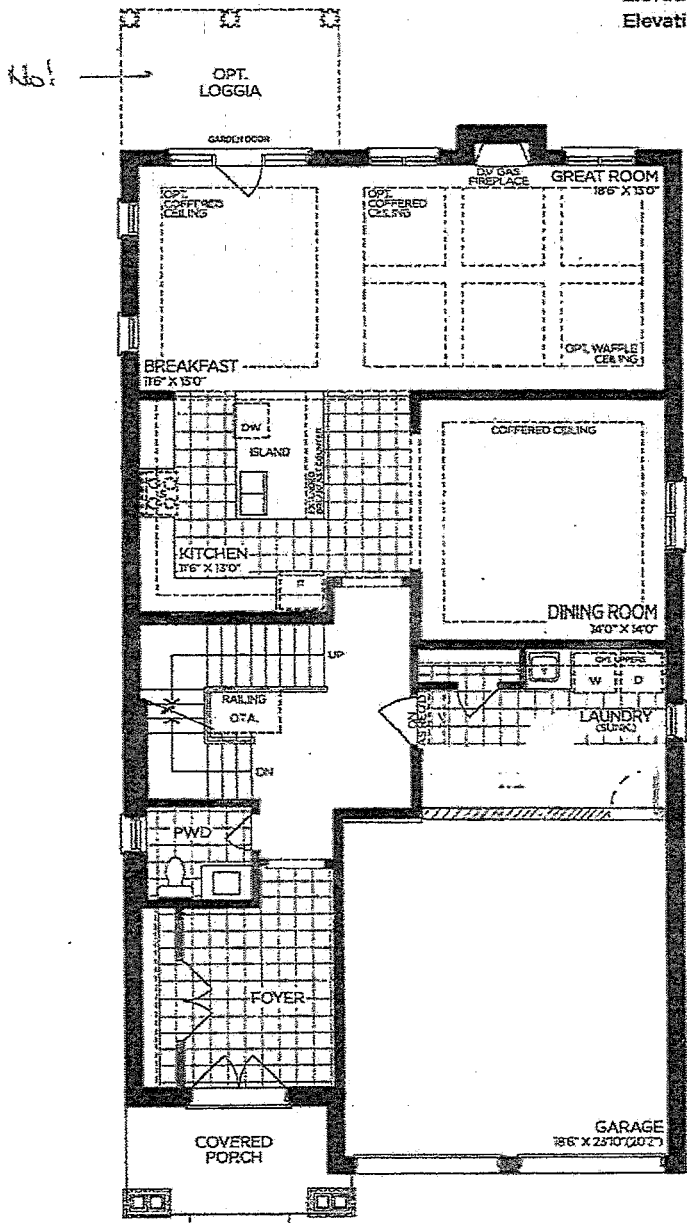

GROUND FLOOR | ELEV. A

VENDOR

PURCHASER

PURCHASER

GOLDPARK
WORTH MORE

Prices, figures, illustrations, sizes, features and finishes are subject to change without notice. Areas and dimensions are approximate and actual usable floor space may vary from the stated area. Layout may be reverse of the unit purchased. E. & Q.E. 4002


SCHEDULE 'F'



PV-142 Juan
April 3 2022

The
Valleyview
40' SERIES

Elevation A • 3,145 sq.ft.
Elevation B • 3,170 sq.ft.

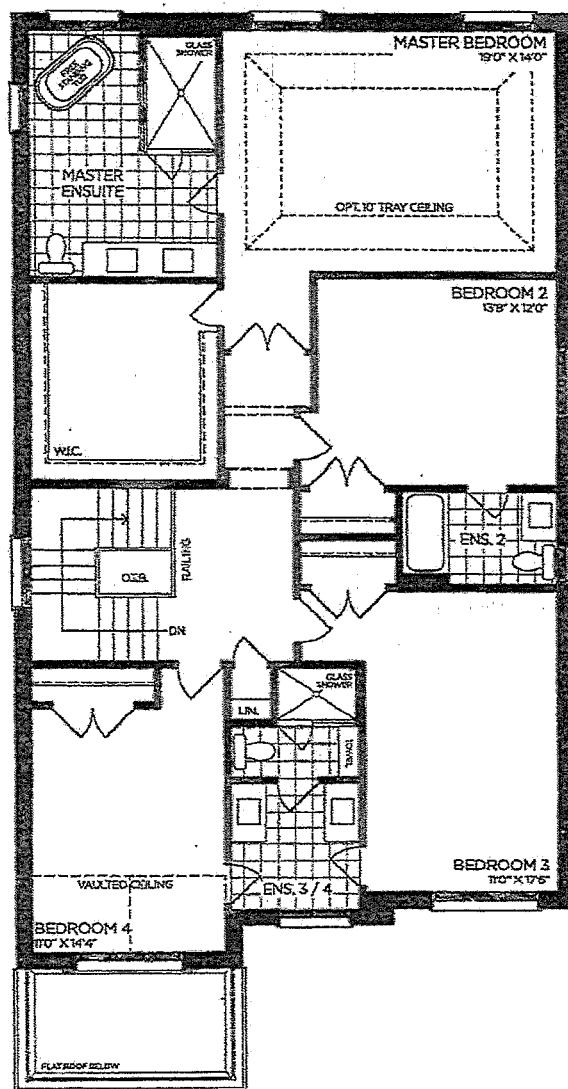

SECOND FLOOR | ELEV. A

VENDOR
PURCHASER
PURCHASER

GOLDPARK
WORTH MORE™

Prices, figures, illustrations, sizes, features and finishes are subject to change without notice. Areas and dimensions are approximate and actual usable floor space may vary from the stated area. Layout may be reverse of the unit purchased. E. & O.E. 4002


SCHEDULE 'F'



PV-142 Jr unit
April 3 2020

The Valleyview
40' SERIES
Elevation A • 3,145 sq.ft.
Elevation B • 3,170 sq.ft.

LOB. (same width as above)

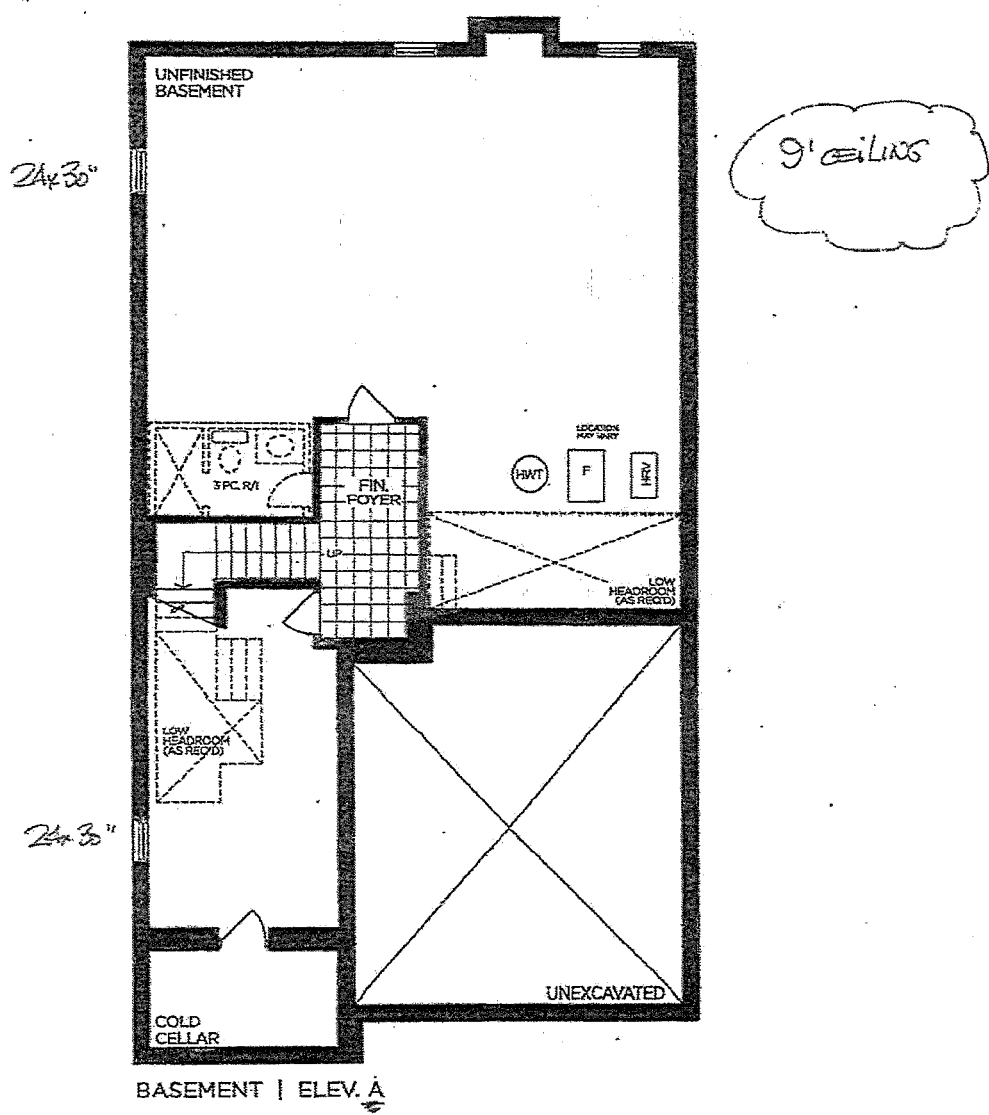

VENDOR	
PURCHASER	
PURCHASER	

GOLDPARK
WORTH MORE™

Prices, figures, illustrations, sizes, features and finishes are subject to change without notice. Areas and dimensions are approximate and actual usable floor space may vary from the stated area. Layout may be reverse of the unit purchased. E. & C.E. 4002