



Lot: 140

Model: 40.02 B VALLEYVIEW

Project/Phase: Pine Valley Forevergreen / 1

CONCRETE AND DRAIN

Invoice	Qty.	Description
2238 31751 09Apr20 NoCat	1	BACK-FLOW PREVENTER VALVE

FORMING

Invoice	Qty.	Description
2238 31747 09Apr20	1	PINE VALLEY MODEL 40.02 VALLEYVIEW ELEV B - 9 FOOT BASEMENT CEILING HEIGHT IN LIEU OF STANDARD 8 FOOT CEILING.

WINDOWS - BASEMENT

Invoice	Qty.	Description
2238 31750 09Apr20	2	BASEMENT WINDOWS - UPGRADE BASEMENT WINDOW SIZE TO 30 " X 24" - 8" FRAME
2238 31750 09Apr20	2	BASEMENT WINDOWS - UPGRADE BASEMENT WINDOW SIZE TO 30 " X 24" - 8" FRAME


This Document is Extremely Time Sensitive - Printed 9 Apr 20 at 10:05



PV-146
APRIL 8 2020

SCHEDULE 'F'

The Valleyview
40' SERIES
Elevation A • 3,145 sq.ft.
Elevation B • 3,170 sq.ft.

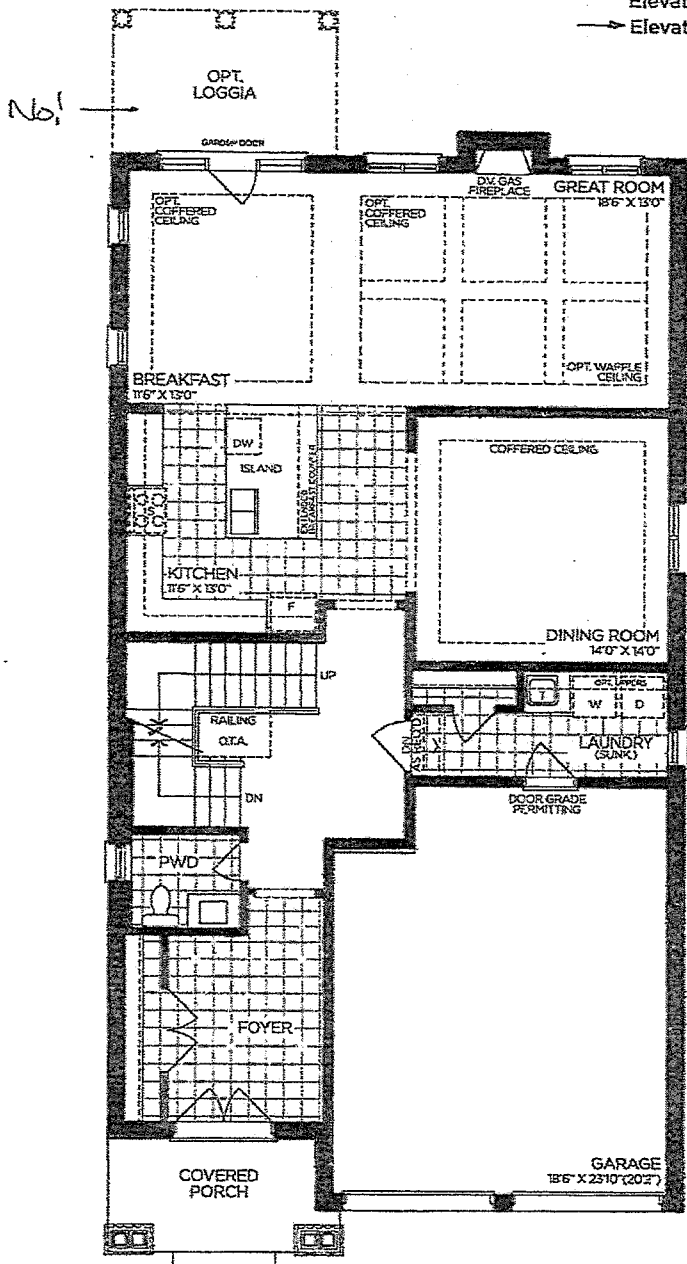

GROUND FLOOR | ELEV. A

VENDOR

PURCHASER

PURCHASER

GOLDPARK
WORTH MORE™


Prices, figures, illustrations, sizes, features and finishes are subject to change without notice. Areas and dimensions are approximate and actual usable floor space may vary from the stated area. Layout may be reverse of the unit purchased. E. & O.E. 4002

SCHEDULE 'F'



PV-140
APRIL 8 2020

The
Valleyview
40' SERIES
Elevation A • 3,145 sq.ft.
Elevation B • 3,170 sq.ft.

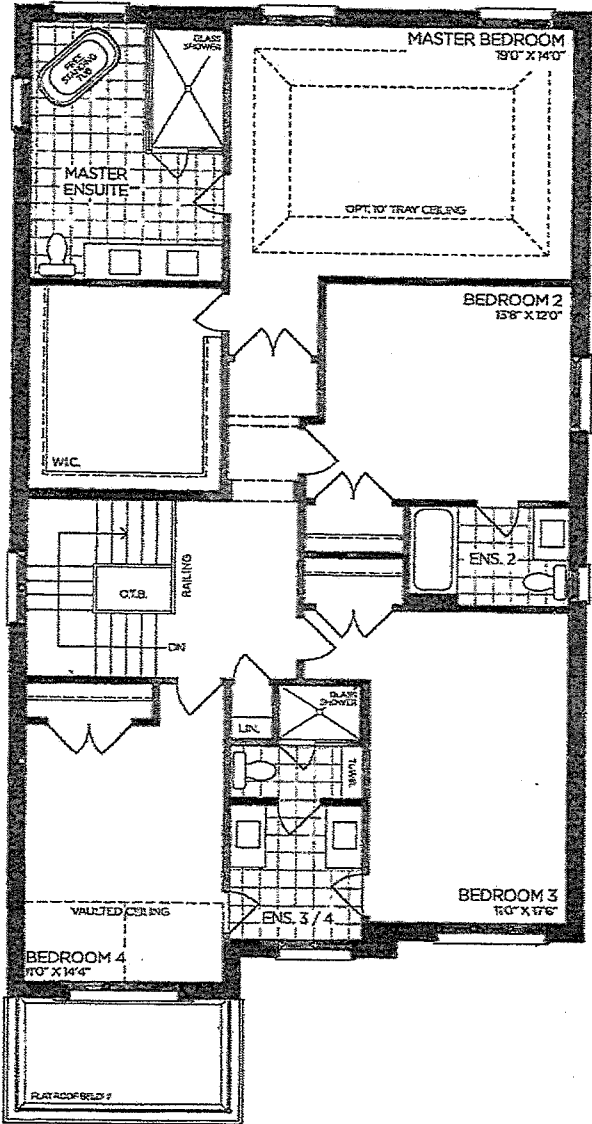

SECOND FLOOR | ELEV. A

VENDOR

PURCHASER

PURCHASER

GOLDPARK
WORTH MORE™

Prices, figures, illustrations, sizes, features and finishes are subject to change without notice. Areas and dimensions are approximate and actual usable floor space may vary from the stated area. Layout may be reverse of the unit purchased. E. & O.E. 4002

SCHEDULE 'F'



PV-140

APRIL 8 2026


The
Valleyview
40' SERIES

Elevation A • 3,145 sq.ft.

→ Elevation B • 3,170 sq.ft.

9' BASEMENT

W.O.D.

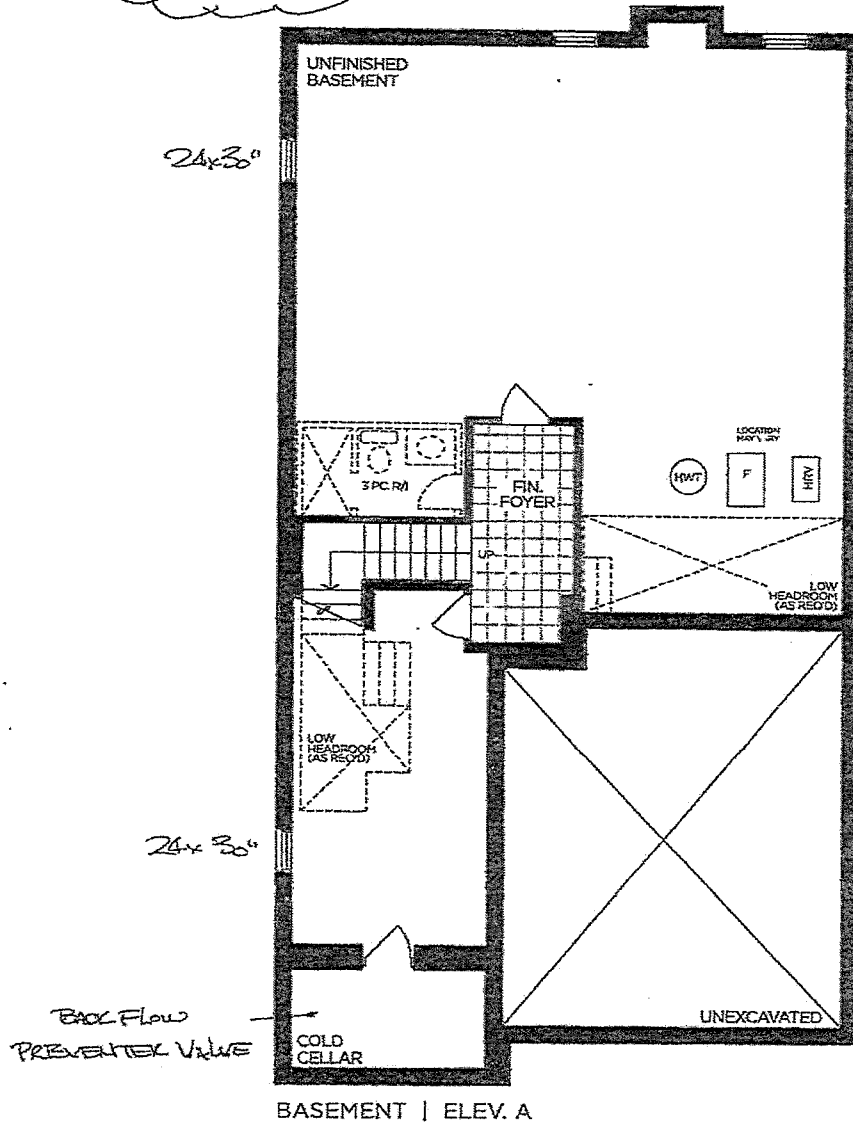

BASEMENT | ELEV. A

VENDOR
PURCHASER
PURCHASER

GOLDPARK
WORTH MORE™

Prices, figures, illustrations, sizes, features and finishes are subject to change without notice. Areas and dimensions are approximate and actual usable floor space may vary from the stated area. Layout may be reverse of the unit purchased. E. & O.E. 4002

[Handwritten signature]

SCHEDULE 'F'



PV-140

April 8 22


Handwritten initials/signature

The Valleyview


40' SERIES

Elevation A • 3,145 sq.ft.


→ Elevation B • 3,170 sq.ft.

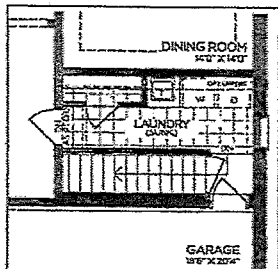


PART. GROUND FLOOR
OPT. SERVICE STAIR

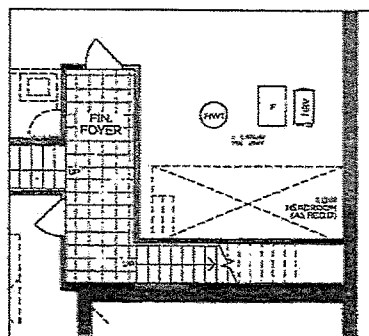


PART. BASEMENT
OPT. SERVICE STAIR

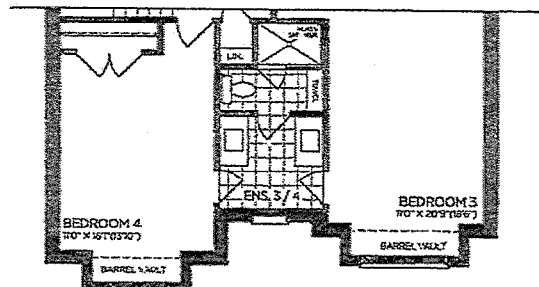

→ PART. SECOND FLOOR | ELEV. B

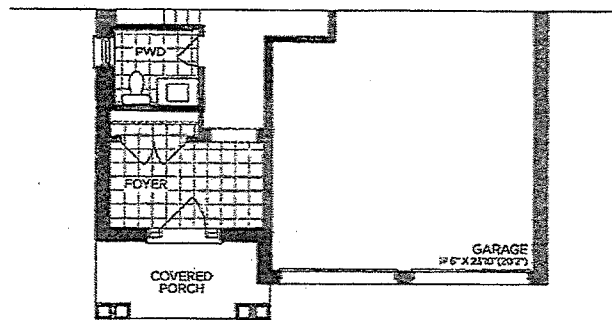

→ PART. GROUND FLOOR | ELEV. B

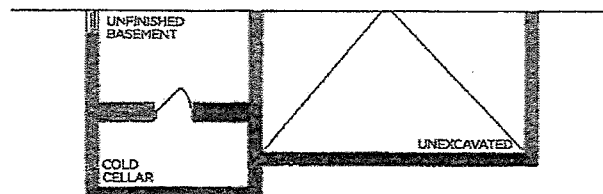

→ PART. BASEMENT | ELEV. B

VENDOR
PURCHASER
PURCHASER

GOLDPARK

WORTH MORE™

Prices, figures, illustrations, sizes, features and finishes are subject to change without notice. Areas and dimensions are approximate and actual usable floor space may vary from the stated area. Layout may be reverse of the unit purchased. E. & O.E. 4002

Handwritten signature