

NOTE: REFERENCES ARE TO DIVISION B, 2012 BUILDING CODE UNLESS NOTED OTHERWISE. THE FOLLOWING NOTES APPLY TO THE CONSTRUCTION GOVERNED BY THE REFERENCED PERMIT AND SHALL FORM PART OF THE DRAWING(S) ATTACHED HERETO. ALL CONSTRUCTION TO COMPLY WITH THE APPLICABLE REQUIREMENT OF ONTARIO REGULATION 332/12, (AS AMENDED), THE 2012 BUILDING CODE, MADE UNDER THE BUILDING CODE ACT.

1. Unless specified elsewhere in the Building Code, Minimum Compressive Strength of unreinforced concrete shall be not less than 15MPa (2200 psi) after 28 days. (Article 9.3.1.6.)
2. Unreinforced Concrete used for garage floors, carport floors, porch slabs, exterior ramps & stairs, and all exterior flatwork shall have a Minimum Compressive Strength of not less than 32 MPa (4650 psi) after 28 days and shall have an entrainment of 5 to 8%. (Article 9.3.1.6.)
3. Concrete slabs-on-ground shall be not less than 75mm (3in) thick exclusive of concrete topping. (Article 9.16.4.3.)
4. Minimum Compressive Strength of slabs-on-ground shall be not less than 25 MPa (after 28 days) or 15 MPa (after 28 days), if Damp-proofing, per Article 9.13.2.7, is provided. (Article 9.16.4.5.)
5. Types of Glass and Protection of Glass shall comply with Article 9.6.1.4.
6. Window areas shall conform with Articles 9.7.2.3. and 9.9.10.1.
7. Doors and windows shall be installed to resist Forced Entry. (Articles 9.7.5.2. & 9.7.6.3.)
8. Stairs shall have a min. headroom of 1.95m; min. width of 860mm; max. rise of 200mm; min. run of 210mm; and min. tread of 235mm min. (Articles 9.8.2.1., 9.8.2.2. & 9.8.4.1.) Curved stairs shall have a min. run of 150mm and a min. average run of 200mm. (Article 9.8.4.2.)
9. Exterior Stairs having more than 3 risers, and interior stairs having more than 2 risers, shall be provided with a Handrail located minimum 895mm (34in) and maximum 965mm (38in) measured above outside edge of nosing and on at least one side. (Articles 9.8.7.1. & 9.8.7.4.)
10. Every walking surface shall be protected by a wall or proper Guard where there is a difference in elevation of more than 600mm from the adjacent surface grade, or where the adjacent surface grade within 1.2m (3'11") from the walking surface has a slope of more than 1 in 2. Guards shall be not less than 900mm (2ft 11in) high measured above the outside edge of nosing (on all open sides of stairs), on interior landings & exterior landings less than 1.8m (5ft 11in), and a min. 1070mm (3ft 6in) high on all other landings. Where an interior stair (including a stair to an unfinished basement) has more than 2 risers, the sides of the stair and the landing or floor level around the stairwell shall be protected by a proper guard on each side that is not protected by a wall. (9.8.8.1 & 9.8.8.3.)
11. A proper Guard is required for any window well where the difference in elevation between the top and bottom of the window well exceeds 600mm (23 5/8in.).
12. Loads on Guards shall comply with 9.8.8.2. & Supplementary Standard SB-7.
13. Guards shall have openings not greater than 100mm (4in) unless permitted under Article 9.8.8.5, and they shall not facilitate climbing as per Article 9.8.8.6.
14. Glass in Guards shall comply with Article 9.8.8.7. & Supplementary Standard SB-13.
15. Exterior Concrete Stairs with more than 2 risers and 2 treads shall be provided with foundations as required by Article 9.8.9.2, or shall be cantilevered as per Subsection 9.8.10.1.
16. The construction between the garage and the dwelling unit shall provide an effective barrier to gas and exhaust fumes. A door between a garage and a dwelling unit shall be tight fitting and weather-stripped and shall be fitted with a self-closing device. Such doors shall not open into a bedroom. (Article 9.10.13.15.)
17. Fire Block in concealed spaces, including spaces created by piping and ceiling bulkheads shall be provided in accordance with Subsection 9.10.16.
18. Smoke Alarms shall be located and installed in accordance with Subsection 9.10.19.
19. Carbon Monoxide Alarms shall be installed on every floor and adjacent to each sleeping area in accordance with Subsection 9.33.4.
20. Damp-proofing, Waterproofing & soil Gas Control shall comply with Section 9.13.
21. Foundation wall drainage layers shall be provided as per Article 9.14.2.1.
22. Every Window Well shall be drained to the footing level or other suitable location as per Article 9.14.6.3.
23. The building site shall be so graded that discharged water will not accumulate at or near the building and will not adversely affect adjacent properties. (Article 9.14.6.1.)
24. Footings and Foundation Walls not subject to surcharge shall rest on stable soils with an allowable bearing pressure of 75kPa or greater. (Article 9.15.1.1.)
25. Where a foundation is erected on filled ground, peat or sensitive clay, the footing sizes shall be designed in conformance with Section 4.2. A Geotechnical Engineer shall confirm the soil bearing capacity and the its capability of supporting the designed structure.
26. Minimum Footing Sizes shall comply with Article 9.15.3.4.
27. Where Step Footings are used, the vertical rise between horizontal portions shall not exceed 600mm (23 5/8in) and the horizontal distance between risers shall be not less than 600 (23 5/8in). (Article 9.15.3.9.)
28. Max height of Fin Ground above basement or crawl space floor shall comply to Table 9.15.4.2.A.
29. Reinforcement for Flat Insulating Concrete Form foundation walls shall comply to 9.15.4.5.
30. Gas Fireplaces shall be ULC labelled and installed with compatible labelled chimneys in accordance with manufacturer's instructions.
31. Beams shall have even and level bearing and shall have not less than 89mm (3 1/2in) length of bearing at end supports. (Article 9.23.8.1.)
32. Continuous barrier to Air Leakage from the interior of the Building into wall, floor, attic and roof spaces shall be provided and installed in accordance with Article 9.25.3.1. Air Access Hatch shall be sized and provided with minimum insulation in accordance with 9.19.2.1. and SB-12 Article 3.1.1.6.

33. Wall and roof flashings shall conform to 9.20.13., 9.26.4., 9.27.3.7. and 9.27.3.8.
34. For the required number of Exterior Steps, refer to Siting and Grading drawings.
35. The Energy efficiency shall comply with Subsection 3.1.1. (Prescriptive Compliance Packages), Subsection 3.1.2. (Performance Compliance), or Subsection 3.1.3. (Other Acceptable Compliance Methods) of SB-12.
36. Provide Ice and Water Shield to roof/wall sheathings susceptible to snow/ice damage at all roof and wall junctions where a change in elevation occurs, at roof valleys where snow/ice damming may occur, and at all Architectural detail locations where snow/ice accumulation may occur. Extend ice and water shield up side wall a minimum of 2ft and refer to manufacturer for installation instructions.
37. Exterior Insulation Finish System (EIFS) cladding must be applied on approved substrate. EIFS cladding must be installed according to manufacturer's specifications, Ontario Building Code (OBC 9.27.) requirements, Canadian Construction Materials Centre (CCMC) evaluation report with ruling of the Ministry of Municipal Affairs and Housing (MMAH), Building Materials Evaluation Commission report and/or decision authorized by the Building Code Commission (BCC). Evaluation report(s) must be available for submission to the building inspector upon request. Stucco systems shall comply with Section 9.28.
38. Where a dwelling unit is not located above or below another suite, the travel limit from a floor level in the dwelling unit to an exit or egress door is permitted to exceed 1 storey where that floor level is served by an operable window or door, (a) providing an unobstructed opening of not less than 1200mm in height and 550mm in width, and (b) located so that the sill is not more than, (i) 1200mm above the floor, and (ii) 7000mm above adjacent ground level. Sentence 9.9.9.1.(2)
40. The travel limit from a floor level in a dwelling unit to an exit or egress door is permitted to exceed 1 storey where that floor level has direct access to a balcony. Sentence 9.9.9.1.(3)
41. First storey means the storey that has its floor closest to grade and its ceiling more than 1.8m above grade, where grade means the average level of proposed or finished ground adjoining a building at all exterior walls & Proposed or finished ground does not include artificial landscape or superficially raised ground, planters or steps.
42. The issuance of this building permit does not include the authority to enter or encroach onto adjacent property, or disturb the ground of the adjacent property, without the authorization of the adjacent owners.
43. Every excavation shall be undertaken in such a manner as to prevent movement which would cause damage to adjacent property, existing structures, utilities, roads and sidewalks, at all stages of construction.
44. The persons to whom this building permit is issued, must govern themselves accordingly to the proper means of excavation and possible shoring as per typical structural/construction standards. Excavations in sandy or poor soil are required to be shored or excavated with a bank shoring not to exceed 1 vertical for 3 horizontal. Excavations in clay or good soil that exceed 1.2 metres (4 ft.) in depth are required to be shored or cut back at the top so that the angle of the cut does not exceed 1 vertical for 1 horizontal, and the vertical cut at the bottom, if so designed, not to exceed 1.2 metres (4 ft.). Where shoring is required, submit engineered drawings with design parameters clearly stated for approval under a separate standalone shoring permit. A geotechnical report and a Commitment to General Review must be included in your submission.
45. Ventilation shall comply with Section 9.32.
46. Lighting shall conform to Article 9.34.1.4. and Subsection 9.34.2.
47. Electric Vehicle Charging shall conform to Subsection 9.34.4.

Architectural Building Code Plans Examination reviewed ONLY and LIMITED to the Description of the proposed work indicated on the Application for Permit to construct or demolish. These Drawings shall be read in conjunction with ALL PREVIOUS BUILDING PERMITS (IF ANY) for any notes, comments and OBC requirements.

ONTARIO BUILDING CODE PLANS EXAMINATION is not intended to review building design, advice on which should be sought from professional sources. Its primary purpose is a set of minimum provisions respecting the safety of building with reference to public health, fire protection and structural sufficiency.

IT IS THE SOLE RESPONSIBILITY of the applicant for the accuracy of the submitted Drawings and that the information on those drawings representing the up-to-date condition of Lot Survey, existing building footprint, layout, configuration, setbacks, finish floor elevations, finish grades, unprotected opening calculation and construction details.

ARCHITECTURAL PLANS have been cursory reviewed and Approved based on the minimum OBC provisions respecting the safety of building with reference to public health, fire protection and structural sufficiency only, however, on-site inspections may reveal deficiencies not covered in this plans review, which must be brought into compliance with the Requirements of the OBC.

MATERIALS, SYSTEMS and BUILDING DESIGNS must comply with all OBC requirements, approved by Canadian Construction Materials Centre and/or Building Code Commission Decision. Evaluation report must be available for submission to Building Inspector upon request. This Building permit must be read in conjunction with all other approved documents.

The design and construction of new or extension of existing building systems shall comply with all applicable parts of 2012 Ontario Building Code (Ontario Regulation 332/12) made under the Building Code Act S.O. 1992, c.23.

Energy Efficiency Design Summary: Prescriptive Method

(Building Code Part 9, Residential)

This form is used by a designer to demonstrate that the energy efficiency design of a house complies with the building code using the prescriptive method described in Subsection 3.1.1. of SB-12. This form is applicable where the ratio of gross area of windows/sidelights/skylights/glazing in doors and sliding glass doors to the gross area of peripheral walls is not more than 22%.

For use by Principal Authority	
Application No:	Model/Certification Number

A. Project Information

Building Number, Street Name		Unit Number	Location
Municipality		Postal Code	Reg. Plan Number / other description
Vaughan		4002 'A'	M4647

B. Prescriptive Compliance (indicate the building code compliance package being employed in this house design)

SB-12 Prescriptive (input design package):	Package: A1	Table: 3.1.1.2.A (IP)
--	-------------	-----------------------

C. Project Design Conditions

Climatic Zone (SB-1):		Heating Equipment Efficiency	Space Heating Fuel Source
☒ Zone 1 (< 5000 degree days)		☒ ≥ 92% AFUE	☐ Gas ☐ Propane ☐ Solid Fuel
☐ Zone 2 (≥ 5000 degree days)		☐ ≥ 84% < 92% AFUE	☐ Oil ☐ Electric ☐ Earth Energy
Ratio of Windows, Skylights & Glass (W, S & G) to Wall Area		Other Building Characteristics	
Area of walls = 335.13 m ² or _____ ft ²		☐ Log/Post&Beam ☐ ICF Above Grade ☐ ICF Basement	
W, S & G % = 11.46%		☐ Slab-on-ground ☐ Walkout Basement	
Area of W, S & G = 38.41 m ² or _____ ft ²		☐ Air Conditioning ☐ Combo Unit	
Utilize window averaging: ☐ Yes ☒ No		☐ Air Sourced Heat Pump (ASHP)	
		☐ Ground Sourced Heat Pump (GSHP)	

D. Building Specifications (provide values and ratings of the energy efficiency components proposed)

Energy Efficiency Substitutions			
☐ ICF (3.1.1.2.(5) & (6) / 3.1.1.3.(5) & (6))			
☐ Combined space heating and domestic water heating systems (3.1.1.2.(7) / 3.1.1.3.(7))			
☐ Airtightness substitution(s)			
Airtightness test required (Refer to Design Guide Attached)		☐ Table 3.1.1.4.B Required: Permitted Substitution: ☐ Table 3.1.1.4.C Required: Permitted Substitution: ☐ Required: Permitted Substitution:	
Building Component	Minimum RSI / R values or Maximum U-Value ⁽¹⁾		Building Component
	Nominal	Effective	Efficiency Ratings
Thermal Insulation			
Ceiling with Attic Space	R60	R60	Windows & Doors Provide U-Value ⁽¹⁾ or ER rating
Ceiling without Attic Space	R31	R31	Windows/Sliding Glass Doors
Exposed Floor	R31	R31	Skylights/Glazed Roofs
Walls Above Grade	R22	R22	Mechanicals
Basement Walls	R20ci	R20ci	Heating Equip (AFUE)
Slab (all ≥ 600mm below grade)			HRV Efficiency (SRE% at 0°C)
Slab (edge only ≤ 600mm below grade)	R10	R10	DHW Heater (EF)
Slab (all ≤ 600mm below grade, or heated)	R10	R10	DWHR (CSA B55.1 (min. 42% efficiency))
			Combined Heating System
			96%
			75%
			0.8EF
			42% # Showers 2

(1) U value to be provided in either W/(m²·K) or Btu/(h·ft²·F) but not both.

E. Designer(s) (name(s) & BCIN(s), if applicable, of person(s) providing information herein to substantiate that design meets the building code)

Qualified Designer Declaration of designer to have reviewed and take responsibility for the design work.		
Name	BCIN	Signature
Orin Fairbairn	20201	

Energy Efficiency Design Summary: Prescriptive Method

(Building Code Part 9, Residential)

This form is used by a designer to demonstrate that the energy efficiency design of a house complies with the building code using the prescriptive method described in Subsection 3.1.1. of SB-12. This form is applicable where the ratio of gross area of windows/sidelights/skylights/glazing in doors and sliding glass doors to the gross area of peripheral walls is not more than 22%.

For use by Principal Authority	
Application No:	Model/Certification Number

A. Project Information

Building number, street name		Unit number	Car/Car
Municipality		Postal code	Reg. Plan number / other description
Vaughan			M4647

B. Prescriptive Compliance (indicate the building code compliance package being employed in this house design)

SB-12 Prescriptive (input design package):	Package: A1	Table: 3.1.1.2.A (IP)
--	-------------	-----------------------

C. Project Design Conditions

Climatic Zone (SB-1):		Heating Equipment Efficiency	Space Heating Fuel Source
☒ Zone 1 (< 5000 degree days)	☒ ≥ 92% AFUE	☒ Gas	☐ Propane
☐ Zone 2 (≥ 5000 degree days)	☐ ≥ 84% < 92% AFUE	☐ Oil	☐ Electric
Ratio of Windows, Skylights & Glass (W, S & G) to Wall Area		Other Building Characteristics	
Area of walls = 341.22 m ² or _____ ft ²	W, S & G % = 11.35%	☐ Log/Post&Beam	
Area of W, S & G = 38.72 m ² or _____ ft ²	Utilize window averaging: ☐ Yes ☒ No	☐ ICF Above Grade	
		☐ ICF Basement	
		☐ Slab-on-ground	
		☐ Walkout Basement	
		☐ Air Conditioning	
		☐ Combo Unit	
		☐ Air Sourced Heat Pump (ASHP)	
		☐ Ground Sourced Heat Pump (GSHP)	

D. Building Specifications (provide values and ratings of the energy efficiency components proposed)

Energy Efficiency Substitutions				
☐ ICF (3.1.1.2.(5) & (6) / 3.1.1.3.(5) & (6))				
☐ Combined space heating and domestic water heating systems (3.1.1.2.(7) / 3.1.1.3.(7))				
☐ Airtightness substitution(s)				
Airtightness test required (Refer to Design Guide Attached)		☐ Table 3.1.1.4.B Required; Permitted Substitution: _____ ☐ Table 3.1.1.4.C Required; Permitted Substitution: _____ ☐ Required; Permitted Substitution: _____		
Building Component	Minimum RSI / R values or Maximum U-Value ⁽¹⁾		Building Component	Efficiency Ratings
Thermal Insulation	Nominal	Effective	Windows & Doors	Provide U-Value ⁽¹⁾ or ER rating
Ceiling with Attic Space	R60	R60	Windows/Sliding Glass Doors	1.6U
Ceiling without Attic Space	R31	R31	Skylights/Glazed Roofs	2.6U
Exposed Floor	R31	R31	Mechanicals	
Walls Above Grade	R22	R22	Heating Equip.(AFUE)	96%
Basement Walls	R20ci	R20ci	HRV Efficiency (SRE% at 0°C)	75%
Slab (all >600mm below grade)			DHW Heater (EF)	0.8EF
Slab (edge only ≤600mm below grade)	R10	R10	DWHR (CSA B55.1 (min. 42% efficiency))	42% # Showers?
Slab (all ≤600mm below grade, or heated)	R10	R10	Combined Heating System	

(1) U value to be provided in either W/(m².K) or Btu/(h.ft².F) but not both.

E. Designer(s) (name(s) & BCIN(s), if applicable, of person(s) providing information herein to substantiate that design meets the building code)

Qualified Designer Declaration of designer to have reviewed and take responsibility for the design work.		
Name	BCIN	Signature
Orin Fairbairn	20201	

Energy Efficiency Design Summary: Prescriptive Method

(Building Code Part 9, Residential)

This form is used by a designer to demonstrate that the energy efficiency design of a house complies with the building code using the prescriptive method described in Subsection 3.1.1. of SB-12. This form is applicable where the ratio of gross area of windows/sidelights/skylights/glazing in doors and sliding glass doors to the gross area of peripheral walls is not more than 22%.

For use by Principal Authority	
Application No:	Model/Certification Number:

A. Project Information

Building number, street name		Unit number	Location
Vaughan		4002A LOD	
Municipality	Postal code	Reg. Plan number / other description	
		M4647	

B. Prescriptive Compliance (indicate the building code compliance package being employed in this house design)

SB-12 Prescriptive (input design package):	Package: A1	Table: 3.1.1.2.A (IP)
--	-------------	-----------------------

C. Project Design Conditions

Climatic Zone (SB-1):	Heating Equipment Efficiency	Space Heating Fuel Source
☒ Zone 1 (< 5000 degree days)	☒ ≥ 92% AFUE	☒ Gas ☐ Propane ☐ Solid Fuel
☐ Zone 2 (≥ 5000 degree days)	☐ ≥ 84% < 92% AFUE	☐ Oil ☐ Electric ☐ Earth Energy
Ratio of Windows, Skylights & Glass (W, S & G) to Wall Area	Other Building Characteristics	
Area of walls = 346.12 m ² or _____ ft ²	☐ Log/Post&Beam ☐ ICF Above Grade ☐ ICF Basement ☐ Slab-on-ground ☐ Walkout Basement ☐ Air Conditioning ☐ Combo Unit ☐ Air Sourced Heat Pump (ASHP) ☐ Ground Sourced Heat Pump (GSHP)	
Area of W, S & G = 39.64 m ² or _____ ft ²	W, S & G % = 11.45% Utilize window averaging: ☐ Yes ☒ No	

D. Building Specifications (provide values and ratings of the energy efficiency components proposed)

Energy Efficiency Substitutions				
☐ ICF (3.1.1.2.(5) & (6) / 3.1.1.3.(5) & (6)) ☐ Combined space heating and domestic water heating systems (3.1.1.2.(7) / 3.1.1.3.(7)) ☐ Airtightness substitution(s)				
Airtightness test required (Refer to Design Guide Attached)		☐ Table 3.1.1.4.B Required: ☐ Table 3.1.1.4.C Required: Required: Permitted Substitution:		
Building Component	Minimum RSI / R values or Maximum U-Value ⁽¹⁾	Building Component	Efficiency Ratings	
Thermal Insulation	Nominal Effective	Windows & Doors	Provide U-Value ⁽¹⁾ or ER rating	
Ceiling with Attic Space	R60 R60	Windows/Sliding Glass Doors	1.6U	
Ceiling without Attic Space	R31 R31	Skylights/Glazed Roofs	2.8U	
Exposed Floor	R31 R31	Mechanicals		
Walls Above Grade	R22 R22	Heating Equip. (AFUE)	96%	
Basement Walls	R20ci R20ci	HRV Efficiency (SRE% at 0° C)	75%	
Slab (all ≥ 600mm below grade)		DHW Heater (EF)	0.8EF	
Slab (edge only ≤ 600mm below grade)	R10 R10	DWHR (CSA B55.1 (min. 42% efficiency))	42%	# Showers 2
Slab (all ≤ 600mm below grade, or heated)	R10 R10	Combined Heating System		

(1) U value to be provided in either W/(m².K) or Btu/(h.ft².F) but not both.

E. Designer(s) (name(s) & BCIN(s), if applicable, of person(s) providing information herein to substantiate that design meets the building code)

Qualified Designer Declaration of designer to have reviewed and take responsibility for the design work.		
Name	BCIN	Signature
Orin Fairbairn	20201	

Energy Efficiency Design Summary: Prescriptive Method

(Building Code Part 9, Residential)

This form is used by a designer to demonstrate that the energy efficiency design of a house complies with the building code using the prescriptive method described in Subsection 3.1.1, of SB-12. This form is applicable where the ratio of gross area of windows/sideights/skylights/glazing in doors and sliding glass doors to the gross area of peripheral walls is not more than 22%.

For use by Principal Authority	
Application No:	Model/Certification Number:

A. Project Information

Building number, street name		Unit number	Lot/Con
		4002 'A' wdb	
Municipality	Postal code	Reg. Plan number / other description	
Vaughan		M4647	

B. Prescriptive Compliance [Indicate the building code compliance package being employed in this house design]

SB-12 Prescriptive (input design package): Package: <u>A1</u>	Table: <u>3.1.1.2.A (IP)</u>
---	------------------------------

C. Project Design Conditions

Climatic Zone (SB-1): ☒ Zone 1 (< 5000 degree days) ☐ Zone 2 (≥ 5000 degree days)	Heating Equipment Efficiency ☒ ≥ 92% AFUE ☐ ≥ 84% < 92% AFUE	Space Heating Fuel Source ☒ Gas ☐ Propane ☐ Solid Fuel ☐ Oil ☐ Electric ☐ Earth Energy
Ratio of Windows, Skylights & Glass (W, S & G) to Wall Area Area of walls = <u>364.92</u> m ² or _____ ft ² W, S & G % = <u>12.44</u> % Area of W, S & G = <u>45.38</u> m ² or _____ ft ²		Other Building Characteristics ☐ Log/Post&Beam ☐ ICF Above Grade ☐ ICF Basement ☐ Slab-on-ground ☐ Walkout Basement ☐ Air Conditioning ☐ Combo Unit ☐ Air Sourced Heat Pump (ASHP) ☐ Ground Sourced Heat Pump (GSHP)
Utilize window averaging: ☐ Yes ☒ No		

D. Building Specifications [provide values and ratings of the energy efficiency components proposed]

Energy Efficiency Substitutions				
☐ ICF (3.1.1.2.(5) & (6) / 3.1.1.3.(5) & (6)) ☐ Combined space heating and domestic water heating systems (3.1.1.2.(7) / 3.1.1.3.(7)) ☐ Airtightness substitution(s) Airtightness test required (Refer to Design Guide Attached)				
☐ Table 3.1.1.4.B Required: _____ ☐ Table 3.1.1.4.C Required: _____ Required: _____		Permitted Substitution: _____ Permitted Substitution: _____ Permitted Substitution: _____		
Building Component	Minimum RSI / R values or Maximum U-Value ⁽¹⁾		Building Component	Efficiency Ratings
Thermal Insulation	Nominal	Effective	Windows & Doors	Provide U-Value ⁽¹⁾ or ER rating
Ceiling with Attic Space	R60	R60	Windows/Sliding Glass Doors	1.6U
Ceiling without Attic Space	R31	R31	Skylights/Glazed Roofs	2.8U
Exposed Floor	R31	R31	Mechanicals	
Walls Above Grade	R22	R22	Heating Equip.(AFUE)	98%
Basement Walls	R20ci	R20ci	HRV Efficiency (SRE% at 0°C)	75%
Slab (all >600mm below grade)			DHW Heater (EF)	0.8EF
Slab (edge only ≤600mm below grade)	R10	R10	DWHR (CSA B55.1 (min. 42% efficiency))	42% # Showers <u>2</u>
Slab (all ≤600mm below grade, or heated)	R10	R10	Combined Heating System	

(1) U value to be provided in either W/(m²·K) or Btu/(h·ft²·F) but not both.

E. Designer(s) [name(s) & BCIN(s), if applicable, of person(s) providing information herein to substantiate that design meets the building code]

Qualified Designer Declaration of designer to have reviewed and take responsibility for the design work.		
Name	BCIN	Signature
Orin Fairbairn	20201	

Energy Efficiency Design Summary: Prescriptive Method

(Building Code Part 9, Residential)

This form is used by a designer to demonstrate that the energy efficiency design of a house complies with the building code using the prescriptive method described in Subsection 3.1.1. of SB-12. This form is applicable where the ratio of gross area of windows/sidelights/skylights/glazing in doors and sliding glass doors to the gross area of peripheral walls is not more than 22%.

For use by Principal Authority	
Application No:	Model/Certification Number

A. Project Information

Building number, street name		Unit number	Location
Municipality		Postal code	Reg. Plan Number / other description
Vaughan			M4647

B. Prescriptive Compliance (indicate the building code compliance package being employed in this house design)

SB-12 Prescriptive (input design package):	Package: A1	Table: 3.1.1.2.A (IP)
--	-------------	-----------------------

C. Project Design Conditions

Climatic Zone (SB-1):	Heating Equipment Efficiency	Space Heating Fuel Source
☒ Zone 1 (< 5000 degree days)	☒ ≥ 92% AFUE	☒ Gas ☐ Propane ☐ Solid Fuel
☐ Zone 2 (≥ 5000 degree days)	☐ ≥ 84% < 92% AFUE	☐ Oil ☐ Electric ☐ Earth Energy
Ratio of Windows, Skylights & Glass (W, S & G) to Wall Area		Other Building Characteristics
Area of walls = 335.13 m ² or _____ ft ²	W, S & G % = 11.42%	☐ Log/Post&Beam ☐ ICF Above Grade ☐ ICF Basement
Area of W, S & G = 38.29 m ² or _____ ft ²	Utilize window averaging: ☐ Yes ☒ No	☐ Slab-on-ground ☐ Walkout Basement
		☐ Air Conditioning ☐ Combo Unit
		☐ Air Sourced Heat Pump (ASHP)
		☐ Ground Sourced Heat Pump (GSHP)

D. Building Specifications (provide values and ratings of the energy efficiency components proposed)

Energy Efficiency Substitutions			
☐ ICF (3.1.1.2.(5) & (6) / 3.1.1.3.(5) & (6))			
☐ Combined space heating and domestic water heating systems (3.1.1.2.(7) / 3.1.1.3.(7))			
☐ Airtightness substitution(s)			
Airtightness test required (Refer to Design Guide Attached)		☐ Table 3.1.1.4.B Required: Permitted Substitution: ☐ Table 3.1.1.4.C Required: Permitted Substitution: Required: Permitted Substitution:	
Building Component	Minimum RSI / R values or Maximum U-Value ⁽¹⁾	Building Component	Efficiency Ratings
Thermal Insulation	Nominal Effective	Windows & Doors Provide U-Value ⁽¹⁾ or ER rating	
Ceiling with Attic Space	R60 R60	Windows/Sliding Glass Doors	1.6U
Ceiling without Attic Space	R31 R31	Skylights/Glazed Roofs	2.8U
Exposed Floor	R31 R31	Mechanicals	
Walls Above Grade	R22 R22	Heating Equip (AFUE)	96%
Basement Walls	R20ci R20ci	HRV Efficiency (SRE% at 0°C)	75%
Slab (all >600mm below grade)		DHW Heater (EF)	0.8EF
Slab (edge only ≤600mm below grade)	R10 R10	DWHR (CSA B55.1 (min. 42% efficiency))	42% # Showers 2
Slab (all ≤600mm below grade, or heated)	R10 R10	Combined Heating System	

(1) U value to be provided in either W/(m²·K) or Btu/(h·ft²·F) but not both.

E. Designer(s) (name(s) & BCIN(s), if applicable, of person(s) providing information herein to substantiate that design meets the building code)

Qualified Designer Declaration of designer to have reviewed and take responsibility for the design work.		
Name	BCIN	Signature
Orin Fairbairn	20201	

Energy Efficiency Design Summary: Prescriptive Method

(Building Code Part 9, Residential)

This form is used by a designer to demonstrate that the energy efficiency design of a house complies with the building code using the prescriptive method described in Subsection 3.1.1. of SB-12. This form is applicable where the ratio of gross area of windows/sidelights/skylights/glazing in doors and sliding glass doors to the gross area of peripheral walls is not more than 22%.

For use by Principal Authority

Application No:	Model/Certification Number
-----------------	----------------------------

A. Project Information

Building number, street name	Unit number	Location
	4002 B' Wood	
Municipality	Postal code	Reg. Plan number / other description
Vaughan		M4647

B. Prescriptive Compliance (Indicate the building code compliance package being employed in this house design)

SB-12 Prescriptive (input design package):	Package: A1	Table: 3.1.1.2.A (IP)
--	-------------	-----------------------

C. Project Design Conditions

Climatic Zone (SB-1):	Heating Equipment Efficiency	Space Heating Fuel Source
☒ Zone 1 (< 5000 degree days)	☒ ≥ 92% AFUE	☒ Gas
☐ Zone 2 (≥ 5000 degree days)	☐ ≥ 84% < 92% AFUE	☐ Propane
		☐ Solid Fuel
		☐ Oil
		☐ Electric
		☐ Earth Energy
Ratio of Windows, Skylights & Glass (W, S & G) to Wall Area	Other Building Characteristics	
Area of walls = 358.28 m ² or _____ ft ²	☐ Log/Post&Beam	☐ ICF Above Grade
	☐ Slab-on-ground	☐ Walkout Basement
	☐ Air Conditioning	☐ Combo Unit
	☐ Air Sourced Heat Pump (ASHP)	
	☐ Ground Sourced Heat Pump (GSHP)	
Area of W, S & G = 38.60 m ² or _____ ft ²	W, S & G % = 10.77%	
	Utilize window averaging: ☐ Yes ☒ No	

D. Building Specifications (provide values and ratings of the energy efficiency components proposed)

Energy Efficiency Substitutions				
☐ ICF (3.1.1.2.(5) & (6) / 3.1.1.3.(5) & (6))				
☐ Combined space heating and domestic water heating systems (3.1.1.2.(7) / 3.1.1.3.(7))				
☐ Airtightness substitution(s)				
Airtightness test required (Refer to Design Guide Attached)		☐ Table 3.1.1.4.B Required: Permitted Substitution: ☐ Table 3.1.1.4.C Required: Permitted Substitution: Required: Permitted Substitution:		
Building Component	Minimum RSI / R values or Maximum U-Value⁽¹⁾	Building Component	Efficiency Ratings	
Thermal Insulation	Nominal Effective	Windows & Doors Provide U-Value ⁽¹⁾ or ER rating		
Ceiling with Attic Space	R60 R60	Windows/Sliding Glass Doors	1.6U	
Ceiling without Attic Space	R31 R31	Skylights/Glazed Roofs	2.8U	
Exposed Floor	R31 R31	Mechanicals		
Walls Above Grade	R22 R22	Heating Equip. (AFUE)	96%	
Basement Walls	R20ci R20ci	HRV Efficiency (SRE% at 0°C)	75%	
Slab (all >600mm below grade)		DHW Heater (EF)	0.8EF	
Slab (edge only ≤600mm below grade)	R10 R10	DWHR (CSA B55.1 (min. 42% efficiency))	42%	# Showers 2
Slab (all ≤600mm below grade, or heated)	R10 R10	Combined Heating System		

(1) U value to be provided in either W/(m²·K) or Btu/(h·ft²·F) but not both.

E. Designer(s) (name(s) & BCIN(s), if applicable, of person(s) providing information herein to substantiate that design meets the building code)

Qualified Designer Declaration of designer to have reviewed and take responsibility for the design work.		
Name	BCIN	Signature
Orin Fairbairn	20201	

Energy Efficiency Design Summary: Prescriptive Method

(Building Code Part 9, Residential)

This form is used by a designer to demonstrate that the energy efficiency design of a house complies with the building code using the prescriptive method described in Subsection 3.1.1. of SB-12. This form is applicable where the ratio of gross area of windows/sidelights/skylights/glazing in doors and sliding glass doors to the gross area of peripheral walls is not more than 22%.

For use by Principal Authority

Application No:	Model/Certification Number
-----------------	----------------------------

A. Project Information

Building Number, Street Name	Unit Number	Lot/Con
Municipality	Postal Code	Reg. Plan Number / Other description
Vaughan		4002 B' Lot M4647

B. Prescriptive Compliance [Indicate the building code compliance package being employed in this house design]

SB-12 Prescriptive (input design package); Package: A1 Table: 3.1.1.2.A (IP)

C. Project Design Conditions

Climatic Zone (SB-1):	Heating Equipment Efficiency	Space Heating Fuel Source
☒ Zone 1 (< 5000 degree days)	☒ ≥ 92% AFUE	☒ Gas ☐ Propane ☐ Solid Fuel
☐ Zone 2 (≥ 5000 degree days)	☐ ≥ 84% < 92% AFUE	☐ Oil ☐ Electric ☐ Earth Energy
Ratio of Windows, Skylights & Glass (W, S & G) to Wall Area	Other Building Characteristics	
Area of walls = <u>363.18</u> m ² or _____ ft ²	☐ Log/Post&Beam ☐ ICF Above Grade ☐ ICF Basement ☐ Slab-on-ground ☐ Walkout Basement ☐ Air Conditioning ☐ Combo Unit ☐ Air Sourced Heat Pump (ASHP) ☐ Ground Sourced Heat Pump (GSHP)	
Area of W, S & G = <u>39.52</u> m ² or _____ ft ²	W, S & G % = <u>10.88</u> Utilize window averaging: ☐ Yes ☒ No	

D. Building Specifications [provide values and ratings of the energy efficiency components proposed]

Energy Efficiency Substitutions			
☐ ICF (3.1.1.2.(5) & (6) / 3.1.1.3.(5) & (6)) ☐ Combined space heating and domestic water heating systems (3.1.1.2.(7) / 3.1.1.3.(7)) ☐ Airtightness substitution(s)			
Airtightness test required (Refer to Design Guide Attached)		☐ Table 3.1.1.4.B Required: ☐ Table 3.1.1.4.C Required:	
Required:		Permitted Substitution:	
Building Component	Minimum RSI / R values or Maximum U-Value⁽¹⁾	Building Component	Efficiency Ratings
Thermal Insulation	Nominal Effective	Windows & Doors Provide U-Value ⁽¹⁾ or ER rating	
Ceiling with Attic Space	R60 R60	Windows/Sliding Glass Doors	1.6U
Ceiling without Attic Space	R31 R31	Skylights/Glazed Roofs	2.8U
Exposed Floor	R31 R31	Mechanicals	
Walls Above Grade	R22 R22	Heating Equip.(AFUE)	96%
Basement Walls	R20ci R20ci	HRV Efficiency (SRE% at 0°C)	75%
Slab (all) >600mm below grade)		DHW Heater (EF)	0.8EF
Slab (edge only ≤600mm below grade)	R10 R10	DWHR (CSA B55.1 (min. 42% efficiency))	42% # Showers <u>2</u>
Slab (all ≤600mm below grade, or heated)	R10 R10	Combined Heating System	

(1) U Value to be provided in either W/(m²·K) or Btu/(h·ft²·F) but not both.

E. Designer(s) [name(s) & BCIN(s), if applicable, of person(s) providing information herein to substantiate that design meets the building code]

Qualified Designer Declaration of designer to have reviewed and take responsibility for the design work.		
Name	BCIN	Signature
Orin Fairbairn	20201	

Energy Efficiency Design Summary: Prescriptive Method

(Building Code Part 9, Residential)

This form is used by a designer to demonstrate that the energy efficiency design of a house complies with the building code using the prescriptive method described in Subsection 3.1.1. of SB-12. This form is applicable where the ratio of gross area of windows/sideights/skylights/glazing in doors and sliding glass doors to the gross area of peripheral walls is not more than 22%.

For use by Principal Authority	
Application No:	Model/Certification Number:

A. Project Information

Building number, street name:		Unit number:	Lot/Con:
Municipality:		Postal code:	Reg. Plan number / other description:
Vaughan			M4647

B. Prescriptive Compliance (indicate the building code compliance package being employed in this house design)

SB-12 Prescriptive (input design package):	Package: <u>A1</u>	Table: <u>3.1.1.2.A (IP)</u>
--	--------------------	------------------------------

C. Project Design Conditions

Climatic Zone (SB-1):	Heating Equipment Efficiency	Space Heating Fuel Source
☒ Zone 1 (< 5000 degree days)	☒ ≥ 92% AFUE	☒ Gas ☐ Propane ☐ Solid Fuel
☐ Zone 2 (≥ 5000 degree days)	☐ ≥ 84% < 92% AFUE	☐ Oil ☐ Electric ☐ Earth Energy
Ratio of Windows, Skylights & Glass (W, S & G) to Wall Area	Other Building Characteristics	
Area of walls = <u>351.96</u> m ² or _____ ft ²	☐ Log/Post&Beam ☐ ICF Above Grade ☐ ICF Basement	
	☐ Slab-on-ground ☐ Walkout Basement	
	☐ Air Conditioning ☐ Combo Unit	
	☐ Air Sourced Heat Pump (ASHP)	
	☐ Ground Sourced Heat Pump (GSHP)	
Area of W, S & G = <u>45.26</u> m ² or _____ ft ²	W, S & G % = <u>11.85%</u>	
	Utilize window averaging: ☐ Yes ☒ No	

D. Building Specifications (provide values and ratings of the energy efficiency components proposed)

Energy Efficiency Substitutions			
☐ ICF (3.1.1.2.(5) & (6) / 3.1.1.3.(5) & (6))			
☐ Combined space heating and domestic water heating systems (3.1.1.2.(7) / 3.1.1.3.(7))			
☐ Airtightness substitution(s)			
Airtightness test required (Refer to Design Guide Attached)		☐ Table 3.1.1.4.B Required: _____ ☐ Table 3.1.1.4.C Required: _____ Required: _____	
Building Component	Minimum RSI / R values or Maximum U-Value ⁽¹⁾		Building Component
Thermal Insulation	Nominal	Effective	Efficiency Ratings
Ceiling with Attic Space	R60	R60	Windows & Doors Provide U-Value ⁽¹⁾ or ER rating
Ceiling without Attic Space	R31	R31	Windows/Sliding Glass Doors
Exposed Floor	R31	R31	Skylights/Glazed Roofs
Walls Above Grade	R22	R22	Mechanicals
Basement Walls	R20ci	R20ci	Heating Equip.(AFUE)
Slab (all >600mm below grade)			HRV Efficiency (SRE% at 0° C)
Slab (edge only ≤600mm below grade)	R10	R10	DHW Heater (EF)
Slab (all ≤600mm below grade, or heated)	R10	R10	DWHR (CSA B55.1 (min, 42% efficiency))
			Combined Heating System
			42% # Showers ≥

(1) U value to be provided in either W/(m².K) or Btu/(h.ft².F) but not both.

E. Designer(s) (name(s) & BCIN(s), if applicable, of person(s) providing information herein to substantiate that design meets the building code)

Qualified Designer Declaration of designer to have reviewed and take responsibility for the design work.		
Name	BCIN	Signature
Orin Fairbairn	20201	

RECEIVED
FEB 27 2020
FOR DATA ENTRY

Office use:	003 ☒	005 ☐	010 ☐	015 ☐
-------------	---	------------------------------	------------------------------	------------------------------

I, Umar Dauda (print name) certify that:
 The information contained in this application, attached drawings and other documentation is true to the best of my knowledge.
 1. Applicant is responsible for separate application of Repeats under the latest Ontario Regulation/amendments.


FEB 26/20
 Date


 Signature of Applicant



HUNT

DESIGN ASSOCIATES INC.

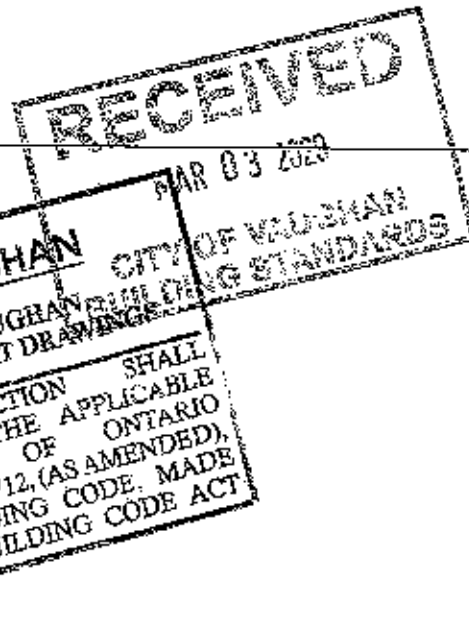

March 3, 2020

City of Vaughan
2141 Major Mackenzie Dr.
Vaughan ON
L6A 1T1
Attn: Building Standards Dept

Re: Certified models 4001, 4002, 4003, 4201, 4204, 5001, 5002, 5006

We provide the following spatial separation calculations for the rear elevation WOB conditions with a limiting distance of 7.5m, resulting in a max. allowable opening of 50%. ~~OR 25% WIFE EBF EXCESS 120 ft².~~

4001-EL. A

EBF wall area = 1008.7 sf
Open. Allowed = 504.4 sf
Open. Provided = 202.7 sf

4001-EL. B

EBF wall area = 1005.4 sf
Open. Allowed = 502.7 sf
Open. Provided = 202.7 sf

4002-EL. A&B

EBF wall area = 964.3 sf
Open. Allowed = 482.2 sf
Open. Provided = 178.8 sf

4003-EL. A&B

EBF wall area = 957.6 sf
Open. Allowed = 478.8 sf
Open. Provided = 192.8 sf

4201-EL. A&B

EBF wall area = 1035.3 sf
Open. Allowed = ~~522.6 sf~~ 517.7 ft² (50%)
Open. Provided = 105.4 sf

4204-EL. A

EBF wall area = 1053.3 sf
Open. Allowed = ~~526.7 sf~~ 526.7 ft² (50%)
Open. Provided = 247.7 sf

STEPHEN HUNT
Principal
JOHN CAO
Partner
TONY DICARLO
Partner
MARCA REE SIMARD
Associate
DOMINIC MOBILIO
Associate
VIJAY SHIVPAUL
Associate
BRIAN SHERRER
Associate
JERMAINE LAWRENCE
Associate



HUNT

DESIGN ASSOCIATES INC.

4204-EL. B

EBF wall area = 1053.3 sf

Open. Allowed = ~~474.0 sf~~ 526.7 ft^2 (50%)

Open. Provided = 249.1 sf

5001-EL. A&B

EBF wall area = 1281.3 sf

Open. Allowed = ~~640.7 sf~~ 320.3 ft^2 (25%)

Open. Provided = 231.4 sf

5002-EL. A&B

EBF wall area = 1274.0 sf

Open. Allowed = ~~637.0 sf~~ 318.5 ft^2 (25%)

Open. Provided = 219.7 sf

5006-EL. A&B

EBF wall area = 1286.1 sf

Open. Allowed = ~~643.1 sf~~ 321.5 ft^2 (25%)

Open. Provided = 282.1 sf

Allan Whiting

Project Manager

awhiting@huntdesign.ca

Hunt Design Associates Inc.

8986 Woodbine Avenue // Suite 200, Markham, ON L3R 0J7

Tel: 905-737-5133 ext: 227

STEPHEN HUNT
Principal

JOHN CAO
Partner

TONY DICARLO
Partner


MARC-ANDRÉ SIMARD
Associate

DOMINIC MOGILIO
Associate

VICAY SHIVPAUL
Associate

BRIAN SHERRER
Associate

JERMAINE LAWRENCE
Associate

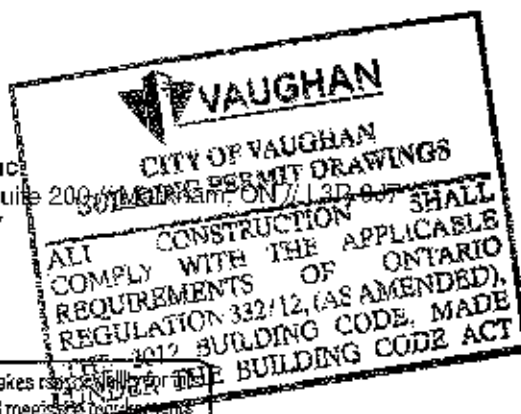

The undersigned has reviewed and takes responsibility for this design and has the qualifications and means to be a Designer as set out in the Ontario Building Code to be a Designer.

QUALIFICATION INFORMATION:

Allan Whiting	<i>AW</i>	23477
NAME	SIGNATURE	BCIN

REGISTRATION INFORMATION:

HUNT DESIGN ASSOCIATES INC.	19695
NAME	BCIN



ELEVATION 'B'

UNIT 4002 - THE VALLEYVIEW

- 1 TITLEPAGE
- 2 BASEMENT PLAN, ELEV. A
- 3 GROUND FLOOR PLAN, ELEV. 'A'
- 4 SECOND FLOOR PLAN, ELEV. 'A'
- 5 PART.BASEMENT & GROUND FLOOR PLAN ELEV. 'B'
- 6 PART. SEC FLR PLAN EL.'B' & PART. BSMT.PLAN FOR
SUNK. LAUND.
- 7 PART.FLOOR PLANS FOR LOGGIA COND.EL.A.(EL.'B'
SIMILAR)
- 8 FRONT ELEVATION 'A'
- 9 LEFT SIDE ELEVATION 'A'
- 10 RIGHT SIDE ELEVATION 'A'
- 11 REAR ELEVATION A/B
- 12 FRONT ELEVATION 'B'
- 13 LEFT ELEVATION 'B'
- 14 RIGHT SIDE ELEVATION 'B'
- 15 REAR & PART LEFT ELEVATION FOR OPT.LOGGIA
CONDITION
- 16 CROSS SECTION 'A-A'
- 17 CONSTRUCTION NOTES 1
- 18 CONSTRUCTION NOTES 2
- W1 WALK-OUT DECK CONDITION
- W2 LOOK-OUT DECK CONDITION
- W3 WALK-OUT BASEMENT CONDITION

20-120002-GLD-00-CH

EL. 'A' WOD STD PLAN	EL. 'A' LOD STD PLAN	EL. 'A'-WOB STD PLAN	EL. 'B'-WOD STD PLAN	EL.'B'-LOD STD PLAN	EL.'B'-WOB STD PLAN
3672.66 sq ft (341.22 sq m)	3725.6 sq ft (346.12 sq m)	3927.95 sq ft (364.92 sq m)	3856.48 sq ft (358.28 sq m)	3909.28 sq ft (363.18 sq m)	4111.56 sq ft (381.98 sq m)
416.73 sq ft (38.72 sq m)	426.73 sq ft (39.64 sq m)	488.45 sq ft (45.38 sq m)	415.44 sq ft (38.60 sq m)	425.44 sq ft (39.52 sq m)	437.16 sq ft (40.56 sq m)
11.35 %	11.45 %	12.44 %	10.77 %	10.88 %	11.85 %

7. REVISED AS PER STRUCT. ENG. & REISSUED FOR FINAL	2018/10/24	OF
6. REVISED AS PER ENG. COMMENTS	2018/05/31	MC
5. REVISED AS PER CLIENT COMMENTS	2018/05/16	MC
4. REVISED AS PER ENG. COMMENTS	2018/04/17	MC
3. REVISED AS PER FLOOR MANUF. COMMENTS	2017/11/27	MC
2. REVISED AS PER CLIENT COMMENTS	2017/11/06	MC
1. ISSUE FOR CLIENT REVIEW	2017/10/13	JLL
REVISIONS	DATE (YYYYMMDD)	BY

THE UNDERSIGNED HAS REVIEWED AND TAKES RESPONSIBILITY FOR THIS DESIGN AND HAS THE QUALIFICATIONS AND EXPERIENCE TO MEET THE REQUIREMENTS SET OUT IN THE ONTARIO BUILDING CODE AS A DESIGNER.				GOLDPARK HOMES - 217020		UNIT 4002 - THE VALLEYVIEW	
QUALIFICATION INFORMATION Orin Fairbairn NAME REGISTRATION INFORMATION HUNT DESIGN ASSOCIATES INC.		20201 SCB1 19695		DESIGN ASSOCIATES INC. www.huntdesign.ca		PINE VALLEY, VAUGHAN, ONTARIO Drawn By: JLL Checked By: OF Scale: 3/16"=1'-0" File Number: 217020WS4002.rvt Page Number: 1 of 18	
All drawings specifications related documents and design are the copyright property of Hunt Design Associates (H.D.A.). Reproduction of this property in whole or in part is strictly prohibited without H.D.A.'s written permission. H.D.A. assumes no responsibility or liability for this property unless it bears the appropriate BCIN number and original signature(s).				5966 Woodbine Avenue, Suite 200, Markham, ON L3R 0J7 T 905.737.5133 F 905.737.7326		REV.2018.10.24	


REFER TO FLOOR JOIST MANUFACTURER'S DRAWINGS FOR LAYOUT, SPACING, BLOCKING & STRAPPING REQUIREMENTS, INSTALLATION DETAILS AND HANGER SIZES, & SUBFLOOR THICKNESS
NOT TO SCALE

PROVIDE SOLID WOOD BLOCKING @ 24" O.C. FOR FIRST JOIST SPAN WHEN PARALLEL W/ EXTERIOR WALL
NOT TO SCALE

SPACE ALL FLOOR JOISTS @ 12" O.C. UNDER ALL CERAMIC TILE AREAS
NOT TO SCALE

All site plans and construction to comply with City of Vaughan By-Law 1-88 a.a.

CITY OF VAUGHAN
FOR BUILDING PERMIT ONLY

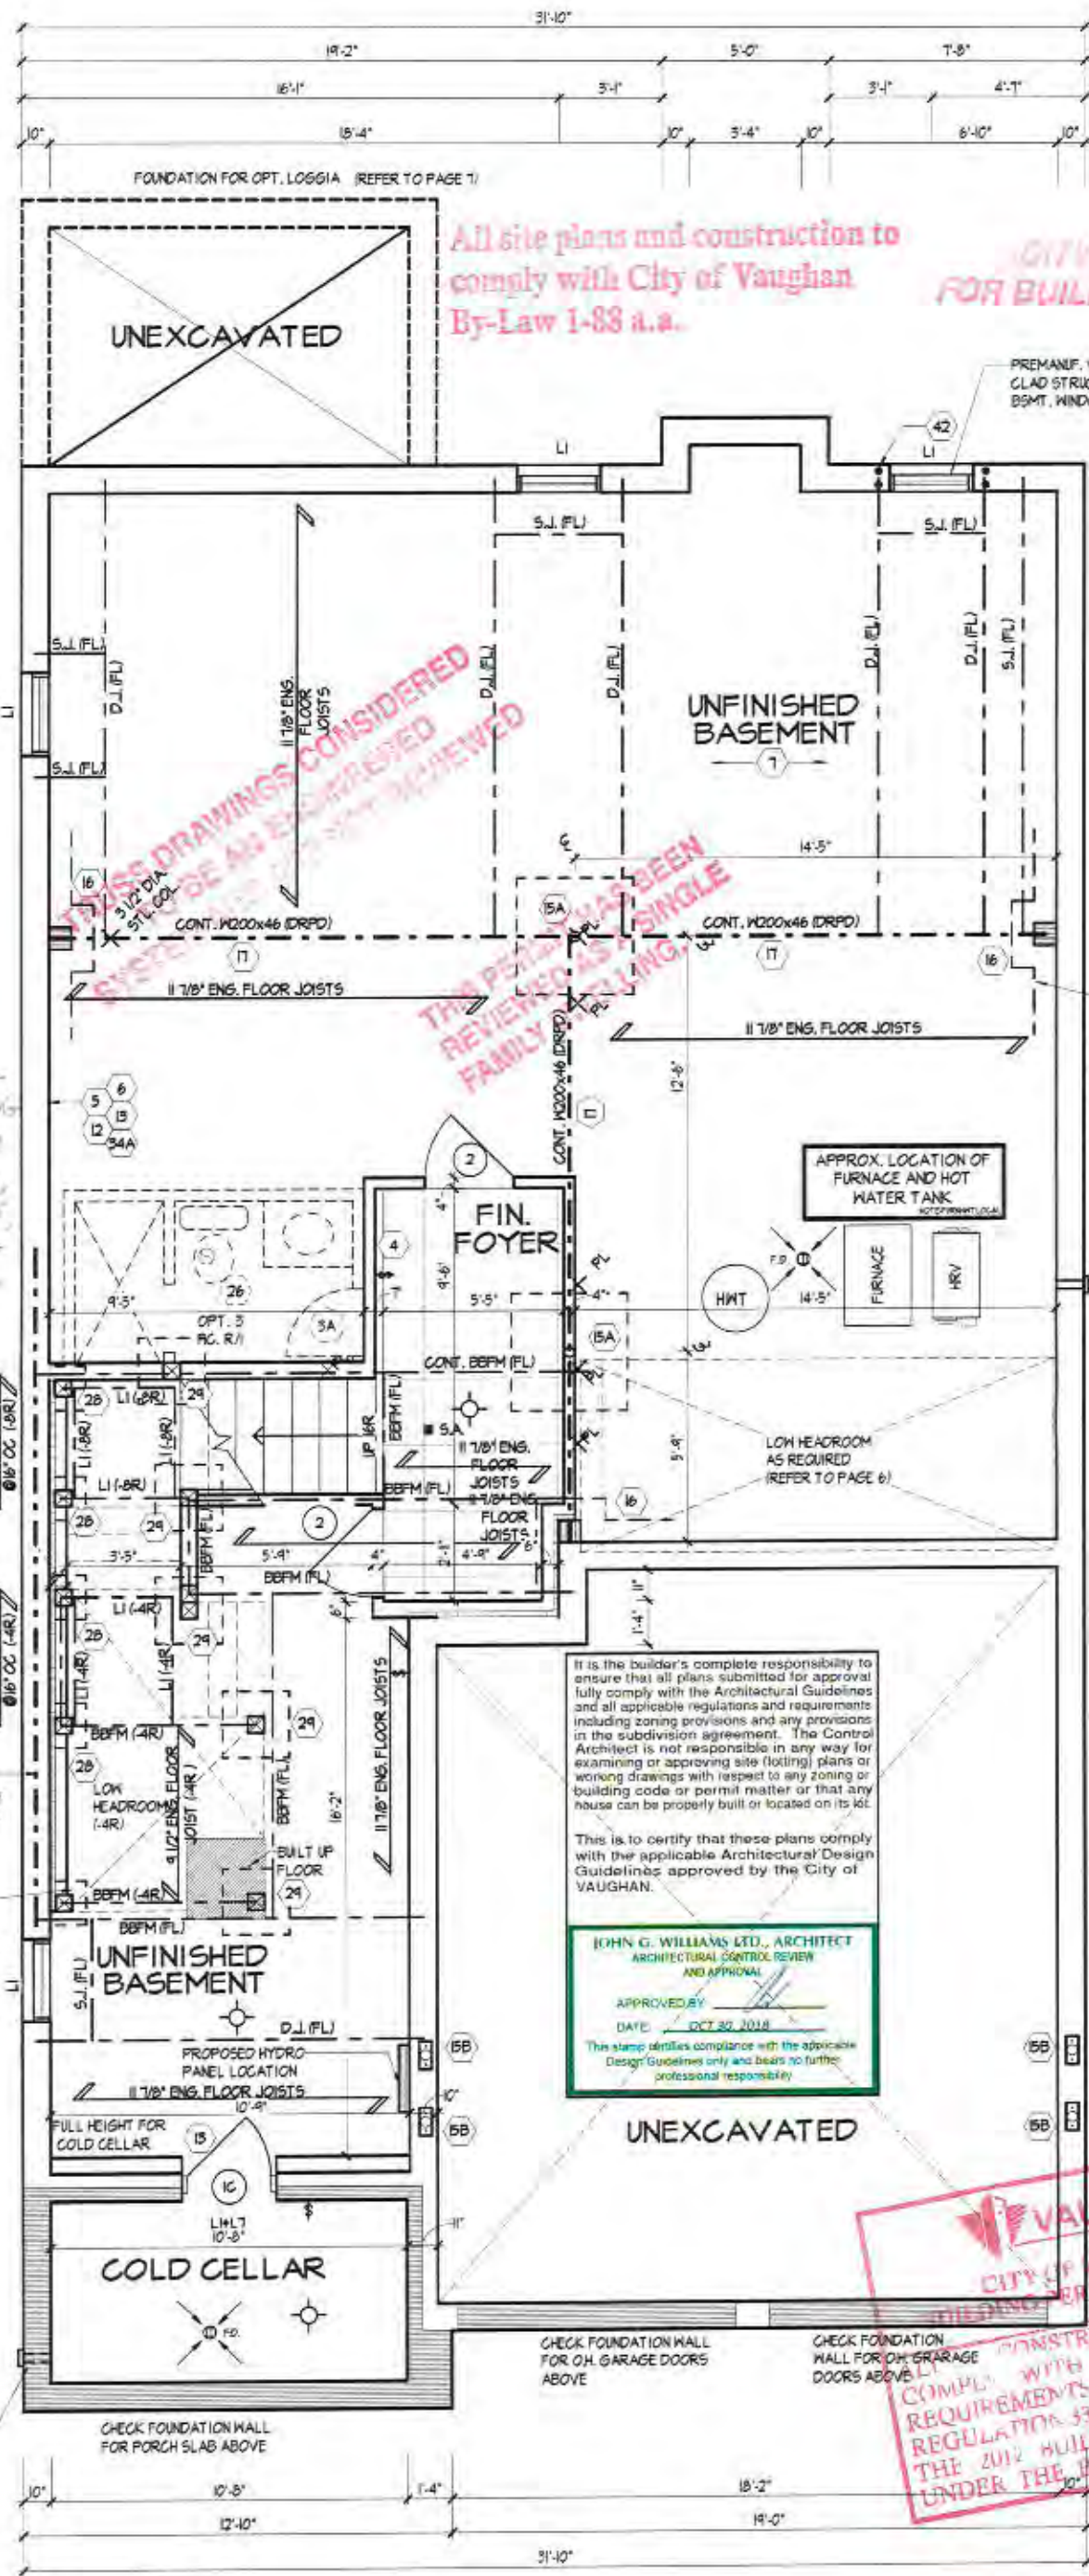

It is the builder's complete responsibility to ensure that all plans submitted for approval fully comply with the Architectural Guidelines and all applicable regulations and requirements including zoning provisions and any provisions in the subdivision agreement. The Control Architect is not responsible in any way for examining or approving site (lotting) plans or working drawings with respect to any zoning or building code or permit matter or that any house can be properly built or located on its lot.

This is to certify that these plans comply with the applicable Architectural Design Guidelines approved by the City of VAUGHAN.

JOHN G. WILLIAMS LTD., ARCHITECT
ARCHITECTURAL CONTROL REVIEW
AND APPROVAL

APPROVED BY: [Signature]
DATE: OCT 30, 2018

This stamp certifies compliance with the applicable Design Guidelines only and bears no further professional responsibility.

VAUGHAN
CITY OF VAUGHAN
BUILDING PERMIT DRAWINGS

CONSTRUCTION SHALL COMPLY WITH THE APPLICABLE REQUIREMENTS OF THE 2012 BUILDING CODE MADE UNDER THE BUILDING CODE ACT

BASEMENT PLAN, ELEV. 'A'

BASEMENT PLAN, ELEV. A




All site plans and construction to comply with City of Vaughan By-Law 1-88 a.a.

**CITY OF VAUGHAN
FOR BUILDING PERMIT ONLY**



ALL site plans and construction to comply with City of Vaughan By-Law 1-88 a.s.

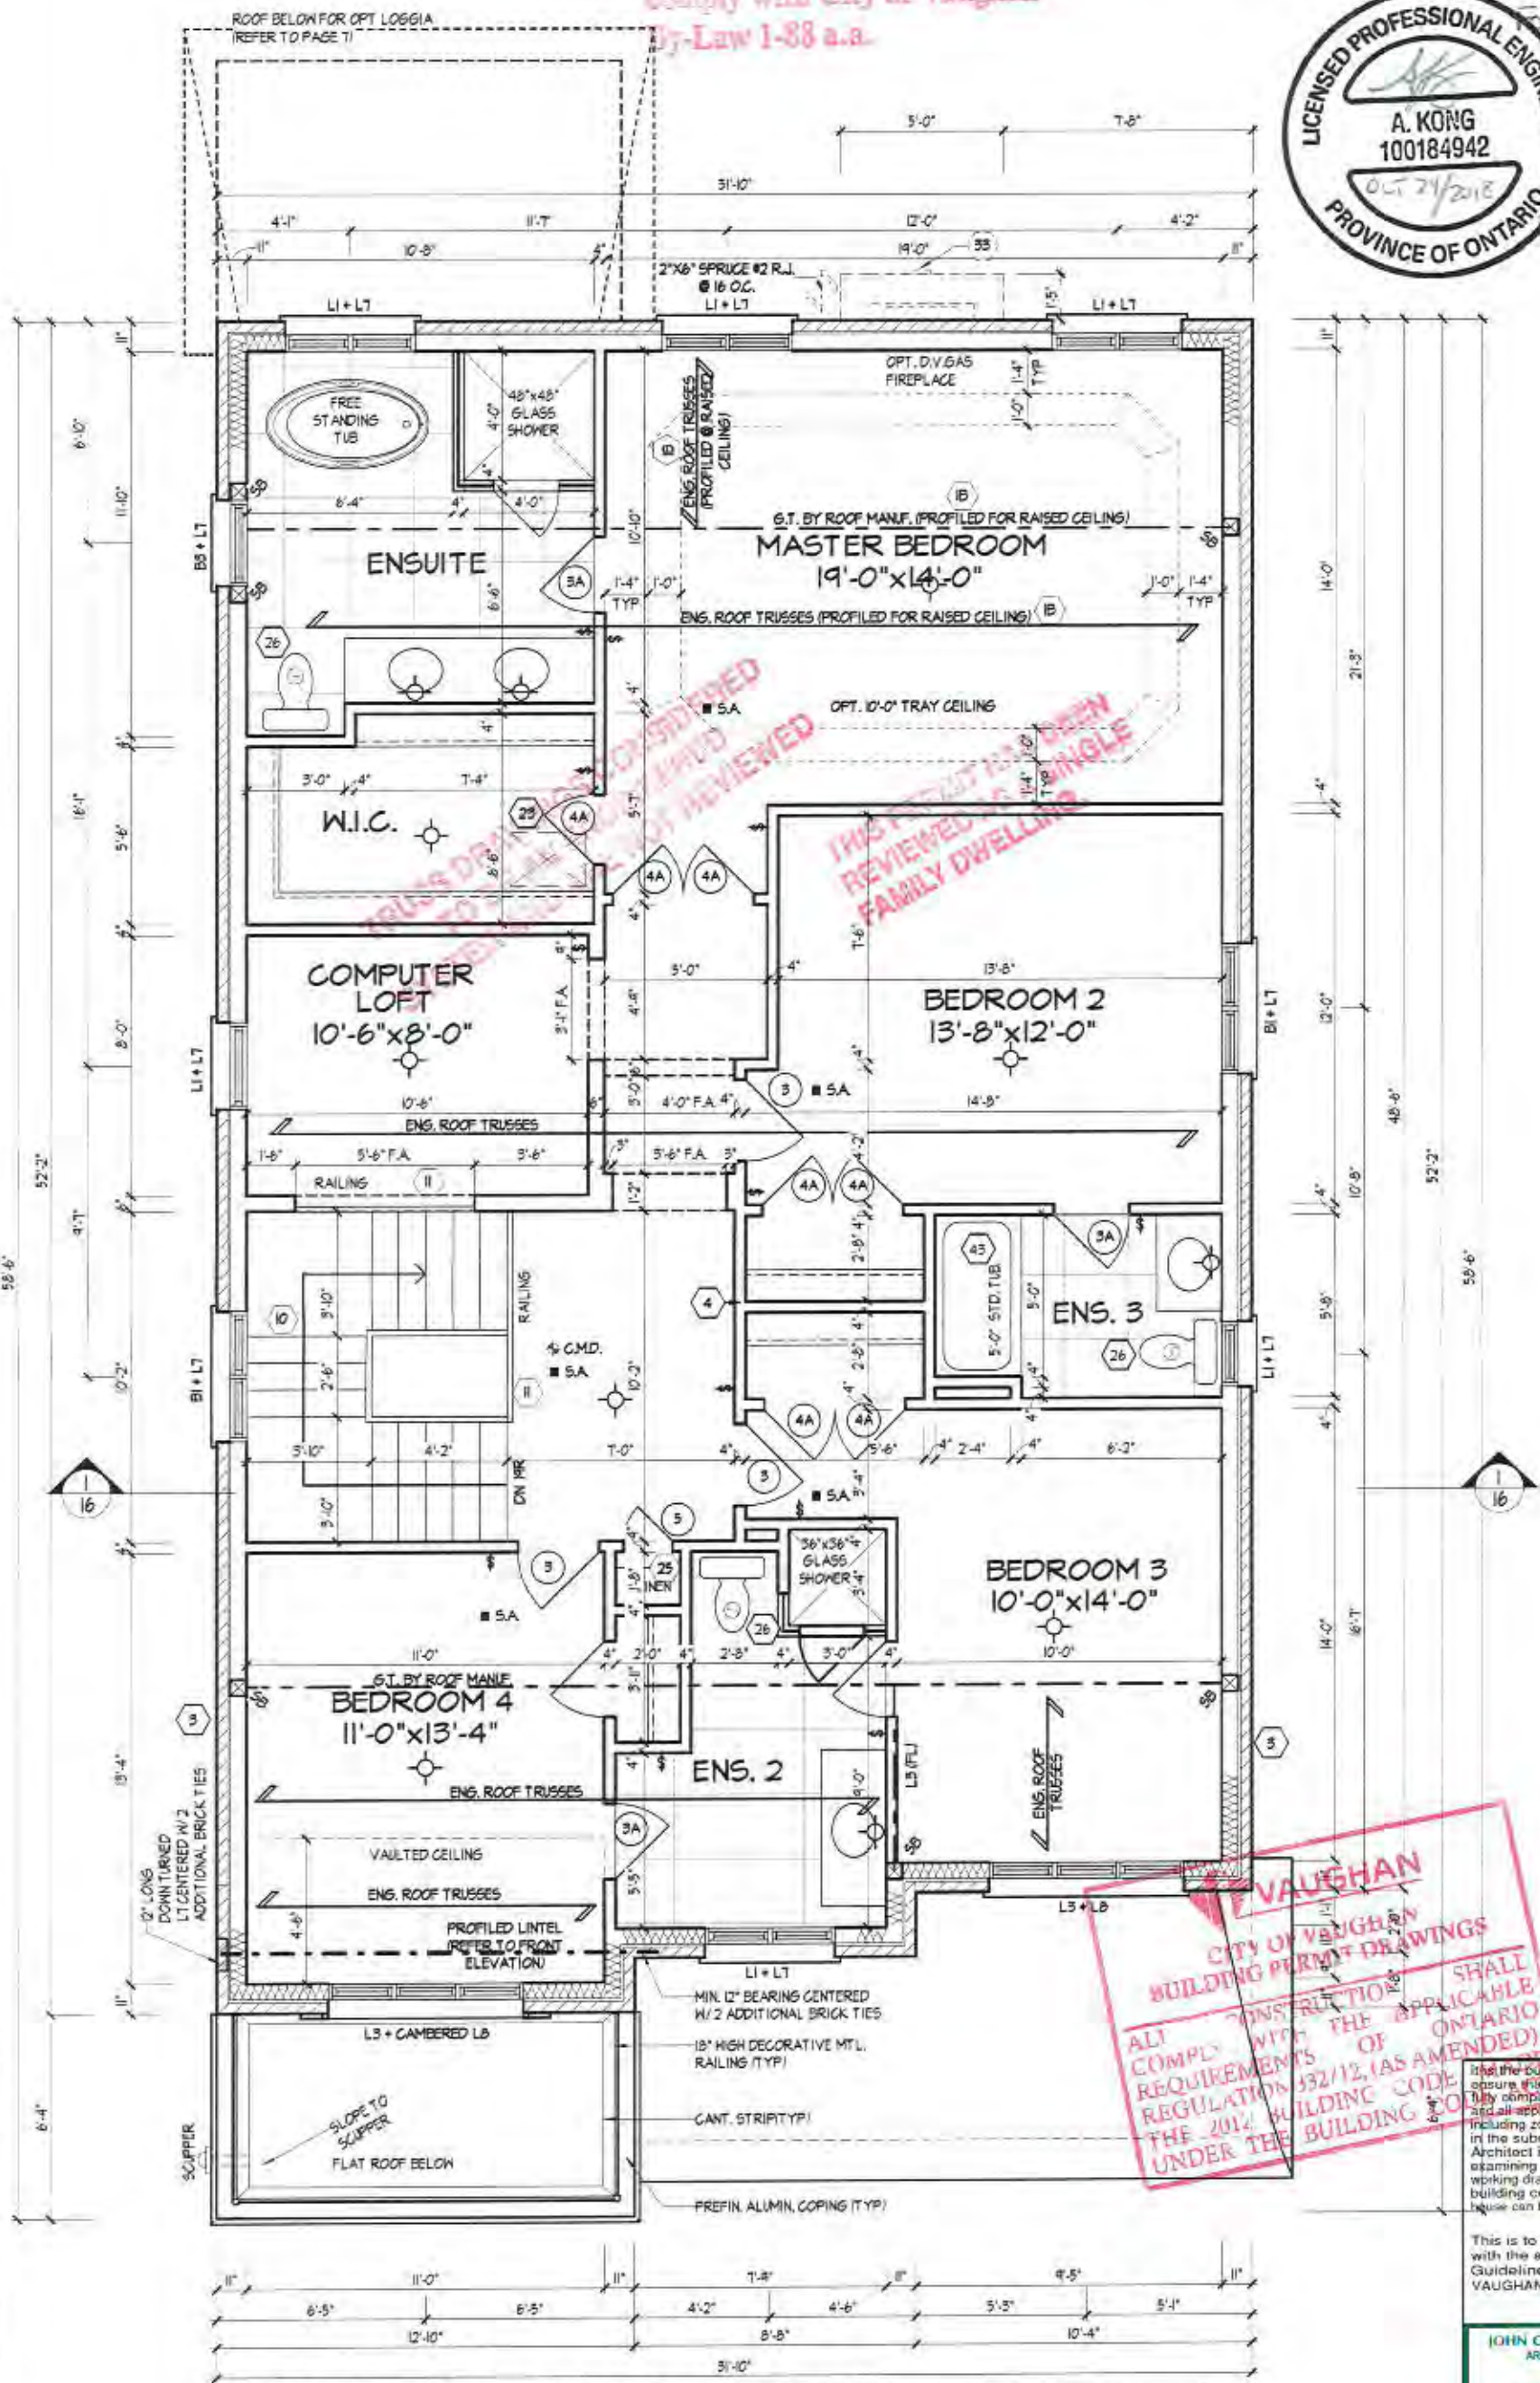

SECOND FLOOR PLAN, ELEV. 'A'

REFER TO ROOF TRUSS MANUFACTURER'S DRAWINGS FOR LAYOUT, SPACING, INSTALLATION DETAILS AND HANGER SIZES.

CITY OF VAUGHAN
BUILDING PERMIT DRAWINGS
ALL CONSTRUCTION SHALL COMPLY WITH THE APPLICABLE REQUIREMENTS OF THE 2012 BUILDING CODE OF THE CITY OF VAUGHAN.

It is the builder's complete responsibility to ensure that all plans submitted for approval comply with the applicable Architectural Guidelines and all applicable regulations and requirements including zoning provisions and any provisions in the subdivision agreement. The Control Architect is not responsible in any way for examining or approving site (lotting) plans or working drawings with respect to any zoning or building code or permit matter or that any house can be properly built or located on its lot.

This is to certify that these plans comply with the applicable Architectural Design Guidelines approved by the City of VAUGHAN.

JOHN G. WILLIAMS LTD., ARCHITECT
ARCHITECTURAL CONTROL REVIEW AND APPROVAL

APPROVED BY: [Signature]
DATE: OCT 30, 2018

This stamp certifies compliance with the applicable Design Guidelines only and bears no further professional responsibility.

SECOND FLOOR PLAN, ELEV. 'A'

THE UNDERSIGNED HAS REVIEWED AND TAKES RESPONSIBILITY FOR THIS DESIGN AND HAS THE QUALIFICATIONS AND MEETS THE REQUIREMENTS SET OUT IN THE ONTARIO BUILDING CODE AND A DESIGNER.

QUALIFICATION INFORMATION

Orin Fairbairn

NAME

REGISTRATION INFORMATION

HUNT DESIGN ASSOCIATES INC.

20201

BC91

19995

HUNT DESIGN ASSOCIATES INC.

www.huntdesign.ca

GOLDPARK HOMES - 217020
PINE VALLEY, VAUGHAN, ONTARIO

Drawn By

JLL

Checked By

OF

Scale

3/16"=1'-0"

File Number

217020WS4002.rvt

Page Number

4 of 18

8986 Woodbine Avenue, Suite 200, Markham, ON L3R 0J7

T 905.737.5133

F 905.737.7326

All drawings specifications related documents and design are the copyright property of Hunt Design Associates (H.D.A.). Reproduction of this property in whole or in part is strictly prohibited without H.D.A.'s written permission (H.D.A. assumes no responsibility or liability for this property unless it bears the appropriate BCN number and original signature.)

PROVIDE SOLID WOOD BLOCKING @ 24" O.C. FOR FIRST JOIST SPAN WHEN PARALLEL W/ EXTERIOR WALL


REFER TO FLOOR JOIST MANUFACTURER'S DRAWINGS FOR LAYOUT, SPACING, BLOCKING & STRAPPING REQUIREMENTS, INSTALLATION DETAILS AND HANGER SIZES, & SUBFLOOR THICKNESS

REFER TO STANDARD PLAN FOR COMPLETE CONSTRUCTION NOTES & DIMENSIONS


SPACE ALL FLOOR JOISTS @ 12" O.C. UNDER ALL CERAMIC TILE AREAS

All site plans and construction to comply with City of Vaughan By-Law 1-88 a.n.

CITY OF VAUGHAN
FOR BUILDING PERMIT ONLY

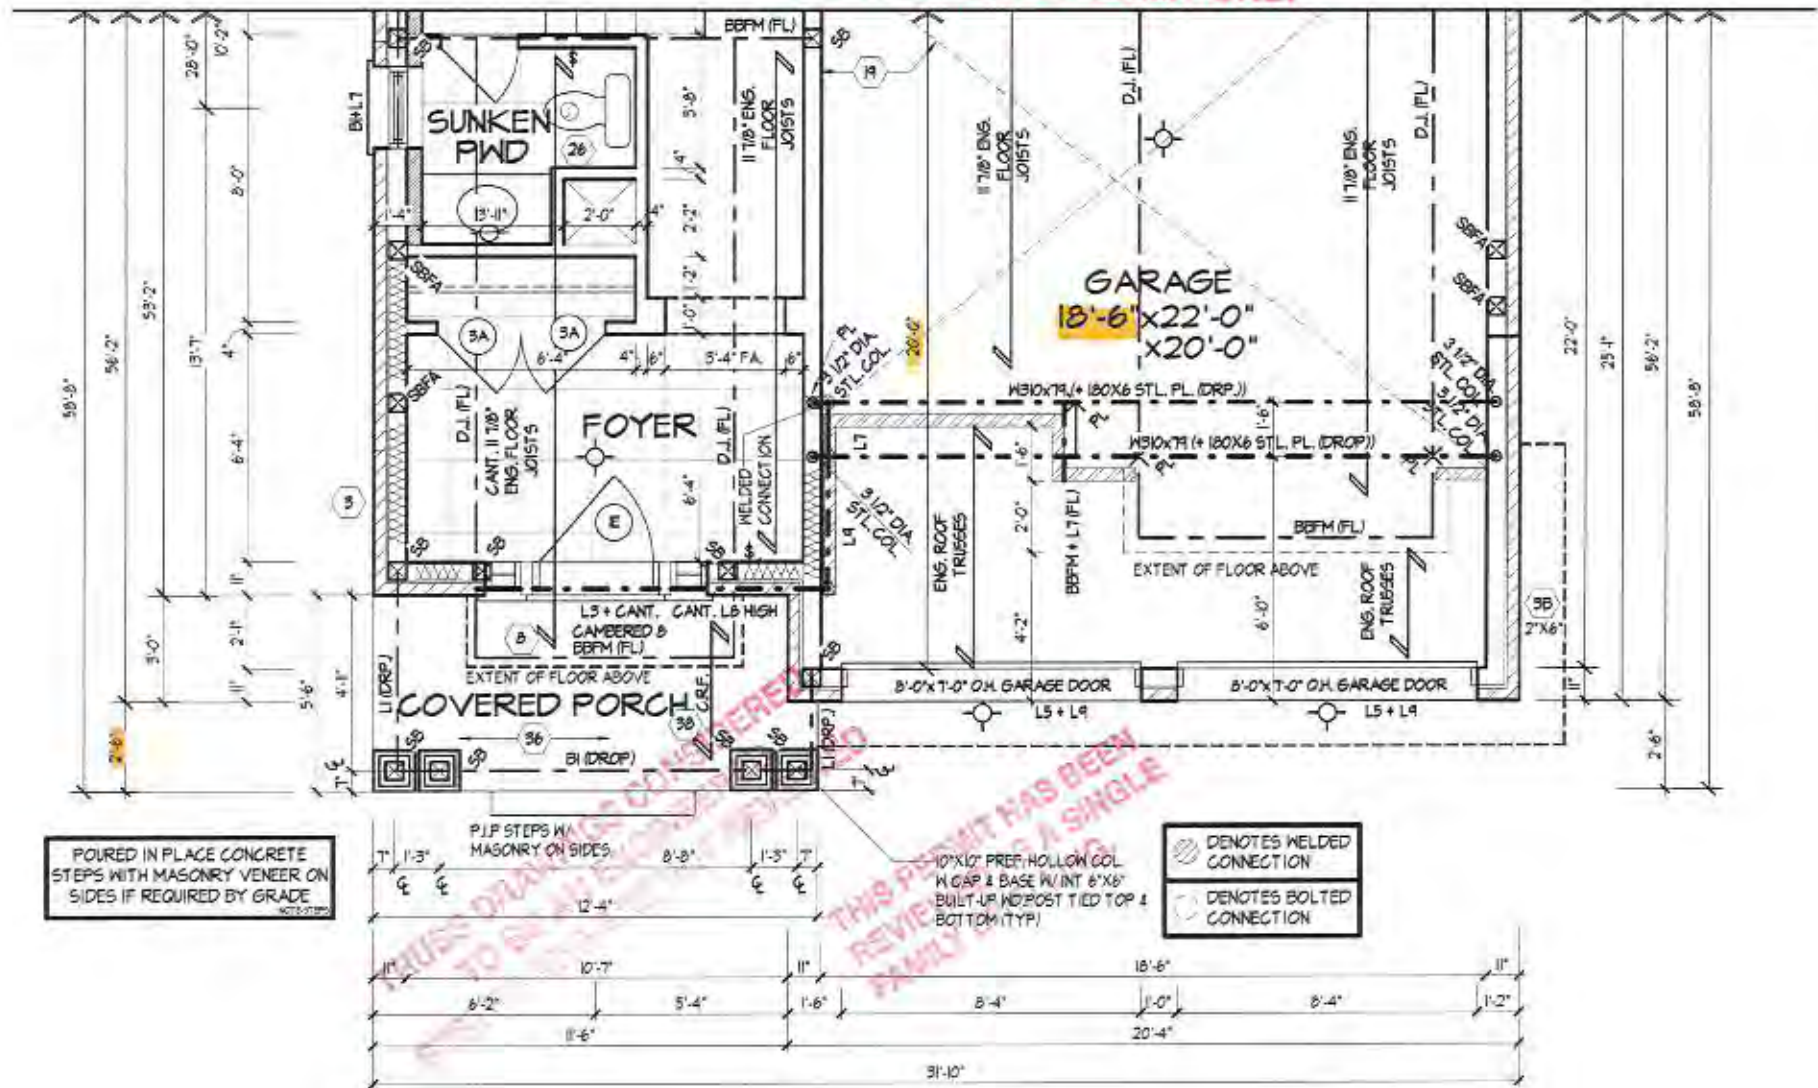

PART. GROUND FLOOR PLAN. ELEV. 'B'

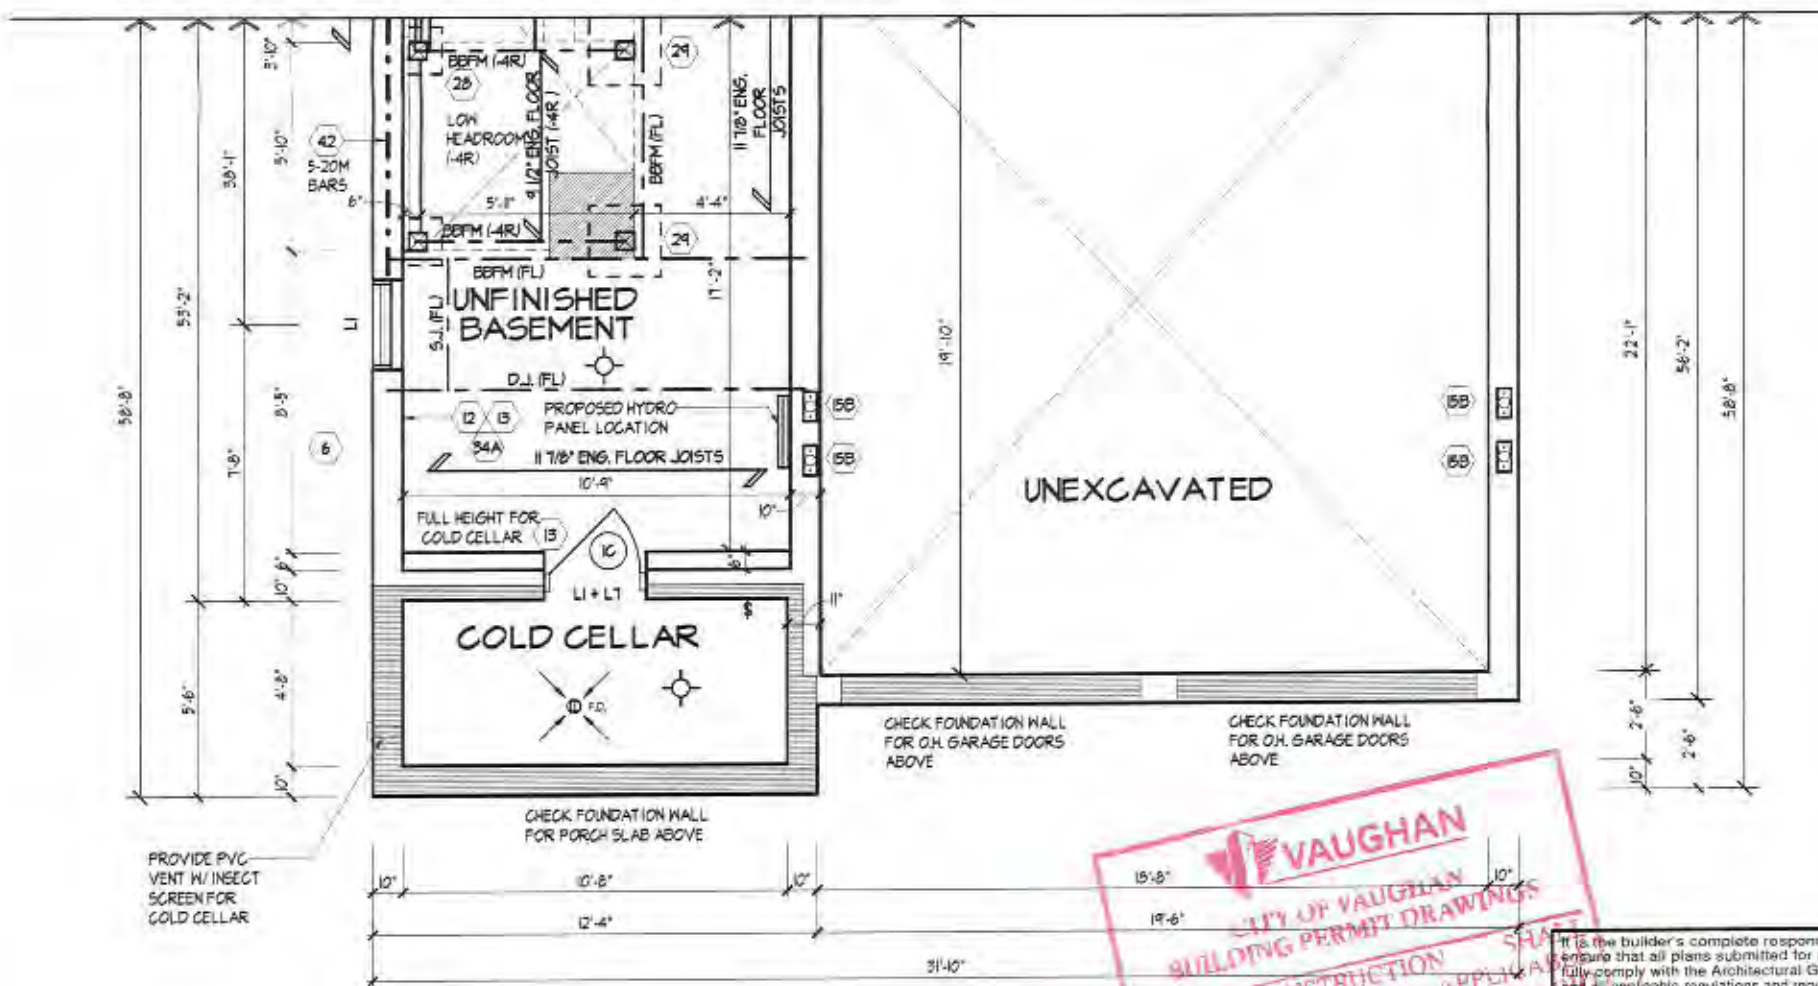

PART. BASEMENT PLAN ELEV. 'B'



PROVIDE SOLID WOOD BLOCKING @ 24" O.C. FOR FIRST JOIST SPAN WHEN PARALLEL W/ EXTERIOR WALL

REFER TO FLOOR JOIST MANUFACTURER'S DRAWINGS FOR LAYOUT, SPACING, BLOCKING & STRAPPING REQUIREMENTS, INSTALLATION DETAILS AND HANGER SIZES, & SUBFLOOR THICKNESS

SPACE ALL FLOOR JOISTS @ 12" O.C. UNDER ALL CERAMIC TILE AREAS

REFER TO STANDARD PLAN FOR COMPLETE CONSTRUCTION NOTES & DIMENSIONS



It is the builder's complete responsibility to ensure that all plans submitted for approval fully comply with the Architectural Guidelines and all applicable regulations and requirements including zoning provisions and any provisions of the subdivision agreement. The Control Architect is not responsible in any way for examining or approving site (lotting) plans or working drawings with respect to any zoning or building code or permit matter or that any plans can be properly built or located on its lot.

This is to certify that these plans comply with the applicable Architectural Design Guidelines approved by the City of VAUGHAN

JOHN G. WILLIAMS LTD., ARCHITECT
ARCHITECTURAL CONTROL REVIEW
AND APPROVAL
APPROVED BY: [Signature]
DATE: OCT 30, 2018
This stamp certifies compliance with the applicable Design Guidelines only and bears no further professional responsibility.

PART. BASEMENT & GROUND FLOOR PLAN ELEV. 'B'

GOLDPARK HOMES - 217020 UNIT 4002 - THE VALLEYVIEW
PINE VALLEY, VAUGHAN, ONTARIO
REV. 2018.10.24

HUNT
DESIGN ASSOCIATES INC.
www.hunt-design.ca


Drawn By: JLL
Checked By: OF
Scale: 3/16"=1'-0"
File Number: 217020WS4002.rvt
Page Number: 5 of 18
T 905.737.5133
F 905.737.7326

THE UNDERSIGNED HAS REVIEWED AND TAKES RESPONSIBILITY FOR THIS DESIGN AND HAS THE QUALIFICATIONS AND MEETS THE REQUIREMENTS SET OUT IN THE ONTARIO BUILDING CODE AND THE REQUIREMENTS QUALIFICATION INFORMATION
Orin Fairbairn
NAME
REGISTRATION INFORMATION
HUNT DESIGN ASSOCIATES INC.
19985

All drawings specifications related documents and design are the copyright property of Hunt Design Associates (H.D.A.). Reproduction of this property in whole or in part is strictly prohibited without H.D.A.'s written permission. H.D.A. assumes no responsibility or liability for this property unless it bears the appropriate BCN number and original signature.

All elev plans and construction to
comply with City of Vaughan
By-Law 1-88 a.a.


FOR BUILDING PERMIT ONLY

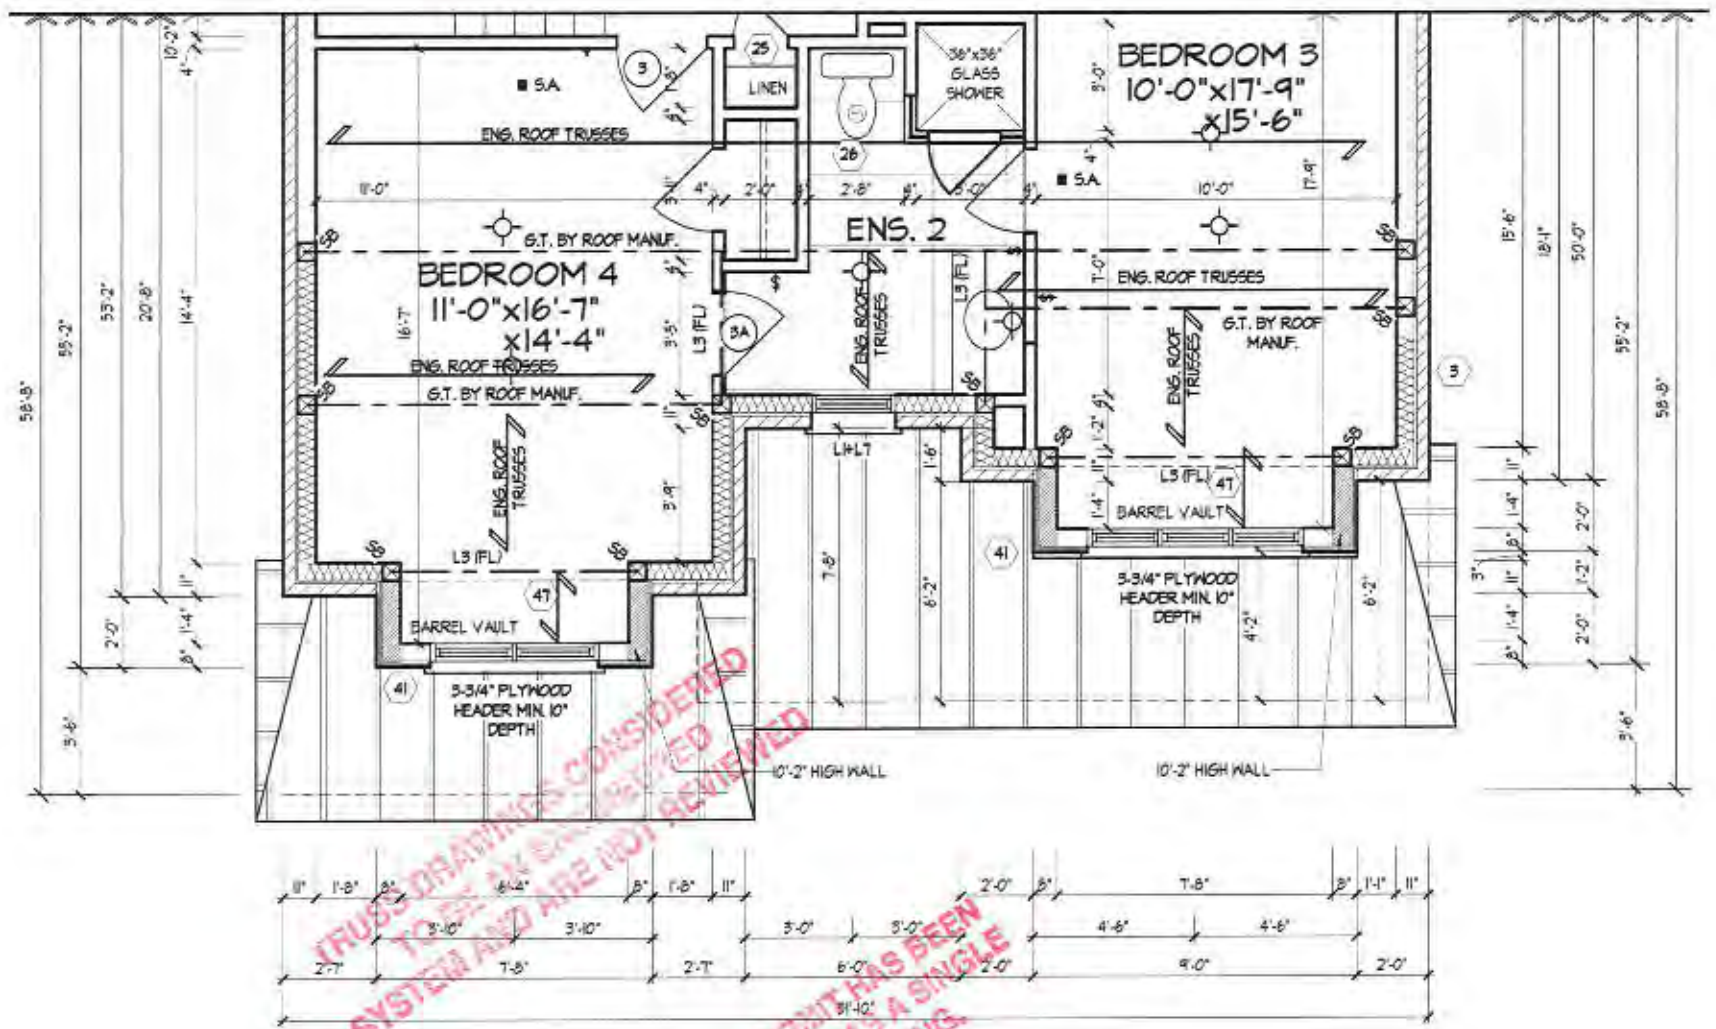

PART. SECOND FLOOR PLAN. ELEV. 'B'

REFER TO STANDARD PLAN FOR
COMPLETE CONSTRUCTION NOTES
& DIMENSIONS

REFER TO ROOF TRUSS
MANUFACTURER'S DRAWINGS FOR
LAYOUT, SPACING, INSTALLATION
DETAILS AND HANGER SIZES.

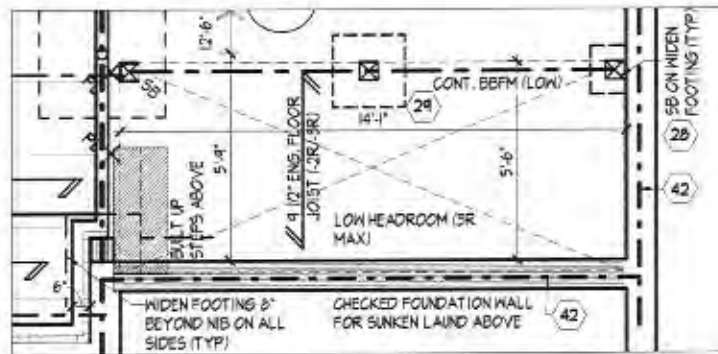

PART BASEMENT PLAN ELEV. A SUNKEN LAUNDRY CONDITION (ELEV. B SIMILAR)

REFER TO STANDARD PLAN FOR
COMPLETE CONSTRUCTION NOTES
& DIMENSIONS



PART. SEC FLR PLAN EL.'B' & PART. BSMT.PLAN FOR SUNK. LAUND.

GOLDPARK HOMES - 217020
PINE VALLEY, VAUGHAN, ONTARIO

UNIT 4002 - THE VALLEYVIEW
REV.2018.10.24


THE UNDERSIGNED HAS REVIEWED AND TAKES RESPONSIBILITY FOR THIS
DESIGN AND HAS THE QUALIFICATIONS AND MEETS THE REQUIREMENTS
SET OUT IN THE ONTARIO BUILDING CODE OF DESIGNER.

QUALIFICATION INFORMATION
Chris Fairbairn
NAME
REGISTRATION INFORMATION
HUNT DESIGN ASSOCIATES INC.
19685


HUNT
DESIGN ASSOCIATES INC.
www.hunt-design.ca

Drawn By: JLL
Checked By: OF
Scale: 3/16"=1'-0"
File Number: 217020WS4002.rvt
Page Number: 6 of 18
8966 Woodbine Avenue, Suite 200, Markham, ON L3R 0J7
T 905.737.5133
F 905.737.7326


All drawings specifications related documents and design are the copyright property of Hunt Design Associates (H.D.A.). Reproduction of this property in whole or in part is strictly prohibited without H.D.A.'s written permission (H.D.A. assumes no responsibility or liability for this property unless it bears the appropriate BCN number and original signature.)

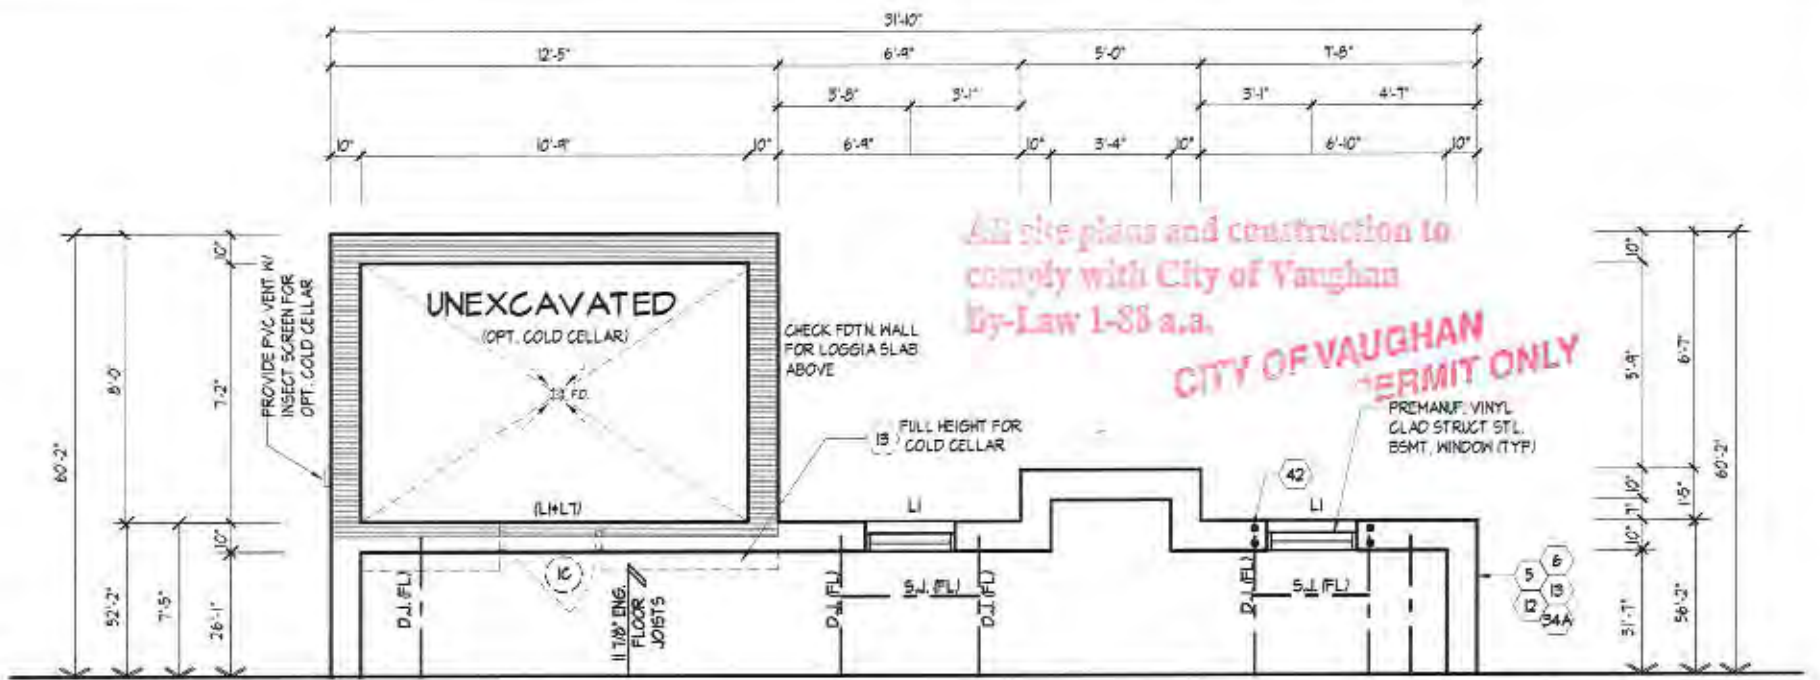

PART BASEMENT PLAN. ELEV. A. OPT. LOGGIA (EL. B. SIMILAR)

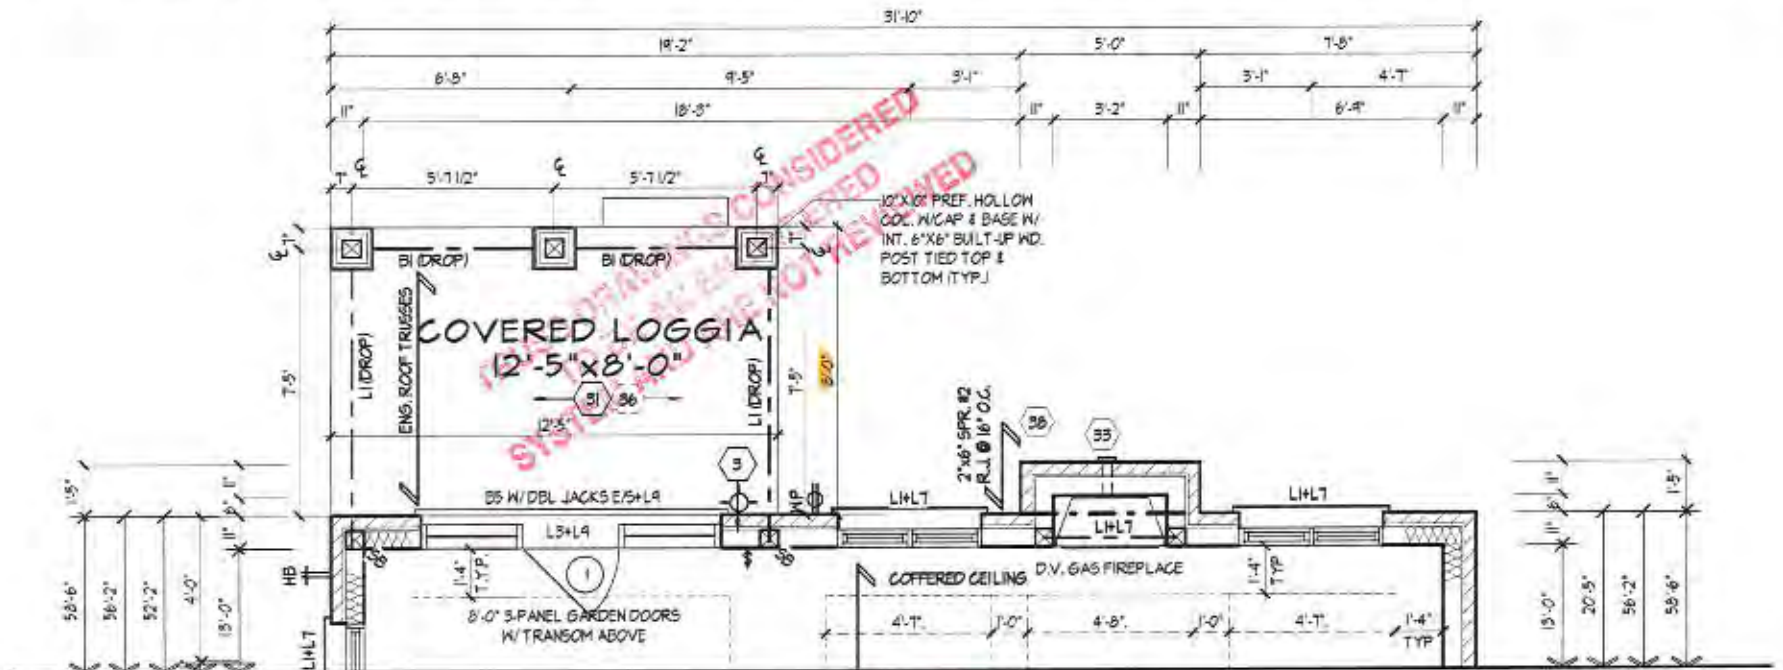

PART GROUND FLOOR PLAN. ELEV. A OPT. LOGGIA (EL. B SIMILAR)

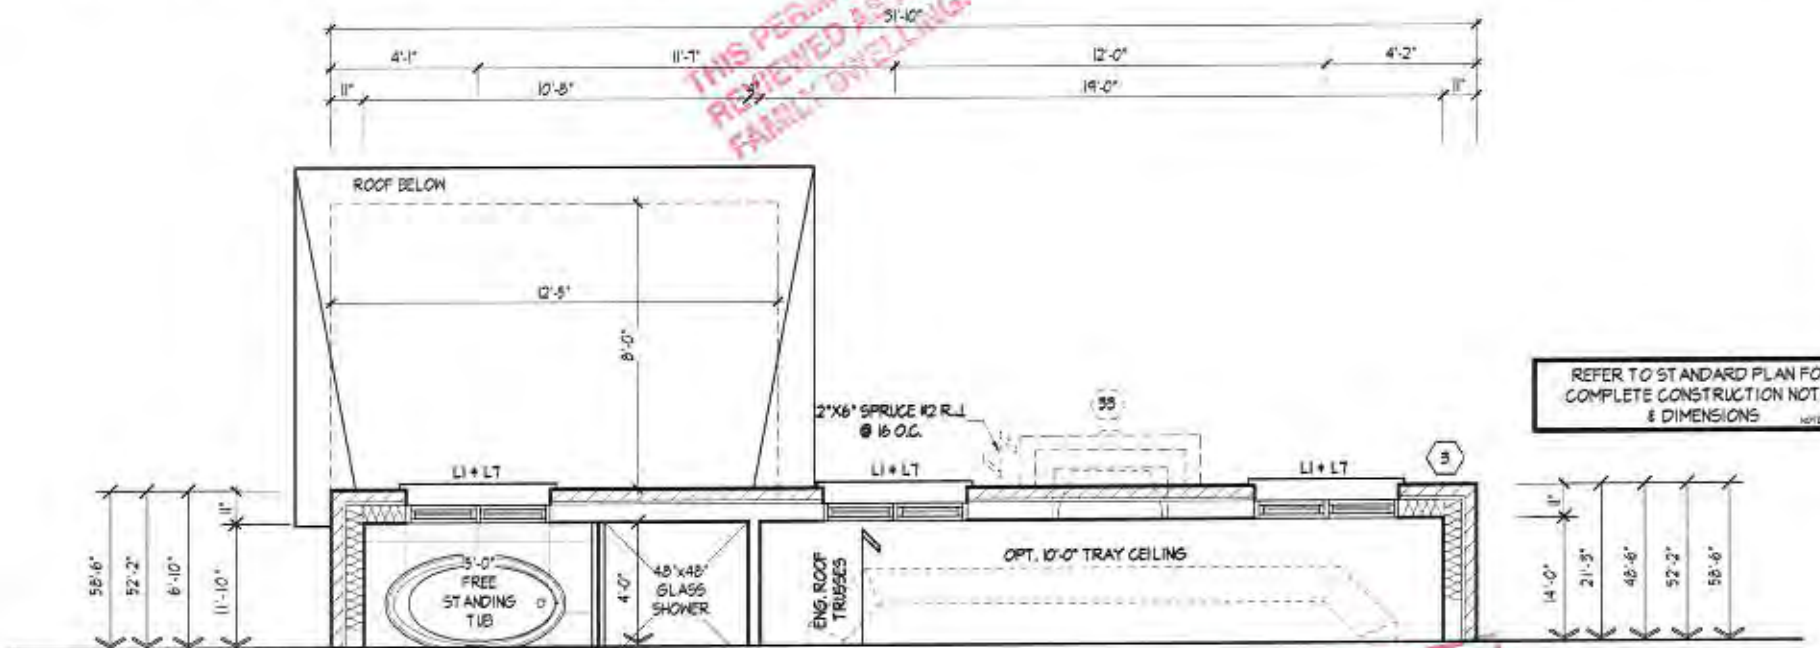

PART SECOND FLOOR PLAN. ELEV. A. OPT. LOGGIA (EL. B SIMILAR)



It is the builder's complete responsibility to ensure that all plans submitted for approval fully comply with the Architectural Guidelines and all applicable regulations and requirements including zoning provisions and any provisions in the subdivision agreement. The Control Architect is not responsible in any way for examining or approving site (lotting) plans or working drawings with respect to any zoning or building code or permit matter or that any house can be properly built or located on its lot.

This is to certify that these plans comply with the applicable Architectural Design Guidelines approved by the City of VAUGHAN.

JOHN G. WILLIAMS LTD., ARCHITECT
ARCHITECTURAL CONTROL REVIEW
AND APPROVAL

APPROVED BY:

DATE: OCT 30 2018

This stamp certifies compliance with the applicable Design Guidelines only and bears no further professional responsibility.

PART.FLOOR PLANS FOR LOGGIA COND.EL.A.(EL.'B' SIMILAR)

GOLDPARK HOMES - 217020 UNIT 4002 - THE VALLEYVIEW
PINE VALLEY, VAUGHAN, ONTARIO REV.2018.10.24

Drawn By: JLL Checked By: OF Scale: 3/16"=1'-0" File Number: 217020WS4002.rvt Page Number: 7 of 18

8966 Woodbine Avenue, Suite 200, Markham, ON L3R 0J7 T 905.737.5133 F 905.737.7326

THE UNDERSIGNED HAS REVIEWED AND TAKES RESPONSIBILITY FOR THIS DESIGN AND HAS THE QUALIFICATIONS AND MEETS THE REQUIREMENTS SET OUT IN THE ONTARIO BUILDING CODE AS A DESIGNER.

QUALIFICATION INFORMATION

Orin Fairbairn 20201 20201

NAME: JUNAIRE

REGISTRATION INFORMATION

HUNT DESIGN ASSOCIATES INC. 19996

HUNT DESIGN ASSOCIATES INC.

www.huntdesign.ca

All drawings specifications related documents and design are the copyright property of Hunt Design Associates (H.D.A.) Reproduction of this property in whole or in part is strictly prohibited without H.D.A.'s written permission (H.D.A. assumes no responsibility or liability for this property unless it bears the appropriate BCIN number and original signature.)

WINDOW SUMMARY

PER O.B.C. TABLE 9.10.15.4

RIGHT SIDE ELEVATION A - STANDARD PLAN

WT	WIDTH	HEIGHT	WINDOW/ DOOR FRAME SIZE (SF)
1	24"	48"	6.11 SF
1	28"	52"	8.00 SF
1	48"	52"	14.67 SF
1	54"	68"	22.22 SF
			51.00 SF

SPATIAL CALCULATION

EXPOSING BUILDING	1196.79	S.F.
FACE AREA	111.19	S.M.
PORTION WALL AREA	1196.79	S.F.
	111.19	S.M.
LIMITING DISTANCE	1.2 m	
MAX. % OPENINGS	7 %	
OPENINGS ALLOWED	83.78 SF	
OPENINGS PROVIDED	51.00 SF	

ADDITIONAL NOTES

GLAZED AREA CALCULATED W/ FRAME SIZE
MINUS 2" AROUND ENTIRE PERIMETER

ASPHALT SHINGLES (TYP)

VALLEY FLASHING (TYP)

PREMAUF. FREEZE BOARD
(CANAMOULD/CAN-BANDS (TYP))

24"x10" PRECAST CONC. IMPOST
ON 12"x21" PRECAST CONC. ACCENT (TYP)

18" PREMAUF. MTL.
RAILING (TYP)

PREFIN. MTL. FLASHING
W/ CAULKING TO MATCH
MASONRY COLOUR (TYP)

6" MTL. FLASHING W/
CAULKING BEYOND (TYP)

2-10"x10" PREF.
HOLLOW COL. W/
CAP & BASE ON 30"x16"
MASONRY PIER W/
INT. 6"x6" BUILT-UP
W/POST TIED TOP &
BOTTOM (TYP)

STONE VENEER
(TYP)

REFER TO FRONT
ELEVATION FOR TYPICAL
NOTES & INFORMATION

ROOF OVERHANGS TO BE 15"
UNLESS NOTED OTHERWISE

NOTE 2-0556A1

All site plans and construction to
comply with City of Vaughan
By-Law 1-83 n.s.

CITY OF VAUGHAN
FOR BUILDING PERMIT ONLY

It is the builder's complete responsibility to
ensure that all plans submitted for approval
fully comply with the Architectural Guidelines
and all applicable regulations and requirements
including zoning provisions and any provisions
in the subdivision agreement. The Control
Architect is not responsible in any way for
examining or approving site (existing plans or
new drawings) or for any errors or omissions
which may occur in the construction of the
house can be properly built or located on its lot.

This is to certify that these plans comply
with the applicable Architectural Design
Guidelines approved by the City of
VAUGHAN.

KOHN G. WILLIAMS LTD., ARCHITECT
ARCHITECTURAL CONTROL REVIEW
AND APPROVAL

APPROVED BY

DATE

This stamp certifies compliance with the applicable
Design Guidelines only and does not constitute
professional responsibility.


RIGHT SIDE ELEVATION 'A'

GOLDPARK HOMES - 217020
UNIT 4002 - THE VALLEYVIEW
PINE VALLEY, VAUGHAN, ONTARIO
REV. 2018.10.24

Scale: 3/16" = 1'-0"
JLL OF 217020WS4002.rvt
T 905.737.5133
F 905.737.7326

HUNT
DESIGN ASSOCIATES INC.
www.huntdesign.ca

THE UNDERSIGNED HAS PROVIDED AND TAKES RESPONSIBILITY FOR THE
DESIGN AND HAS THE QUALIFICATIONS AND MEETS THE REQUIREMENTS
SET OUT IN THE ONTARIO BUILDING CODE
QUALIFICATION INFORMATION
Onn Fairburn
20201
18595
HUNT DESIGN ASSOCIATES INC.
All drawings specifications related documents and design are the copyright property of Hunt Design Associates (H.D.A.). Reproduction of this property in whole or in part is strictly prohibited without H.D.A.'s written permission. H.D.A. assumes no responsibility or liability for this property unless it bears the appropriate H.D.A. number and original signature.

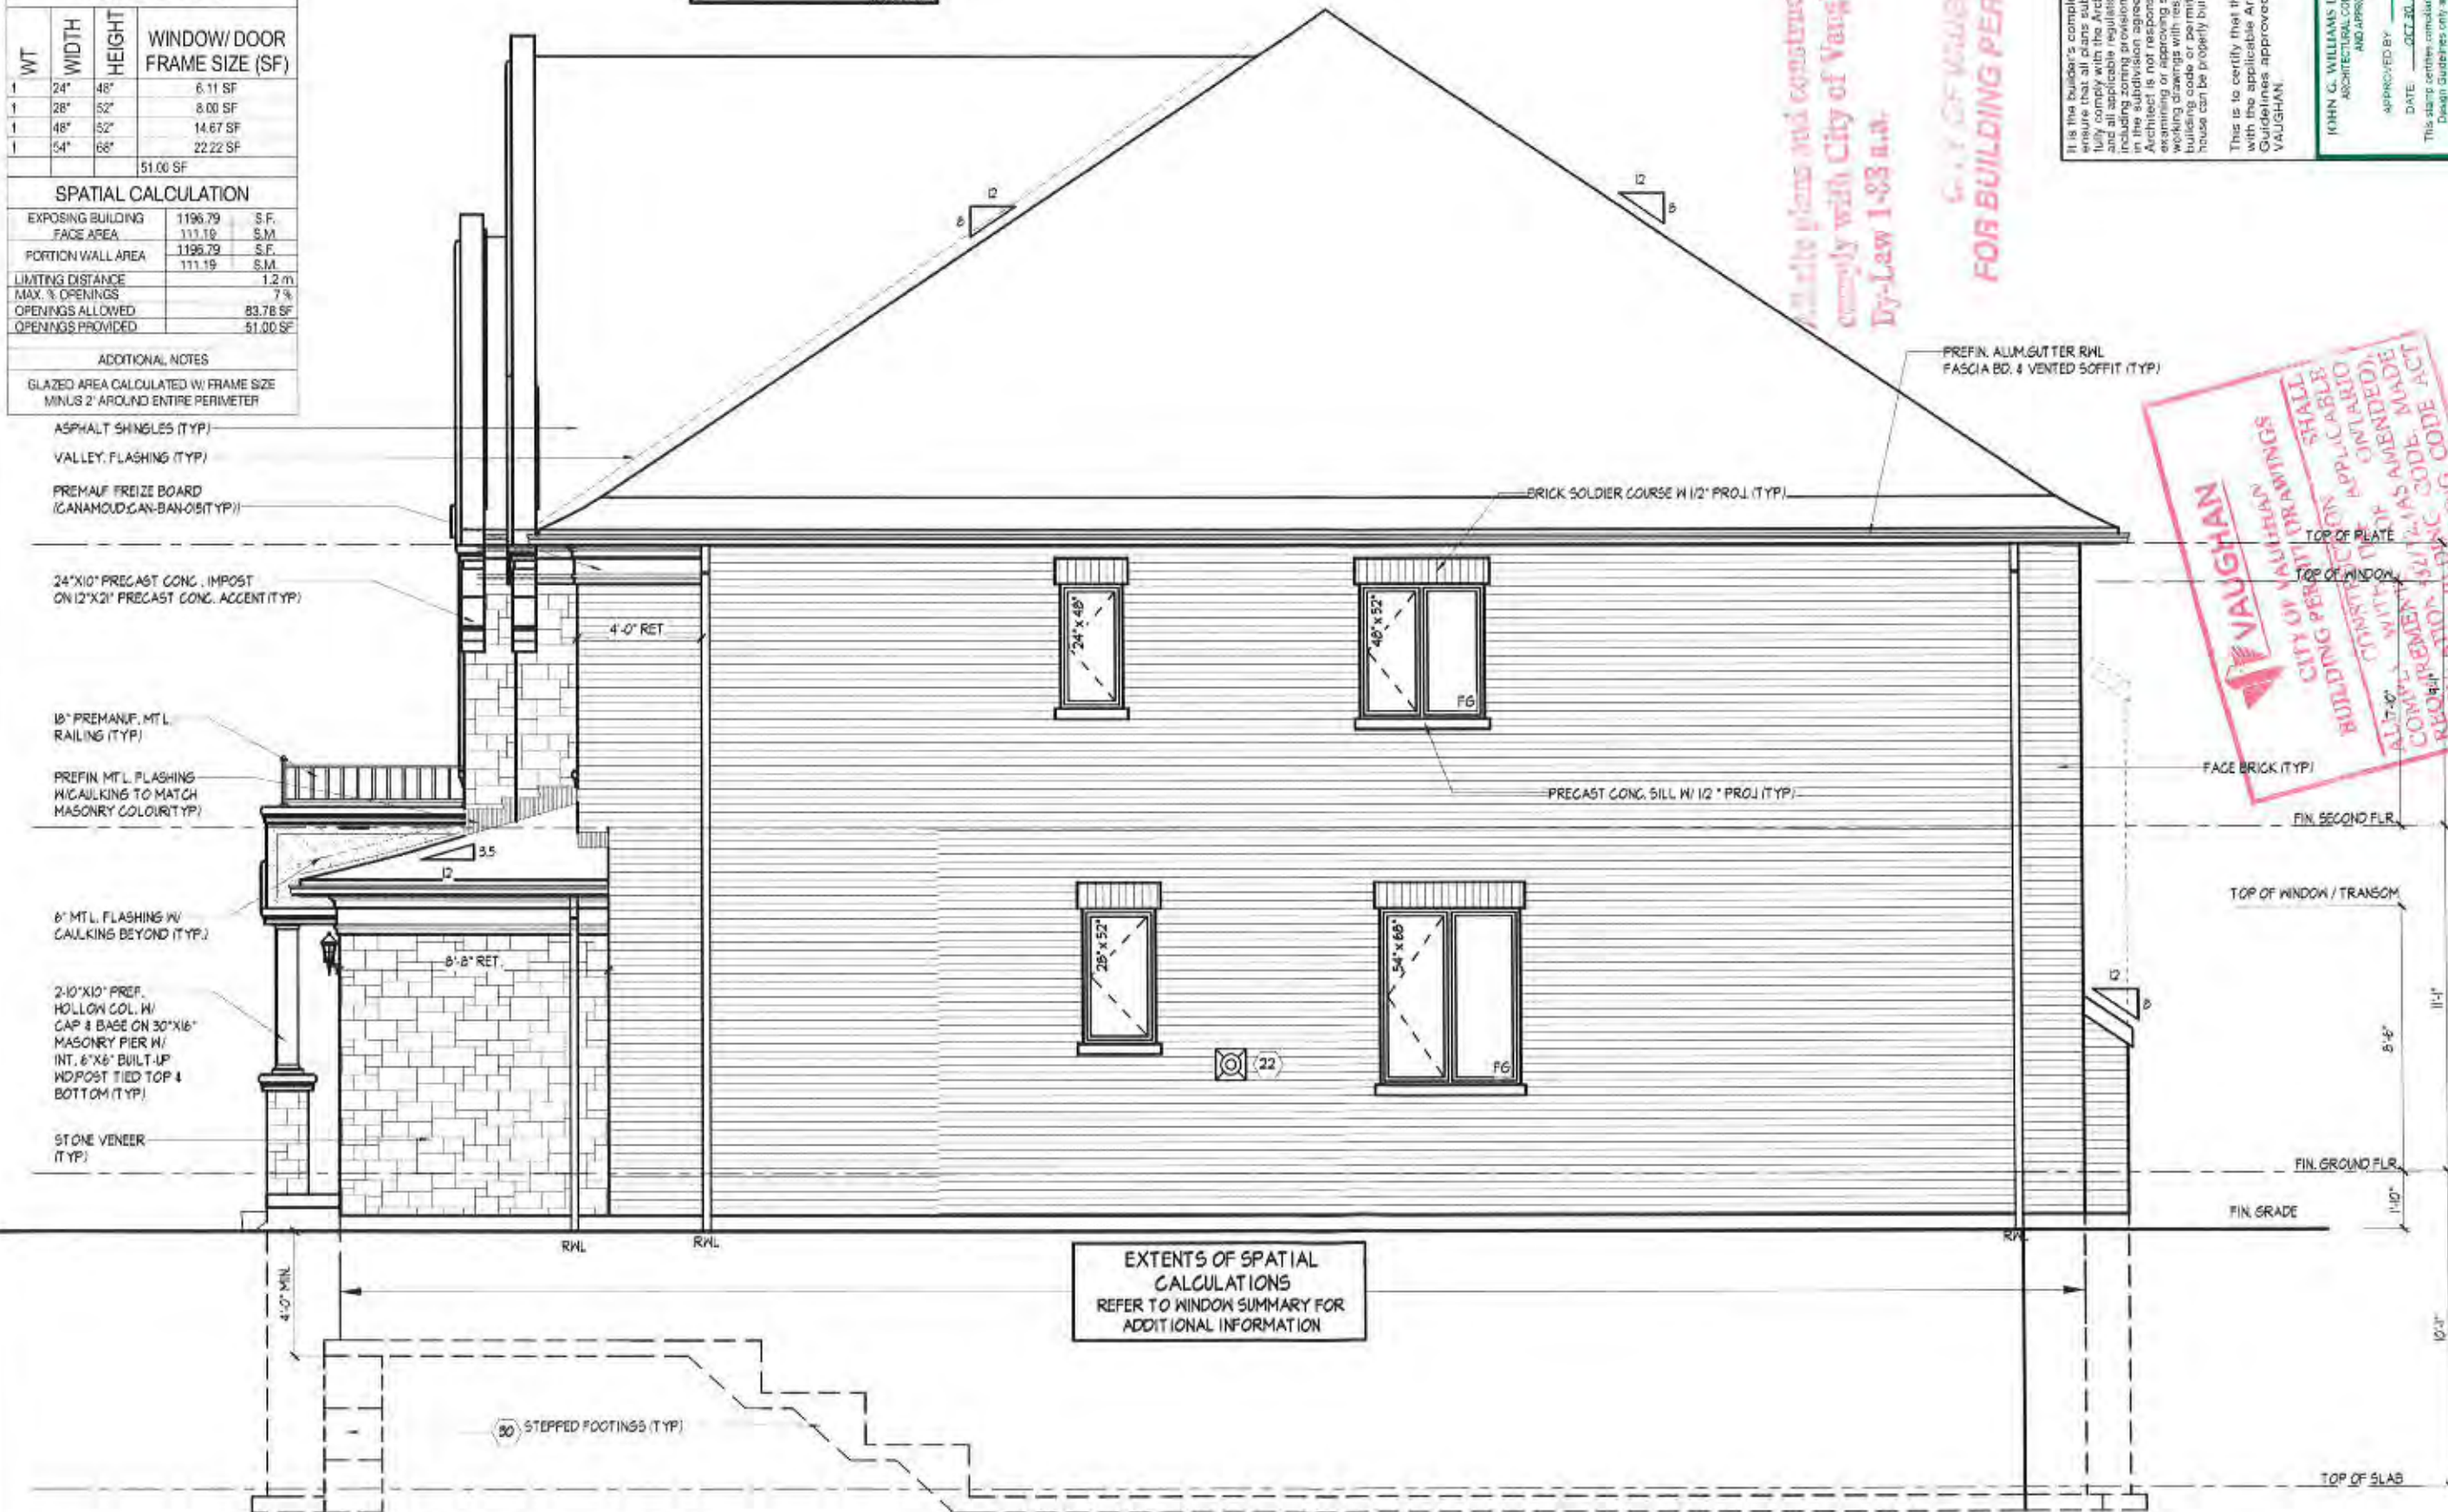

RIGHT SIDE ELEVATION, 'A'

EXTENTS OF SPATIAL
CALCULATIONS
REFER TO WINDOW SUMMARY FOR
ADDITIONAL INFORMATION

VAUGHAN
CITY OF VAUGHAN
BUILDING PERMIT
CONSTRUCTION SHALL
COMPLY WITH THE
APPLICABLE
BUILDING CODE ACT
AND THE BUILDING
REGULATION CODE
MADE UNDER
THE BUILDING
ACT, 1992

WINDOW SUMMARY PER O.B.C. TABLE 9.10.15.4

REAR EL. A & B - STANDARD PLAN

QUANT.	WIDTH	HEIGHT	WINDOW/ DOOR FRAME SIZE (SF)
2	30"	16"	4.33 SF
1	100"	20"	10.67 SF
2	48"	52"	29.33 SF
1	48"	60"	17.11 SF
2	48"	68"	39.11 SF
1	100"	82"	32.36 SF
			132.83 SF

SPATIAL CALCULATION

EXPOSING BUILDING FACE AREA	701.67	S.F.
PORTION WALL AREA	701.67	S.F.
LIMITING DISTANCE	7.5 m	
MAX. % OPENINGS	50 %	
OPENINGS ALLOWED	350.84 SF	
OPENINGS PROVIDED	132.93 SF	

ADDITIONAL NOTES

GLAZED AREA CALCULATED W/ FRAME SIZE
MINUS 2" AROUND ENTIRE PERIMETER



REAR ELEVATION, 'A/B'

ROOF OVERHANGS TO BE 15"
UNLESS NOTED OTHERWISE

REFER TO FRONT
ELEVATION FOR TYPICAL
NOTES & INFORMATION

It is the builder's complete responsibility to ensure that all plans submitted for approval fully comply with the Architectural Guidelines and all applicable regulations and requirements including zoning provisions and any provisions in the subdivision agreement. The Control Architect is not responsible in any way for examining or expediting site location plans or working drawings with respect to any zoning or building code requirements. The Control Architect's house can be properly built or located on its lot.

This is to certify that these plans comply with the applicable Architectural Design Guidelines approved by the City of VAUGHAN.

JOHN C. WILLIAMS LTD., ARCHITECT
ARCHITECTURAL CONTROL REVIEW
AND APPROVAL

APPROVED BY: [Signature]
DATE: OCT 30, 2018

This stamp certifies compliance with the applicable Design Guidelines only and bears no liability for the architectural responsibility.

CITY OF VAUGHAN
BUILDING PERMIT DRAWINGS
SHALL CONSTRUCTION SHALL
COMPLY WITH THE APPLICABLE
BUILDING CODE ACT
REGULATIONS 437.12.1.15 AS AMENDED
UNDER THE BUILDING CODE ACT

CITY OF VAUGHAN
FOR BUILDING PERMIT ONLY
City-Law 1-83 a.a.

REAR ELEVATION A/B

GOLDPARK HOMES - 217020 UNIT 4002 - THE VALLEYVIEW
PINE VALLEY, VAUGHAN, ONTARIO
REV. 2018.10.24

HUNT
DESIGN ASSOCIATES INC.
www.huntdesign.ca


THE UNDERSIGNED HAS REVIEWED AND TAKES RESPONSIBILITY FOR THE DESIGN AND THE QUALIFICATIONS OF THE DESIGNER'S THE REQUIREMENTS SET OUT IN THE ONTARIO BUILDING CODE. DESIGNER'S QUALIFICATION INFORMATION

NAME: [Signature]
DATE: 2020/1/15/20

REGISTRATION INFORMATION
HUNT DESIGN ASSOCIATES INC.
19665
All drawings specifications related documents and design are the copyright property of Hunt Design Associates (H.D.A.). Reproduction of this property in whole or in part is strictly prohibited without H.D.A.'s written permission. H.D.A. assumes no responsibility or liability for this property unless it bears the appropriate BCN number and original signature.

File Number: 217020WS4002.rvt
Scale: 3/16" = 1'-0"
Drawn By: JLL
Checked By: JLL
Date: 2018.10.24
Page Number: 11 of 18
P: 906.737.7326

ROOF OVERHANGS TO BE 15" UNLESS NOTED OTHERWISE

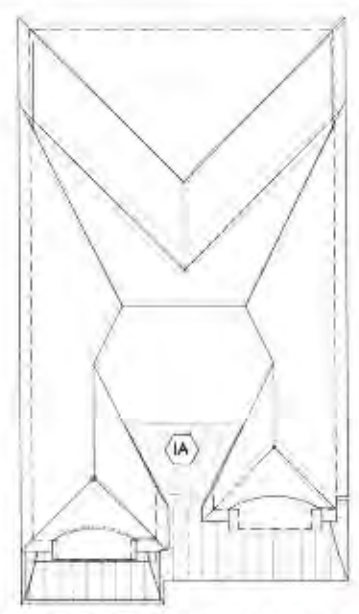

ROOF PLAN EL. 'B'
N.T.S.

JOHN G. WILLIAMS LTD., ARCHITECT
ARCHITECTURAL CONTROL REVIEW
AND APPROVAL
APPROVED BY: [Signature]
DATE: OCT 30, 2018
This stamp certifies compliance with the applicable Design Guidelines only and does not constitute professional responsibility.

It is the builder's complete responsibility to ensure that all plans submitted for approval fully comply with the Architectural Guidelines and all applicable regulations and requirements including zoning provisions and any provisions in a subdivision agreement. The Control Architect is not responsible for the accuracy of any drawings with respect to any zoning or building code or permit matter on that any request can be properly built or located on its lot. This is to certify that these plans comply with the applicable Architectural Design Guidelines approved by the City of VAUGHAN.

FOR BUILDING PERMIT ONLY
CITY OF VAUGHAN
BUILDING PERMIT DRAWINGS
ALL CONSTRUCTION SHALL APPLY WITHIN THE CITY OF VAUGHAN
CONSTRUCTION SHALL BE IN ACCORDANCE WITH THE BUILDING CODE REGULATION 221-141-0000
VAUGHAN



FRONT ELEVATION 'B'

FRONT ELEVATION 'B'
GOLDPARK HOMES - 217020 UNIT 4002 - THE VALLEYVIEW
PINE VALLEY, VAUGHAN, ONTARIO
REV. 2018.10.24

HUNT HILL
DESIGN ASSOCIATES INC.
www.huntdesign.ca

20201
B01
18605

NAME: [Signature]
REGISTRATION INFORMATION: [Signature]
HUNT DESIGN ASSOCIATES INC.
All drawings specifications related documents and design are the copyright property of Hunt Design Associates Inc. (H.D.A.). Reproduction of this property in whole or in part is strictly prohibited without H.D.A.'s written permission. H.D.A. assumes no responsibility or liability for this property unless it bears the appropriate H.D.A. number and original signature.

Page Number: 12 of 18
File Number: 217020WS4002.rvt
T 905.737.5133
F 905.737.7328

WINDOW SUMMARY

PER O.B.C. TABLE 9.10.15.4

LEFT SIDE ELEVATION B - STANDARD PLAN

WT	WT	WIDTH	HEIGHT	WINDOW/ DOOR FRAME SIZE (SF)
1	30"	16"		2.17 SF
1	27"	40"		5.75 SF
2	24"	68"		17.78 SF
1	32"	52"		9.33 SF
1	32"	60"		10.89 SF
1	48"	52"		14.87 SF
				60.58 SF

SPATIAL CALCULATION

EXPOSING BUILDING	1215.39	S.F.
FACE AREA	112.91	S.M.
PORTION WALL AREA	1215.39	S.F.
	112.91	S.M.
LIMITING DISTANCE	1.2 m	
MAX. % OPENINGS	7 %	
OPENINGS ALLOWED	85.08 SF	
OPENINGS PROVIDED	60.42 SF	

ADDITIONAL NOTES

GLAZED AREA CALCULATED W/ FRAME SIZE MINUS 2" AROUND ENTIRE PERIMETER

ROOF OVERHANGS TO BE 15" UNLESS NOTED OTHERWISE

REFER TO FRONT ELEVATION FOR TYPICAL NOTES & INFORMATION



LEFT SIDE ELEVATION 'B'

EXTENTS OF SPATIAL CALCULATION REFER TO WINDOW SUMMARY FOR ADDITIONAL INFORMATION

It is the builder's complete responsibility to ensure that all plans submitted for approval fully comply with the Architectural Guidelines and all applicable regulations and requirements including zoning provisions and any provisions in the subdivision agreement. The Control Architect is not responsible in any way for existing or proposed site (existing) plans or existing drawings which may be used in the building of a house. The Control Architect is not responsible for the design of a house can be properly built or located on its lot.

This is to certify that these plans comply with the applicable Architectural Design Guidelines approved by the City of VAUGHAN.

APPROVED BY: DATE: OCT 30, 2022

JOHN G. WILLIAMS LTD., ARCHITECT
ARCHITECTURAL CONTROL REVIEW
AND APPROVAL

This stamp certifies compliance with the applicable Design Guidelines only and does not constitute professional responsibility.

LEFT ELEVATION 'B'

GOLDPARK HOMES - 217020 UNIT 4002 - THE VALLEYVIEW
PINE VALLEY, VAUGHAN, ONTARIO
REV. 2018.10.24

DESIGN ASSOCIATES INC.
www.huntassociates.ca
8886 Woodbine Avenue, Suite 200, Markham, ON L3R 0J7
T 905.737.5133
F 905.737.7326

THE UNDERSIGNED HAS REVIEWED AND TAKES RESPONSIBILITY FOR THE DESIGN AND HAS THE QUALIFICATIONS AND MEETS THE REQUIREMENTS SET OUT IN THE ONTARIO BUILDING CODE AND DESIGNER'S QUALIFICATION INFORMATION

NAME: Chris Fairbairn
REGISTRATION INFORMATION: 20201 BSN
SIGNATURE:

WINDOW SUMMARY
PER O.B.C. TABLE 9.10.15.4

RIGHT SIDE ELEVATION B -
STANDARD PLAN

WT	WIDTH	HEIGHT	WINDOW/ DOOR FRAME SIZE (SF)
1	24"	48"	8.11 SF
1	28"	52"	8.00 SF
1	48"	52"	14.87 SF
1	54"	68"	22.22 SF
			51.00 SF

SPATIAL CALCULATION

EXPOSING BUILDING FACE AREA	1215.39	S.F.
PORTION WALL AREA	112.91	S.F.
LIMITING DISTANCE	12 m	
MAX. % OPENINGS	7 %	
OPENINGS ALLOWED	85.08 SF	
OPENINGS PROVIDED	51.00 SF	

ADDITIONAL NOTES

GLAZED AREA CALCULATED W/ FRAME SIZE
MINUS 2" AROUND ENTIRE PERIMETER

ROOF OVERHANGS TO BE 15",
UNLESS NOTED OTHERWISE

REFER TO FRONT
ELEVATION FOR TYPICAL
NOTES & INFORMATION

All side plans and construction to
comply with City of Vaughan
By-Law 1-83 s.a.
CITY OF VAUGHAN
FOR BUILDING PERMIT ONLY

It is the builder's complete responsibility to
ensure that all plans submitted for approval
comply with the Architectural Guidelines
and all applicable regulations and requirements
including zoning provisions and any provisions
in the subdivision agreement. The Control
Architect is not responsible in any way for
examining or approving site (lotting) plans or
working drawings with respect to any zoning or
building code or permit matter and any
house can be properly built or located on its lot.

This is to certify that these plans comply
with the applicable Architectural Design
Guidelines approved by the City of
VAUGHAN.

JOHN G. WILLIAMS LTD. ARCHITECT
ARCHITECTURAL CONTROL REVIEW
APPROVED BY
DATE OCT 30, 2018
This stamp certifies compliance with the applicable
Design Guidelines only and does not constitute
professional responsibility.

RIGHT SIDE ELEVATION 'B'

UNIT 4002 - THE VALLEYVIEW
REV. 2018.10.24

GOLDPARK HOMES - 217020
PINE VALLEY, VAUGHAN, ONTARIO

DESIGN ASSOCIATES INC.

www.huntdesign.ca
8966 Woodbine Avenue, Suite 200, Markham, ON L3R 0J7 T 905.737.5139
JLL OF 3/16"=1'-0" 217020WS4002.rvt 14 of 18 F 905.737.7326

198/66

THE UNDERSIGNED HAS REVIEWED AND TAKES RESPONSIBILITY FOR THE
DESIGN AND HAS THE QUALIFICATIONS AND MEETS THE REQUIREMENTS
SET OUT IN THE ONTARIO BUILDING CODE
QUALIFICATION INFORMATION
On File/On
NAME
REGISTRATION INFORMATION
HUNT DESIGN ASSOCIATES INC.


VAUGHAN
CITY OF VAUGHAN
BUILDING PERMIT
ALL CITY OF VAUGHAN
BUILDING PERMIT
APPLICABLE
THIS APPLICATION
SHALL BE
VALID FOR
30 DAYS
FROM DATE OF
ISSUANCE

ALL CITY OF VAUGHAN
BUILDING PERMIT
APPLICABLE
THIS APPLICATION
SHALL BE
VALID FOR
30 DAYS
FROM DATE OF
ISSUANCE

198/66



REAR ELEVATION FOR OPT. LOGGIA. ELEA. 'A' (EL. B SIMILAR)

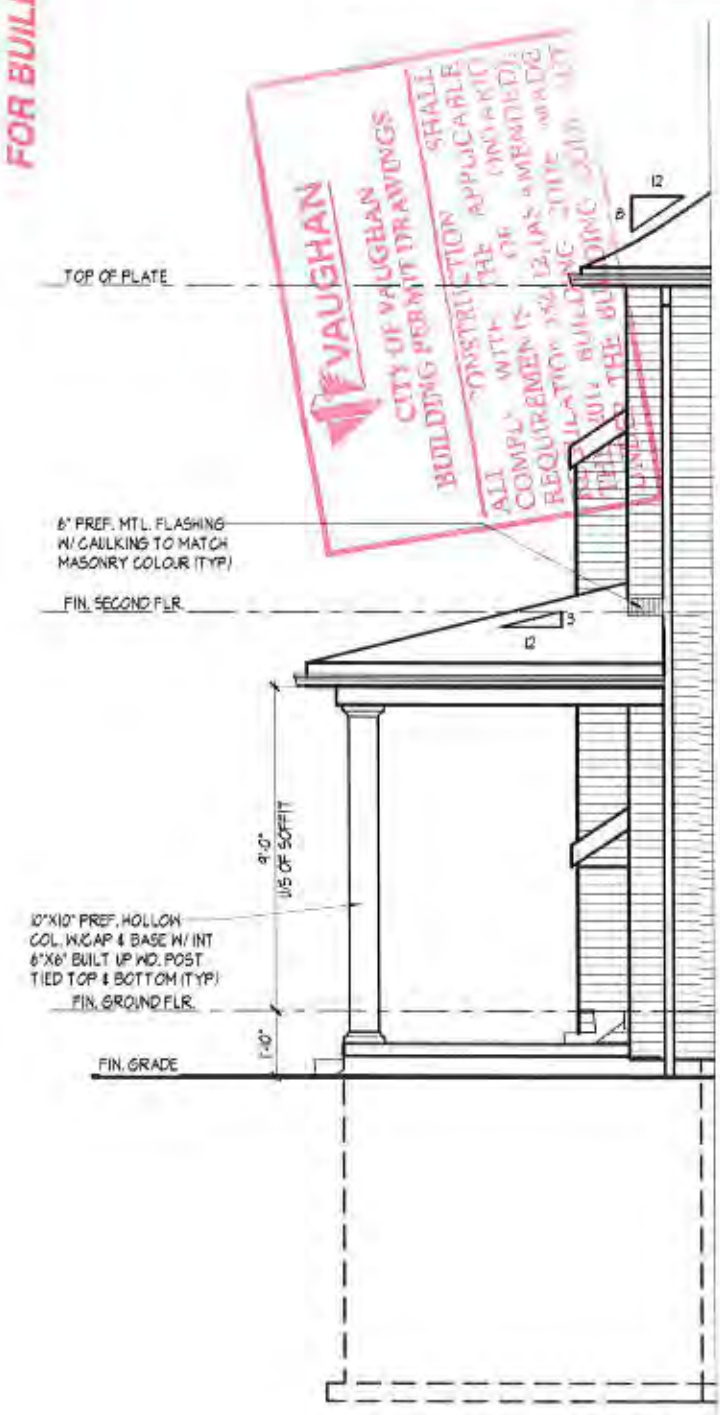

LEFT SIDE ELEVATION FOR OPT. LOGIA

All plans submitted to the City of Vaughan must comply with City of Vaughan By-Law 1-88 a.s.

CITY OF VAUGHAN
FOR BUILDING PERMIT ONLY

It is the builder's complete responsibility to ensure that all plans submitted for approval fully comply with the Architectural Guidelines and the applicable Building Code and any provisions in the subdivision agreement. The Control Architect is not responsible in any way for examining or approving site (lotting) plans or working drawings with respect to any zoning or building code or permit matter or that any house can be properly built or located on its lot.

This is to certify that these plans comply with the applicable Architectural Design Guidelines approved by the City of VAUGHAN.

JOHN G. WILLIAMS LTD., ARCHITECT
ARCHITECTURAL CONTROL REVIEW
AND APPROVAL

APPROVED BY:

DATE: OCT 30, 2015

This stamp certifies compliance with the applicable Design Guidelines only and bears no further professional responsibility.

REAR & PART LEFT ELEVATION FOR OPT. LOGGIA CONDITION

GOLDPARK HOMES - 217020

UNIT 4002 - THE VALLEYVIEW

PINE VALLEY, VAUGHAN, ONTARIO

REV. 2018.10.24

Scale: 3/16" = 1'-0"

Drawn By: JLL

Checked By: JLL

File Number: 217020WVS4002.rvt

Page Number: 15 of 18

8866 Woodbine Avenue, Suite 200, Markham, ON L3R 0J7

T 905.737.5133

F 905.737.7326

HUNT UP

DESIGN ASSOCIATES INC.

www.huntupdesign.ca

202011

15685

THE UNDERSIGNED HAS REVIEWED AND TAKES RESPONSIBILITY FOR THE DESIGN AND HAS THE QUALIFICATIONS AND MEETS THE REQUIREMENTS SET OUT IN THE ONTARIO BUILDING CODE ACT AND REGULATION.


Qualification Information

Chris Farnham

REGISTRATION INFORMATION

HUNT DESIGN ASSOCIATES INC.

All drawings specifications related documents and design are the copyright property of Hunt Design Associates Inc. All drawings specifications related documents and design are the copyright property of Hunt Design Associates Inc. All drawings specifications related documents and design are the copyright property of Hunt Design Associates Inc.

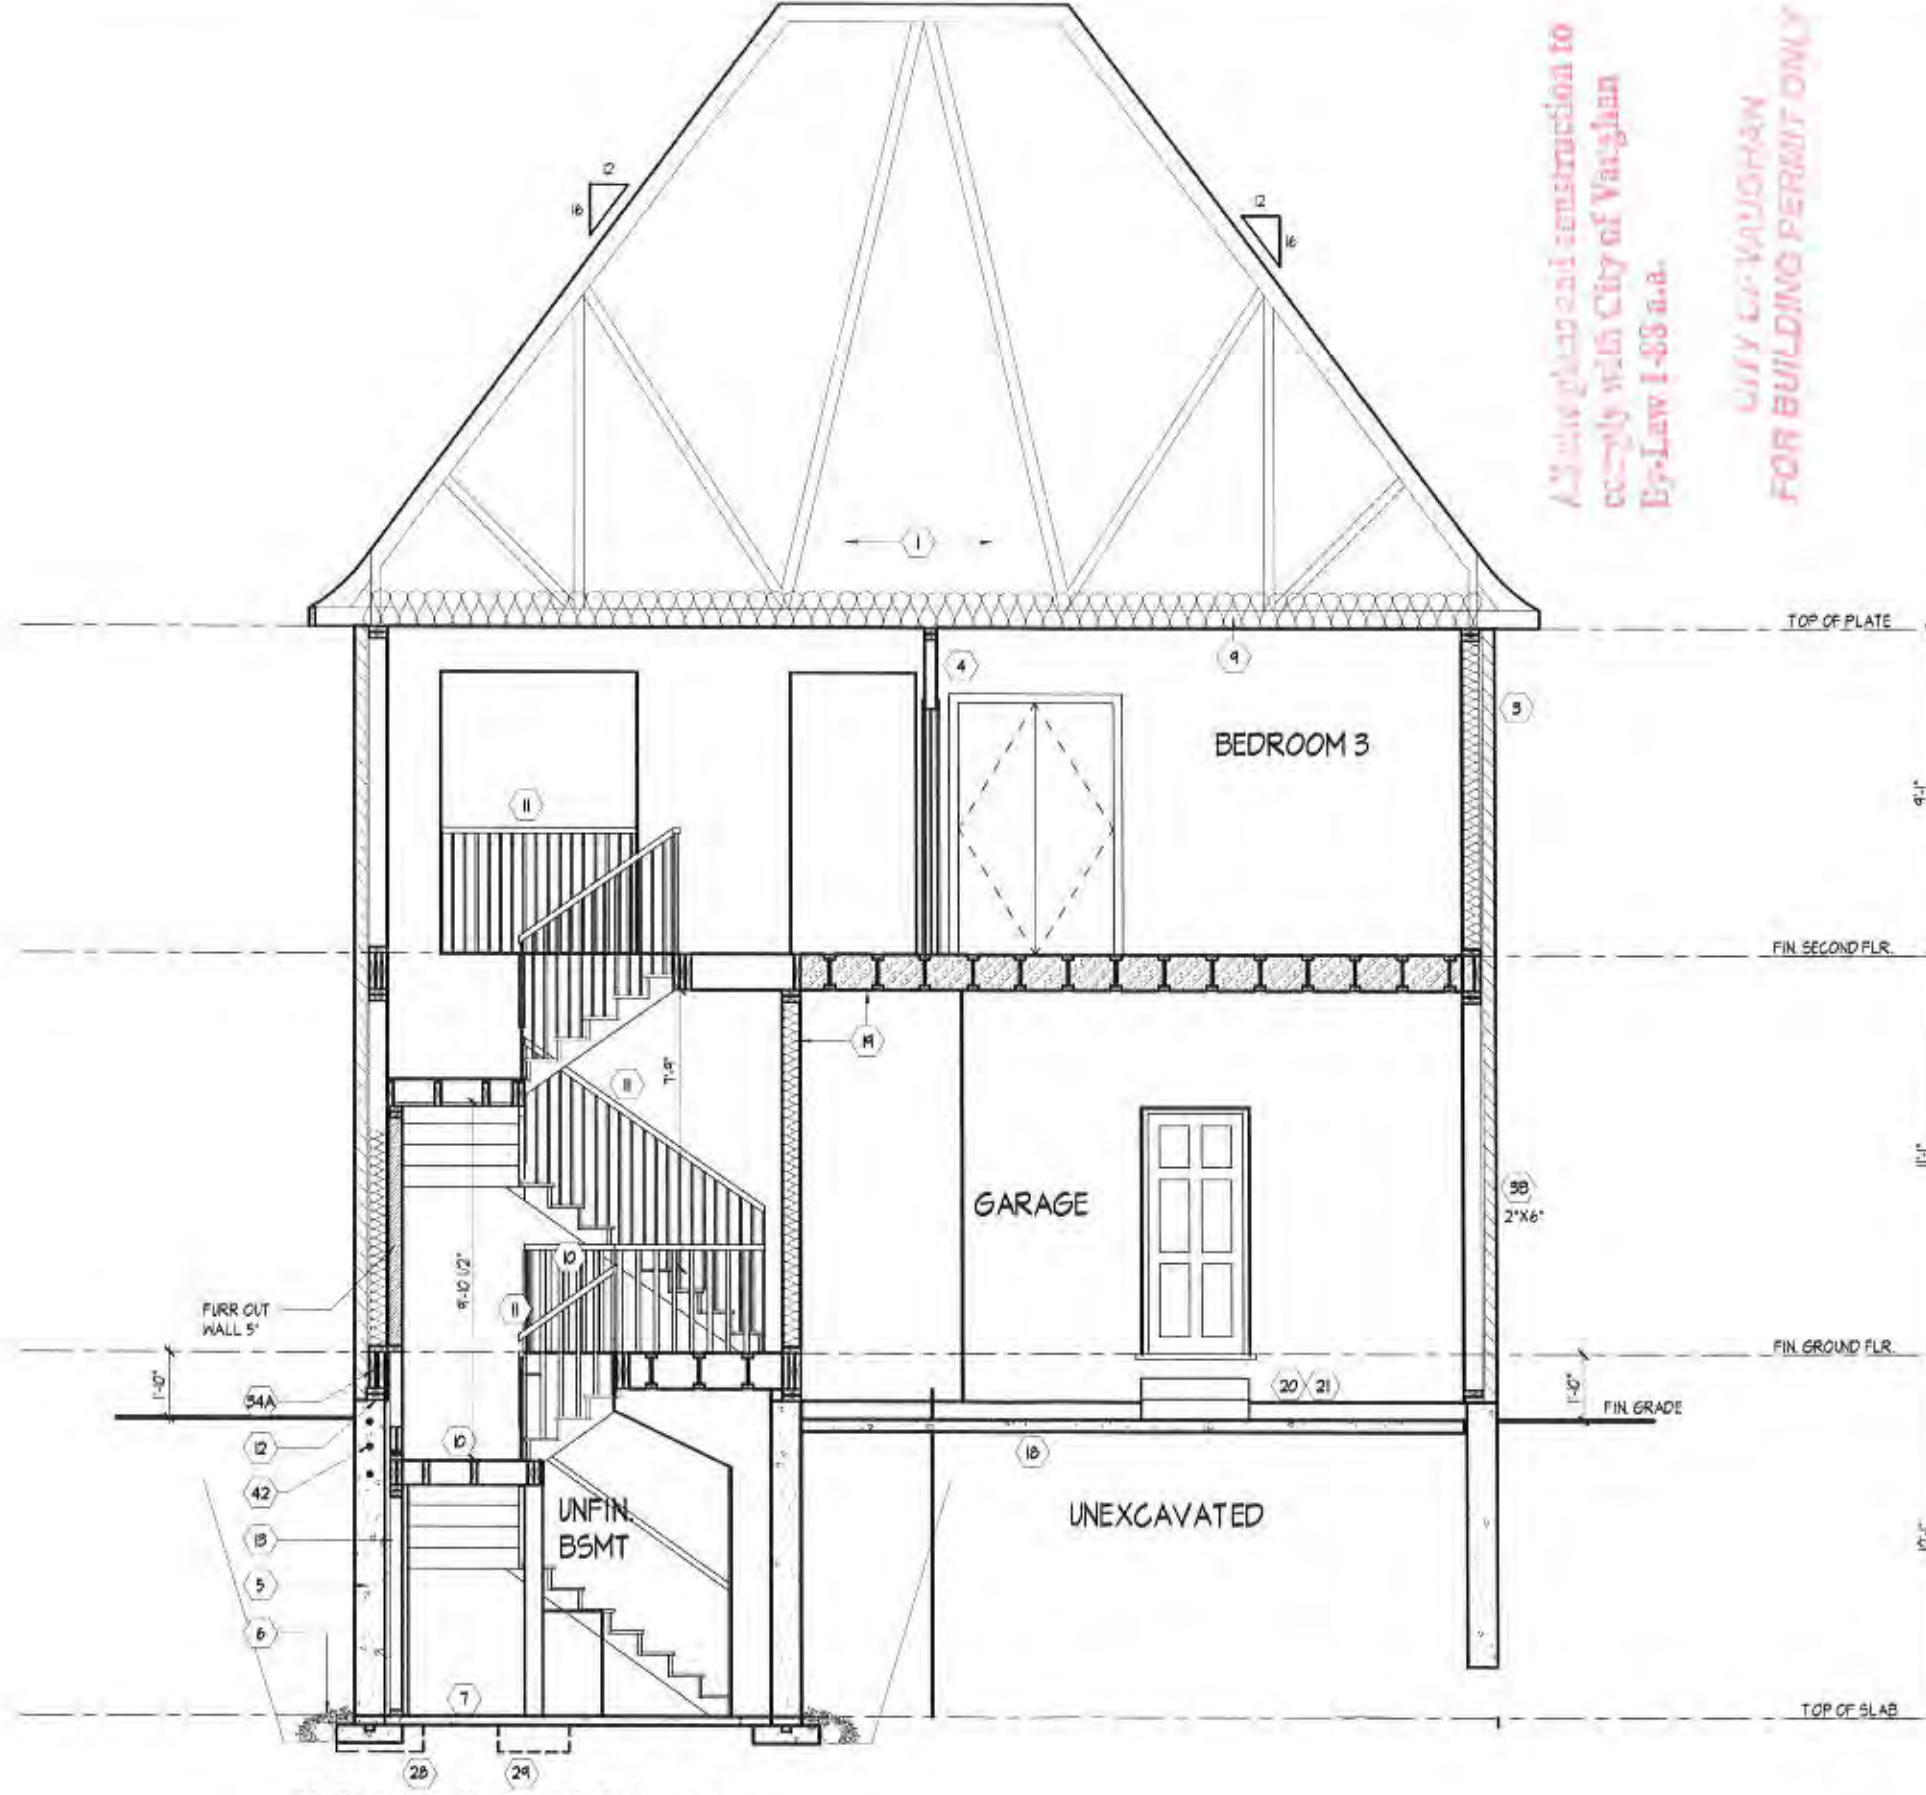

CROSS SECTION A-A

All drawings and construction to comply with City of Vaughan By-Law 1-88 s.s.s.

CITY OF VAUGHAN FOR BUILDING PERMIT ONLY

* SEE P. 1504, CERTIFIED DRAWING ATTACHED.



SECTION 1.0. CONSTRUCTION NOTES

REFER TO S8-12 ENERGY EFFICIENCY DESIGN MATRIX ON THE TITLE PAGE FOR ALL VALUES AS REQUIRED PER 3.1.1., 3.1.2., 3.1.3. OF THE OBC.

- 1 ROOF CONSTRUCTION** (9.23.13, 9.23.15)
No. 210 (10.25 kg/m²) ASPHALT SHINGLES @ 3/8" (9.5) PLYWOOD SHEATHING WITH 4" CURS, APPROVED WOOD TRUSSES @ 24" (610) O.C. MAX. APPROVED EAVES PROTECTION TO EXTEND 2'-1" (609) FROM EDGE OF ROOF AND MIN. 12" (305) BEYOND INNER FACE OF EXTERIOR WALL. 2"x4" (38x89) TRUSS BRACING @ 8'-0" (2438) O.C. AT BOTTOM CHORD. PREP. ALUM. EAVESTROUGH, FASCIA RAIL & VENTED SOFFIT. ATTIC VENTILATION 1:300 OF INSULATED CEILING AREA WITH 50% AT EAVES. EAVESTROUGH TO BE 4" MIN. WITH RVL CONNECTED TO STORM SEWERS OR TO DISCHARGE ONTO CONCRETE SPLASH PADS AS PER MUNICIPAL REQUIREMENTS. TOWNHOUSES TO HAVE 5" (127) MIN. EAVESTROUGH WITH ELEC. TRACED HEATER CABLE ALONG EAVESTROUGH AND DOWN RVL.
- 1A ICE AND WATER SHIELD**
PROVIDE ICE AND WATER SHIELD IN THE AREAS INDICATED. THE ICE AND WATER SHIELD SHALL BE A SELF-ADHERING AND SELF-SEALING MEMBRANE. SIDE LAPS MUST BE A MINIMUM 3 1/2" (90) AND END LAPS A MINIMUM 6" (152). AND TO EXTEND UP CORNER WALLS A MINIMUM 12" (305).
- 1B PROFILED ROOF TRUSSES**
ROOF TRUSSES SHALL BE PROFILED AND/OR STEPPED AT RAISED COFFER/TRAY CEILINGS. ANGLED TRAY CEILINGS WILL BE SHEATHED W/ 3/8" (9.5) PLYWOOD.
- 2 SIDING WALL CONSTRUCTION**
SIDING MATERIAL AS PER ELEVATION ATTACHED TO FRAMING MEMBERS, FURRING MEMBERS OR BLOCKING BETWEEN THE FRAMING MEMBERS ON APPROVED SHEATHING PAPER ON 3/8" (9.5) EXT. GRADE SHEATHING ON 2"x6" (38x140) STUDS @ 16" (406) O.C. INSULATION, APPROVED 6 MIL POLYETHYLENE AIR VAPOUR BARRIER ON 1/2" (12.7) GYPSUM WALLBOARD INT. FIN. (GYPSUM SHEATHING, RIGID INSULATION, AND FIBERBOARD SHALL NOT BE USED FOR THE ATTACHMENT OF SIDING (9.23.18.3.1.1)) (REFER TO 35 NOTE AS REQ.)
- 2A SIDING WALL CONSTRUCTION W/ CONTIN. INSULATION**
SIDING MATERIAL AS PER ELEVATION ATTACHED TO FURRING MEMBERS ON APPROVED AIR/WATER BARRIER AS PER O.B.C. 9.27.3. ON EXTERIOR TYPE RIGID INSULATION (JOINTS UNTAPED) MECHANICALLY FASTENED AS PER MANUFACTURER'S SPECIFICATIONS ON 3/8" (9.5) EXT. GRADE SHEATHING ON 2"x6" (38x140) STUDS @ 16" (406) O.C. INSULATION, APPROVED 6 MIL POLYETHYLENE AIR VAPOUR BARRIER ON 1/2" (12.7) GYPSUM WALLBOARD INT. FIN. (GYPSUM SHEATHING, RIGID INSULATION, AND FIBERBOARD SHALL NOT BE USED FOR THE ATTACHMENT OF SIDING (9.23.18.3.1.1)) (REFER TO 35 NOTE AS REQ.)
- 2B SIDING WALL @ GARAGE CONSTRUCTION**
SIDING MATERIAL AS PER ELEVATION ATTACHED TO FRAMING MEMBERS, FURRING MEMBERS OR BLOCKING BETWEEN THE FRAMING MEMBERS ON APPROVED SHEATHING PAPER ON 3/8" (9.5) EXTERIOR TYPE SHEATHING ON STUDS CONFORMING TO O.B.C. (9.23.10.1.1) & SECTION 1.1.1.2 (12.7) GYPSUM WALLBOARD INTERIOR FINISH. (GYPSUM SHEATHING, RIGID INSULATION AND FIBERBOARD SHALL NOT BE USED FOR THE ATTACHMENT OF SIDING (9.23.18.3.1.1)) (REFER TO 35 NOTE AS REQ.)
- 3 BRICK VENEER WALL CONSTRUCTION**
3 1/2" (90) BRICK VENEER 1" (25) AIR SPACE, 7/8"x7/8"x0.03" (22x18x0.76) GALV. METAL TIES @ 18" (450) O.C. HORIZ. 24" (610) O.C. VERT. BONDING AND FASTENING FOR TIES TO CONFORM WITH 9.20.3. ON APPROVED SHEATHING PAPER, 3/8" (9.5) EXTERIOR TYPE SHEATHING, 2"x6" (38x140) STUDS @ 16" (406) O.C. INSULATION AND 6 MIL POLYETHYLENE VAPOUR BARRIER WITH APPROVED CONT. AIR BARRIER, 1/2" (12.7) GYPSUM WALLBOARD INTERIOR FINISH. PROVIDE WEEP HOLES @ 32" (800) O.C. BOTTOM COURSE AND OVER OPENINGS. PROVIDE BASE FLASHING UP MIN. 6" (152) BEHIND BUILDING PAPER (9.23.13.6.1) (REFER TO 35 NOTE AS REQUIRED).
- 3A BRICK VENEER WALL CONSTRUCTION W/ CONTIN. INSULATION**
3 1/2" (90) BRICK VENEER 1" (25) AIR SPACE, 7/8"x7/8"x0.03" (22x18x0.76) GALV. METAL TIES @ 18" (450) O.C. HORIZ. 24" (610) O.C. VERT. BONDING AND FASTENING FOR TIES TO CONFORM WITH 9.20.3. ON APPROVED AIR/WATER BARRIER AS PER O.B.C. 9.27.3. ON EXTERIOR TYPE RIGID INSULATION (JOINTS UNTAPED) MECHANICALLY FASTENED AS PER MANUFACTURER'S SPECIFICATIONS, ON 3/8" (9.5) EXTERIOR TYPE SHEATHING, 2"x6" (38x140) STUDS @ 16" (406) O.C. INSULATION AND 6 MIL POLYETHYLENE VAPOUR BARRIER WITH APPROVED CONT. AIR BARRIER, 1/2" (12.7) GYPSUM WALLBOARD INTERIOR FINISH. PROVIDE WEEP HOLES @ 32" (800) O.C. BOTTOM COURSE AND OVER OPENINGS. PROVIDE BASE FLASHING UP MIN. 6" (152) OVER RIGID INSULATION (9.23.13.6.1) (REFER TO 35 NOTE AS REQUIRED).
- 3B BRICK VENEER WALL @ GARAGE CONSTRUCTION**
3 1/2" (90) BRICK VENEER, MIN. 1" (25) AIR SPACE, 7/8"x7/8"x0.03" (22x18x0.76) GALV. METAL TIES @ 18" (450) O.C. HORIZ. 24" (610) O.C. VERT. BONDING AND FASTENING FOR TIES TO CONFORM WITH 9.20.3. ON APPROVED SHEATHING PAPER, 3/8" (9.5) EXTERIOR TYPE SHEATHING ON STUDS CONFORMING TO O.B.C. 9.23.10.1.1 & SECTION 1.1.1.2 (12.7) GYPSUM WALLBOARD INTERIOR FINISH. PROVIDE WEEP HOLES @ 32" (800) O.C. AT BOTTOM COURSE AND OVER OPENINGS. PROVIDE BASE FLASHING UP 6" (150) MIN. BEHIND BUILDING PAPER (9.23.13.6.1) (REFER TO 35 NOTE AS REQ.)
- 4 INTERIOR STUD PARTITIONS** (9.23.9.6, 9.23.10)
SEPARING PARTITIONS SHALL BE A MINIMUM 2"x4" (38x89) @ 16" (406) O.C. FOR 2 STOREY AND 12" (305) O.C. FOR 3 STOREY. NON-BEARING PARTITIONS 2"x4" (38x89) @ 24" (610) O.C. PROVIDE 2"x4" (38x89) BOTTOM PLATE AND 2"x4" (38x89) TOP PLATE. 1/2" (12.7) INT. DRYWALL BOTH SIDES OF STUDS. PROVIDE 2"x6" (38x140) STUDS WHERE NOTED. PROVIDE 2"x4" (38x89) @ 24" (610) O.C. LADDER FRAMING WHERE WALLS INTERSECT PERPENDICULAR TO ONE ANOTHER. PROVIDE 2"x4" (38x89) WOOD BLOCKING ON FLAT @ 3'-11" (1194) O.C. MAX. BETWEEN FLOOR JOISTS WHEN NON-LOADBEARING WALLS ARE PARALLEL TO FLOOR JOISTS.
- 4A EXT. LOFT WALL CONSTRUCTION - NO CLADDING**
3/8" (9.5) EXTERIOR TYPE SHEATHING, 2"x6" (38x140) STUDS @ 16" (406) O.C. INSULATION AND 6 MIL POLYETHYLENE VAPOUR BARRIER WITH APPROVED CONT. AIR BARRIER, 1/2" (12.7) GYPSUM WALLBOARD INT. FINISH. (9.23.1)
- 4B EXT. LOFT WALL CONSTRUCTION - NO CLADDING W/ CONTINUOUS INSULATION**
APPROVED AIR/WATER BARRIER AS PER O.B.C. 9.27.3. ON EXTERIOR TYPE RIGID INSULATION (JOINTS UNTAPED) MECHANICALLY FASTENED AS PER MANUFACTURER'S SPECIFICATIONS, ON 3/8" (9.5) EXTERIOR TYPE SHEATHING, 2"x6" (38x140) STUDS @ 16" (406) O.C. INSULATION AND 6 MIL POLYETHYLENE VAPOUR BARRIER WITH APPROVED CONT. AIR BARRIER, 1/2" (12.7) GYPSUM WALLBOARD INT. FINISH. (9.23.1)
- 5 FOUNDATION WALL FOOTINGS**
POURED CONC. FOUNDATION WALL AS PER CHART BELOW ON CONTINUOUS KEYED CONCRETE FOOTING. THE OUTSIDE OF THE FOUNDATION SHALL BE DAMPROOFED FROM THE TOP OF THE FOOTING TO FINISHED GRADE AND BRUSH-COAT FROM THE TOP TO 2" BELOW GRADE. PROVIDE A DRAINAGE LAYER ON THE OUTSIDE OF THE FOUNDATION WALL. SEAL THE DRAINAGE LAYER AT THE TOP. THE TOP OF THE CONC. FOOTING SHALL BE DAMPROOFED. CONCRETE FOOTINGS SUPPORTING JOIST SPANS GREATER THAN 16'-1" (4900) SHALL BE SIZED IN ACCORDANCE WITH 9.15.3.4.1.1.2 OF THE O.B.C. (REFER TO CHART BELOW FOR RESPECTIVE SIZE). BRACE FOUNDATION WALL PRIOR TO BACKFILLING. ALL FOOTINGS SHALL REST ON NATURAL UNDISTURBED SOIL OF 125kPa S.L.S. OR COMPACTED ENGINEERED FILL WITH MIN. BEARING CAPACITY OF 125kPa S.L.S. IF SOIL BEARING DOES NOT MEET MINIMUM CAPACITY, ENGINEERED FOOTINGS ARE REQUIRED. ACTUAL SOIL BEARING CAPACITY TO BE VERIFIED WITH SOIL ENGINEERING REPORT. REFER TO CONSTRUCTION DRAWINGS AND DETAILS FOR FOUNDATION WALL STRENGTH AND THICKNESS AND 9.15.4. FOUNDATION WALLS SHALL NOT EXCEED 9'-10" (3.0m) IN UNSUPPORTED HEIGHT UNLESS OTHERWISE NOTED (9.15.4.2.1.1)
- | UNREINFORCED SOLID CONCRETE FOUNDATION WALLS (9.15.4.2.1) | | | | |
|---|-------------------------------------|------------------|----------------|----------------|
| HEIGHT FROM FIN. SLAB TO GRADE | MAX. HEIGHT FROM FIN. SLAB TO GRADE | | | |
| | UNSUPPORTED AT TOP | SUPPORTED AT TOP | | |
| ★ 8' | 5'-11" (1.80m) | 7'-0" (2.13m) | >2.5m & ≤2.75m | >2.75m & ≤3.0m |
| 10' | 4'-7" (1.40m) | 7'-6" (2.30m) | 8'-6" (2.60m) | 9'-2" (2.80m) |
| 12' | 4'-11" (1.50m) | 7'-6" (2.30m) | 8'-6" (2.60m) | 9'-2" (2.80m) |
| ★ 8' | 3'-11" (1.20m) | 7'-6" (2.30m) | 7'-6" (2.30m) | 7'-2" (2.20m) |
| 10' | 4'-7" (1.40m) | 7'-6" (2.30m) | 8'-6" (2.60m) | 9'-2" (2.80m) |
| 12' | 4'-11" (1.50m) | 7'-6" (2.30m) | 8'-6" (2.60m) | 9'-2" (2.80m) |
- ★ 8" MIN. THICK FOUNDATION WALL IS REQUIRED FOR MASONRY VENEER FINISHED EXTERIOR WALLS WITH CONTINUOUS INSULATION CONDITION. TO PROVIDE MIN. BEARING FOR SILL PLATES, BEAMS AND FLOOR JOIST AS PER 9.23.7.2, 9.23.8.1, & 9.23.9.1 OF THE O.B.C.
- | MINIMUM STRIP FOOTING SIZES (9.15.3.1) | | | |
|--|--|---------------------|-----------------------|
| NUMBER FLOORS SUPPORTED | SUPPORTING INT. LOAD BEARING MASONRY WALLS | SUPPORTING EXTERIOR | SUPPORTING PARTY WALL |
| 1 | 16" WIDE x 8" THICK | 16" WIDE x 8" THICK | 16" WIDE x 8" THICK |
| 2 | 24" WIDE x 8" THICK | 20" WIDE x 8" THICK | 24" WIDE x 8" THICK |
| 3 | 36" WIDE x 14" THICK | 28" WIDE x 9" THICK | 36" WIDE x 14" THICK |

- 5A FOUNDATION REDUCTION IN THICKNESS FOR MASONRY**
WHERE THE TOP OF THE FOUNDATION WALL IS REDUCED IN THICKNESS TO PERMIT THE INSTALLATION OF MASONRY EXTERIOR FACING, THE REDUCED SECTION SHALL BE NOT LESS THAN 3 1/2" (90) THICK. THE BRICK VENEER SHALL BE TIED TO THE FOUNDATION WALL WITH CORROSION RESISTANT METAL TIES @ 7'-8" (203) VERTICAL AND 2'-11" (669) HORIZONTAL. FILL VOID WITH MORTAR BETWEEN WALL AND BRICK VENEER @ 15.4 (7203) & 9.20.9.4(5).
- 5B FOUNDATION REDUCTION IN THICKNESS FOR JOISTS**
WHERE THE TOP OF THE FOUNDATION WALL IS REDUCED IN THICKNESS TO PERMIT THE INSTALLATION OF FLOOR JOISTS, THE REDUCED SECTION SHALL BE NOT MORE THAN 13 3/4" (350) HIGH & NOT LESS THAN 3 1/2" (90) THICK (9.15.4.7(1)).
- 6 WEEPING TILE** (9.14.3.1)
4" (100) Ø WEEPING TILE W/ FILTER CLOTH WRAP & 6" (152) CRUSHED STONE COVER.
- 7 BASEMENT SLAB OR SLAB ON GRADE** (9.16.4.3.1)
3" (80) MIN. 25MPa (3600psi) CONC. SLAB ON 4" (100) COARSE GRANULAR FILL OR 20MPa (2900psi) CONC. WITH DAMPROOFING BELOW SLAB. PROVIDE 1/2" (12.7) IMPERVIOUS BOARD FOR BOND BREAK AT EDGE. (9.15.1) WHERE A BASEMENT SLAB IS WITHIN 24" (610) OF THE EXTERIOR GRADE PROVIDE RIGID INSUL. AROUND THE PERIMETER EXTENDING MIN. 24" (610) BELOW GRADE. FOR SLAB ON GRADE CONDITIONS RIGID INSULATION SHALL BE APPLIED TO THE UNDERSIDE OF THE ENTIRE SLAB. (15B-12) 3.1.1.7.1(5) & (6).
- 8 EXPOSED FLOOR TO EXTERIOR**
PROVIDE SPRAY FOAM INSULATION BETWEEN CANT. JOIST AND INSTALL FIN. SOFFIT OR CLADDING AS PER ELEVATION TO U/S OF EXPOSED CANT. JOIST.
- 9 EXPOSED CEILING TO EXTERIOR w/ ATTIC**
INSULATION, 6 mil POLYETHYLENE VAPOUR BARRIER, 1/2" (12.7) GYPSUM BOARD, INTERIOR FINISH OR APPROVED EQ.
- EXPOSED CEILING TO EXTERIOR w/o ATTIC**
JOISTS/TRUSSES AS PER PLANS W/ 2"x2" (38x38) FURLINS @ 16" (406) O.C. PERPENDICULAR TO JOISTS (FURLINS NOT REQ. W/ SPRAY FOAM OR ROOF TRUSSES). W/ INSULATION BETWEEN JOIST, 6 mil POLYETHYLENE VAPOUR BARRIER, 1/2" (12.7) GYPSUM BOARD INT. FINISH OR APPROVED EQ. (CANALUC-5705.2, 9.19.1)
- 10 ALL STAIRS/EXTERIOR STAIRS** (9.8.1.2, 9.8.2, 9.8.4.1)
- | | MAX. RISE | MIN. RISE | MAX. RUN | MIN. RUN | MAX. TREAD | MIN. TREAD |
|---------|------------------|---------------|---------------|--------------|-------------|--------------|
| PRIVATE | 7'-8" (200) | 5" (125) | 14" (356) | 8'-14" (210) | 14" (356) | 9'-14" (235) |
| PUBLIC | 7" (180) | 5" (125) | N/D LIMIT | 11" (280) | N/D LIMIT | 11" (280) |
| | MIN. STAIR WIDTH | | CURVED STAIRS | | | ALL STAIRS |
| PRIVATE | 2'-10" (560) | MIN. RUN | 5'-8" (150) | | MAX. NOSING | 1" (25) |
| PUBLIC | 2'-11" (560) | MIN. AVG. RUN | 7'-8" (200) | | | |
- ** HEIGHT OVER STAIRS (HEADROOM) IS MEASURED VERTICALLY ACROSS WIDTH OF STAIRS FROM A STRAIGHT LINE TO THE TREAD & LANDING NOSING TO LOWEST POINT ABOVE AND NOT LESS THAN 6'-5" (1950) FOR SINGLE DWELLING UNIT & 6'-8 3/4" (2050) FOR EVERYTHING ELSE. (9.8.2.2.1)
- REQUIRED LANDING IN GARAGE - O.B.C. 9.8.2.2.1.2**
FOR AN EXTERIOR STAIR SERVING A GARAGE, W/ MORE THAN 3 RISERS, GUARDS, HANDRAILS & STEPS AS PER CONSTRUCTION HEX NOTE 10.3.1.1
- 11 GUARDS/RAILINGS** (9.8.7, 9.8.8.1)
GUARDS TO BE DESIGNED NOT TO FACILITATE CLIMBING AND PROVIDING MAX. OPENING CONFORMING TO O.B.C. 9.8.8.5. & 9.8.8.6. AND BE ABLE TO RESIST LOADS AS PER TABLE 9.8.8.2.
- GUARD HEIGHTS - O.B.C. 9.8.8.2**
INTERIOR GUARDS: 2'-11" (660) MIN.
EXTERIOR GUARDS: 2'-11" (660) MIN. (LESS THAN 5'-11" (1800) TO GRADE) 3'-6" (1070) MIN. (MORE THAN 5'-11" (1800) TO GRADE)
GUARDS FOR EXT. STAIRS: 3'-0" (920) MIN.
GUARDS FOR LANDINGS @ EXT. STAIRS: 3'-6" (1070) MIN.
GUARDS FOR FLOORS & RAMPS IN GARAGES: (SERVICE STAIRS)
FLOOR OR RAMP W/O EXTERIOR WALLS THAT IS 23 5/8" (603) OR MORE ABOVE ADJACENT SURFACE REQUIRES CONT. CURB MIN. 6" (152) HIGH, AND GUARD MIN. 3'-6" (1070) HIGH.
REQUIRED GUARDS
BETWEEN WALKING SURFACE & ADJACENT SURFACE WITH A DIFFERENCE IN ELEVATION MORE THAN 23 5/8" (603) OR ADJACENT SURFACE WITHIN 3'-11" (1200) & WALKING SURFACE W/ A SLOPE MORE THAN 1 IN 12 SHALL BE PROTECTED WITH GUARDS PER CONSTRUCTION HEX NOTE 11.
HANDRAIL HEIGHTS - O.B.C. 9.8.7 - REQUIRED AS PER 9.8.7.1.3
MIN. HEIGHT AT STAIRS OR RAMP: 2'-10" (609)
MAX. HEIGHT AT STAIRS OR RAMP: 3'-2" (965)
MAX. HEIGHT AT LANDING: 3'-6" (1070)
STAIRS OR RAMP MIN. 7'-3" (2200) WIDE; 2'-9" (885) MIN. HEIGHT
- 12 SILL PLATES**
2"x4" (38x89) SILL PLATE WITH 1/2" (12.7) Ø ANCHOR BOLTS 8" (200) LONG EMBEDDED MIN. 4" (100) INTO CONC. @ 4'-0" (1200) O.C. CAULKING OR GASKET BETWEEN PLATE AND TOP OF FOUNDATION WALL. USE NON-SHRINK GROUT TO LEVEL SILL PLATE WHEN REQUIRED (9.23.7.1)
- 13 BASEMENT INSULATION** (15B-12) 3.1.1.7.1
PROVIDE CONTINUOUS BLANKET INSULATION W/ BUILT IN 6 mil POLYETHYLENE VAPOUR BARRIER. INSULATION TO EXTEND NO MORE THAN 8" (200) ABOVE FINISHED BASEMENT FLOOR. DAMPROOFED WITH BUILDING PAPER BETWEEN THE FOUNDATION WALL AND INSULATION UP TO GRADE LEVEL.
- 14 BEARING STUD PARTITION IN BASEMENT** (9.15.3.6, 9.23.10.1.1)
2"x4" (38x89) STUDS @ 16" (406) O.C. 2"x4" (38x89) SILL PLATE ON DAMPROOFING MATERIAL OR 2 mil POLYETHYLENE FILM, 1/2" (12.7) Ø ANCHOR BOLTS @ (200) LONG EMBEDDED 4" (100) MIN. INTO CONC. @ 7'-10" (2390) O.C. & 1" (25) HIGH CONC. CURB ON CONC. FOOTING FOR SIZE REFER TO HEX NOTE 5. ADD HORIZ. BLOCKING AT MID-HEIGHT IF WALL IS UNFINISHED.
- 15 ADJUSTABLE STEEL BASEMENT COLUMN** (9.15.3.4.1)
9'-10" (3000) MAX. SPAN BETWEEN COLUMNS 3 1/2" (90) SINGLE TUBE. ADJUSTABLE STEEL COLUMN CONFORMING TO CAN/CSA-82M, AND WITH 6x6x3/8" (152x152x9.5) STEEL PLATE TOP & BOTTOM. FIELD WELD BASEMENT COLUMN CONNECTION. POURED CONCRETE FOOTING ON NATURAL UNDISTURBED SOIL OF 125kPa S.L.S. OR COMPACTED ENGINEERED FILL WITH MIN. BEARING CAPACITY OF 125kPa S.L.S. AS PER SOILS REPORT.
SUPPORTING 2 STOREY FLR. LOAD PROVIDE 34"x34"x16" (878x878x406) CONC. FOOTING
SUPPORTING 3 STOREY FLR. LOAD PROVIDE 48"x48"x24" (1230x1230x610) CONC. FOOTING
- 15A NON-ADJUSTABLE STEEL BASEMENT COLUMN**
3 1/2" (90) Ø x 0.188" (4.75) NON-ADJUSTABLE STEEL COLUMN WITH 6"x6"x3/8" (152x152x9.5) STEEL PLATE TOP & BOTTOM. FIELD WELD BASEMENT COLUMN CONNECTION. POURED CONCRETE FOOTING ON NATURAL UNDISTURBED SOIL OF 125kPa S.L.S. OR COMPACTED ENGINEERED FILL WITH MIN. BEARING CAPACITY OF 125kPa S.L.S. AS PER SOILS REPORT.
SUPPORTING 2 STOREY FLR. LOAD PROVIDE 42"x42"x18" (1070x1070x460) CONC. FOOTING
SUPPORTING 3 STOREY FLR. LOAD PROVIDE 48"x48"x24" (1230x1230x610) CONC. FOOTING
- 15B NON-ADJUSTABLE STL. COLUMN AT FOUNDATION WALL**
3 1/2" (90) Ø x 0.188" (4.75) NON-ADJUSTABLE STEEL COLUMN WITH 6"x6"x3/8" (152x152x9.5) STEEL TOP PLATE & 6"x4"x3/8" (152x100x9.5) BOTTOM PLATE. BASE PLATE 4'-12"x10"x1/2" (120x80x12.7) WITH 2" 1/2" Ø x 12" LONG x 3" HOOK ANCHORS @ 12" (305) ON C. FIELD WELD COLUMN TO BASE PLATE & STEEL FR.
- 16 STEEL BEAM BEARING AT FOUNDATION WALL** (9.15.3.7)
BEAM POCKET OR 6"x8" (200x200) POURED CONC. MIS WALLS, MIN. BEARING 3 1/2" (90).
- 17 WOOD STRAPPING AT STEEL BEAMS** (9.23.4.3.3.1) 9.23.9.3.1
1x3" (19x64) CONTIN. WOOD STRAPPING BOT. SIDES OF STEEL BEAM.
- 18 GARAGE SLAB** (9.15.9.35)
4" (100) 32MPa (4600psi) CONC. SLAB WITH 5-8% AIR ENTRAINMENT OR 4" (100) COARSE GRANULAR FILL WITH COMPACTED SUB-BASE OR COMPACTED NATIVE FILL. SLOPE TO FRONT @ 1% MIN.
- 19 GARAGE TO HOUSE WALLS/CEILING** (9.10.9.16)
1/2" (12.7) GYPSUM BOARD ON WALL AND CEILING BETWEEN HOUSE AND GARAGE. PLUS REQUIRED INSULATION IN WALLS AND SPRAY FOAM FOR CEILINGS. TAPE AND SEAL ALL JOINTS GAS TIGHT.
- 19A GARAGE TO HOUSE WALLS/CEILING W/ CONTIN. INSULATION**
1/2" (12.7) GYPSUM BOARD ON CEILING AND ON WALL. IS INSTALLED OVER EXTERIOR TYPE RIGID INSULATION (JOINTS UNTAPED) MECHANICALLY FASTENED AS PER MANUFACTURER'S SPECIFICATIONS ON 3/8" EXTERIOR GRADE SHEATHING ON STUDS BETWEEN HOUSE AND GARAGE. PLUS REQUIRED INSULATION IN WALLS & SPRAY FOAM FOR CEILINGS. TAPE AND SEAL ALL JOINTS GAS TIGHT. (9.10.9.16.1)
- 20 GARAGE DOOR TO HOUSE** (9.10.9.16, 9.10.13.10, 9.10.13.15)
GAS-PROOF DOOR AND FRAME. DOOR EQUIPPED WITH SELF-CLOSING DEVICE AND WEATHER STRIPPING.

- 21 EXTERIOR AND GARAGE STEPS**
PRECAST CONC. STEP OR WOOD STEP WHERE NOT EXPOSED TO WEATHER, MAX. RISE 7'-8" (200) MIN. TREAD 9'-14" (235). FOR THE REQUIRED NUMBER OF STEPS REFER TO SITING AND GRADING DRAWINGS. EXTERIOR CONCRETE STAIRS WITH MORE THAN 2 RISERS AND 2 TREADS SHALL BE PROVIDED WITH FOUNDATION AS REQUIRED BY ARTICLE 9.8.3.2. OR SHALL BE CANTILEVERED AS PER SUBSECTION 9.8.10.
- 22 DRYER EXHAUST**
CAPPED DRYER EXHAUST VENTED TO EXT. CONFORMING TO PART 6, OBC 9.32.
- 23 ATTIC ACCESS** (9.19.2.1)
ATTIC ACCESS HATCH WITH MIN. AREA OF 0.32m² AND NO DIM. LESS THAN 31 1/2" (845) WITH WEATHER STRIPPING. HATCHWAYS TO THE ATTIC OR ROOF SPACE WILL BE FITTED WITH DOORS OR COVERS AND WILL BE INSULATED WITH MIN. R20 (RS-3.52) (15B-12) 3.1.1.5(1.1).
- 24 FIREPLACE CHIMNEYS** (9.21.1)
TOP OF FIREPLACE CHIMNEY SHALL BE 2'-1" (669) ABOVE THE HIGHEST POINT AT WHICH IT COMES IN CONTACT WITH THE ROOF AND 2'-0" (610) ABOVE THE ROOF SURFACE WITHIN A HORIZ. DISTANCE OF 10'-0" (3048) FROM THE CHIMNEY.
- 25 LINEN CLOSET**
PROVIDE 4 SHELVES MIN. 14" (356) DEEP.
- 26 MECHANICAL VENTILATION** (9.32.1.3.1)
MECHANICAL EXHAUST FAN, VENTED TO EXTERIOR, TO PROVIDE AT LEAST ONE AIR CHANGE PER HOUR. SEE GENERAL NOTE 2.3.
- 27 PARTY WALL BEARING** (9.23.8)
(12"x12"x5/8" (305x305x15.9) STEEL PLATE FOR STEEL BEAMS AND 12"x12"x1/2" (305x305x12.7) STEEL PLATE FOR WOOD BEAMS BEARING (MIN. 3'-1" (890) ON CONC. BLOCK PARTY WALL ANCHORED WITH 2 3/4" (2-19) x 8" (200) LONG GALV. ANCHORS WITHIN SOLID BLOCK COURSE. LEVEL W/ NON-SHRINK GROUT. REFER TO NOTE SOLID BEARING (SECTION 3.0) FOR WD. STUD PARTY WALL.
- 28 WOOD FRAMING IN CONTACT TO CONCRETE**
WOOD BEARING WALLS, THE UNDERSIDE OF BUILT-UP WOOD POSTS AND SILLS SHALL BE WRAPPED WITH 2 mil POLY. STRIP FOOTINGS SUPPORTING THE FOUNDATION WALL SHALL BE WIDENED 6" (152) BELOW THE BEARING WALL AND/OR WOOD POST. (9.17.4.3)
- 29 BUILT-UP WOOD POST AND FOOTING** (9.17.4.1, 9.15.3.7.1)
3-2x6" (3-38x140) BUILT-UP WOOD POST UNLESS OTHERWISE NOTED) ON METAL BASE SHOE ANCHORED TO CONC. WITH 1/2" (12.7) Ø SILL, 2x4x24x12" (610x10x80x3) CONC. FOOTING OR AS PROVIDED ON PLAN. REFER TO NOTE 28.
- 30 STEP FOOTINGS** (9.15.3.9)
MIN. HORIZ. STEP = 23 5/8" (603) MAX. VERT. STEP = 23 5/8" (603)
- 31 CONC. PORCH SLAB** (9.16.4.1)
MIN. 4" (100) CONCRETE SLAB ON GRADE ON 4" (100) COARSE GRANULAR FILL REINFORCED WITH 6x6x2 9 MESH PLACED NEAR MID-DEPTH OF SLAB. CONC. STRENGTH 32MPa (4640psi) WITH 5-8% AIR ENTRAINMENT ON COMPACTED SUB-GRADE.
- 32 FURNACE VENTING** (9.32.1)
DIRECT VENT FURNACE TERMINAL MAX. 3'-0" (915) FROM A GAS REGULATOR MIN. 12" (305) ABOVE FIN. GRADE. FROM ALL OPENINGS, EXHAUST AND INTAKE VENTS, HRV INTAKE TO BE A MIN. 6'-0" (1830) FROM ALL EXHAUST TERMINALS. REFER TO GAS UTILIZATION CODE.
- 33 FIREPLACE VENTING** (9.32.3.1)
DIRECT VENT GAS FIREPLACE VENT TO BE A MIN. 12" (305) FROM ANY FLOORING AND ABOVE FIN. GRADE. REFER TO GAS UTILIZATION CODE.
- 34 FLOOR FRAMING** (9.23.3.5, 9.23.9.4, 9.23.14.1)
T&G SUBFLOOR ON WOOD FLOOR JOISTS. FOR CERAMIC TILE APPLICATION SEE O.B.C. 9.30.6. ALL JOISTS WHERE REQUIRED TO BE BRIDGED WITH 2x2" (38x89) CROSS BRACING OR SOLID BLOCKING @ 6'-1" (1816) O.C. MAX. ALL JOISTS TO BE STRAPPED WITH 1x3" (19x64) @ 6'-11" (2109) O.C. UNLESS A PANEL TYPE CEILING FINISH IS APPLIED.
- 34A HEADER CONSTRUCTION**
PROVIDE CONTINUOUS APPROVED AIR VAPOUR BARRIER (HEADER WRAP) UNDER THE SILL PLATE, AROUND THE RIM BOARD AND UNDER THE BOTTOM PLATE. THE HEADER WRAP SHALL EXTEND 6" (152) BELOW THE TOP OF FOUNDATION WALL AND WILL BE SEALED TO THE CONCRETE FOUNDATION WALL. EXTEND HEADER WRAP 6" (152) UP THE INTERIOR SIDE OF THE STUD WALL AND OVERLAP WITH THE VAPOUR BARRIER AND SEAL THE JOINT. ALL EDGES/JOINTS MUST BE MECHANICALLY CLAMPED.
- 35 EXPOSED BUILDING FACE w/ LIMITING DISTANCE <= 3'-11" (1.20m)**
WALL ASSEMBLY CONTAINS INSULATION CONFORMING TO CAN/ULC-S702 & HAVING A MASS OF NOT LESS THAN 1.22 kg/m² OF WALL SURFACE AND 1/2" (12.7) TYPE X GYPSUM WALLBOARD INTERIOR FINISH. EXTERIOR CLADDING MUST BE NON-COMBUSTIBLE. WALL ASSEMBLY REQUIRES TO HAVE A FIRE RESISTANCE RATING OF NOT LESS THAN 45 MINUTES & CONFORMING TO O.B.C. (9.10.14 OR 9.10.15.1) REFER TO DETAILS FOR TYPE & SPECS.
** AN OPENING IN AN EXPOSING BUILDING FACE NOT MORE THAN 20 (610) (1300cm²) SHALL NOT BE CONSIDERED AN UNPROTECTED OPENING AS PER 9.10.14.8
- 36 COLD CELLAR PORCH SLAB** (9.39.1)
FOR MAX. 8'-2" (2500) PORCH DEPTH, 5" (127) 32 MPa (4640psi) CONC. SLAB W/ 5-8% AIR ENTRAINMENT. REIN. WITH 10M BARS @ 7'-8" (200) O.C. EACH DIRECTION, W/ 1 1/4" (32) CLEAR COVER FROM BOTTOM OF SLAB TO FIRST LAYER OF BARS & SECOND LAYER OF BARS LAD DIRECTLY ON TOP OF LOWER LAYER IN OPPOSITE DIR. 24x24" (610x610) 10M DOWELS @ 23 5/8" (603) O.C. ANCHORED IN PERIMETER FND. WALLS, SLOPE SLAB 1/4% FROM DOOR.
- 37 RANGE HOODS AND RANGE-TOP FANS**
COOKING APPLIANCE EXHAUST FANS VENTED TO EXTERIOR MUST CONFORM TO OBC 9.23.3.5 & 9.32.3.10.
- 38 CONVENTIONAL ROOF FRAMING** (9.23.13, 9.23.15.1)
2"x6" (38x140) RAFTERS @ 16" (406) O.C. 2"x6" (38x140) RIDGE BOARD. 2"x4" (38x89) COLLAR TIES AT MID-SPAN. CEILING JOISTS TO BE 2"x4" (38x89) @ 16" (406) O.C. FOR MAX. 9'-2" (2819) SPAN & 2"x6" (38x140) @ 16" (406) O.C. FOR MAX. SPAN 14'-7" (4450). RAFTERS FOR BUILT UP ROOF OVER PRE-ENGINEERED ROOF TRUSSES AND OR CONVENTIONAL FRAMING TO BE 2"x4" (38x89) @ 24" (610) O.C. UNLESS OTHERWISE SPECIFIED.
- 39 TWO STOREY VOLUME SPACES** (9.23.10.1, 9.23.11, 9.23.16.1)
- | WALL ASSEMBLY | WIND LOADS | | | | |
|----------------|--------------------|----------------|------------------|----------------|---------------|
| | <= 0.5 kPa (1050) | | > 0.5 kPa (1050) | | |
| | SPACING | MAX HEIGHT | SPACING | MAX HEIGHT | |
| EXTERIOR STUDS | | | | | |
| BRICK | 2-2"x6" (2-38x140) | 12' (365) O.C. | 18'-4" (5598) | 8' (203) O.C. | 18'-4" (5598) |
| SIDING | GPR #2 | 16" (406) O.C. | 18'-4" (5598) | 12' (305) O.C. | 18'-4" (5598) |
| BRICK | 2-2"x6" (2-38x140) | 12' (365) O.C. | 21'-0" (6400) | 12' (305) O.C. | 21'-0" (6400) |
| SIDING | GPR #2 | 16" (406) O.C. | 21'-0" (6400) | 16" (406) O.C. | 21'-0" (6400) |
- STUDS ARE TO BE CONTINUOUS. CW 3/8" (9.5) THICK EXTERIOR PLYWOOD SHEATHING. PROVIDE SOLID WOOD BLOCKING BETWEEN WOOD STUDS @ 4'-0" (1220) O.C. VERTICALLY.
FOR HORIZ. DISTANCES LESS THAN 9'-6" (2895) PROVIDE 2"x6" (38x140) STUDS @ 16" (406) O.C. WITH CONTIN. 2"x6" (38x140) TOP PLATE @ 12" (305) O.C. BOTTOM PLATE & MIN. OF 3-2x6" (38x140) CONT. HEADER AT GROUND FLOOR CEILING LEVEL TOP NAILED & GLUED AT TOP. BOTTOM PLATES & HEADERS

CONSTRUCTION NOTES 1

THE UNDERSIGNED HAS REVIEWED AND TAKES RESPONSIBILITY FOR THIS DESIGN AND HAS THE QUALIFICATIONS AND EXPERIENCE TO MEET THE REQUIREMENTS SET OUT IN THE ONTARIO BUILDING CODE, 1995.

QUALIFICATION INFORMATION
Chris Fairbairn
NAME
REGISTRATION INFORMATION
HUNT DESIGN ASSOCIATES INC.
19995

2020
BCA

HUNT
DESIGN ASSOCIATES INC.
www.huntdesign.ca

GOLDPARK HOMES - 217020
PINE VALLEY, VAUGHAN, ONTARIO
Open By
JLL
Created By
OF
Scale
3/16"=1'-0"
File Number
217020WS4002.rvt
Page Number
17 of 18
8966 Woodbine Avenue, Suite 200, Markham, ON L3R 0J7
T 905.737.5133
F 905.737.7325

UNIT 4002 - THE VALLEYVIEW
REV.2018.10.24
A. KONG
100184942
PROVINCE OF ONTARIO

cont. SECTION 1.0. CONSTRUCTION NOTES

- 40 1 HR. PARTY WALL (CONC. BLOCK)** ((SB-3) WALL TYPE B&e & B10) 1/2" (12.7) GYPSUM SHEATHING ON EACH SIDE ON 2"x2" (38x38) VERTICAL WOOD STRAPPING @ 24" (610) O.C. ON 8" (203) CONC. BLOCK FILL STRAPPING CAVITY EACH SIDE WITH AT LEAST 90% OF ABSORPTIVE MATERIAL PROCESSED FROM ROCK, SLAG OR GLASS TAPE, FILL & SAND ALL GYPSUM JOINTS. EXPOSED BLOCK MUST BE SEALED W/ 2 COATS OF PAINT OR FURRED WITH 2"x2" (38x38) WD. STRAPPING & 1/2" (12.7) GYPSUM SHEATHING.
- 40 1 HR. PARTY WALL (DOUBLE STUD)** ((SB-3) WALL TYPE W13e) 5/8" (15.9) TYPE X GYPSUM SHEATHING ON EXTERIOR SIDE OF 2 ROWS OF 2"x4" (38x89) STUDS @ 16" (406) O.C., MIN. 1" (25) APART ON SEPARATE 2"x4" (38x89) SILL PLATES. FILL ONE SIDE OF STUD CAVITY WITH AT LEAST 90% OF ABSORPTIVE MATERIAL PROCESSED FROM ROCK, SLAG OR GLASS TAPE FILL AND SAND ALL GYPSUM JOINTS
- 40A 2 HR. FIREWALL** ((SB-3) WALL TYPE B&e & B10) 1/2" (12.7) GYPSUM SHEATHING ON EACH SIDE ON 2"x2" (38x38) VERTICAL WOOD STRAPPING @ 24" (610) O.C. ON 8" (203) CONC. BLOCK 75% SOLID FILL STRAPPING CAVITY EACH SIDE WITH AT LEAST 90% OF ABSORPTIVE MATERIAL PROCESSED FROM ROCK, SLAG OR GLASS TAPE, FILL & SAND ALL GYPSUM JOINTS. AT UNFINISHED AREAS, EXTERIOR FACE OF CONC. BLOCK TO BE SEALED WITH 2 COATS OF PAINT. GYPSUM SHEATHING TO BE ATTACHED TO CONC. BLOCK. (REFER TO DETAILS)
- 41 STUCCO WALL CONSTRUCTION** STUCCO FINISH CONFORMING TO O.B.C. SECTION 9.26 AND APPLIED PER MANUFACTURERS SPECIFICATIONS OVER 1 1/2" (38) E.I.F.S. (MINIMUM) ON APPROVED DRAINAGE MAT ON 1/2" (12.7) DENSGLASS GOLD GYPSUM BOARD ON 2"x6" (38x140) SPRUCE STUDS @ 16" (406) O.C. INSULATION, APPROVED 6 MIL. POLYETHYLENE VAPOUR BARRIER, 1 1/2" (12.7) GYPSUM WALLBOARD INT. FINISH. (REFER TO 35 NOTE AS REQUIRED)
- 41A STUCCO WALL CONSTRUCTION W/ CONTIN. INSULATION** STUCCO FINISH CONFORMING TO O.B.C. SECTION 9.26 AND APPLIED PER MANUFACTURERS SPECIFICATIONS OVER 1 1/2" (38) E.I.F.S. (MINIMUM) ON APPROVED DRAINAGE MAT ON APPROVED AIR/WATER BARRIER AS PER O.B.C. 9.27.3 ON EXTERIOR TYPE RIGID INSULATION (JOINTS UNTAPED) MECHANICALLY FASTENED AS PER MANUFACTURERS SPECIFICATIONS. ON 2"x6" (38x140) SPRUCE STUDS @ 16" (406) O.C. INSULATION, APPROVED 6 MIL. POLYETHYLENE VAPOUR BARRIER, 1 1/2" (12.7) GYPSUM WALLBOARD INT. FINISH. (REFER TO 35 NOTE AS REQUIRED)
- 41B STUCCO WALL @ GARAGE CONST.** STUCCO FINISH CONFORMING TO O.B.C. SECTION 9.26 AND APPLIED PER MANUFACTURERS SPECIFICATIONS OVER 1 1/2" (38) E.I.F.S. (MINIMUM) ON APPROVED DRAINAGE MAT ON 1/2" (12.7) DENSGLASS GOLD GYPSUM BRD. ON STUDS CONFORMING TO O.B.C. (9.23.10.1) & SECTION 1.1. 1/2" (12.7) GYPSUM WALLBOARD INT. FINISH. (REFER TO 35 NOTE AS REQ.) *** FOR DWELLINGS USING CONTIN. INSULATION CONSTRUCTION, PROVIDE APPROVED DRAINAGE MAT ON 7/16" (11) EXTERIOR TYPE SHEATHING OVER FURRING (AS REQ.) AND STUDS (IN LIEU OF 1/2" (38) E.I.F.S. (MINIMUM) ON APPROVED DRAINAGE MAT ON 1/2" (12.7) DENSGLASS GOLD GYPSUM BRD.
- 42 UNSUPPORTED FOUNDATION WALLS** (9.15.4.2) REINFORCING AT STAIRS AND SUNKEN FLOOR AREAS 2-30M BARS IN TOP PORTION OF WALL (UP TO 8'-0" OPENING) 3-30M BARS IN TOP PORTION OF WALL 18'-0" TO 10'-0" OPENING 4-30M BARS IN TOP PORTION OF WALL 10'-0" TO 15'-0" OPENING - BARS STACKED VERTICALLY AT INTERIOR FACE OF WALL REINFORCING AT BASEMENT WINDOWS 2-15M HORIZ. REINFORCING ON THE INSIDE AND OUTSIDE FACE OF THE FOUNDATION WALL BELOW THE WIN. SILL. EXTEND BARS 24" (610) BEYOND THE OPENING. 2-15M VERTICAL REINFORCING ON THE INSIDE AND OUTSIDE FACE OF THE FOUNDATION WALL ON EACH SIDE OF THE WINDOW OPENING - BARS TO HAVE MIN. 2" (50) CONC. COVER - BARS TO EXTEND 2'-0" (610) BEYOND BOTH SIDES OF OPENING
- 43 STUD WALL REINFORCEMENT** PROVIDE STUD WALL REINFORCEMENT IN MAIN BATHROOM CONFORMING TO O.B.C. (9.5.2.3.1) AND 9.8.3.3. (2) (REFER TO DETAILS)
- 44 WINDOW WELLS** WHERE A WINDOW OPENS INTO A WINDOW WELL, A CLEARANCE OF NOT LESS THAN 21 5/8" (550) SHALL BE PROVIDED IN FRONT OF THE WINDOW. EVERY WINDOW WELL SHALL BE DRAINED TO THE FOOTING LEVEL OR OTHER SUITABLE LOCATION WITH A 4" (100) WEEPING TILE OR A FILTER CLOTH WRAP AND FILLED WITH CRUSHED STONE. (9.9.13.1 (5), 9.14.6.3)
- 45 SLOPED CEILING CONSTRUCTION** ((SB-12) 2.1.1.7., 9.23.4.2.) 2"x12" (38x286) ROOF JOISTS @ 16" (406) O.C. MAX. (UNLESS OTHERWISE NOTED) W/ 2"x2" (38x38) PURLINS @ 16" (406) O.C. PERPENDICULAR TO ROOF JOIST (PURLINS NOT REQ. W/ SPRAY FOAM), W/ INSULATION BETWEEN JOIST 6 mil POLYETHYLENE VAPOUR BARRIER, 1 1/2" (12.7) GYPSUM WALLBOARD INT. FINISH OR APPROVED EQ. INSULATION VALUE DIRECTLY ABOVE THE INNER SURFACE OF EXTERIOR WALLS SHALL NOT BE LESS THAN R20 (3.52 RS).
- 46 FLAT ROOF/BALCONY CONSTRUCTION** WATERPROOFING MEMBRANE FULLY ADHERED TO 5/8" (15.9) T&G EXTERIOR GRADE PLYWOOD SHEATHING ON 2"x2" (38x38) PURLINS ANGLED TOWARDS SCUPPER @ 2% MINIMUM LAID PERPENDICULAR TO 2"x6" (38x184) FLOOR JOISTS @ 16" (406) O.C. (UNLESS OTHERWISE NOTED), BUILT UP CURB TO BE 4" (100) MIN. ABOVE FINISHED BALCONY FLOOR. CONTINUOUS L TRIM DRIP EDGE TO BE PROVIDED ON OUTSIDE FACE OF CURB. SCUPPER DRAIN TO BE LOCATED 24" (610) MIN. AWAY FROM HOUSE. PREFINISHED ALUMINUM OR PANEL FOR UNDERSIDE OF SOFFIT (9.25.2.3). REMOVE CURB WHERE REQ. **BALCONY CONDITION** SEE FLAT ROOF/BALCONY CONSTRUCTION NOTE. INCLUDE 2"x4" (38x89) PT. DECKING W/ 1/4" (6.4) GAPS LAID FLAT PARALLEL TO JOISTS ON 2"x4" (38x89) PT. SLEEPERS @ 12" (305) O.C. LAID FLAT PERPENDICULAR TO JOISTS **BALCONY OVER HEATED SPACE CONDITION** SEE FLAT ROOF/BALCONY CONSTRUCTION NOTE FOR ASSEMBLY. REFER TO PLANS FOR FLOOR JOIST SIZE & REFER TO HEX NOTE 9 FOR INSULATION AND INTERIOR FINISH
- 47 BARREL VAULT CONSTRUCTION** CANTILEVERED 2"x4" (38x89) SPACERS LAID FLAT ON 2"x10" (38x235) SPR. #2 ROOF JOIST NAILED TO BUILT-UP 3-3/4" (19) PLYWOOD HEADER PROFILED FOR BARREL. SPRAY FOAM INSULATION BETWEEN JOISTS W/ GYPSUM BOARD INTERIOR FIN. (REFER TO DETAILS)

REFER TO SB-12 ENERGY EFFICIENCY DESIGN MATRIX ON THE TITLE PAGE FOR ALL VALUES AS REQUIRED PER 3.1.1., 3.1.2., 3.1.3., OF THE OBC.

SECTION 1.1. WALL STUDS

- REFER TO THIS CHART FOR STUD SIZE & SPACING AS REQUIRED FOR EXTERIOR WALLS ONLY. REFER TO SITING & GRADING PLAN OF THIS UNIT FOR CONFIRMATION OF TOP OF FOUNDATION WALL AND ADDITIONAL INFORMATION
- IF STUD WALL HEIGHT EXCEEDS MAX. UNSUPPORTED HEIGHT, WALL NEEDS TO BE REVIEWED AND APPROVED BY ENGINEER

SIZE & SPACING OF STUDS (OBC REFERENCE - TABLE 9.23.10.1)				
MIN. STUD SIZE in (mm)	SUPPORTED LOADS (EXTERIOR)			
	ROOF w/ OR w/o ATTIC	ROOF w/ OR w/o ATTIC & 1 FLOOR ATTIC	ROOF w/ OR w/o ATTIC & 2 FLOOR ATTIC	ROOF w/ OR w/o ATTIC & 3 FLOOR
	MAX. STUD SPACING, in (mm) O.C.			
	MAX. UNSUPPORTED HGT., ft-in (m)			
2"x4" (38x89)	24" (610)	16" (406)	12" (305)	N/A
2"x6" (38x140)	9-10" (3.0)	9-10" (3.0)	9-10" (3.0)	N/A
2"x6" (38x140)	-	8-2" (610)	16" (406)	12" (305)
2"x6" (38x140)	-	9-10" (3.0)	11-10" (3.6)	5-11" (1.8)

SECTION 2.0. GENERAL NOTES

- 2.1. WINDOWS** 1) DIRECT WHERE A DOOR ON THE SAME FLOOR LEVEL AS THE BEDROOM PROVIDES DIRECT ACCESS TO THE EXTERIOR, EVERY FLOOR LEVEL CONTAINING A BEDROOM IS TO HAVE AT LEAST ONE OUTSIDE WINDOW W/ MIN. 0.35m² UNOBSTRUCTED OPEN PORTION W/ NO DIMENSION LESS THAN 1'-3" (380), CAPABLE OF MAINTAINING THE OPENING WITHOUT THE NEED FOR ADDITIONAL SUPPORT, CONFORMING TO 9.9.10. 2) WINDOW GUARDS: A GUARD OR A WINDOW WITH A MAXIMUM RESTRICTED OPENING WIDTH OF 4" (100) IS REQUIRED WHERE THE TOP OF THE WINDOW SILL IS LOCATED LESS THAN 1'-7" (480) ABOVE FIN. FLOOR AND THE DISTANCE FROM THE FINISHED FLOOR TO THE ADJACENT GRADE IS GREATER THAN 2'-11" (680). (9.8.8.1) 3) WINDOWS IN EXIT STAIRWAYS THAT EXTEND TO LESS THAN 2'-11" (680) (3'-6" (1070) FOR ALL OTHER BUILDINGS) SHALL BE PROTECTED BY GUARDS IN ACCORDANCE WITH NOTE #2 (ABOVE), OR THE WINDOW SHALL BE NON-OPERABLE AND DESIGNED TO WITHSTAND THE SPECIFIED LOADS FOR BALCONY GUARDS AS PROVIDED IN 4.1.5.15 OR 9.8.8.2
- 4) REFER TO TITLE PAGE FOR MAX. U-VALUE REQUIREMENTS
- 2.2. CEILING HEIGHTS** THE CEILING HEIGHTS OF ROOMS AND SPACES SHALL CONFORM TO TABLE 9.5.3.1
- | ROOM OR SPACE | MINIMUM HEIGHTS |
|--------------------------------------|---|
| LIVING ROOM, DINING ROOM AND KITCHEN | 7'-7" OVER 75% OF REQUIRED FLOOR AREA WITH A CLEAR HEIGHT OF 6'-11" AT ANY POINT |
| BEDROOM | 7'-7" OVER 50% OF REQUIRED FLOOR AREA OR 6'-11" OVER ALL OF THE REQUIRED FLOOR AREA |
| BASEMENT | 6'-11" OVER AT LEAST 75% OF THE BASEMENT AREA EXCEPT THAT UNDER BEAMS AND DUCTS THE CLEARANCE IS PERMITTED TO BE REDUCED TO 6'-6" |
| BATHROOM, LAUNDRY AREA ABOVE GRADE | 6'-11" IN ANY AREA WHERE A PERSON WOULD NORMALLY BE STANDING |
| FINISHED ROOM NOT MENTIONED ABOVE | 6'-11" |
| MEZZANINES | 6'-11" ABOVE & BELOW FLOOR ASSEMBLY (9.5.3.2) |
| STORAGE GARAGE | 6'-7" (9.5.3.3) |
- 2.3. MECHANICAL / PLUMBING** 1) MECHANICAL VENTILATION IS REQUIRED TO PROVIDE 0.7 AIR CHANGE PER HOUR, IF NOT AIR CONDITIONED, 1 PER HOUR IF AIR CONDITIONED AVERAGED OVER 24 HOURS. WHEN A VENTILATION FAN (PRINCIPAL EXHAUST) IS REQUIRED, CONFORM TO OBC 9.32.3.4. WHEN A HRV IS REQUIRED, CONFORM TO 9.32.3.11. REFER TO MECHANICAL DRAWINGS
- 2) REFER TO HOT WATER TANK MANUFACTURER SPECS. CONFORM TO OBC 9.31.6.
- 3) REFER TO TITLE PAGE FOR SPACE HEATING EQUIPMENT, HRV AND DOMESTIC HOT WATER HEATER MINIMUM EFFICIENCIES.
- 4) DRAIN WATER HEAT RECOVERY UNIT(S) WILL BE INSTALLED CONFORMING TO THE REQUIREMENTS OF 3.1.1.12 OF THE O.B.C.
- 2.4. LUMBER** 1) ALL LUMBER SHALL BE SPRUCE No 2 GRADE OR BETTER, UNLESS NOTED OTHERWISE
- 2) STUDS SHALL BE STUD GRADE SPRUCE, UNLESS NOTED OTHERWISE
- 3) LUMBER EXPOSED TO THE EXTERIOR TO BE SPRUCE No 2 GRADE PRESSURE TREATED OR CEDAR, UNLESS NOTED OTHERWISE
- 4) ALL LAMINATED VENEER LUMBER (LVL) BEAMS, GIRDER TRUSSES, AND METAL HANGER CONNECTIONS SUPPORTING ROOF FRAMING TO BE DESIGNED & CERTIFIED BY FLOOR AND ROOF TRUSS MANUFACTURER
- 5) JOIST HANGERS: PROVIDE APPROVED METAL HANGERS FOR ALL JOISTS AND BUILT-UP WOOD MEMBERS INTERSECTING WITH FLUSH BUILT-UP WOOD MEMBERS.
- 6) WOOD FRAMING NOT TREATED WITH A WOOD PRESERVATIVE, IN CONTACT WITH CONCRETE, SHALL BE SEPARATED FROM THE CONC. BY AT LEAST 2 mil POLYETHYLENE FILM, No.60 (48kg) ROLL ROOFING OR OTHER DAMPROOFING MATERIAL, EXCEPT WHERE THE WOOD MEMBER IS AT LEAST 6" (152) ABOVE THE GROUND.
- 2.5. STEEL** (9.23.4.3) 1) STRUCTURAL STEEL SHALL CONFORM TO CAN/CSA-G40-21 GRADE 300W HOLLOW STRUCT. SECTIONS SHALL CONFORM TO CAN/CSA-G40-21 GRADE 350W CLASS "H"
- 2) REINFORCING STEEL SHALL CONFORM TO CSA-G30-18M GRADE 400R
- 2.6. FLAT ARCHES** 1) FOR 8'-0" (2440) CEILINGS, FLAT ARCHES SHALL BE 6'-10" (2080) A F F
- 2) FOR 9'-0" (2740) CEILINGS, FLAT ARCHES SHALL BE 7'-10" (2400) A F F
- 3) FOR 10'-0" (3040) CEILINGS, FLAT ARCHES SHALL BE 8'-6" (2600) A F F
- 2.7. ROOF OVERHANGS** 1) ALL ROOF OVERHANGS SHALL BE 1'-0" (305), UNLESS NOTED OTHERWISE.
- 2.8. FLASHING** (9.20.13, 9.25.4, 9.27.3) 1) FLASHING MATERIALS & INSTALLATION SHALL CONFORM TO O.B.C.
- 2.9. GRADING** 1) THE BUILDING SHALL BE LOCATED ON THE BUILDING SITE GRADED SO THE WATER WILL NOT ACCUMULATE AT OR NEAR THE BUILDING AND WILL NOT ADVERSELY AFFECT ADJACENT PROPERTIES. CONFORM TO 9.14.6
- 2.10. ULC SPECIFIED ASSEMBLIES** ALL REQUIRED INDIVIDUAL COMPONENTS THAT FORM PART OF ANY ULC LISTED ASSEMBLY SPECIFIED WITHIN THESE DRAWINGS, CANNOT BE ALTERED OR SUBSTITUTED FOR ANY OTHER MATERIAL/PRODUCT OR SPECIFIED MANUFACTURER THAT IS IDENTIFIED IN THAT "SPECIFIED ULC LISTING". THERE SHALL BE NO DEVIATIONS UNDER ANY CIRCUMSTANCES IN ANY ULC LISTED ASSEMBLY IDENTIFIED IN THESE DRAWINGS

3.3. DOOR SCHEDULE	
CONFORMING TO SECTIONS 9.5.11, 9.6, 9.7.2.1, & 9.10.13.10	
* EXTERIOR	2'-8" x 6'-8" x 1-3/4" (815 x 2030 x 45) INSULATED MIN. R4 (RSI 0.7)
1A EXTERIOR	2'-10" x 6'-8" x 1-3/4" (865 x 2030 x 45) INSULATED MIN. R4 (RSI 0.7)
1B EXTERIOR	3'-0" x 6'-8" x 1-3/4" (915 x 2030 x 45) INSULATED MIN. R4 (RSI 0.7)
1C EXTERIOR	2'-6" x 6'-8" x 1-3/4" (760 x 2030 x 45) INSULATED MIN. R4 (RSI 0.7)
1D EXTERIOR	2'-8" x 6'-8" x 1-3/4" (815 x 2030 x 45) INS. MIN. R4 (RSI 0.7) (SEE HEX NOTE 20)
1E EXTERIOR	3'-0" x 8'-0" x 1-3/4" (915 x 2440 x 45) INSULATED MIN. R4 (RSI 0.7)
2A EXTERIOR	3'-8" x 6'-8" x 1-3/4" (934 x 1815 x 2030 x 45) 20 MIN. F.R.R. DOORFRAME WITH APP. SELF CLOSING DEVICE
2 EXTERIOR	2'-6" x 6'-8" x 1-3/8" (815 x 2030 x 35)
3 EXTERIOR	2'-6" x 6'-8" x 1-3/8" (760 x 2030 x 35)
3A EXTERIOR	2'-4" x 6'-8" x 1-3/8" (710 x 2030 x 35)
4 EXTERIOR	2'-0" x 6'-8" x 1-3/8" (610 x 2030 x 35)
4A EXTERIOR	2'-2" x 6'-8" x 1-3/8" (660 x 2030 x 35)
5 EXTERIOR	1'-6" x 6'-8" x 1-3/8" (460 x 2030 x 35)

- 3.4. ACRONYMS**
- | | | | |
|----------|-----------------------------------|------|-------------------------|
| AFF | ABOVE FINISHED FLOOR | JST | JOIST |
| BBFM | BEAM BY FLOOR MANUFACTURER | LIN | LINEN CLOSET |
| BG | FIXED GLASS W/ BLACK BACKING | LVL | LAMINATED VENEER LUMBER |
| BM | BEAM | OTBA | OPEN TO BELOW/ABOVE |
| BBRM | BEAM BY ROOF MANUFACTURER | PL | POINT LOAD |
| CRF | CONVENTIONAL ROOF FRAMING | PLT | PLATE |
| CW | COMPLETE WITH | PT | PRESSURE TREATED |
| DJ/TJ | DOUBLE JOIST/ TRIPLE JOIST | PTD | PAINTED |
| DO | DO OVER | PWD | POWDER ROOM |
| DRP | DROPPED | RT | ROOF TRUSS |
| E.I.F.S. | EXTERIOR INSULATION FINISH SYSTEM | RWL | RAIN WATER LEADER |
| ENG | ENGINEERED | SB | SOLID BEARING WOOD POST |
| EST | ESTIMATED | SBFA | SB FROM ABOVE |
| FA | FLAT ARCH | SJ | SINGLE JOIST |
| FD | FLOOR DRAIN | SPR | SPRUCE |
| FG | FIXED GLASS | STL | STEEL |
| FL | FLUSH | T/O | TOP OF |
| FLR | FLOOR | TYP | TYPICAL |
| GT | GIRDER TRUSS | UIS | UNDERSIDE |
| HB | HOUSE BIB | WD | WOOD |
| HRV | HEAT RETURN VENTILATION UNIT | WIC | WALK IN CLOSET |
| HWT | HOT WATER TANK | WP | WEATHER PROOF |
- 3.5. SYMBOLS**
- ALL ELECTRICAL FACILITIES SHALL BE INSTALLED IN ACCORDANCE WITH SECTION 9.34
- | | |
|----------------------------|--|
| CLASS B VENT | EXHAUST VENT |
| DUPLEX OUTLET 112" HIGH | DUPLEX OUTLET (HEIGHT AS NOTED A.F.F.) |
| HEAVY DUTY OUTLET | SWITCH (2/3/4 WAY) |
| POT LIGHT | LIGHT FIXTURE (CEILING MOUNTED) |
| LIGHT FIXTURE (POUL CHAIN) | LIGHT FIXTURE (WALL MOUNTED) |
| CABLE T.V. JACK | TELEPHONE JACK |
| CENTRAL VACUUM OUTLET | CHANDELIER (CEILING MOUNTED) |
- SA **SMOKE ALARM** (9.10.15) PROVIDE ONE PER FLOOR. NEAR THE STAIRS CONNECTING THE FLOOR LEVEL. ALARMS ARE TO BE INSTALLED IN EACH SLEEPING ROOM AND IN A LOCATION BETWEEN SLEEPING ROOMS AND CONNECTING HALLWAYS AND WIRED TO BE INTERCONNECTED TO ACTIVATE ALL ALARMS IF ONE SOUNDS. ALARMS ARE TO BE CONNECTED TO AN ELECTRICAL CIRCUIT AND WITH A BATTERY BACKUP. ALARM SIGNAL SHALL MEET TEMPORAL SOUND PATTERN IS MIN. ALARMS SHALL HAVE A VISUAL SIGNALING COMPONENT AS PER THE NATIONAL FIRE ALARM AND SIGNALING CODE 72
- CMD **CARBON MONOXIDE ALARM** (9.33.4) ** CHECK LOCAL BY-LAWS FOR REQUIREMENTS ** A CARBON MONOXIDE ALARMS) CONFORMING TO CAN/CSA-6.19 SHALL BE INSTALLED ON OR NEAR THE CEILING IN EACH DWELLING UNIT ADJACENT TO EACH SLEEPING AREA. CARBON MONOXIDE ALARMS) SHALL BE PERMANENTLY WIRED WITH NO DISCONNECT SWITCH, WITH AN ALARM THAT IS AUDIBLE WITHIN SLEEPING ROOMS WHEN THE INTERVENING DOORS ARE CLOSED
- SB **SOLID BEARING (BUILT-UP WOOD COLUMNS AND STUD POSTS)** THE WIDTH OF A WOOD COLUMN SHALL NOT BE LESS THAN THE WIDTH OF SUPPORTED MEMBER. BUILT-UP WOOD COLUMNS SHALL BE NAILED TOGETHER WITH NOT LESS THAN 3" (76) NAILS SPACED NOT MORE THAN 11 3/4" (300) O.C. THE NUMBER OF STUDS IN A WALL DIRECTLY BELOW A GIRDER TRUSS OR ROOF BEAM SHALL CONFORM TO TABLES A-34 TO A-37. (9.17.4, 9.23.10.7)
- TWO STOREY VOLUME SPACE. SEE CONSTRUCTION NOTE 39.
- VARYING PLATES: BUILT-OUT FLOORS, BEARING WALLS, ICE & WATER SHIELD
- EXPOSED BUILDING FACE - O.B.C. 9.10.14, OR 9.10.15. REFER TO HEX NOTE 35, & DETAILS FOR TYPE AND SPECIFICATIONS.
- 1 HR. PARTY WALL. REFER TO HEX NOTE 40
- 2 HR. FIREWALL. REFER TO HEX NOTE 40A

2.4. LUMBER

1) ALL LUMBER SHALL BE SPRUCE No 2 GRADE OR BETTER, UNLESS NOTED OTHERWISE

2) STUDS SHALL BE STUD GRADE SPRUCE, UNLESS NOTED OTHERWISE

3) LUMBER EXPOSED TO THE EXTERIOR TO BE SPRUCE No 2 GRADE PRESSURE TREATED OR CEDAR, UNLESS NOTED OTHERWISE

4) ALL LAMINATED VENEER LUMBER (LVL) BEAMS, GIRDER TRUSSES, AND METAL HANGER CONNECTIONS SUPPORTING ROOF FRAMING TO BE DESIGNED & CERTIFIED BY FLOOR AND ROOF TRUSS MANUFACTURER

5) JOIST HANGERS: PROVIDE APPROVED METAL HANGERS FOR ALL JOISTS AND BUILT-UP WOOD MEMBERS INTERSECTING WITH FLUSH BUILT-UP WOOD MEMBERS:

6) WOOD FRAMING NOT TREATED WITH A WOOD PRESERVATIVE, IN CONTACT WITH CONCRETE, SHALL BE SEPARATED FROM THE CONC. BY AT LEAST 2 mil POLYETHYLENE FILM, No. 30 (45lb) ROLL ROOFING OR OTHER DAMPPROOFING MATERIAL, EXCEPT WHERE THE WOOD MEMBER IS AT LEAST 6" (152) ABOVE THE GROUND.

2.5. STEEL (9.23.4.3.)

1) STRUCTURAL STEEL SHALL CONFORM TO CAN/CSA-G40-21 GRADE 300W HOLLOW STRUCT. SECTIONS SHALL CONFORM TO CAN/CSA-G40-21 GRADE 350W CLASS "H"

2) REINFORCING STEEL SHALL CONFORM TO CSA-G30-18M GRADE 400R

2.6. FLAT ARCHES

1) FOR 8'-0" (2440) CEILINGS, FLAT ARCHES SHALL BE 6'-10" (2080) A F F

2) FOR 9'-0" (2740) CEILINGS, FLAT ARCHES SHALL BE 7'-10" (2400) A F F

3) FOR 10'-0" (3040) CEILINGS, FLAT ARCHES SHALL BE 8'-6" (2600) A F F

2.7. ROOF OVERHANGS

1) ALL ROOF OVERHANGS SHALL BE 1'-0" (305), UNLESS NOTED OTHERWISE.

2.8. FLASHING (9.20.13, 9.25.4, 9.27.3.)

1) FLASHING MATERIALS & INSTALLATION SHALL CONFORM TO CIBC.

2.9. GRADING

1) THE BUILDING SHALL BE LOCATED ON THE BUILDING SITE GRADED SO THE WATER WILL NOT ACCUMULATE AT OR NEAR THE BUILDING AND WILL NOT ADVERSELY AFFECT ADJACENT PROPERTIES. CONFORM TO 9.14.6

2.10. ULC SPECIFIED ASSEMBLIES

ALL REQUIRED INDIVIDUAL COMPONENTS THAT FORM PART OF ANY ULC LISTED ASSEMBLY SPECIFIED WITHIN THESE DRAWINGS, CANNOT BE ALTERED OR SUBSTITUTED FOR ANY OTHER MATERIAL PRODUCT OR SPECIFIED MANUFACTURER THAT IS IDENTIFIED IN THAT SPECIFIED ULC LISTING. THERE SHALL BE NO DEVIATIONS UNDER ANY CIRCUMSTANCES IN ANY ULC LISTED ASSEMBLY IDENTIFIED IN THESE DRAWINGS

SECTION 3.0. LEGEND

3.1. WOOD LINTELS AND BUILT-UP WOOD			
(DIVISION B PART 9, TABLES A8 TO A10 AND A12, A15 & A16)			
FORMING PART OF SENTENCE 9.23.4.2(3), 9.23.4.2(4), 9.23.12.3(1), 9.23.13.6(2), 9.37.3(1)			
2"x6" SPRUCE #2	2"x10" SPRUCE #2	2"x12" SPRUCE #2	
L1 3/2"x6" (2/38x184)	L3 2/2"x10" (2/38x235)	L5 2/2"x12" (2/38x266)	
B1 3/2"x8" (3/38x184)	B3 3/2"x10" (3/38x235)	B5 3/2"x12" (3/38x266)	
B2 4/2"x8" (4/38x184)	B4 4/2"x10" (4/38x235)	B6 4/2"x12" (4/38x266)	
B7 5/2"x8" (5/38x184)	B8 5/2"x10" (5/38x235)	B9 5/2"x12" (5/38x266)	
ENGINEERED LUMBER SCHEDULE - GRADE 2.0E UNLESS OTHERWISE NOTED			
1 3/4" x 9 1/2" LVL	1 3/4" x 11 7/8" LVL	1 3/4" x 14" LVL	
LVL2 1-1 3/4"x9 1/2"	LVL3 1-1 3/4"x11 7/8"	LVL10 1-1 3/4"x14"	
LVL4 2-1 3/4"x9 1/2"	LVL6 2-1 3/4"x11 7/8"	LVL11 2-1 3/4"x14"	
LVL5 3-1 3/4"x9 1/2"	LVL7 3-1 3/4"x11 7/8"	LVL12 3-1 3/4"x14"	
LVL8 4-1 3/4"x9 1/2"	LVL8 4-1 3/4"x11 7/8"	LVL13 4-1 3/4"x14"	
3.2. STEEL LINTELS SUPPORTING MASONRY VENEER			
(DIVISION B PART 9, TABLE 9.20.5.2.B.)			
FORMING PART OF SENTENCE 9.20.5.2(2) & 9.20.5.2(3)			
CODE	SIZE	BRICK	STONE
L7	3 1/2" x 3 1/2" x 1/4" (89 x 89 x 6.4)	3-1" (2.47m)	7-6" (2.30m)
L8	4 1/2" x 3 1/2" x 1/4" (102 x 89 x 6.4)	3-2" (2.66m)	8-1" (2.48m)
L9	4 7/8" x 3 1/2" x 5/16" (127 x 89 x 7.9)	10-1/8" (3.31m)	10-1" (3.03m)
L10	4 7/8" x 3 1/2" x 3/8" (127 x 89 x 11)	11-5" (3.48m)	10-7" (3.24m)
L11	5 7/8" x 3 1/2" x 3/8" (132 x 89 x 11)	12-6" (3.82m)	11-7" (3.54m)
L12	7 1/8" x 4" x 3/8" (178 x 102 x 11)	14-1" (4.30m)	13-1" (3.99m)

SECTION 4.0. CLIMATIC DATA

DESIGN SNOW LOAD (9.4.2.2.): 1.01 kPa

WIND LOAD (q50) (SB-1.2.): 0.44 kPa

CONTRACTOR MUST VERIFY ALL DIMENSIONS ON THE JOB. REPORT ANY DISCREPANCIES TO HUNT DESIGN ASSOCIATES INC. (H.D.A.) BEFORE PROCEEDING WITH THE WORK. ALL THE DRAWINGS & SPECIFICATIONS ARE THE INSTRUMENTS OF SERVICE AND ARE THE PROPERTY OF H.D.A.

ALL CONSTRUCTION TO ADHERE TO THESE PLANS AND SPECIFICATIONS AND TO CONFORM TO THE ONTARIO BUILDING CODE AND ALL OTHER APPLICABLE CODES AND AUTHORITIES HAVING JURISDICTION. THESE REQUIREMENTS ARE TO BE TAKEN AS MINIMUM SPECIFICATIONS. ONT. REG. 332/12

CONSTRUCTION NOTE REVISION DATE: January 1, 2017 - UPDATED to 2017 OBC

CONSTRUCTION NOTES 2

GOLDPARK HOMES - 217020 UNIT 4002 - THE VALLEYVIEW

PINE VALLEY, VAUGHAN, ONTARIO

Scale: 3/16"=1'-0"

Drawn By: JLL

Checked By: OF

File Number: 217020WS4002.rvt

Page Number: 18 of 18

5965 Woodbine Avenue, Suite 200, Markham, ON L3R 0J7

T 905.737.5133

F 905.737.7326

K:\PROJECTS\217020 Goldpark Homes\217020WS4002.rvt - 217020WS4002 - Val View.rvt

THE UNDERSIGNED HAS REVIEWED AND TAKES RESPONSIBILITY FOR THIS DESIGN AND HAS THE QUALIFYING AND TESTS THE REQUIREMENTS SET OUT IN THE ONTARIO BUILDING CODE.

Qualification Information

Chris Fairbairn


NAME

REGISTRATION INFORMATION


HUNT DESIGN ASSOCIATES INC.

19895

All drawings specifications related documents and design are the copyright property of Hunt Design Associates (H.D.A.). Reproduction of this property in whole or in part is strictly prohibited without H.D.A.'s written permission. H.D.A. assumes no responsibility or liability for the property unless it bears the appropriate BCDA number and original signature.

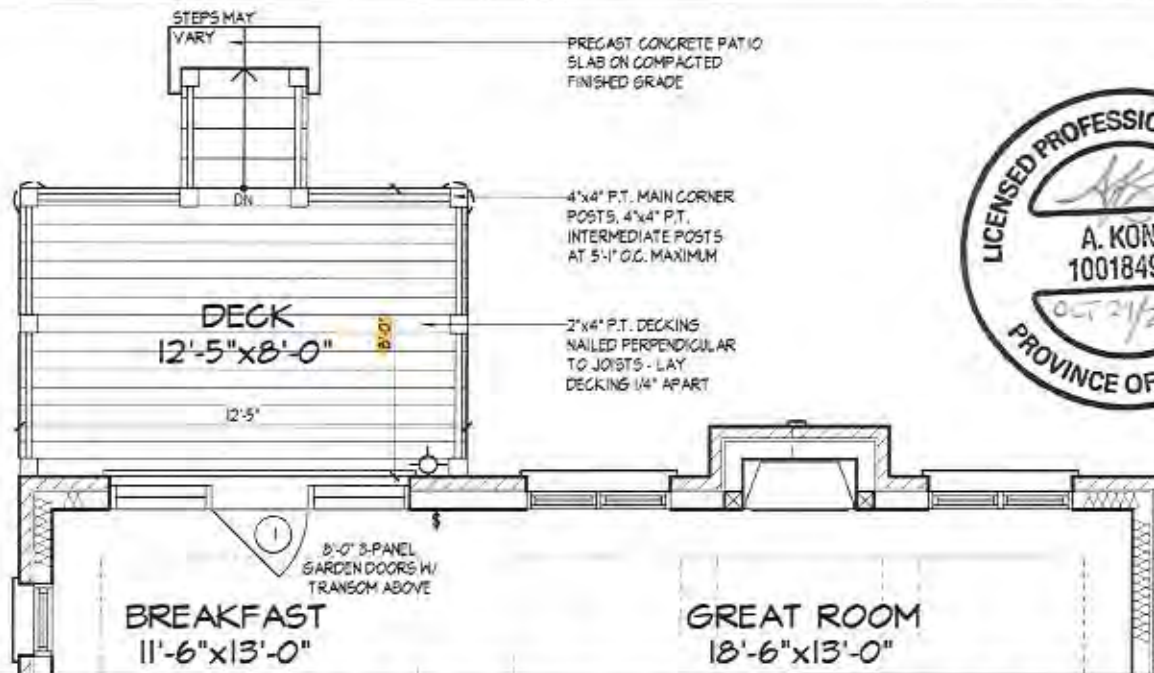

PART. GROUND FLOOR PLAN, ELEV. 'A' & 'B' - W.O.D. CONDITION

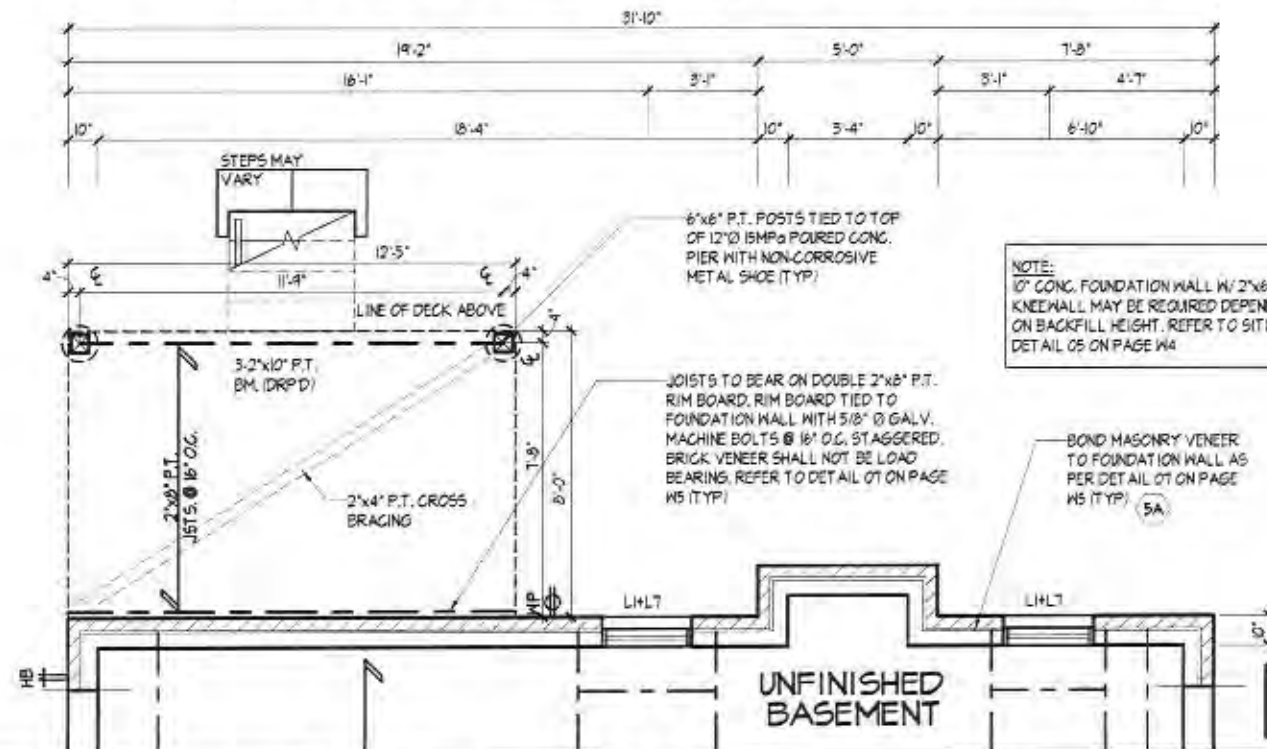

PART. BASEMENT PLAN, ELEV. 'A' & 'B' - W.O.D. CONDITION



WINDOW SIZES FOR W.O.D. CONDITIONS:
WINDOWS TO BE LOCATED WITHIN
JOIST SPACE. IF GRADE PERMITS, TOP
OF WINDOW TO BE 7'-10" A.F.F.

PART. REAR ELEVATION, 'A' & 'B' - W.O.D. CONDITION

REFER TO FRONT
ELEVATION FOR TYPICAL
NOTES & INFORMATION




It is the builder's complete responsibility to ensure that all plans submitted for approval fully comply with the Architectural Guidelines and all applicable regulations and requirements including zoning provisions and any provisions in the subdivision agreement. The Control Architect is not responsible in any way for examining or approving site (lotting) plans or working drawings with respect to any zoning or building code or permit matter or that any house can be properly built or located on its lot.


This is to certify that these plans comply with the applicable Architectural Design Guidelines approved by the City of VAUGHAN.

JOHN G. WILLIAMS LTD., ARCHITECT
ARCHITECTURAL CONTROL REVIEW
AND APPROVAL
APPROVED BY: [Signature]
DATE: OCT 30, 2018
This stamp certifies compliance with the applicable Design Guidelines only and bears no further professional responsibility.

WALK-OUT DECK CONDITION

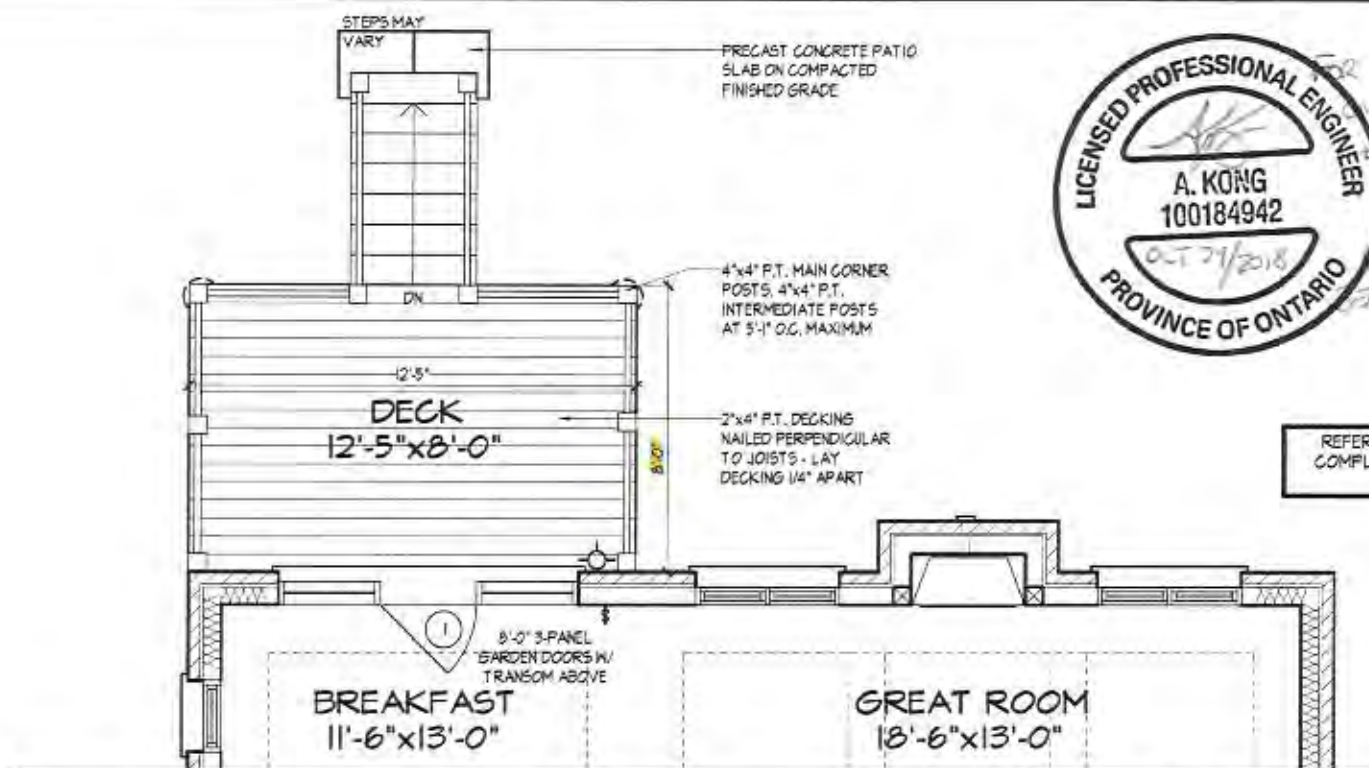

PART. GROUND FLOOR PLAN, ELEV. 'A' & 'B' - L.O.D. CONDITION

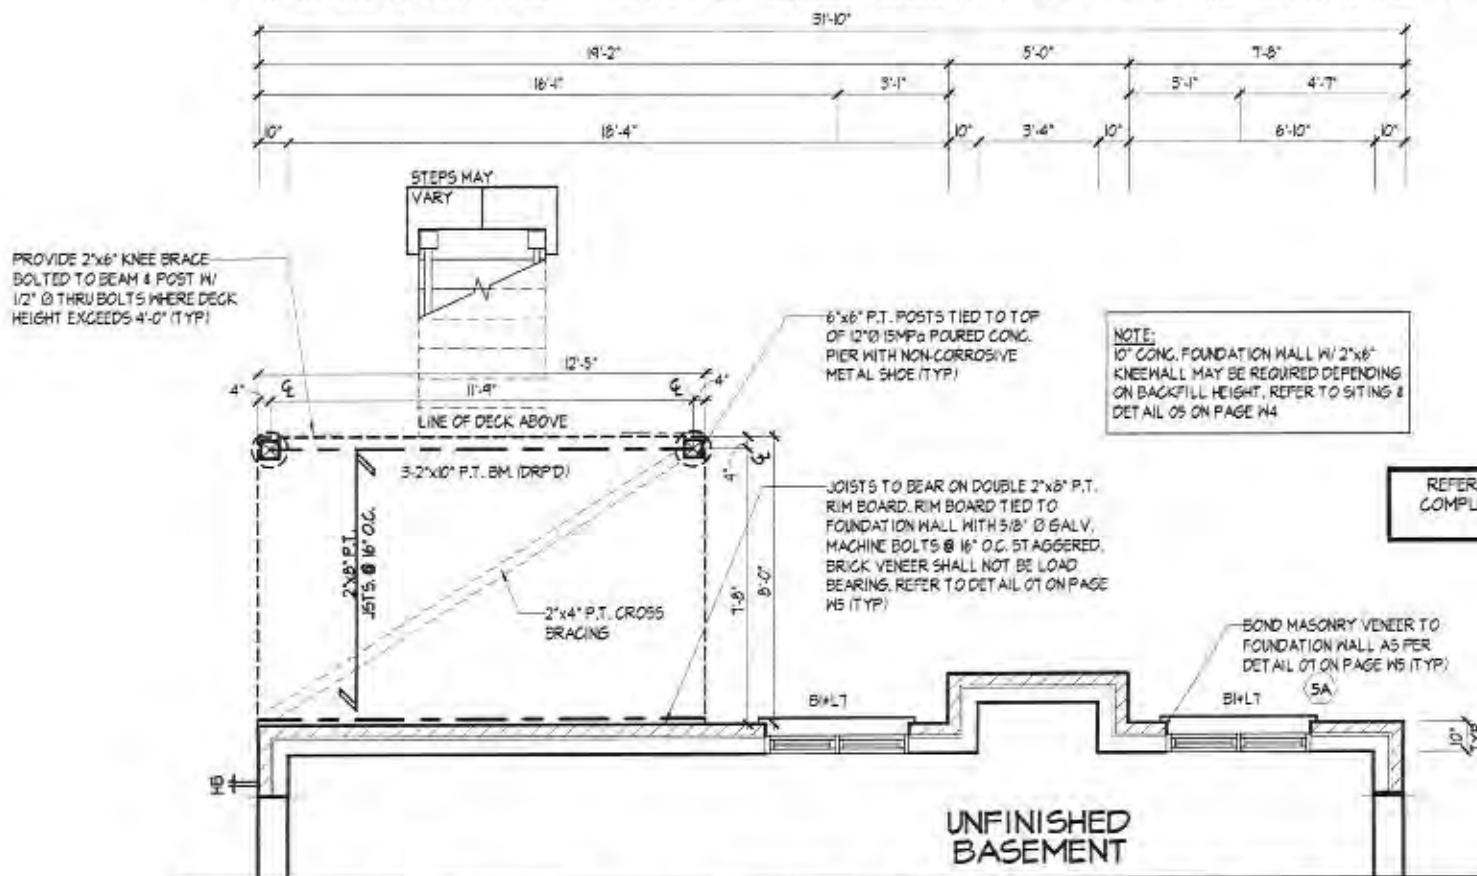


PART. BASEMENT PLAN, ELEV. 'A' & 'B' - L.O.D. CONDITION




PART. REAR ELEVATION, 'A' & 'B' - L.O.D. CONDITION

VAUGHAN
CITY OF VAUGHAN
BUILDING PERMIT DRAWINGS
CONSTRUCTION SHALL COMPLY WITH THE APPLICABLE REQUIREMENTS OF THE 2012 BUILDING CODE ACT
IT IS THE BUILDER'S COMPLETE RESPONSIBILITY TO ensure that all plans submitted for approval fully comply with the Architectural Guidelines and all applicable regulations and requirements including zoning provisions and any provisions in the subdivision agreement. The Control Architect is not responsible in any way for examining or approving site (lotting) plans or working drawings with respect to any zoning or building code or permit matter or that any house can be properly built or located on its lot.
This is to certify that these plans comply with the applicable Architectural Design Guidelines approved by the City of VAUGHAN.
JOHN G. WILLIAMS LTD., ARCHITECT
ARCHITECTURAL CONTROL REVIEW AND APPROVAL
APPROVED BY: [Signature]
DATE: OCT 30, 2018
This stamp certifies compliance with the applicable Design Guidelines only and bears no further professional responsibility.

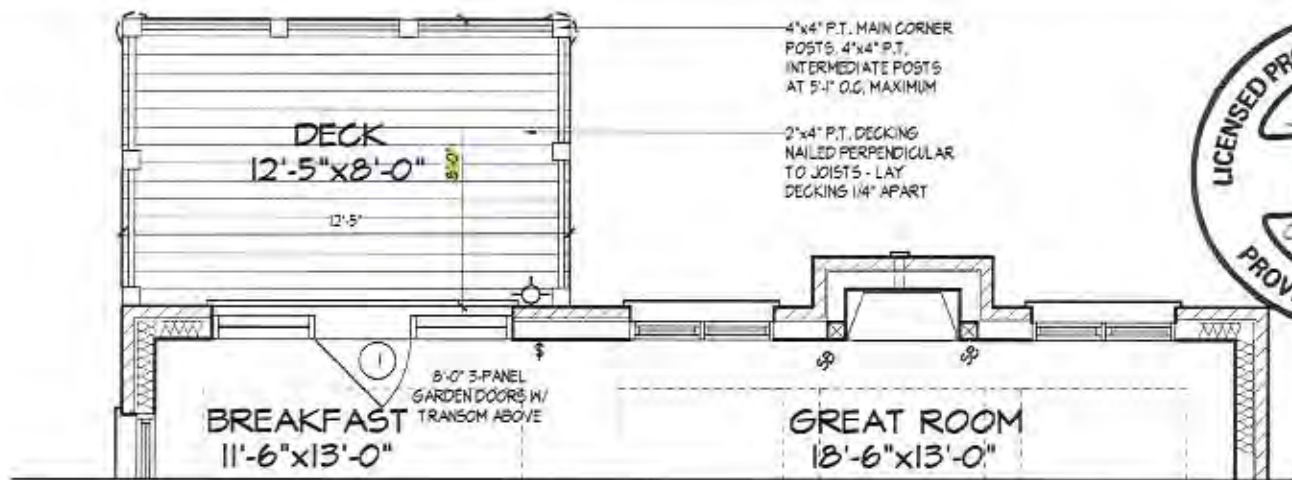

PART. GROUND FLOOR PLAN, ELEV. 'A' & 'B' - W.O.B. CONDITION

REFER TO STANDARD PLAN FOR COMPLETE CONSTRUCTION NOTES & DIMENSIONS

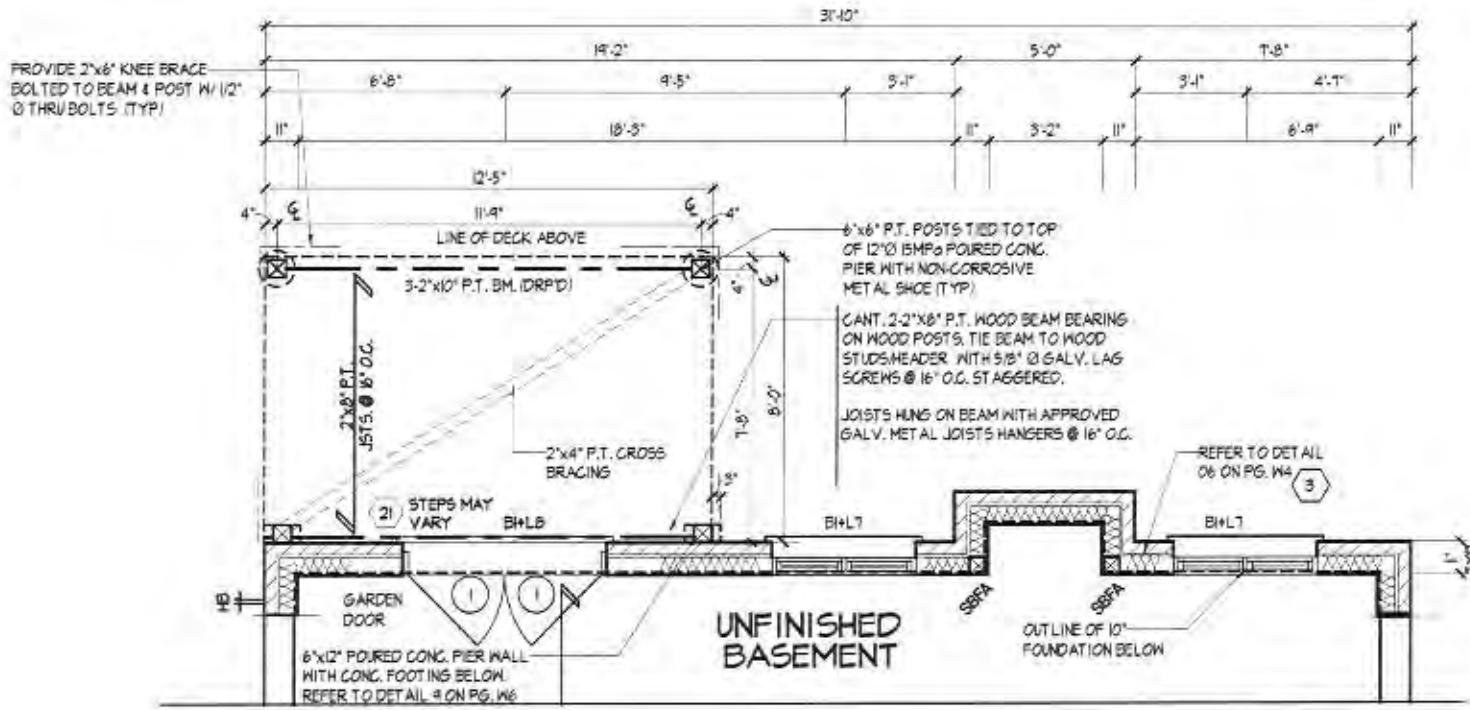

REFER TO STANDARD PLAN FOR COMPLETE CONSTRUCTION NOTES & DIMENSIONS

PART. BASEMENT PLAN, ELEV. 'A' & 'B' - W.O.B. CONDITION



WINDOW SIZES FOR W.O.B. CONDITIONS:
- W.O.B. = MATCH WIDTH OF WINDOW ABOVE AND WINDOWS TO BE 56" DEEP.
TOP OF WINDOW TO BE @ 7'-10" A.F.F.

REFER TO FRONT ELEVATION FOR TYPICAL NOTES & INFORMATION

It is the builder's complete responsibility to ensure that all plans submitted for approval fully comply with the Architectural Guidelines and all applicable regulations and requirements including zoning provisions and any provisions in the subdivision agreement. The Control Architect is not responsible in any way for examining or approving site (lotting) plans or working drawings with respect to any zoning or building code or permit matter or that any house can be properly built or located on its lot.

This is to certify that these plans comply with the applicable Architectural Design Guidelines approved by the City of VAUGHAN.

JOHN G. WILLIAMS LTD., ARCHITECT
ARCHITECTURAL CONTROL REVIEW
AND APPROVAL

APPROVED BY: _____
DATE: OCT 30 2018

This stamp certifies compliance with the applicable Design Guidelines only and bears no further professional responsibility.

PART. REAR ELEVATION, 'A' & 'B' - W.O.B. CONDITION



SIZE & SPACING OF STUDS (OBC REFERENCE - TABLE 9.23.10.1)				
MIN. STUD SIZE in (mm)	SUPPORTED LOADS (EXTERIOR)			
	ROOF w/ OR w/o ATTIC	ROOF w/ OR w/o ATTIC & 1 FLOOR	ROOF w/ OR w/o ATTIC & 2 FLOOR	ROOF w/ OR w/o ATTIC & 3 FLOOR
	MAX. STUD SPACING in (mm) O.C.			
	MAX. UNSUPPORTED HGT. ft-in (m)			
2"x4" (38x89)	24" (610)	16" (405)	12" (305)	N/A
	9'-10" (3.0)	9'-10" (3.0)	9'-10" (3.0)	N/A
2"x6" (38x140)	-	24" (610)	16" (406)	12" (305)
	-	9'-10" (3.0)	11'-10" (3.6)	5'-11" (1.8)

- REFER TO THIS CHART FOR STUD SIZE & SPACING AS REQUIRED FOR EXTERIOR WALLS ONLY. REFER TO SITING & GRADING PLAN OF THIS UNIT FOR CONFIRMATION OF TOP OF FOUNDATION WALL AND ADDITIONAL INFORMATION.

- IF STUD WALL HEIGHT EXCEEDS MAX. UNSUPPORTED HEIGHT, WALL NEEDS TO BE REVIEWED AND APPROVED BY ENGINEER.

BASE FLASHING CONFORMING TO TABLE 9.20.13.1 TO EXTEND 3/16" BEYOND OUTER FACE OF FOUNDATION WALL, TIED TO EXT. SHEATHING UNDER AIR/WATER BARRIER, PROVIDE 6" MINIMUM LAP JOINT.

WEEP HOLES @ 32" O.C. AT BASE FLASHING AND OVER ALL OPENINGS. PROVIDE P.V.C. BRICK VENTILATOR @ ALL WEEP HOLE LOCATIONS.

PROVIDE MASONRY PARAPET FROM TOP OF FOUNDATION WALL TO 2" BELOW FINISHED GRADE

FOUNDATION WALLS SHALL NOT EXCEED 9'4" (3.0m) IN UNSUPPORTED HEIGHT UNLESS OTHERWISE NOTED. (9.15.4.2.1). POURED CONC. FDN. WALL WITH BITUMINOUS DAMPPROOFING AND DRAINAGE LAYER. REFER TO CHART FOR MAXIMUM UNSUPPORTED HEIGHT AND EARTH RETENTION FROM BASEMENT SLAB TO FINISHED GRADE. ON CONTINUOUS KEYED CONC. FTG. BRACE FOUNDATION WALL PRIOR TO BACKFILLING. ALL FOOTINGS SHALL REST ON NATURAL UNDISTURBED SOIL OR COMPACTED ENGINEERED FILL.

UNREINFORCED SOLID CONCRETE FOUNDATION WALLS (9.15.4.2.1)				
STRENGTH REQUIREMENTS	MAX. HEIGHT FROM FIN. SLAB TO GRADE			
	UNSUPPORTED AT TOP	SUPPORTED AT TOP		
8" 25 MPa	8' 3"-11" (2.5m)	7'-0" (2.1m)	7'-0" (2.1m)	6'-10" (2.1m)
10" 25 MPa	10' 4"-12" (3.0m)	7'-6" (2.3m)	8'-6" (2.6m)	8'-2" (2.5m)
12" 25 MPa	12' 4"-14" (3.5m)	7'-6" (2.3m)	8'-6" (2.6m)	9'-3" (2.8m)
8" 35 MPa	8' 3"-11" (2.5m)	7'-6" (2.3m)	7'-6" (2.3m)	7'-2" (2.2m)
10" 35 MPa	10' 4"-12" (3.0m)	7'-6" (2.3m)	8'-6" (2.6m)	9'-3" (2.8m)
12" 35 MPa	12' 4"-14" (3.5m)	7'-6" (2.3m)	8'-6" (2.6m)	9'-3" (2.8m)
MINIMUM STRIP FOOTING SIZES (9.15.3)				
NUMBER FLOORS SUPPORTED	SUPPORTING INT. LOAD BEARING MASONRY WALL	SUPPORTING EXTERIOR	SUPPORTING PARTIAL WALL	
1	16" M x 6" D	16" M x 6" D	16" M x 6" D	
2	24" M x 8" D	20" M x 6" D	24" M x 8" D	
3	36" M x 14" D	26" M x 9" D	36" M x 14" D	

NOTE: FOOTING SIZE SUBJECT TO CERTIFICATION BY A SOIL CONSULTANT

MASONRY VENEER, 2"x6" STUDS, 10" FOUNDATION WALL Laterally Unsupported

SIZE & SPACING OF STUDS (OBC REFERENCE - TABLE 9.23.10.1)				
MIN. STUD SIZE in (mm)	SUPPORTED LOADS (EXTERIOR)			
	ROOF w/ OR w/o ATTIC	ROOF w/ OR w/o ATTIC & 1 FLOOR	ROOF w/ OR w/o ATTIC & 2 FLOOR	ROOF w/ OR w/o ATTIC & 3 FLOOR
	MAX. STUD SPACING in (mm) O.C.			
	MAX. UNSUPPORTED HGT. ft-in (m)			
2"x4" (38x89)	24" (610)	16" (405)	12" (305)	N/A
	4'-10" (3.0)	4'-10" (3.0)	4'-10" (3.0)	N/A
2"x6" (38x140)	-	24" (610)	16" (406)	12" (305)
	-	4'-10" (3.0)	11'-0" (3.6)	5'-11" (1.8)

- REFER TO THIS CHART FOR STUD SIZE & SPACING AS REQUIRED FOR EXTERIOR WALLS ONLY. REFER TO SITING & GRADING PLAN OF THIS UNIT FOR CONFIRMATION OF TOP OF FOUNDATION WALL AND ADDITIONAL INFORMATION

- IF STUD WALL HEIGHT EXCEEDS MAX. UNSUPPORTED HEIGHT, WALL NEEDS TO BE REVIEWED AND APPROVED BY ENGINEER.

BASE FLASHING CONFORMING TO TABLE 9.20.13.1 TO EXTEND 3/16" BEYOND OUTER FACE OF FOUNDATION WALL, TIED TO EXT. SHEATHING UNDER AIR/WATER BARRIER, PROVIDE 6" MINIMUM LAP JOINT.

WEEP HOLES @ 32" O.C. AT BASE FLASHING AND OVER ALL OPENINGS. PROVIDE P.V.C. BRICK VENTILATOR @ ALL WEEP HOLE LOCATIONS.

PROVIDE MASONRY PARAPET FROM TOP OF FOUNDATION WALL TO 2" BELOW FINISHED GRADE

OPTIONAL WEeping TILE AT REAR WALL-SEE MUNICIPAL STANDARDS

FOUNDATION WALLS SHALL NOT EXCEED 9'4" (3.0m) IN UNSUPPORTED HEIGHT UNLESS OTHERWISE NOTED. (9.15.4.2.1). POURED CONC. FDN. WALL WITH BITUMINOUS DAMPPROOFING AND DRAINAGE LAYER. REFER TO CHART FOR MAXIMUM UNSUPPORTED HEIGHT AND EARTH RETENTION FROM BASEMENT SLAB TO FINISHED GRADE. ON CONTINUOUS KEYED CONC. FTG. BRACE FOUNDATION WALL PRIOR TO BACKFILLING. ALL FOOTINGS SHALL REST ON NATURAL UNDISTURBED SOIL OR COMPACTED ENGINEERED FILL.

UNREINFORCED SOLID CONCRETE FOUNDATION WALLS (9.15.4.2.1)				
STRENGTH REQUIREMENTS	MAX. HEIGHT FROM FIN. SLAB TO GRADE			
	UNSUPPORTED AT TOP	SUPPORTED AT TOP		
8" 25 MPa	8' 3"-11" (2.5m)	7'-0" (2.1m)	7'-0" (2.1m)	6'-10" (2.1m)
10" 25 MPa	10' 4"-12" (3.0m)	7'-6" (2.3m)	8'-6" (2.6m)	8'-2" (2.5m)
12" 25 MPa	12' 4"-14" (3.5m)	7'-6" (2.3m)	8'-6" (2.6m)	9'-3" (2.8m)
8" 35 MPa	8' 3"-11" (2.5m)	7'-6" (2.3m)	7'-6" (2.3m)	7'-2" (2.2m)
10" 35 MPa	10' 4"-12" (3.0m)	7'-6" (2.3m)	8'-6" (2.6m)	9'-3" (2.8m)
12" 35 MPa	12' 4"-14" (3.5m)	7'-6" (2.3m)	8'-6" (2.6m)	9'-3" (2.8m)
MINIMUM STRIP FOOTING SIZES (9.15.3)				
NUMBER FLOORS SUPPORTED	SUPPORTING INT. LOAD BEARING MASONRY WALL	SUPPORTING EXTERIOR	SUPPORTING PARTIAL WALL	
1	16" M x 6" D	16" M x 6" D	16" M x 6" D	
2	24" M x 8" D	20" M x 6" D	24" M x 8" D	
3	36" M x 14" D	26" M x 9" D	36" M x 14" D	

NOTE: FOOTING SIZE SUBJECT TO CERTIFICATION BY A SOIL CONSULTANT

MASONRY VENEER, 2"x6" STUDS, SLAB ON GRADE / WALK OUT BASEMENT CONDITION

05

1/2" = 1'-0"

06

1/2" = 1'-0"

07

1/2" = 1'-0"

2"x4" P.T. TOP RAIL
2"x4" P.T. RAIL
2"x2" P.T. PICKETS @ 4" O.C. MAX.
4"x4" P.T. MAIN CORNER POSTS
4"x4" P.T. INTERMEDIATE POSTS AT
5'-1" O.C. MAXIMUM

NOTE: ALL METAL FASTENERS
SHALL BE NON-CORROSIVE.

2"x4" P.T. BOTTOM RAIL
2"x4" P.T. DECKING LAID
PERPENDICULAR TO JOISTS 1/4"
APART
2"x8" P.T. RIM BOARD

2"x8" P.T. BLOCKING AT POSTS
CONNECTION
2"x8" P.T. JOISTS @ 16" O.C.
P.T. BEAM AS PER PLANS TIED TO TOP
OF 6"x6" P.T. POSTS TIED TO TOP OF
12"x9" 15MPa POURED CONC. PIER WITH
NON-CORROSIVE METAL SHOE

POSTS TIED TO METAL SHOE
ANCHOR WITH 4-5/8" MACHINE BOLTS
1/2" 6 NON-CORROSIVE ANCHOR 4"
MINIMUM INTO CONCRETE

TYPICAL FOUNDATION WALL
CONSTRUCTION

FINISHED GRADE

TYPICAL BRICK VENEER WALL CONSTRUCTION

FIRST FLOOR

MINIMUM 2"x4" SILL PLATE (2"x6" AS REQ.) TIED TO TOP OF POURED
CONC. FND. WALL WITH 6" LONG 1/2" ANCHOR BOLTS C/W NUT AND
WASHER WITH 2 1/2" HOOK. ANCHOR BOLTS TO BE SPACED NOT
MORE THAN 7'-10" O.C. AND EMBEDDED NOT LESS THAN 4" INTO
CONC. PROVIDE SILL GASKET BETWEEN PLATE AND FOUNDATION
WALL. PROVIDE NON-SHRINK GROUT TO LEVEL PLATE.

TYPICAL FLOOR CONSTRUCTION

BASE FLASHING CONFORMING TO TABLE 9.20.13.1 TO EXTEND 3/16"
BEYOND OUTER FACE OF FOUNDATION WALL, TIED TO EXT. SHEATHING
UNDER AIR/WATER BARRIER. PROVIDE 6" MINIMUM LAP JOINT.

JOISTS TO BEAR ON DOUBLE 2"x8" P.T. RIM BOARD,
RIM BOARD TIED TO FOUNDATION WALL WITH 5/8" 6
GALV. MACHINE BOLTS @ 16" O.C. STAGGERED. BRICK
VENEER SHALL NOT BE LOAD BEARING

TIE BRICK VENEER TO FOUNDATION WALL WITH CORROSION
RESISTANT METAL TIES @ 8" VERTICAL AND 2'-11" HORIZONTAL
- FILL VOID WITH MORTAR BETWEEN WALL AND BRICK
VENEER-SEE OBC 9.20.9.4(3)

TAPE AND SEAL BLANKETS AT ALL JOINTS

INSULATION BLANKET OR BATTS W/ REQUIRED BASEMENT WALL R-VALUE,
6 MIL POLYETHYLENE VAPOUR BARRIER DAMPPROOF WITH AIR/WATER
BARRIER BETWEEN THE FOUNDATION WALL AND INSULATION UP TO
GRADE LEVEL. TERMINATE BLANKETS ABOVE SLAB AS REQUIRED BY
O.B.C. OR ENERGY DESIGN CONSULTANT

SECURE METAL BLANKET TIE TO FOUNDATION
WALL AS PER MANUF. INSTRUCTIONS

UNFINISHED BASEMENT

WHERE HEIGHT OF REDUCTION IN WALL THICKNESS
EXCEEDS 2'-0", REINFORCE FOUNDATION WALL W/
15M BARS @ 300mm EACH WAY.

07

MASONRY VENEER, TYPICAL WALK/LOOK OUT WOOD DECK, SOLID MASONRY

1/2" = 1'-0"

JOISTS TO BEAR ON DOUBLE 2"x8" P.T. RIM BOARD.
RIM BOARD TIED TO FOUNDATION WALL WITH 5/8" 6
GALV. MACHINE BOLTS @ 16" O.C. STAGGERED. BRICK
VENEER SHALL NOT BE LOAD BEARING

NOTE: ALL METAL FASTENERS
SHALL BE NON-CORROSIVE.

VARIES - REFER TO FLOOR PLANS

POST SPACING AS PER PLANS

2"x8" P.T. RIM JOIST TIED TO 4"x4" P.T.
POSTS WITH 4-#10X3" SCREWS PER SIDE
(DO TYPICAL) (O.B.C. SB-1 DETAIL EB-2)

2"x4" P.T. CROSS BRACING WITH 2-5"
SPIRAL NAILS AT EACH JOIST
2"x8" P.T. BLOCKING BETWEEN JOISTS
DOUBLE 2"x8" P.T. RIM BOARD BELOW

P.T. BEAM AS PER PLANS
2"x8" P.T. BLOCKING
4-#10X3" SCREWS EACH SIDE
(O.B.C. SB-1 DETAIL EB-2)

4"x4" P.T. INTERMEDIATE POST
2"x8" P.T. RIM JOIST TIED TO 2"x8" P.T.
FLOOR JOISTS @ 16" O.C. WITH 3-4"
SPIRAL NAILS (DO TYPICAL)

2"x4" P.T. DECKING NAILED PERPENDICULAR
TO JOISTS WITH 2-5" SPIRAL NAILS AT EACH
JOIST-LAY DECKING 1/4" APART
TYPICAL FLOOR CONSTRUCTION

PLAN

TYPICAL BRICK VENEER WALL
CONSTRUCTION

GENERAL NOTES

- ALL CONSTRUCTION SHALL BE IN ACCORDANCE WITH THE O.B.C. AND SB-1 OF THE SUPPLEMENTARY STANDARD
- LUMBER GRADES SHALL NOT BE LESS THAN NO. 2 SPF. LUMBER SHALL BE FREE OF LOOSE KNOTS AND ALL CUT ENDS OF PRESERVATIVE TREATED LUMBER SHALL BE TREATED TO PREVENT DECAY. SPECIES FOR POSTS, PICKETS AND RAILS SHALL BE DOUGLAS FIR-LARCH, HEM-FIR, SPRUCE-PINE-FIR
- ALL FASTENERS, SCREWS AND NAILS SHALL BE RESISTANT TO CORROSION - NAILS TO BE COMMON SPIRAL

08

TYP. DECK FRAMING ON WOOD LEDGER, BRICK VENEER

1/2" = 1'-0"




DECK DETAILS 2

UNIT 4002 - THE VALLEYVIEW
REV. 2018/09/18


GOLDPARK HOMES - 217020
PINE VALLEY, VAUGHAN ONT.

Drawn By: HDAL, Checked By: HDAL, Scale: 3/16"=1'-0", Title: 4002-DECK DETAILS, Page Number: W5 of W7
8966 Woodbine Ave, Markham, ON L3R 0J7 // T 905.737.5133 // F 905.737.7326


HUNT
DESIGN ASSOCIATES INC.
www.hunt-design.ca

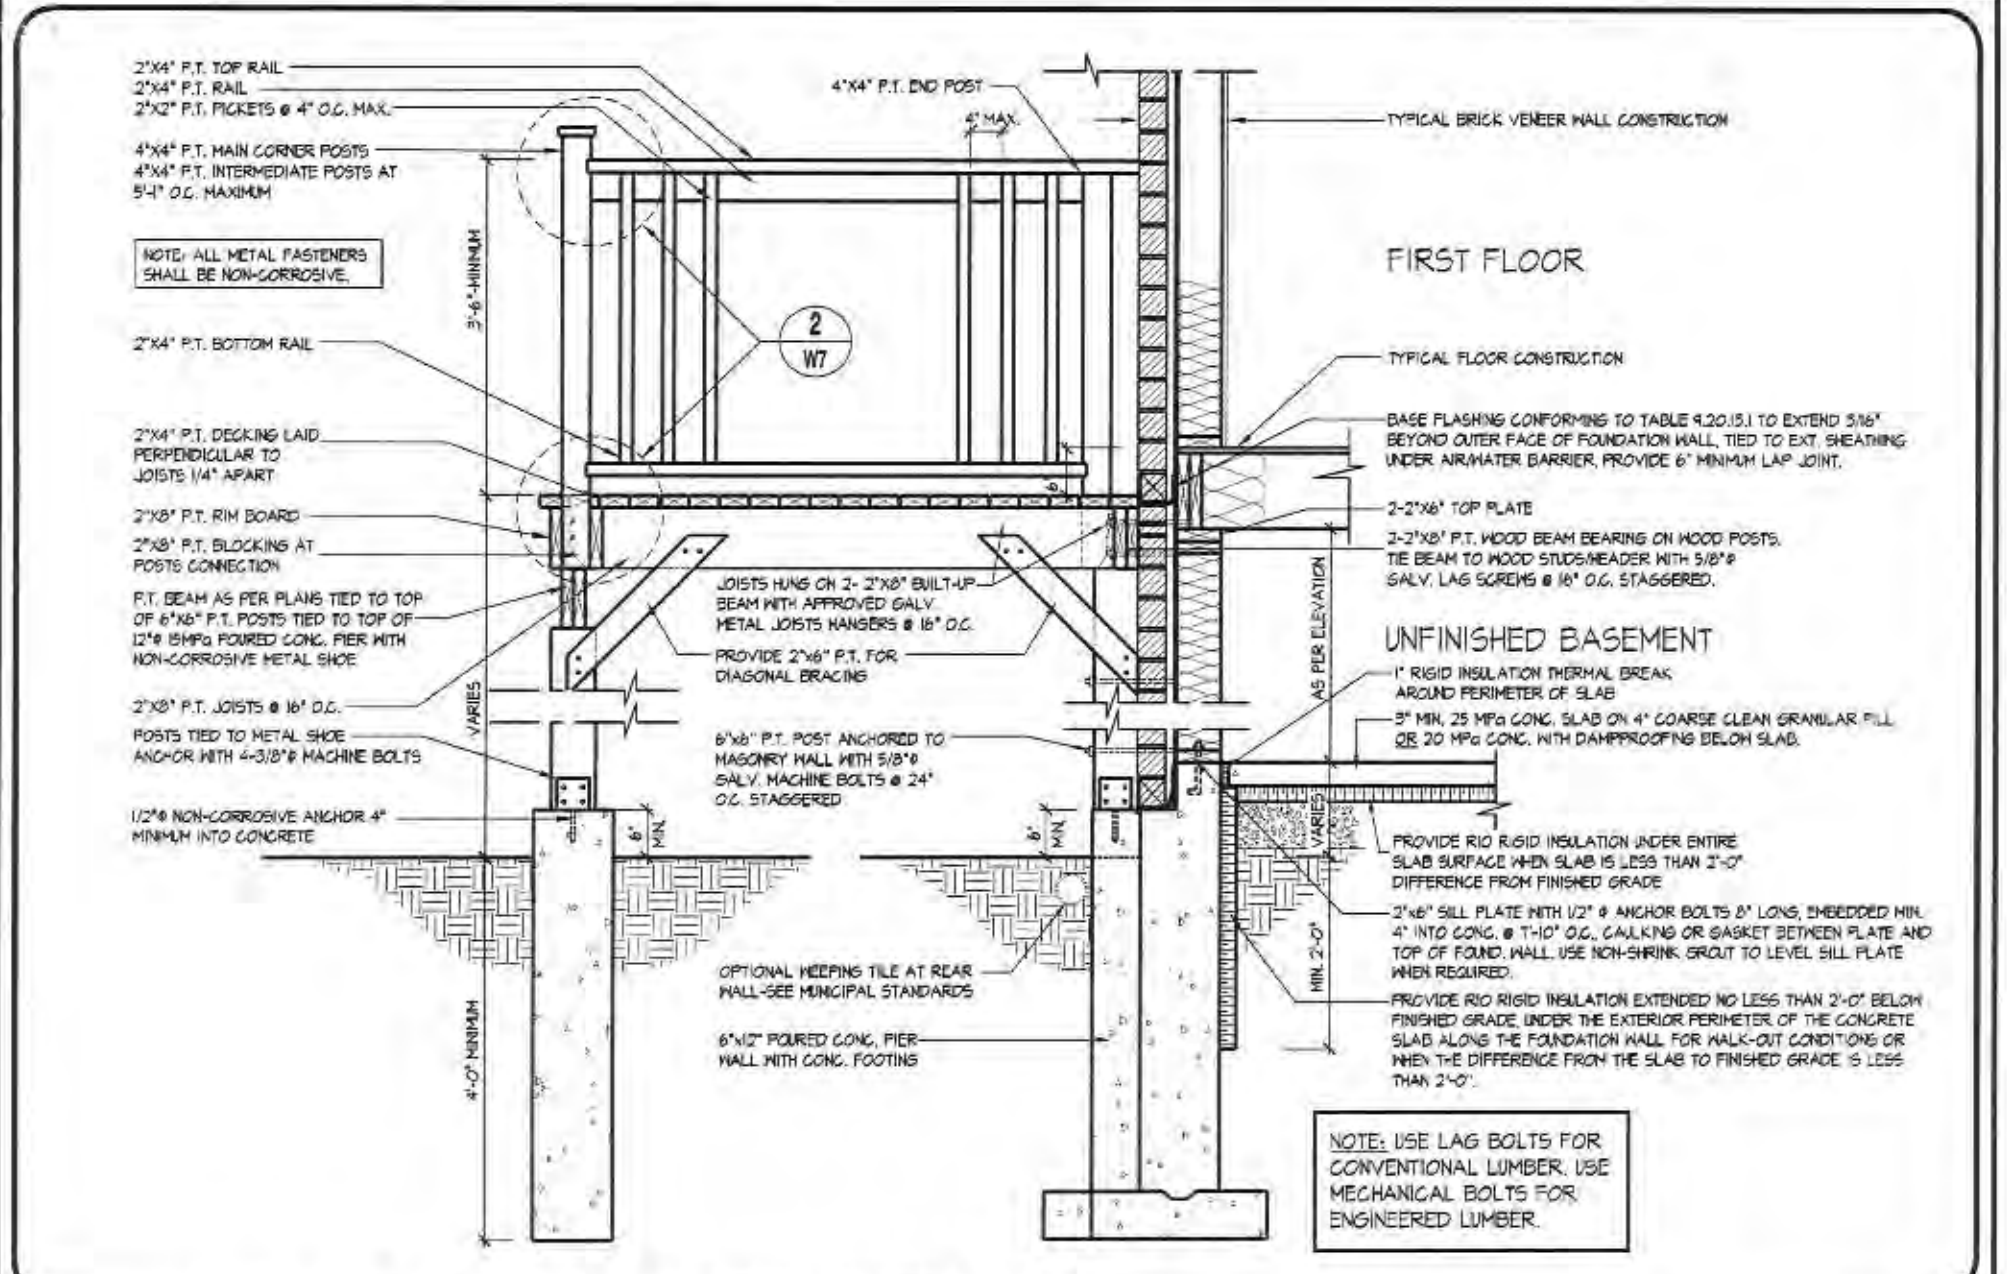

09 MASONRY VENEER, TYPICAL WOOD DECK FOR WALK OUT BASEMENT
1/2" = 1'-0"

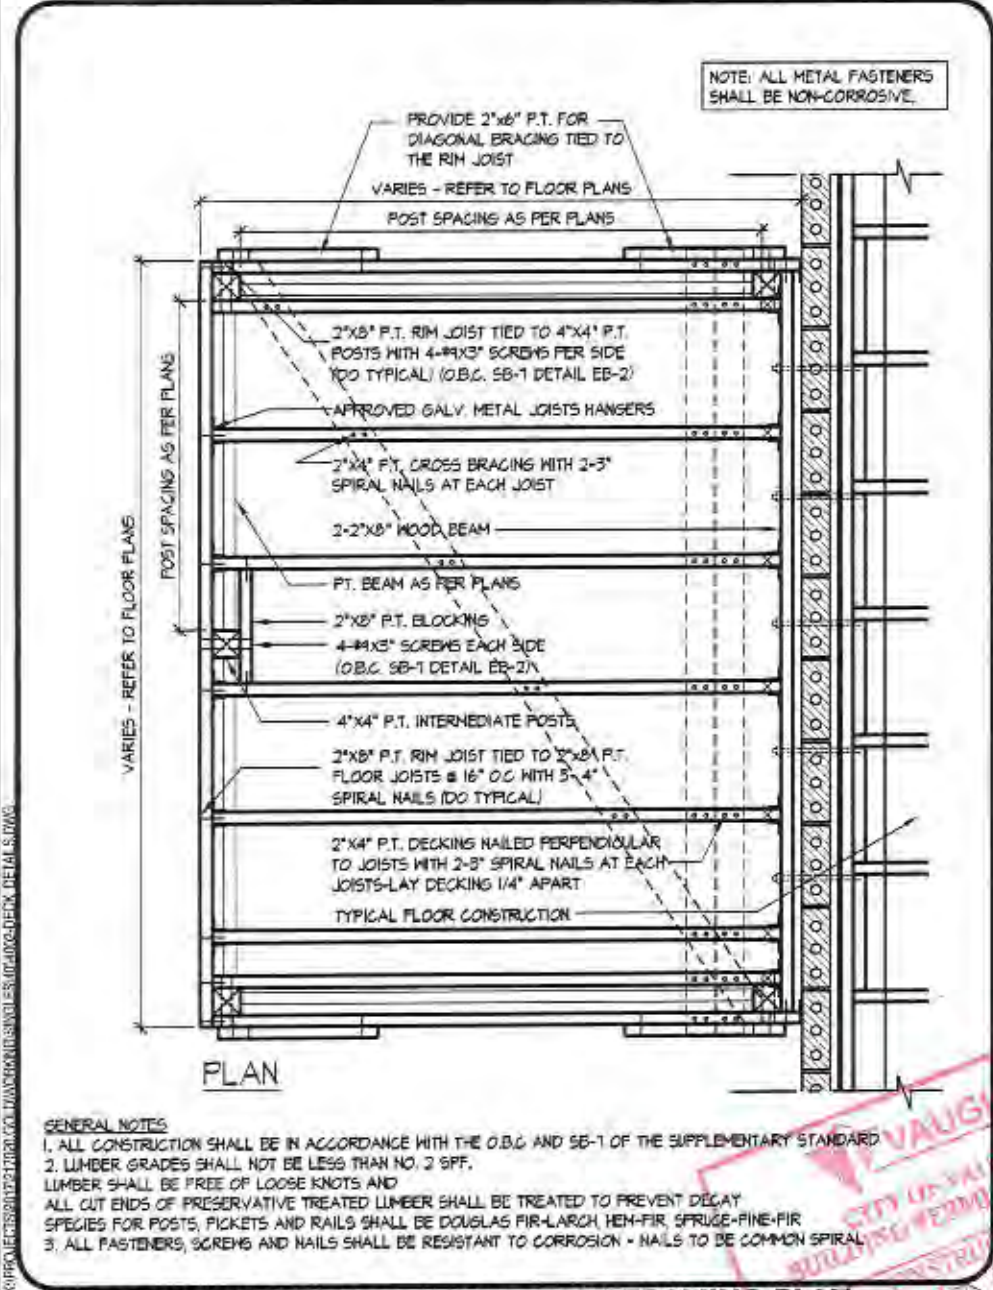

10 MASONRY VENEER, TYPICAL DECK FRAMING PLAN
1/2" = 1'-0"

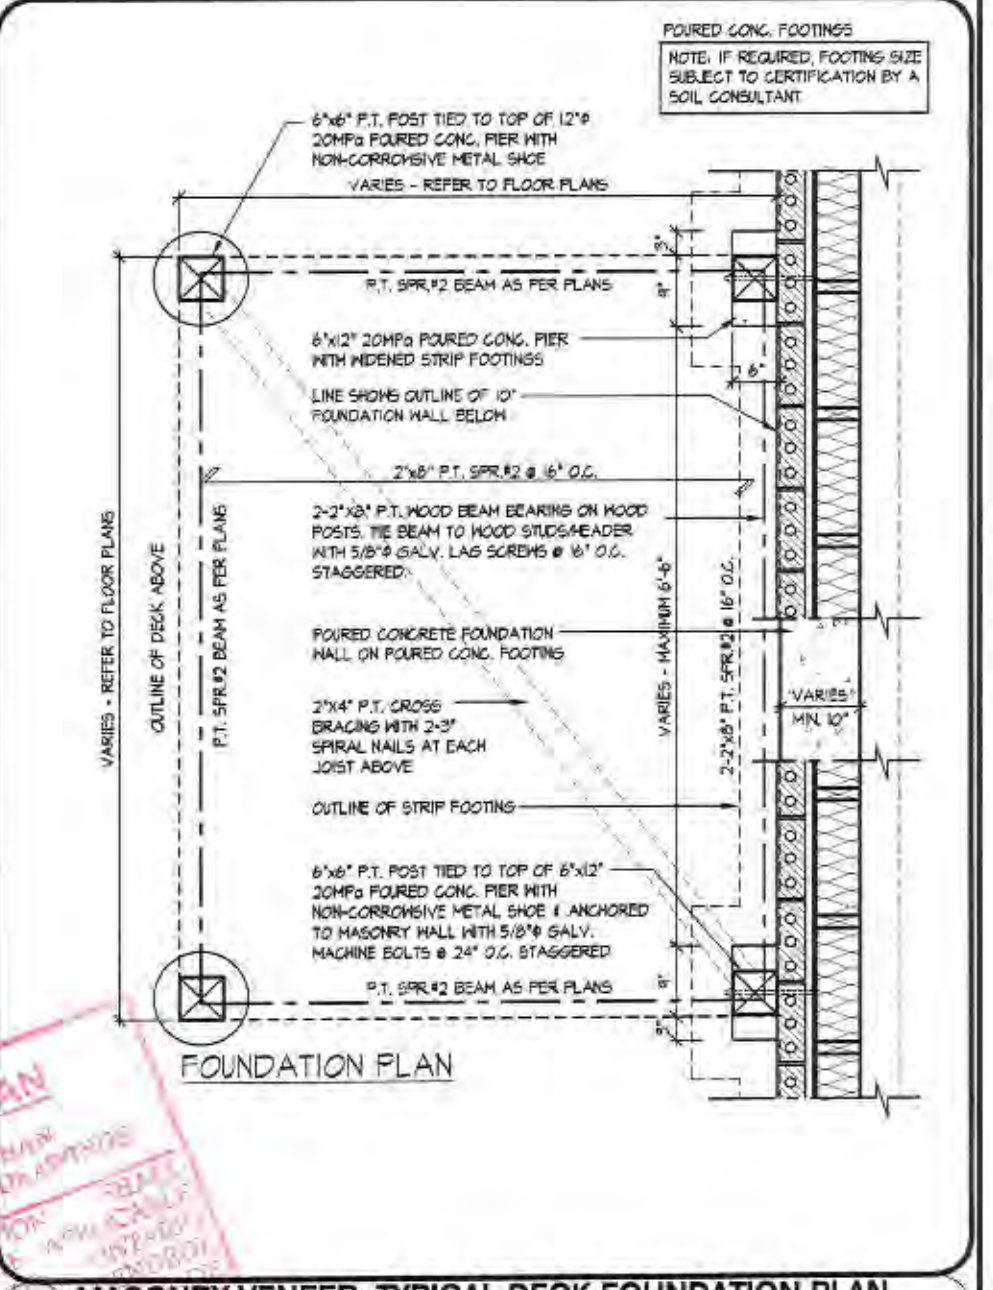

11 MASONRY VENEER, TYPICAL DECK FOUNDATION PLAN
1/2" = 1'-0"

GENERAL NOTES

1. ALL CONSTRUCTION SHALL BE IN ACCORDANCE WITH THE O.B.C. AND SB-1 OF THE SUPPLEMENTARY STANDARD
2. LUMBER GRADES SHALL NOT BE LESS THAN NO. 2 SPF.
3. ALL FASTENERS, SCREWS AND NAILS SHALL BE RESISTANT TO CORROSION - NAILS TO BE COMMON SPIRAL

DECK DETAILS 3

GOLDPARK HOMES - 217020
PINE VALLEY, VAUGHAN ONT.

UNIT 4002 - THE VALLEYVIEW
REV. 2018/09/18


Drawn By: HDAL Checked By: HDAL Scale: 3/16"=1'-0" File Number: 4002-DECK DETAILS Page Number: W8 of W7

8966 Woodbine Ave., Markham, ON L3R 0J7 // T 905.737.5133 // F 905.737.7326

LICENSED PROFESSIONAL ENGINEER
A. KONG
100184942
PROVINCE OF ONTARIO


HUNT DESIGN ASSOCIATES INC.
www.huntdesign.ca

NOTE: ALL METAL FASTENERS SHALL BE NON-CORROSIVE.

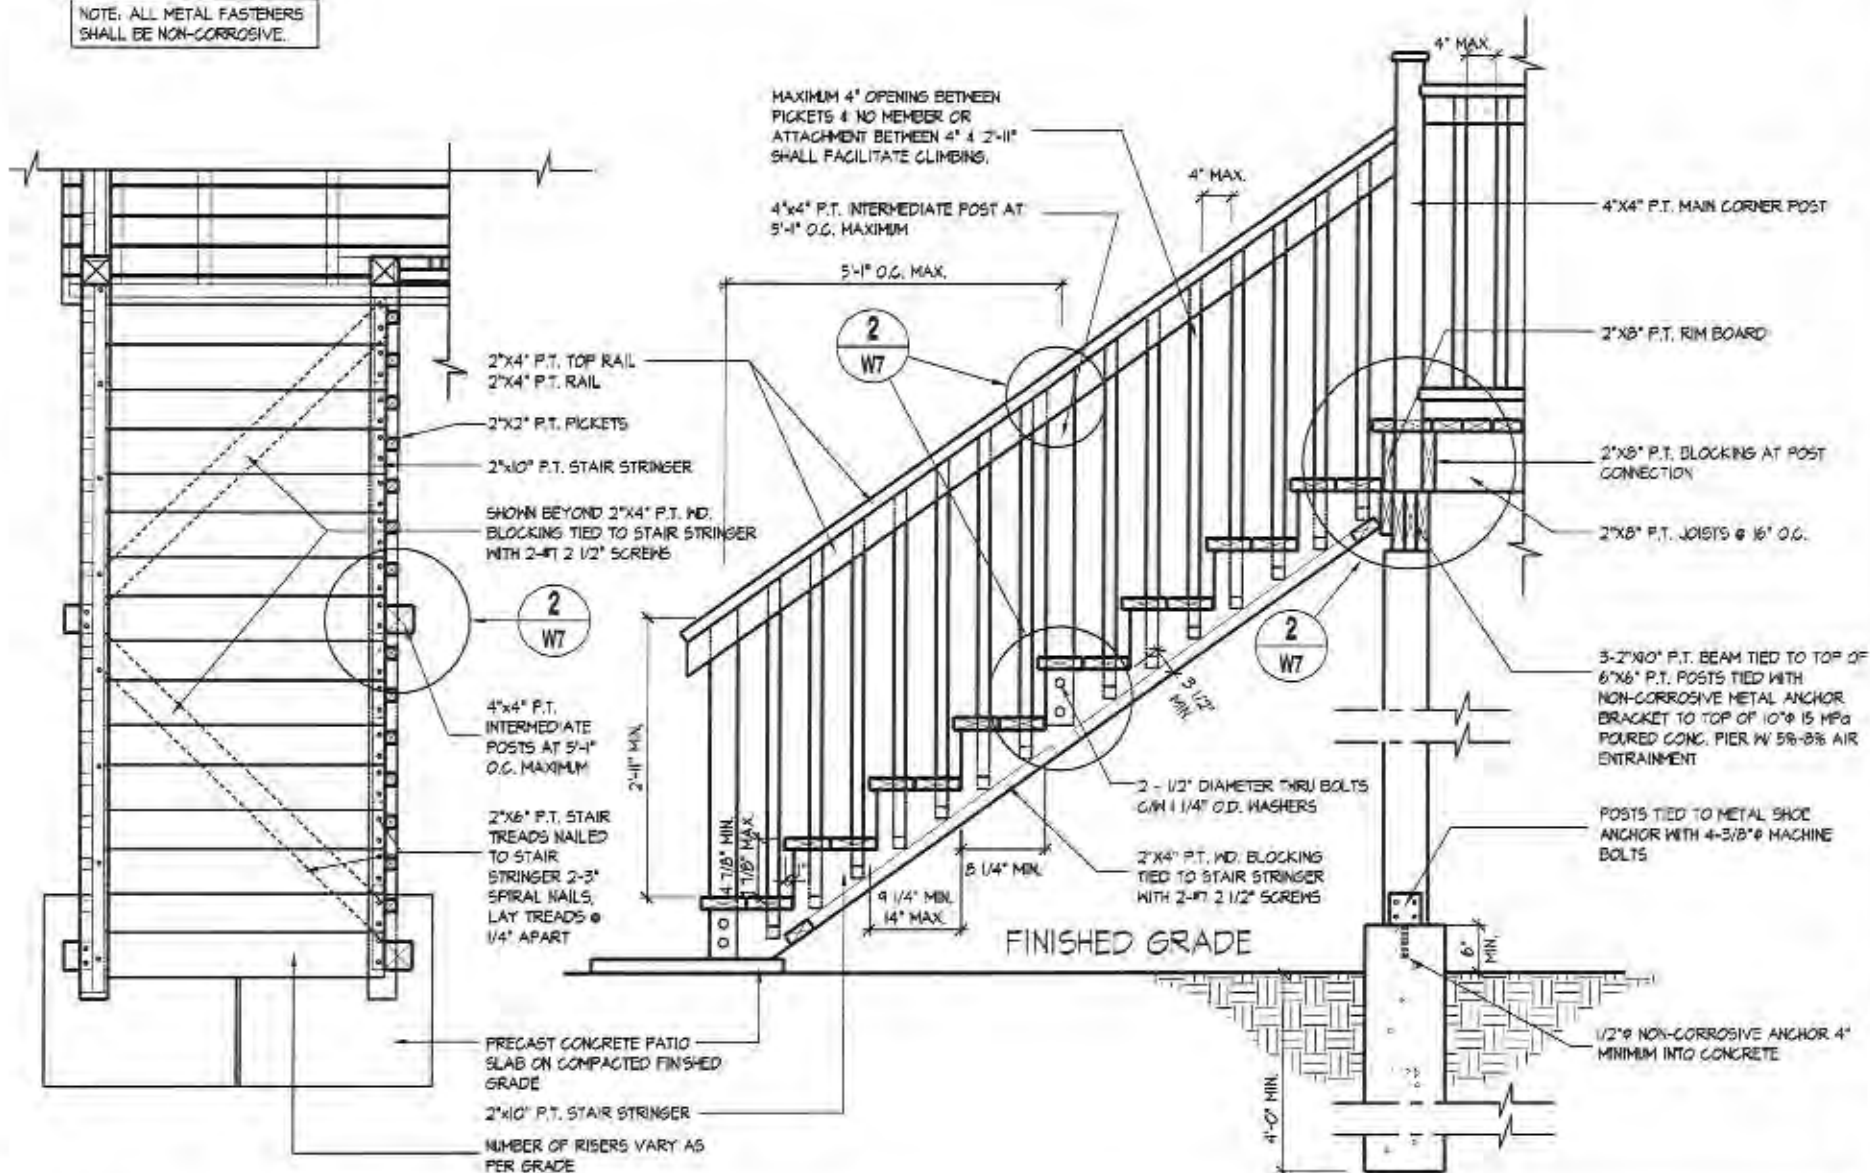


01 TYPICAL WOOD DECK STAIR

1/2" = 1'-0"

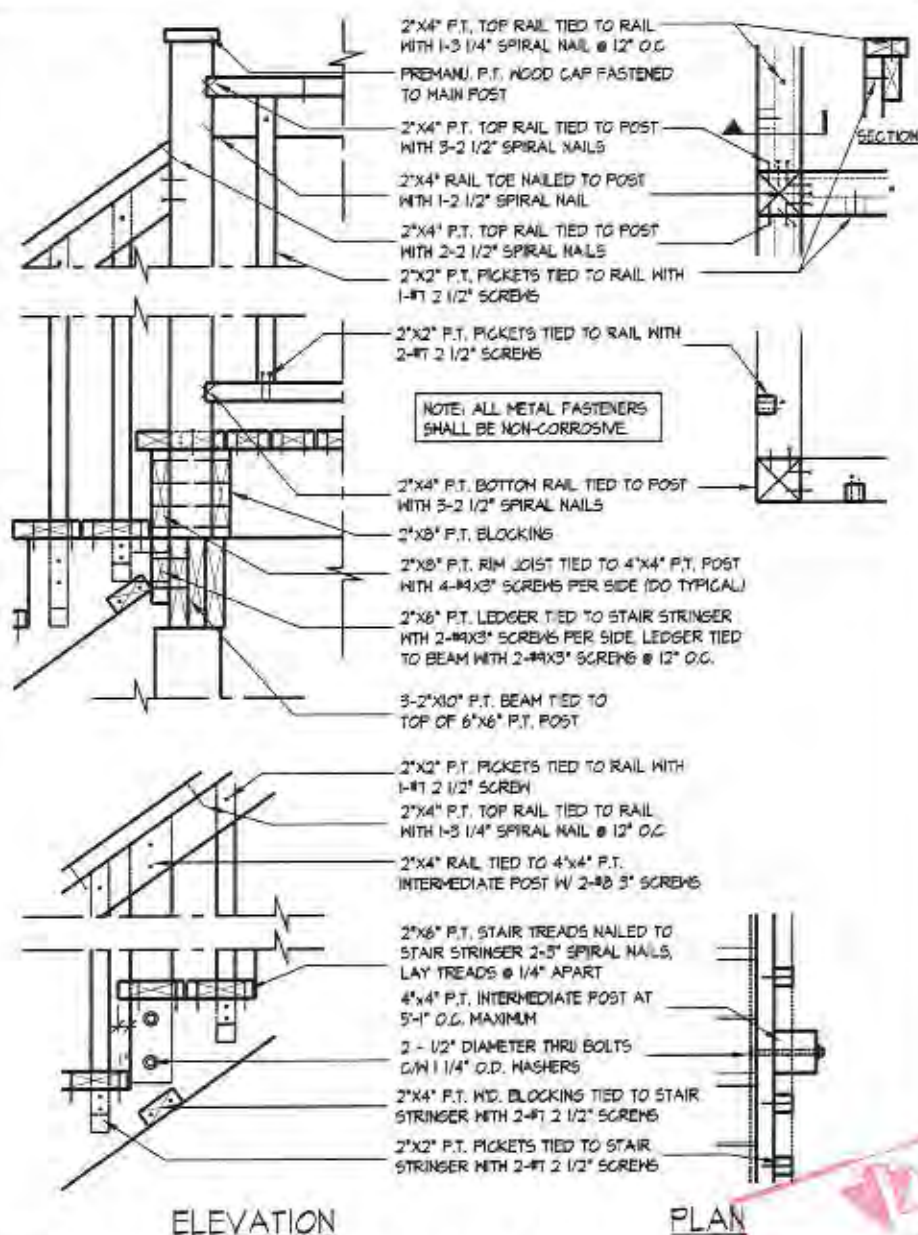

02 TYP. MAIN AND INTERMEDIATE POST ANCHORAGE

3/4" = 1'-0"

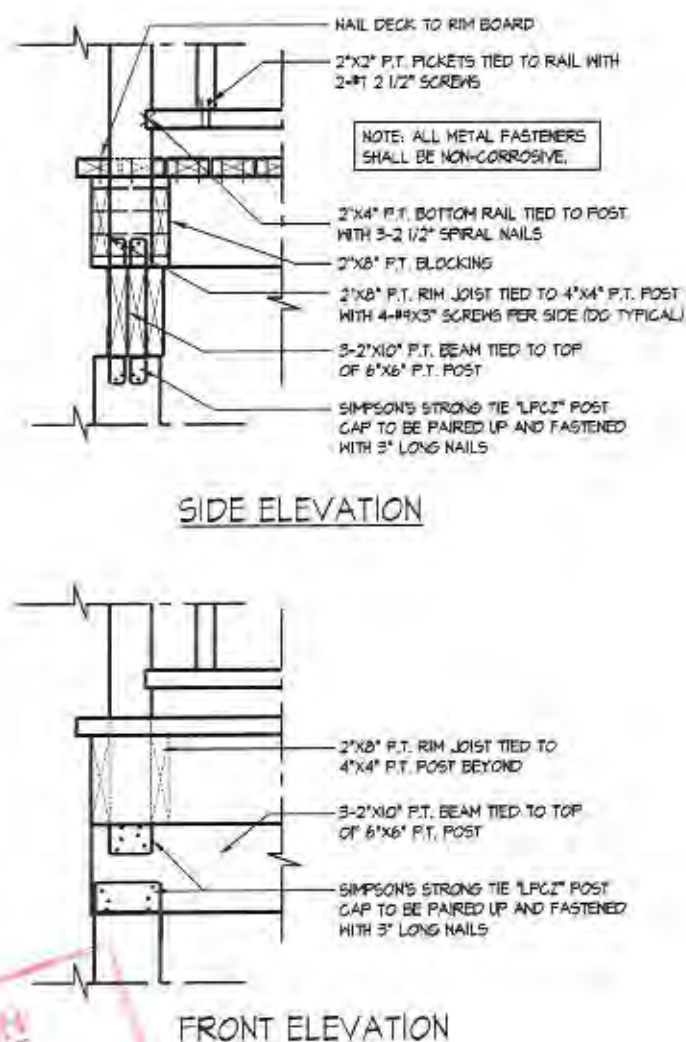

03 TYP. POST & BEAM CONNECTION

3/4" = 1'-0"



HUNT DESIGN ASSOCIATES INC.
www.hunt-design.com

GOLDPAC HOMES - 217020
PINE VALLEY, VAUGHAN ONT.

UNIT 4002 - THE VALLEYVIEW
REV. 2018/09/18

Drawn By: HDAL, Checked By: HDAL, Scale: 3/16" = 1'-0", File Number: 4002-DECK_DETAILS, Page Number: W7 of W7
8966 Woodbine Ave, Markham, ON L3R 0J7 // T 905.737.5133 // F 905.737.7326

