



Lot: 128

Model: 40.08 A HILLSDALE

Project/Phase: Pine Valley Forevergreen / 1

CONCRETE AND DRAIN

Invoice	Qty.	Description
2207 31291	1	BACK-FLOW PREVENTER VALVE
18Mar20 NoCat		CONCRETE AND DRAIN

ELECTRICAL APPLIANCES

Invoice	Qty.	Description
2285 32272	1	KITCHEN: 110V WALL RECEPTACLE ON SEPARATE CIRCUIT - GAS FIRED APPLIANCE - FOR AUX. EQUIPMENT - NOT A STOVE PLUG FOR GAS COOKTOP
17Apr20		ELECTRICAL APPLIANCES 72,273

ELECTRICAL INTERIOR

Invoice	Qty.	Description
2285 32261 17Apr20	1	GREAT ROOM: INTERIOR WALL OUTLET; ADDITIONAL 110V WALL INTERIOR RECEPTACLE ON EXISTING CIRCUIT FOR WALL MOUNTED TV - LOCATE APPROX. 66" A.F.F. ABOVE FIREPLACE ELECTRICAL INTERIOR 72,281
2285 32263 17Apr20	1	KITCHEN: FIXTURE: RELOCATE STANDARD CEILING MOUNT FIXTURE - LOCATE ABOVE ISLAND, SEE PLAN FOR LOCATION ELECTRICAL INTERIOR 72,307

ELECTRICAL POTLIGHT

Invoice	Qty.	Description	
2285 32270	6	KITCHEN/BREAKFAST: 4" E/S LED INTERIOR POT LIGHT - GROUND FLOOR - EACH	
17Apr20		ELECTRICAL POTLIGHT INCLUDED IN APS	72,289

ELECTRICAL ROUGH-IN

Invoice	Qty.	Description
2285 32262	1	KITCHEN: ROUGH-IN FOR CAPPED CEILING OUTLET (FUTURE LIGHT FIXTURE) - EACH - LOCATE ABOVE ISLAND, USE SAME SWITCH AS STANDARD LIGHT. SEE PLAN FOR LOCATION
17Apr20		ELECTRICAL ROUGH-IN 72,667

ELECTRICAL SWITCH

Invoice	Qty.	Description
2285 32268	1	KITCHEN: ADDITIONAL INTERIOR SWITCH
17Apr20		ELECTRICAL SWITCH FOR POTLIGHTS
		72,278



SCHEDULE 'F'

PV-128


April 13 2020

per attached see attached

The Hillsdale

40' SERIES

→ Elevation A • 2,745 sq.ft.
Elevation B • 2,760 sq.ft.

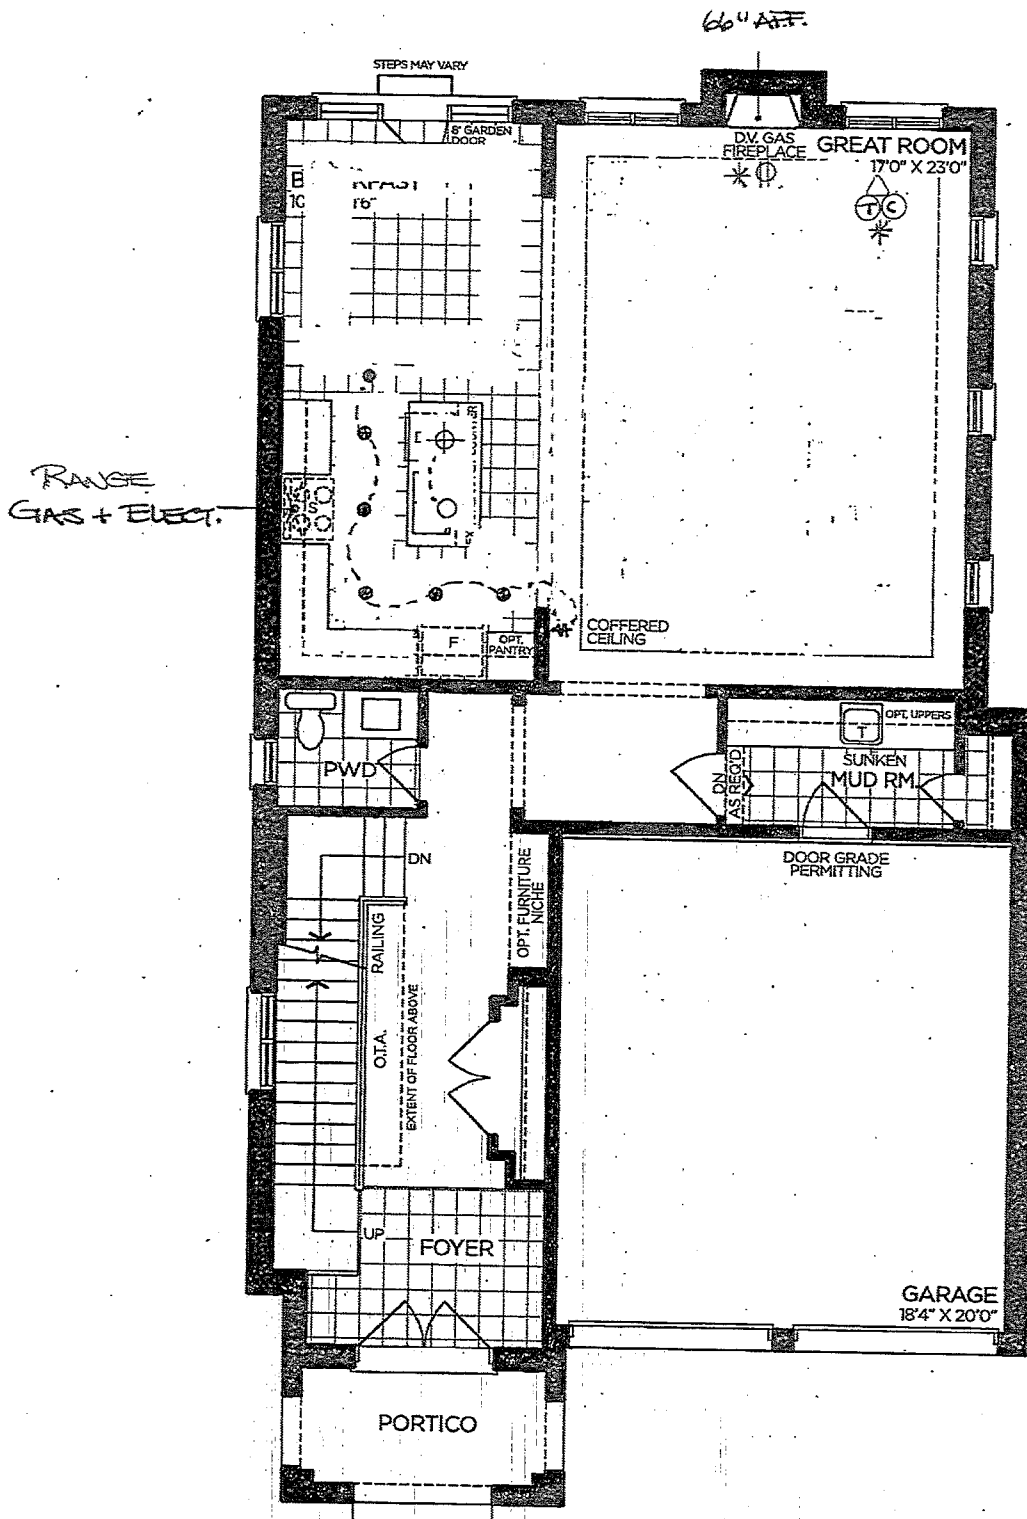

GROUND FLOOR | ELEV. A

VENDOR

PURCHASER

PURCHASER

GOLDPARK

WORTH MORE™

Prices, figures, illustrations, sizes, features and finishes are subject to change without notice. Areas and dimensions are approximate and actual usable floor space may vary from the stated area. Layout may be reverse of the unit purchased. E. & O.E. 4008

SCHEDULE 'F'




PV-128
April 13 2022

see attached
see attached

The Hillsdale

40' SERIES

Elevation A • 2,745 sq.ft.
Elevation B • 2,760 sq.ft.

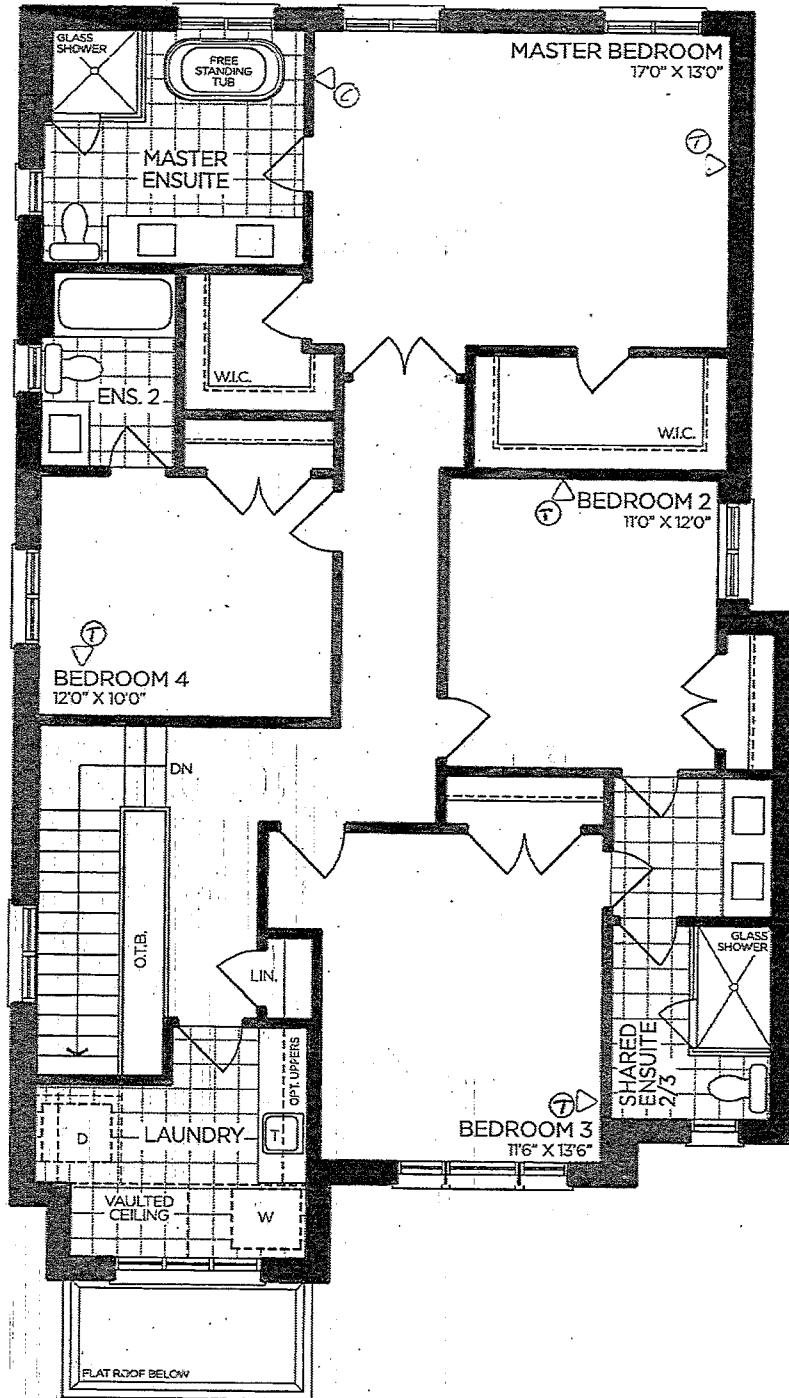

SECOND FLOOR | ELEV. A

VENDOR

PURCHASER

PURCHASER

GOLDPARK

WORTH MORE™

Prices, figures, illustrations, sizes, features and finishes are subject to change without notice. Areas and dimensions are approximate and actual usable floor space may vary from the stated area. Layout may be reverse of the unit purchased. E. & O.E. 4008

SCHEDULE 'F'




PV-128
APRIL 13 2020

see attached see attached

The
Hillsdale
40' SERIES

→ Elevation A • 2,745 sq.ft.
Elevation B • 2,760 sq.ft.

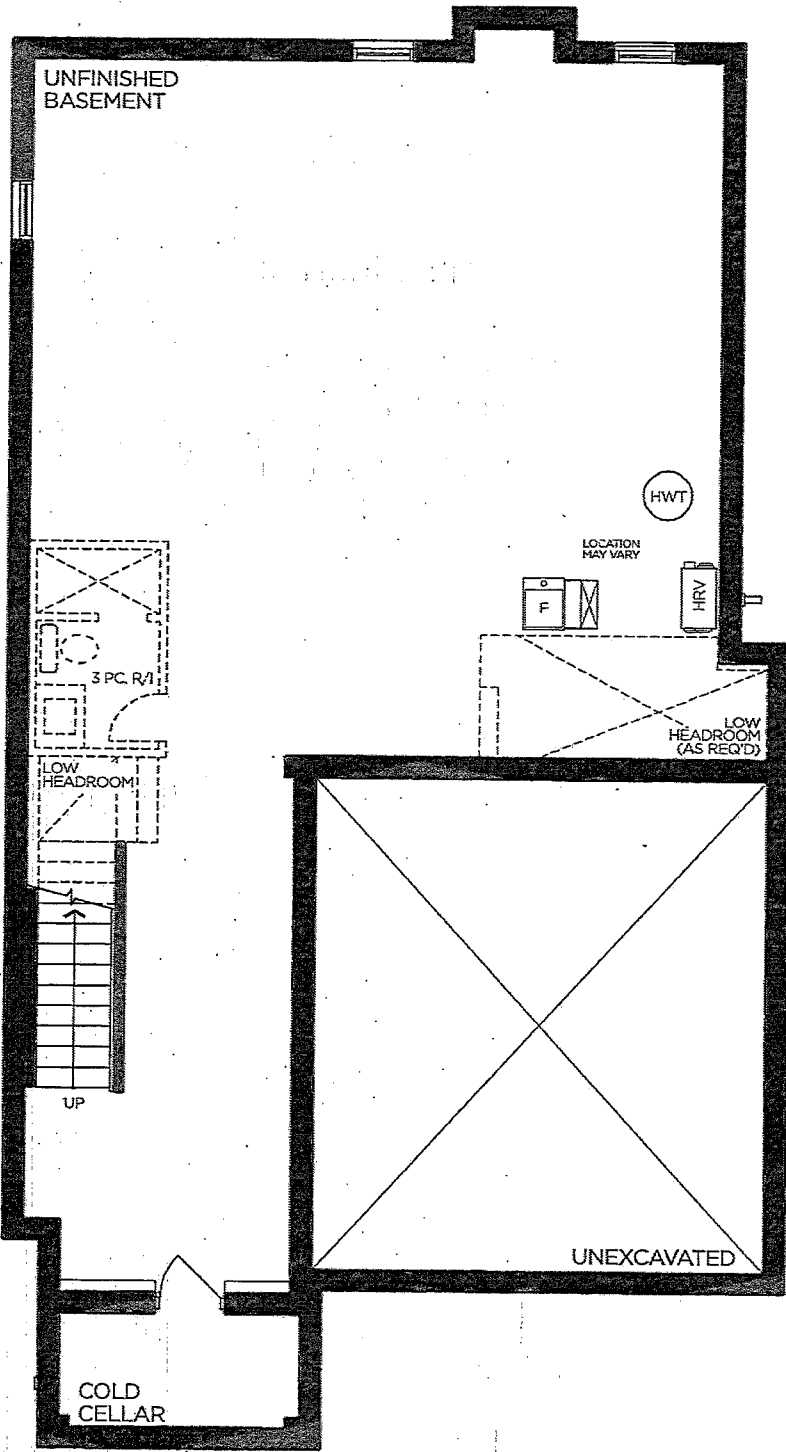

BASEMENT | ELEV. A

VENDOR	
PURCHASER	
PURCHASER	

GOLDPARK
WORTH MORE™

Prices, figures, illustrations, sizes, features and finishes are subject to change without notice. Areas and dimensions are approximate and actual usable floor space may vary from the stated area. Layout may be reverse of the unit purchased. E. & O.E. 4008

SCHEDULE 'F'


PINE VALLEY
HILLSDALE

TV-128
APRIL 15 2020

L.H.
3-5

The
Hillsdale
40' SERIES

Elevation A - 2,745 sq.ft.
Elevation B - 2,760 sq.ft.

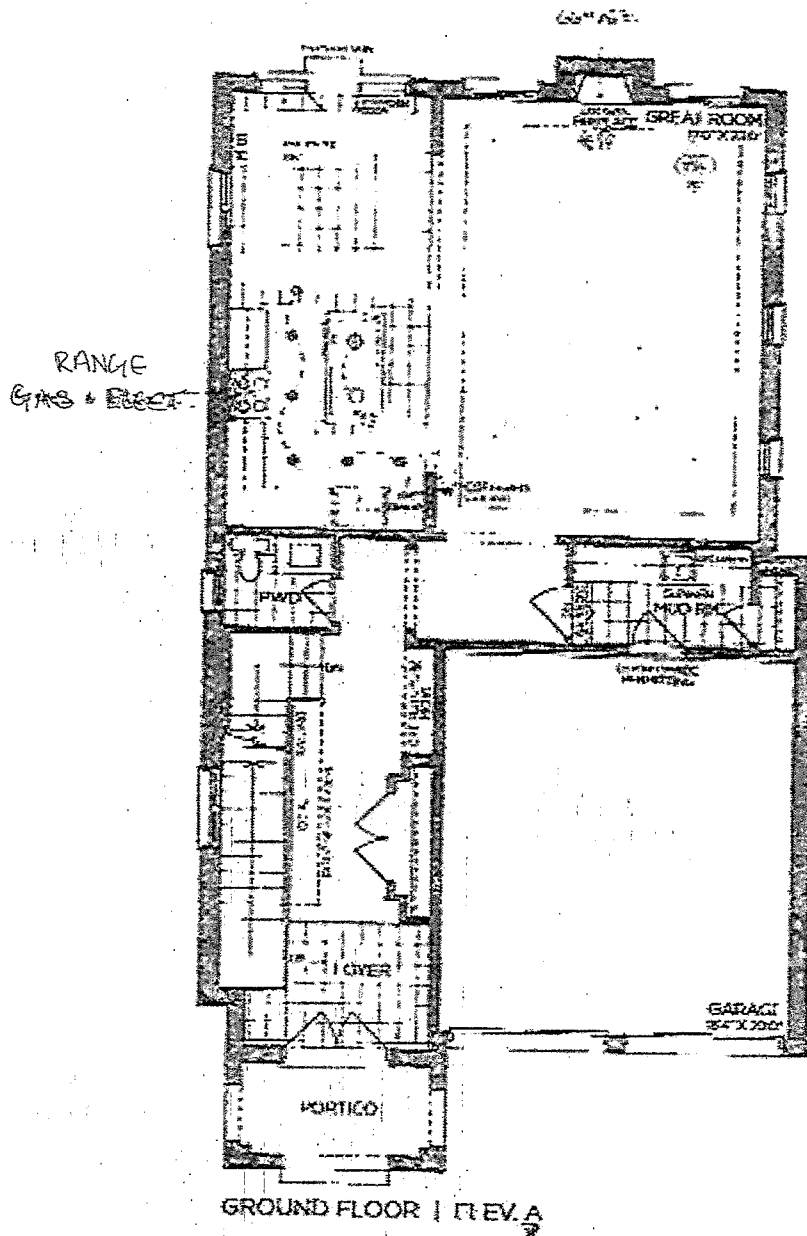

VENDOR
PURCHASER
PURCHASER

GOLDPARK
WORK MORE

These Square Footage, Room, Features and Colors are subject to change without notice. Approved dimensions are approximate and actual square foot may vary. Some the dimensions shown may be source of the unit purchased. L. & D.E. 2020

SCHEDULE 'F'




IN-1283
April 13, 2023

L.M.
B.S.

The Hillsdale

40' SERIES

→ Elevation A - 2,745 sq.ft.
Elevation B - 2,760 sq.ft.

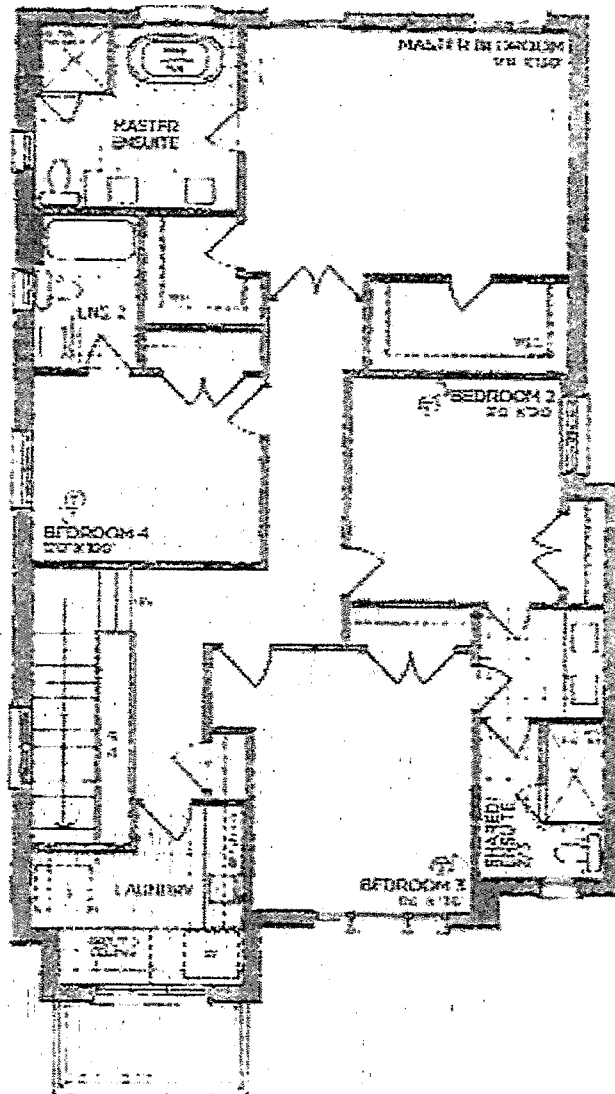

SECOND FLOOR | ELEV. A

VENDOR
PURCHASER
PURCHASER

GOLD

WORLD AGENT

Notes: Buyer to obtain all local, state, and federal permits for all work. Seller to provide all necessary permits and licenses. Buyer to obtain all necessary permits and licenses. Seller to provide all necessary permits and licenses. Buyer to obtain all necessary permits and licenses. Seller to provide all necessary permits and licenses.

SCHEDULE 'H'


PINE VALLEY
CALIFORNIA

PL 128
APRIL 13 1972

L.H.
B-S.

The
Hillsdale
40' SERIES

→ Elevation A - 2,745 sq. ft.
Elevation B - 2,750 sq. ft.

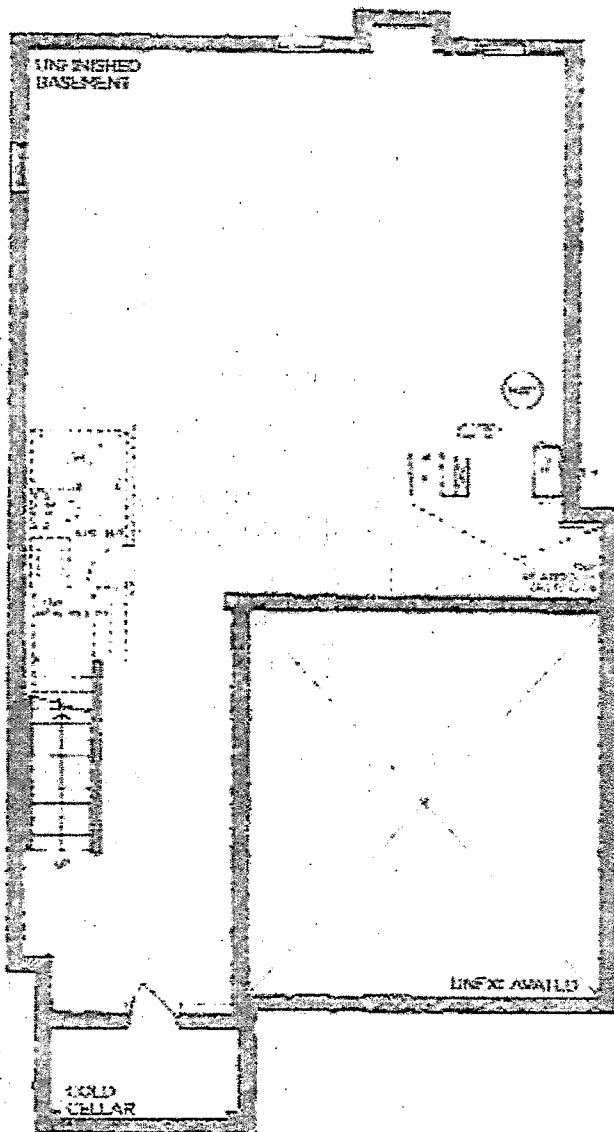

BASEMENT | ELEV. A

VENUE
PURCHASER
PURCHASER

GOLD

1000TH 10000

This is a preliminary drawing and is not to be used for construction purposes. It is subject to change without notice. The purchaser is responsible for obtaining all necessary permits and approvals from the local authorities.