

CONCRETE AND DRAIN

Invoice	Qty.	Description
2288 32304 NoCat	1	BACK-FLOW PREVENTER VALVE CONCRETE AND DRAIN

WINDOWS - BASEMENT

Invoice	Qty.	Description
2288 32302	2	BASEMENT WINDOWS - EGRESS BASEMENT WINDOW 47 " X 35"- 8" FRAME WINDOWS - BASEMENT 72,672 WINDOWS - BASEMENT
2288 32303	2	BASEMENT WINDOWS - UPGRADE BASEMENT WINDOW SIZE TO 30 " X 24" - 8" FRAME WINDOWS - BASEMENT 72,351 WINDOWS - BASEMENT
2288 32303	2	BASEMENT WINDOWS -UPGRADE BASEMENT WINDOW SIZE TO 30 " X 24" - 8" FRAME WINDOWS -BASEMENT 72,351 WINDOWS - BASEMENT

This Document is Extremely Time Sensitive - Printed 20 Apr 20 at 8:35

SCHEDULE 'F'




PV-130
APRIL 14 2020
*80 attached
see attached*

The Valleyview

40' SERIES

→ Elevation A • 3,145 sq.ft.
Elevation B • 3,170 sq.ft.

No!

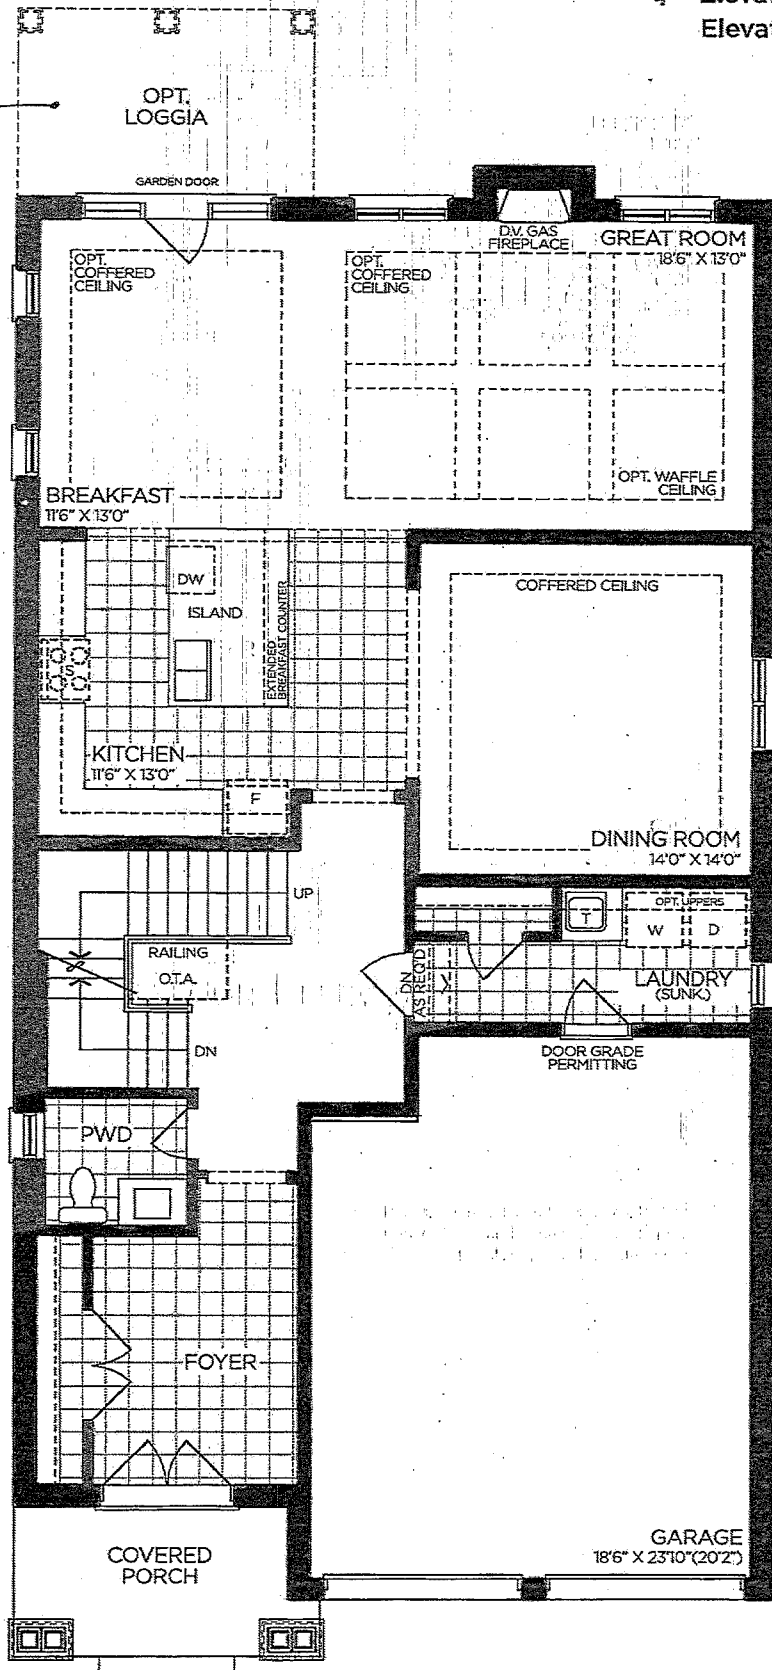

GROUND FLOOR | ELEV. A

VENDOR

PURCHASER

PURCHASER

GOLDPARK

WORTH MORE™

Prices, figures, illustrations, sizes, features and finishes are subject to change without notice. Areas and dimensions are approximate and actual usable floor space may vary from the stated area. Layout may be reverse of the unit purchased. E. & O.E. 4002




SCHEDULE 'F'

PL 130
APRIL 14 2020

see attached
see attached

The Valleyview 40' SERIES

→ Elevation A • 3,145 sq.ft.
Elevation B • 3,170 sq.ft.

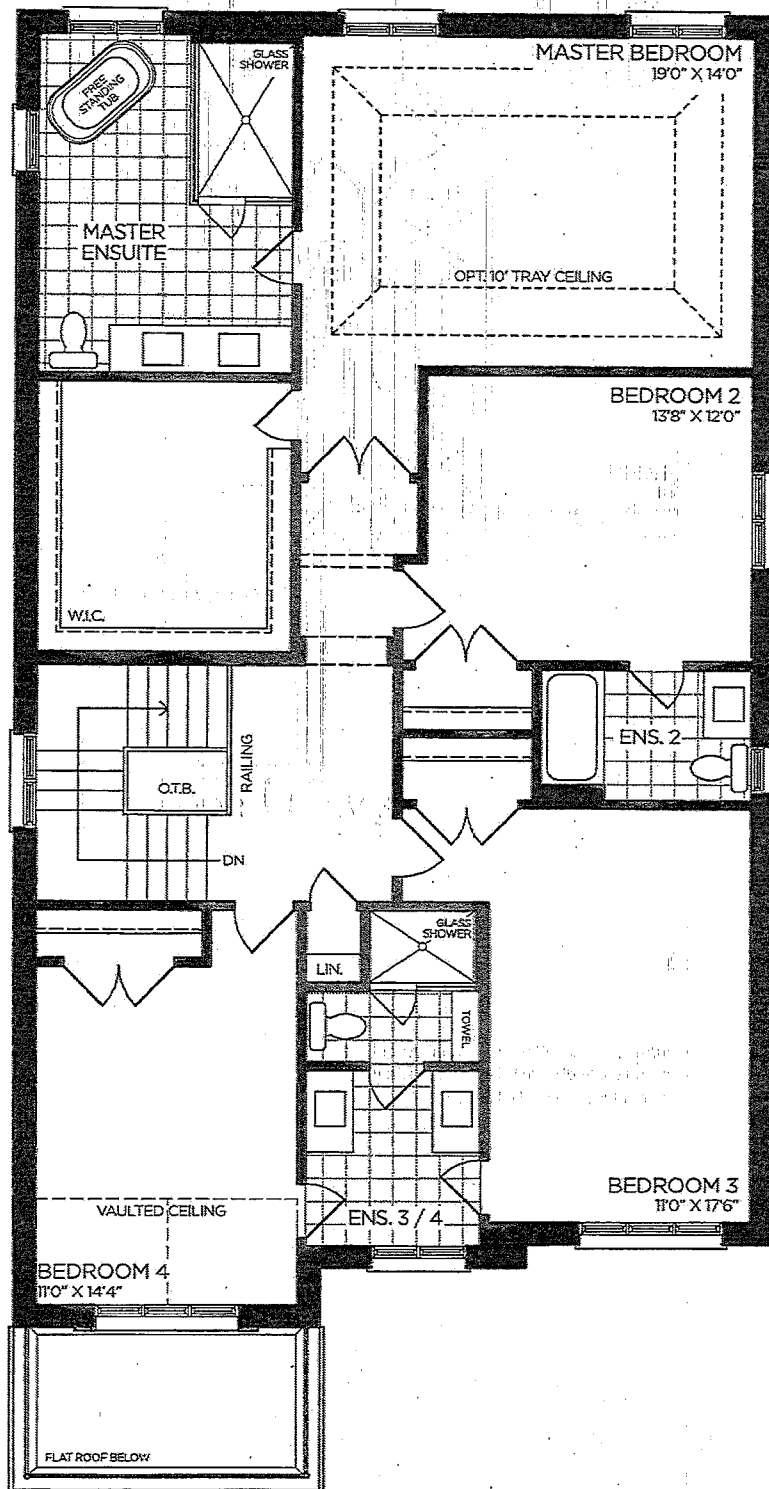

SECOND FLOOR | ELEV. A

VENDOR	
PURCHASER	
PURCHASER	

GOLDPARK
WORTH MORE™

Prices, figures, illustrations, sizes, features and finishes are subject to change without notice. Areas and dimensions are approximate and actual usable floor space may vary from the stated area. Layout may be reverse of the unit purchased. E. & O.E. 4002

SCHEDULE 'F'




PV-130
APRIL 14 2026
Set Attached

The Valleyview

40' SERIES

→ Elevation A • 3,145 sq.ft.
Elevation B • 3,170 sq.ft.

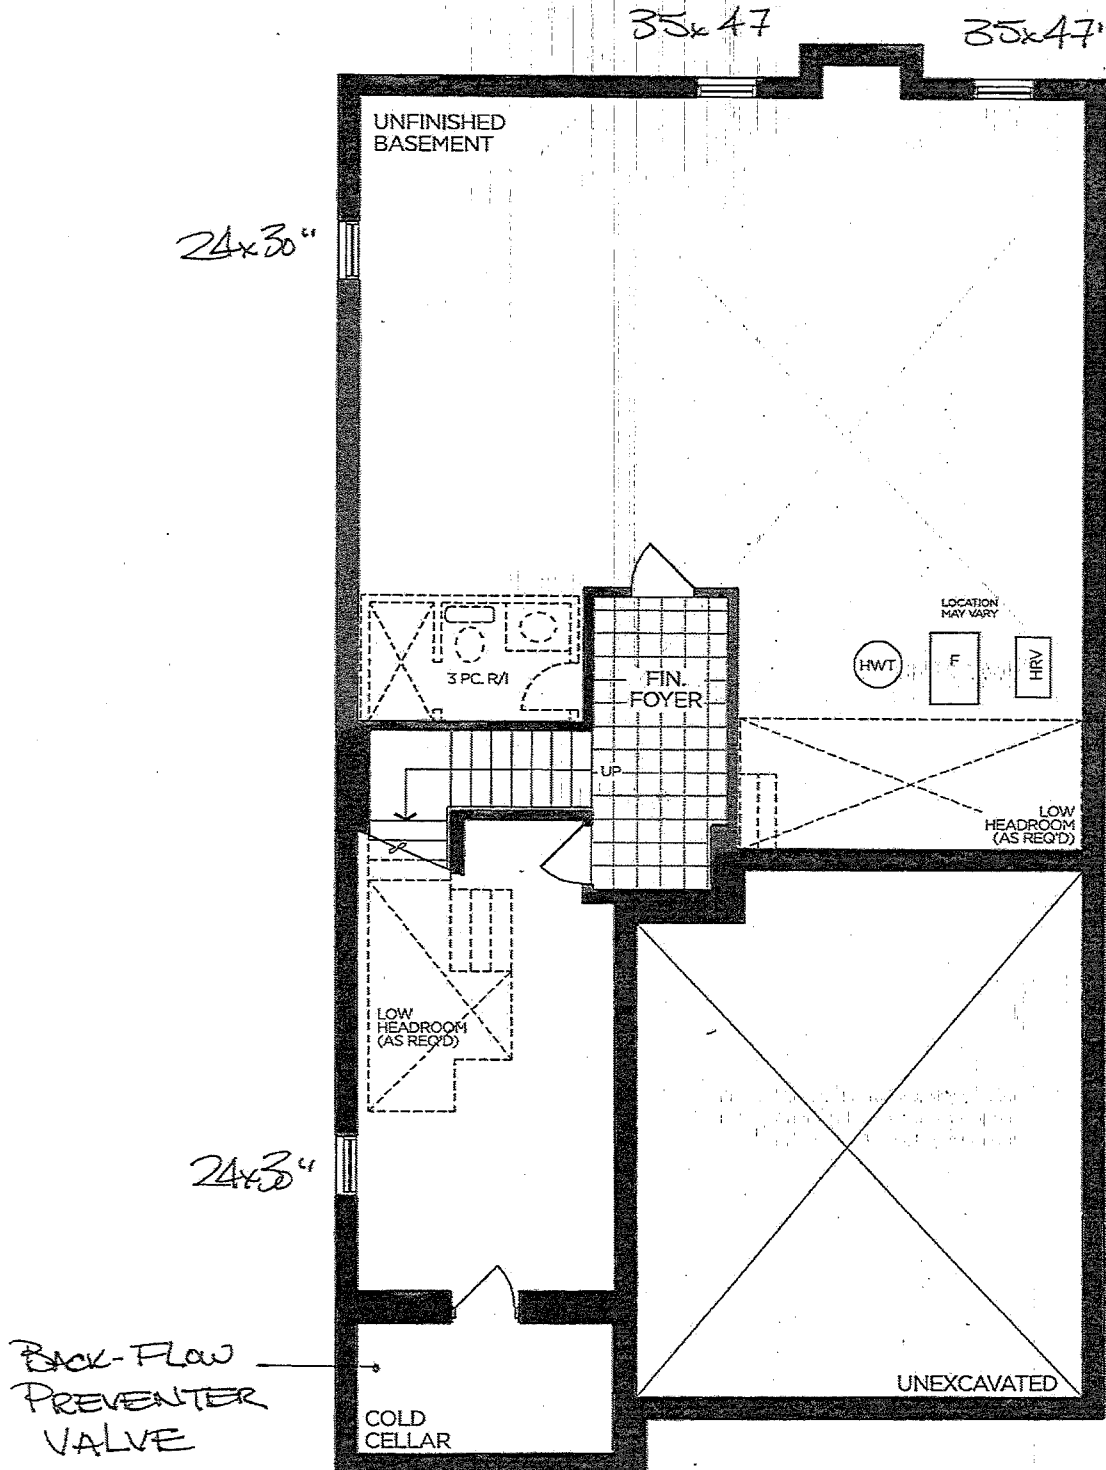

BASEMENT | ELEV. A

VENDOR	
PURCHASER	
PURCHASER	

GOLDPARK

WORTH MORE™

Prices, figures, illustrations, sizes, features and finishes are subject to change without notice. Areas and dimensions are approximate and actual usable floor space may vary from the stated area. Layout may be reverse of the unit purchased. E. & O.E. 4002




SCHEDULE F

PV-130
April 14, 2020

The Valleyview 40' SERIES

→ Elevation A - 3,145 sq.ft.
Elevation B - 3,170 sq.ft.

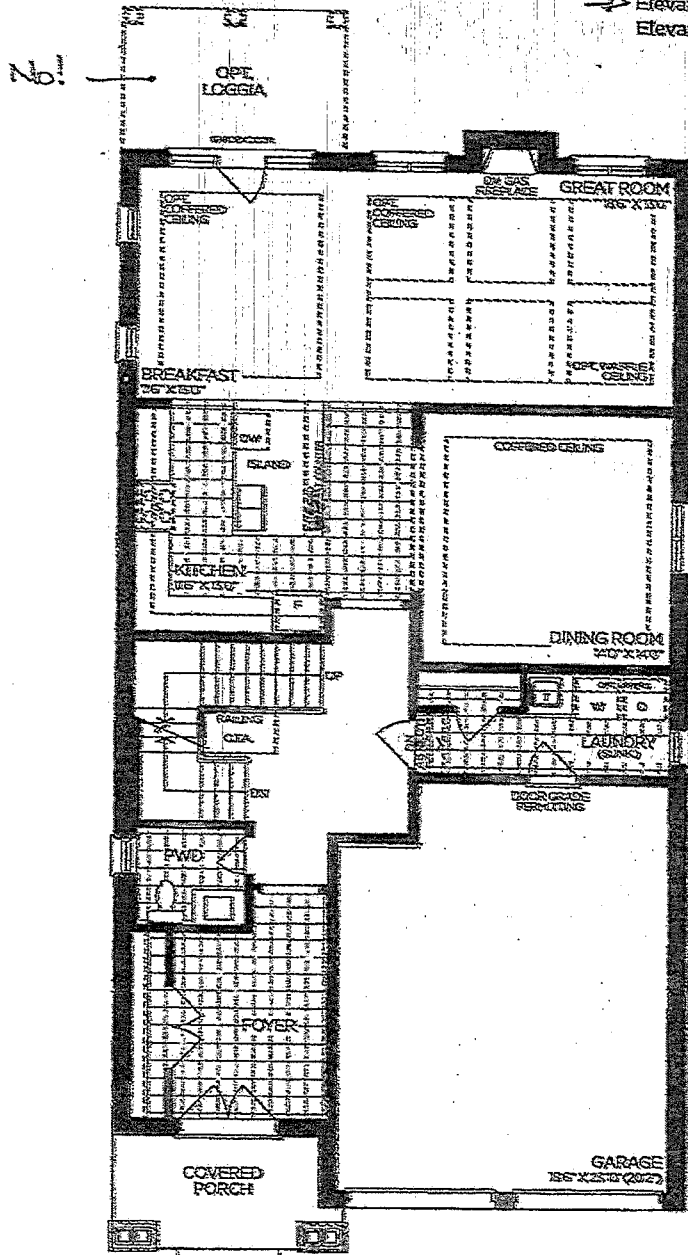

GROUND FLOOR | ELEV. A

VENDOR
PURCHASER
PURCHASER

GOLDPARK
WORTH MORE


Prices, figures, illustrations, sizes, features and finishes are subject to change without notice. Areas and dimensions are approximate and actual results may vary from the stated area. Layout may be revised at the time of purchase. E & OE, 4/3/20



SCHEDULE 'F'

PL 130
April 14 2020

The
Valleyview
40' SERIES
→ Elevation A - 3,145 sq.ft.
Elevation B - 3,170 sq.ft.

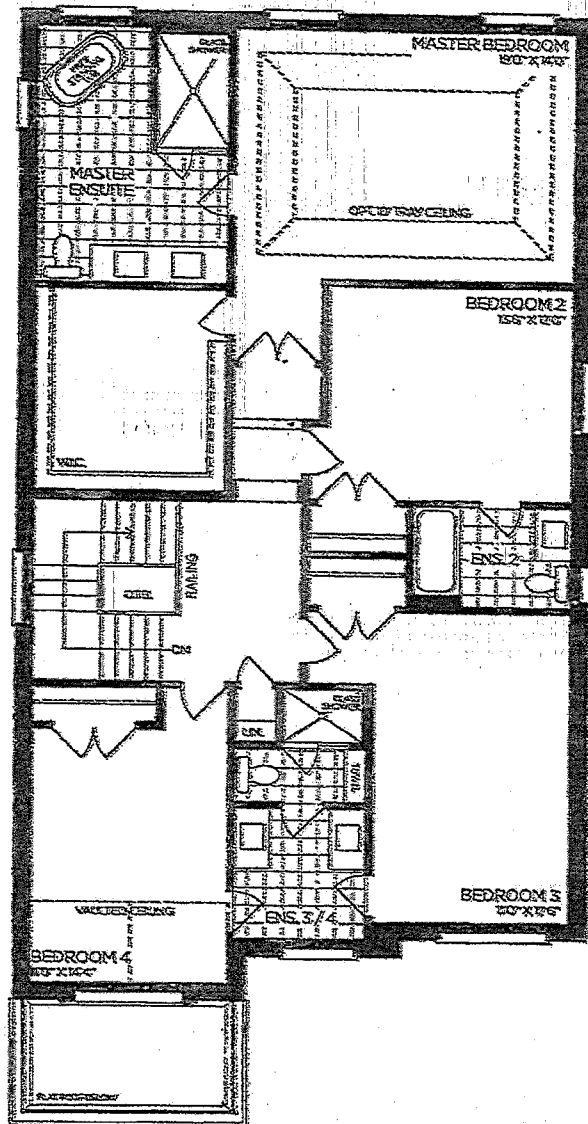

SECOND FLOOR | ELEV. A

VENDOR
PURCHASER
PURCHASER

GOLDPARK
WORK MORE

Prices, floor, materials, sizes, features and finishes are subject to change without notice. Areas and dimensions are approximate and actual usable floor space may vary from the standard unit. Layout may be reverse of the unit purchased. E & OE 4/2/22

SCHEDULE 'F'




PV-130

April 14 2022

The Valleyview
40' SERIES

→ Elevation A • 3,145 sq.ft.
Elevation B • 3,170 sq.ft.

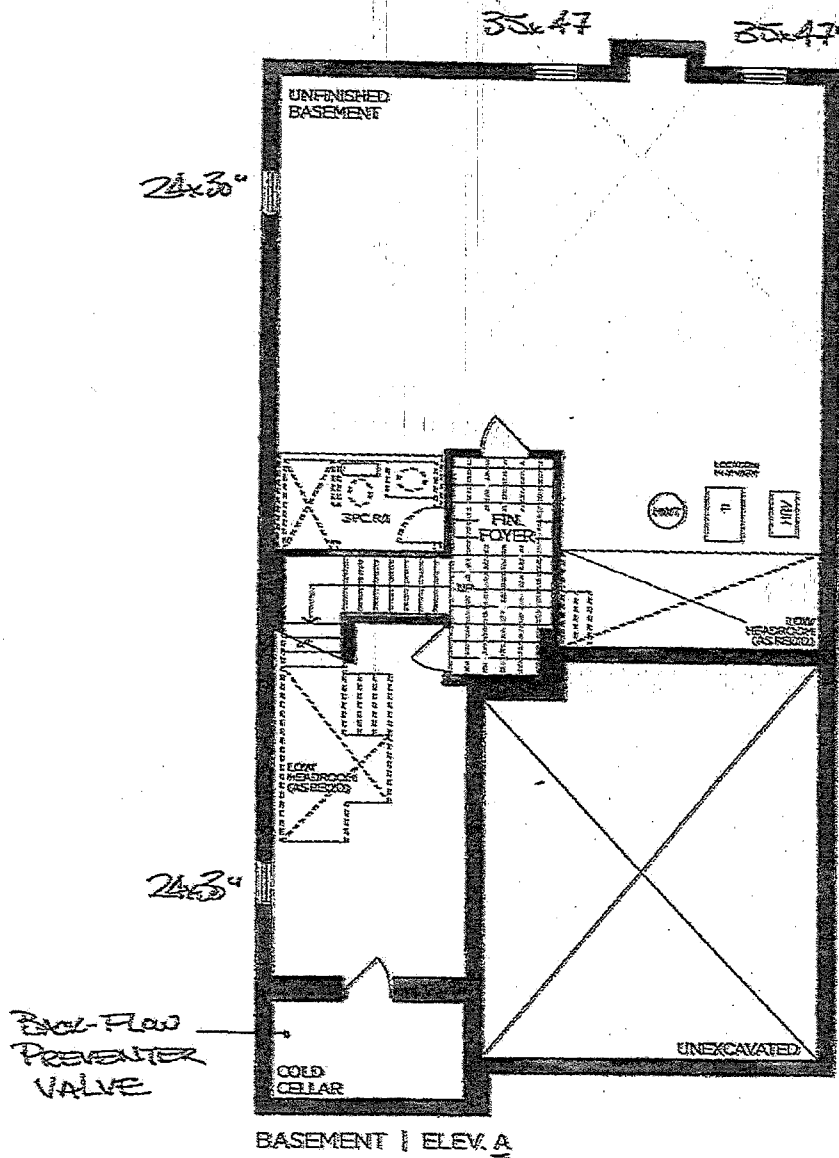

VENDOR
PURCHASER
PURCHASER

GOLDPARK
WORTH MORE

Prices, figures, illustrations, sizes, features and details are subject to change without notice. Areas and dimensions are approximate and actual usable floor space may vary from the stated area. Layout may be reverse of the unit purchased. E. & C.E. 4/22

PV-130

GOLD PARK HOMES
300 HIGHWAY 7
CONCORD ON

CARD *****8275
CARD TYPE VISA
DATE 2020/04/15
TIME 0953 17:38:13
RECEIPT NUMBER
M82039870-001-001-377-0
PURCHASE
TOTAL

\$2,050.95

PASSWORD USED

APPROVED

AUTH# 044051 01-027
THANK YOU

CARDHOLDER COPY

IMPORTANT - RETAIN THIS
COPY FOR YOUR RECORDS

PV-130

GOLD PARK HOMES
300 HIGHWAY 7
CONCORD ON

CARD *****8275
CARD TYPE VISA
DATE 2020/04/15
TIME 0953 17:38:13
RECEIPT NUMBER
M82039870-001-001-377-0
PURCHASE
TOTAL

\$2,050.95

PASSWORD USED

APPROVED

AUTH# 044051 01-027
THANK YOU

MERCHANT COPY

IMPORTANT - RETAIN THIS
COPY FOR YOUR RECORDS