


REQUEST TO MOVE BOX FROM 18" TO 12" HAS  
BEEN ACCOMODATED- APRIL 20 2020. - NP


\*DRAWINGS  
CORRECTED TO  
MATCH FIREPLACE  
SIZE

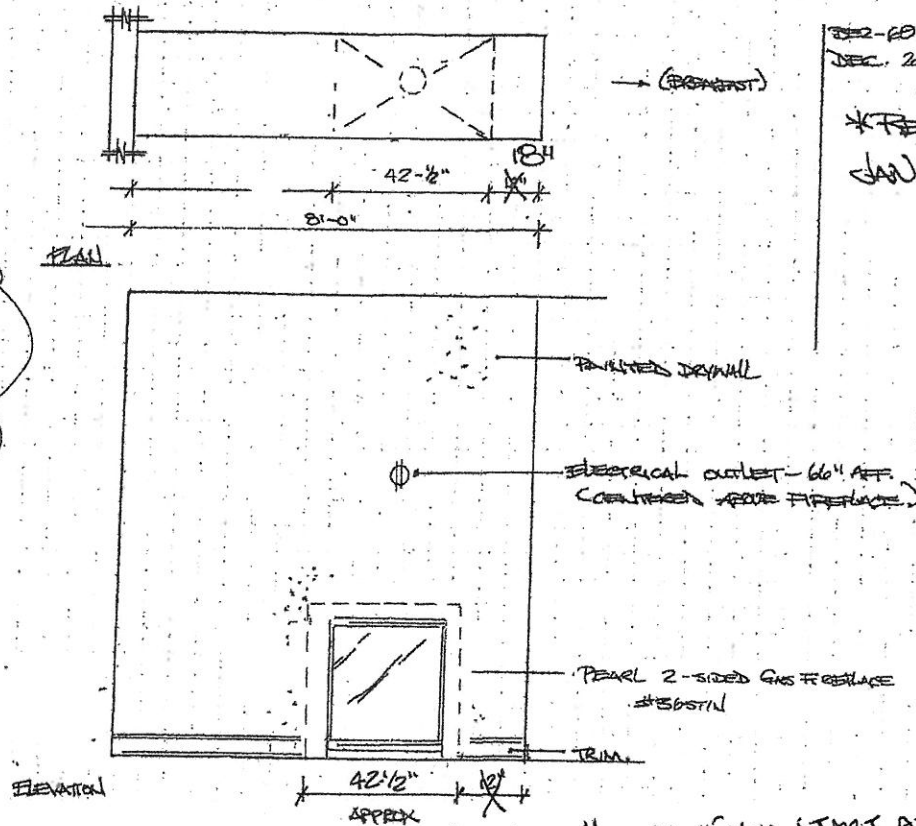

DEC 2 2009  
\*REVIEW\*  
JAN 7 2010

APRIL 14 2020  
\*ADD BLOCKING for  
FUTURE TV  
SIDE CLOSEST to  
REAR YARD

12" 12" INCH IF YOU START AT BOX.  
AS SIGNED AND DRAWN ON JAN. 07.  
PLEASE SEE SECOND PAGE. IT CONTAINS  
A DRAWING OF THE FIREPLACE, NOT THE  
BOX INIT. WE AS SIGNED WANT THE FIREPLACE  
NOT BOX, TO START AT 18 INCHES KITCHEN SIDE

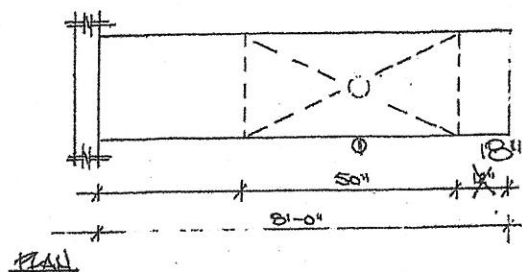


→ (BREAK)

PER-EDL PB.  
DEC. 200 (PB)

\*~~REVISION~~  
JAN 7.200

(PB) (PB)

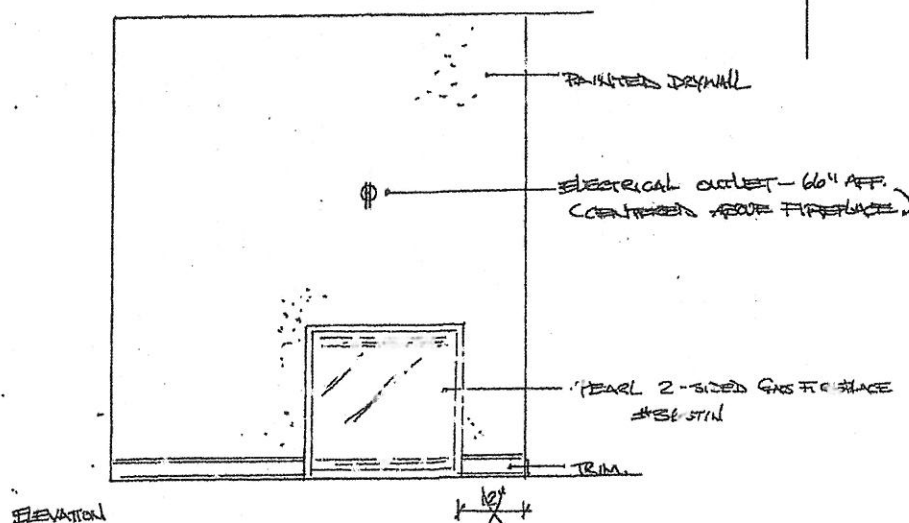

18"

↑  
FIREPLACE  
NOT  
BOX.