

CONSTRUCTION SUMMARY

Lot: 75L

Model: 28-10 Elev C Stravinsky

Project/Phase: Brampton Encore / 2

APPLIANCES		
Invoice	Qty.	Description
2301 32545 21Apr20 NoCat	1	APPLIANCE PACKAGE: FRIDGE/STOVE/DISHWASHER - STAINLESS STEEL + WASHER/DRYER - WHITE INCLUDED IN APS

CENTRAL VAC AND WIRING		
Invoice	Qty.	Description
2301 32535 21Apr20	1	GREAT ROOM: CONDUIT PIPE- FOR TELEVISION- LOCATE APPROX. 66" A.F.F. TERMINATING BY CABLE. SEE PLAN FOR LOCATION

CONCRETE AND DRAIN		
Invoice	Qty.	Description
2301 32550 21Apr20 **	1	ROUGH-IN - 3PC BASEMENT ROUGH-IN INCLUDED IN APS

ELECTRICAL		
Invoice	Qty.	Description
2301 32536 21Apr20	1	GREAT ROOM: 110V WALL RECEPTACLE ON DEDICATED CIRCUIT- LOCATE APPROX. 66" A.F.F. ABOVE FIREPLACE
2301 32537 21Apr20 NoCat	1	KITCHEN: CAPPED CEILING ROUGH-IN - LOCATE APPROX CENTER ABOVE ISLAND
2301 32538 21Apr20 NoCat	1	KITCHEN: SINGLE POLE SWITCH
2301 32539 21Apr20	1	200 AMP ELECTRICAL SERVICE

EXTERIOR COLOURS		
Invoice	Qty.	Description
2301 32600 21Apr20 NoCat	1	EXTERIOR COLOUR PACKAGE # 10

GOLDPARK

WORTH MORE™

CONSTRUCTION SUMMARY

Lot: 75L

Model: 28-10 Elev C Stravinsky

Project/Phase: Brampton Encore / 2

FORMING

Invoice	Qty.	Description
2301 32542 21Apr20 **	1	BASEMENT WINDOWS - UPGRADE EXISTING BASEMENT WINDOW TO 30 INCH X 24 INCH - MAY REQUIRE INSTALLATION OF WINDOW WELL
2301 32547 21Apr20	1	SIDE DOOR- HOME TO EXTERIOR- AS PER PLAN AND GRADE PERMITTING INCLUDED IN APS
2301 32549 21Apr20 **	2	BASEMENT WINDOWS - UPGRADE EXISTING BASEMENT WINDOW TO 30 INCH X 16 INCH INCLUDED IN APS
2301 32602 21Apr20 NoCat	1	GARAGE MANDOOR - AS PER PLAN AND GRADE PERMITTING

FRAMING

Invoice	Qty.	Description
2301 32548 21Apr20	1	MANDOOR - GARAGE TO HOUSE- AS PER PLAN AND GRADE PERMITTING INCLUDED IN APS
2301 32601 21Apr20 NoCat	1	SIDE DOOR - AS PER PLAN AND GRADE PERMITTING

GARAGE DOORS

Invoice	Qty.	Description
2301 32540 21Apr20	1	GARAGE DOOR OPENER - WITH 1 REMOTE- PRICE IS PER DOOR **BELT DRIVE**
2301 32541 21Apr20	1	GARAGE: DIGITAL ENTRY KEYPAD

HVAC

Invoice	Qty.	Description
2301 32546 21Apr20 NoCat	1	A/C- 2.0 TON INCLUDED IN APS

INTERIOR TRIM AND DOORS

Invoice	Qty.	Description
2301 32547 21Apr20 **	1	SIDE DOOR- HOME TO EXTERIOR- AS PER PLAN AND GRADE PERMITTING INCLUDED IN APS

ryDiscipline.rpt 14Mar20


Page 2 of 3

BE2-75L
APRIL 20 2020

AS
AK

The Stravinsky SEMI SERIES

Elevation A • 2,090 sq.ft.
Elevation B • 2,105 sq.ft.
→ Elevation C • 2,160 sq.ft.
Elevation D • 2,105 sq.ft.

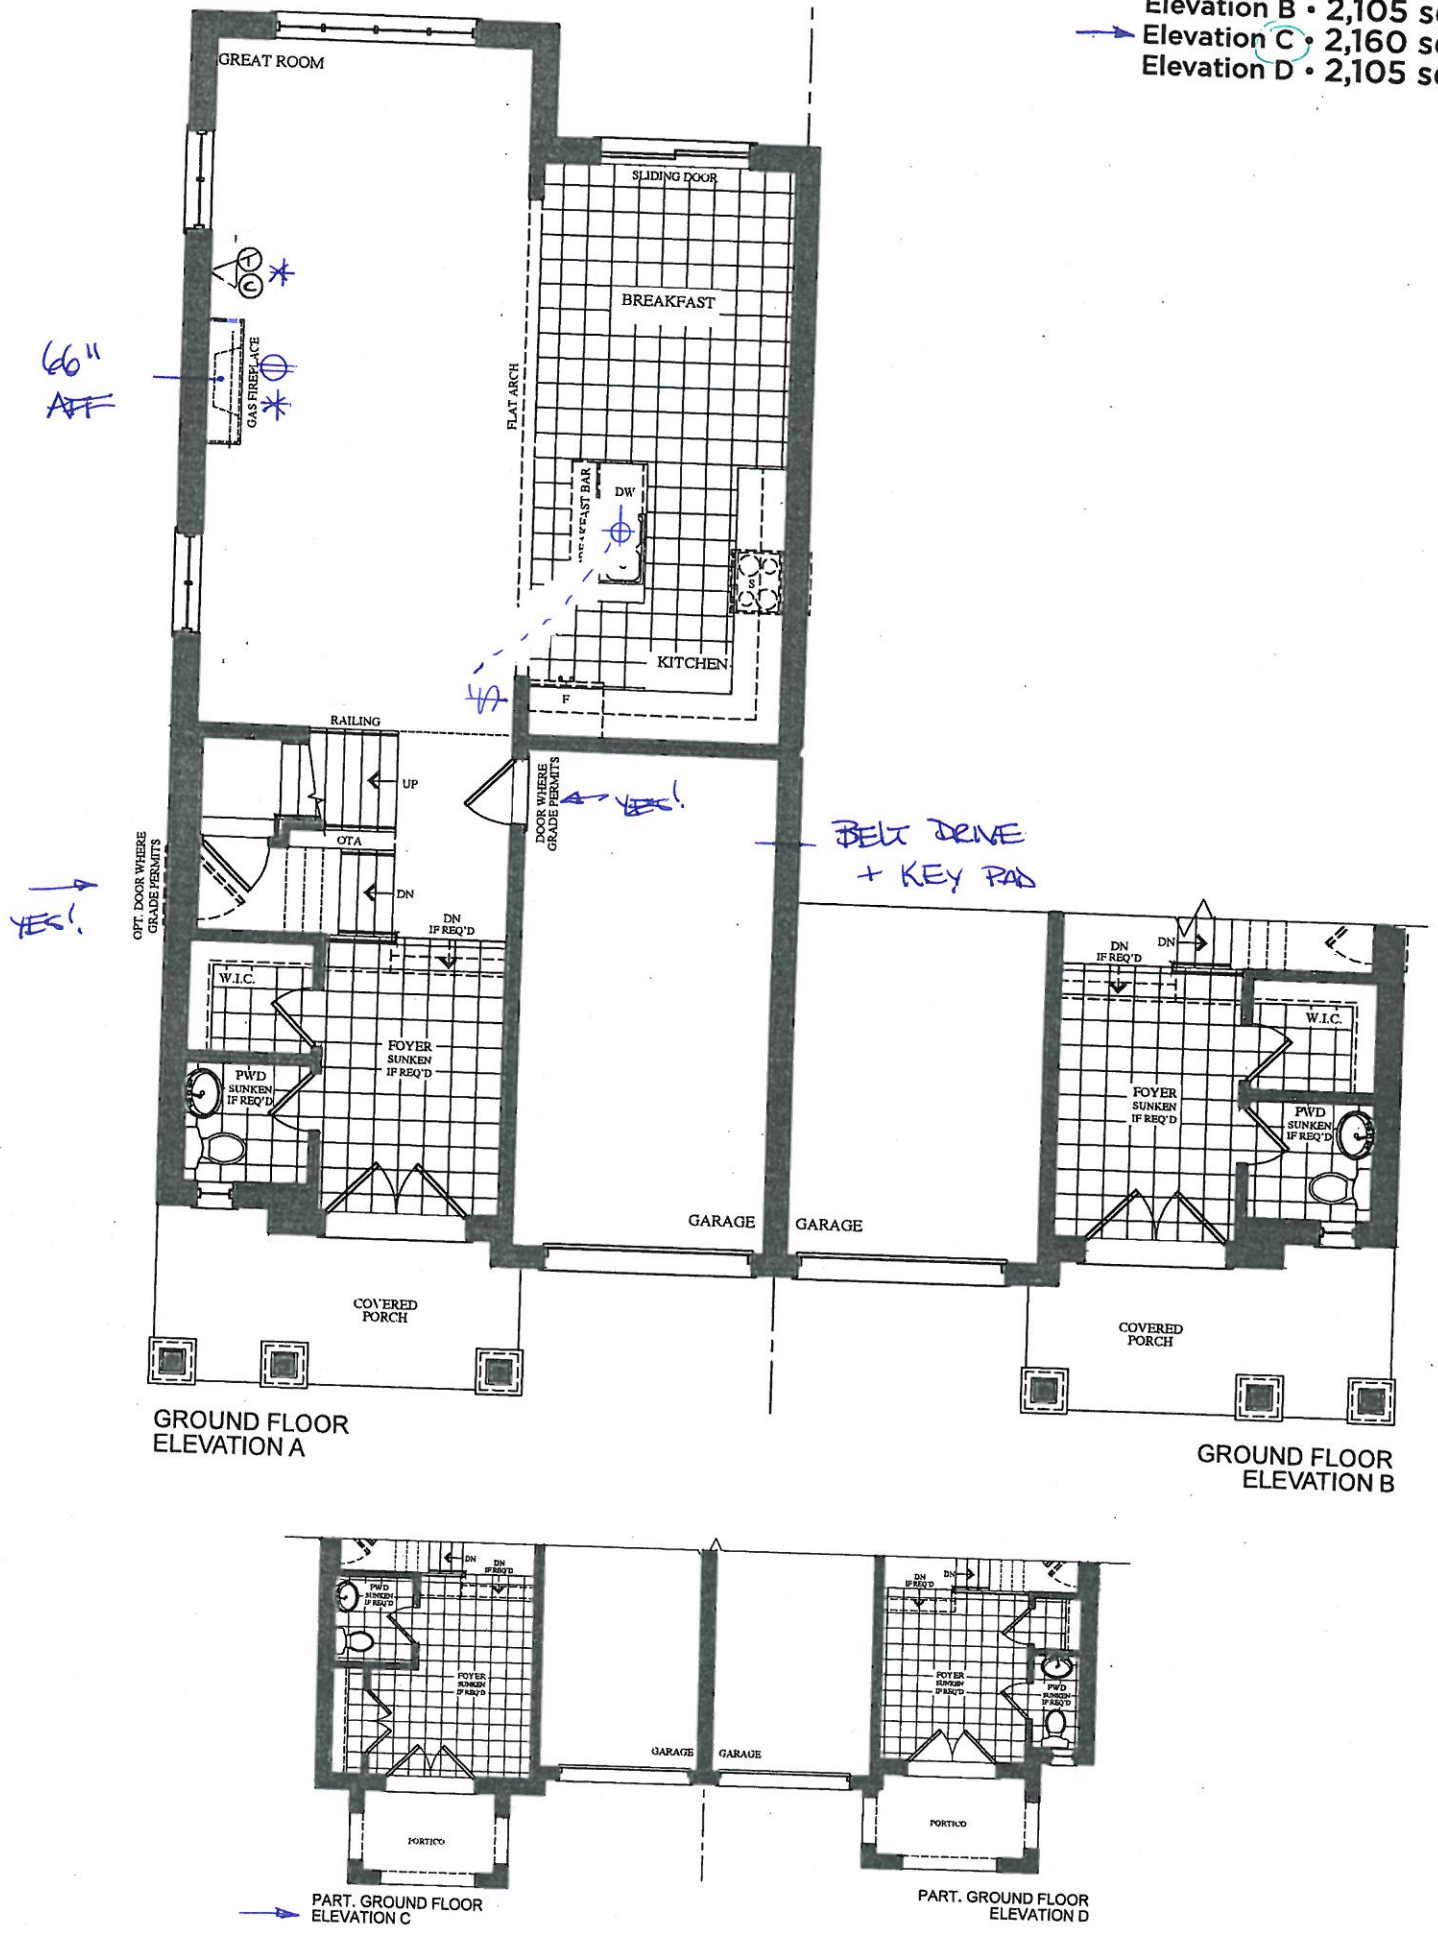

VENDOR

PURCHASER

PURCHASER

GOLDPARK
WORTH MORE™



Prices, figures, illustrations, sizes, features and finishes are subject to change without notice. Areas and dimensions are approximate and actual usable floor space may vary from the stated area. Layout may be reverse of the unit purchased. E. & O.E.

BE2-75L
APRIL 20 2020

AS
AK

The
Stravinsky
SEMI SERIES

Elevation A • 2,090 sq.ft.
Elevation B • 2,105 sq.ft.
Elevation C • 2,160 sq.ft.
Elevation D • 2,105 sq.ft.

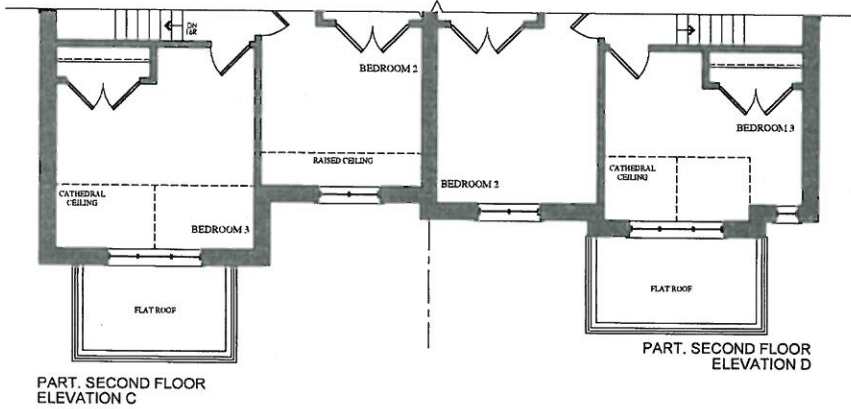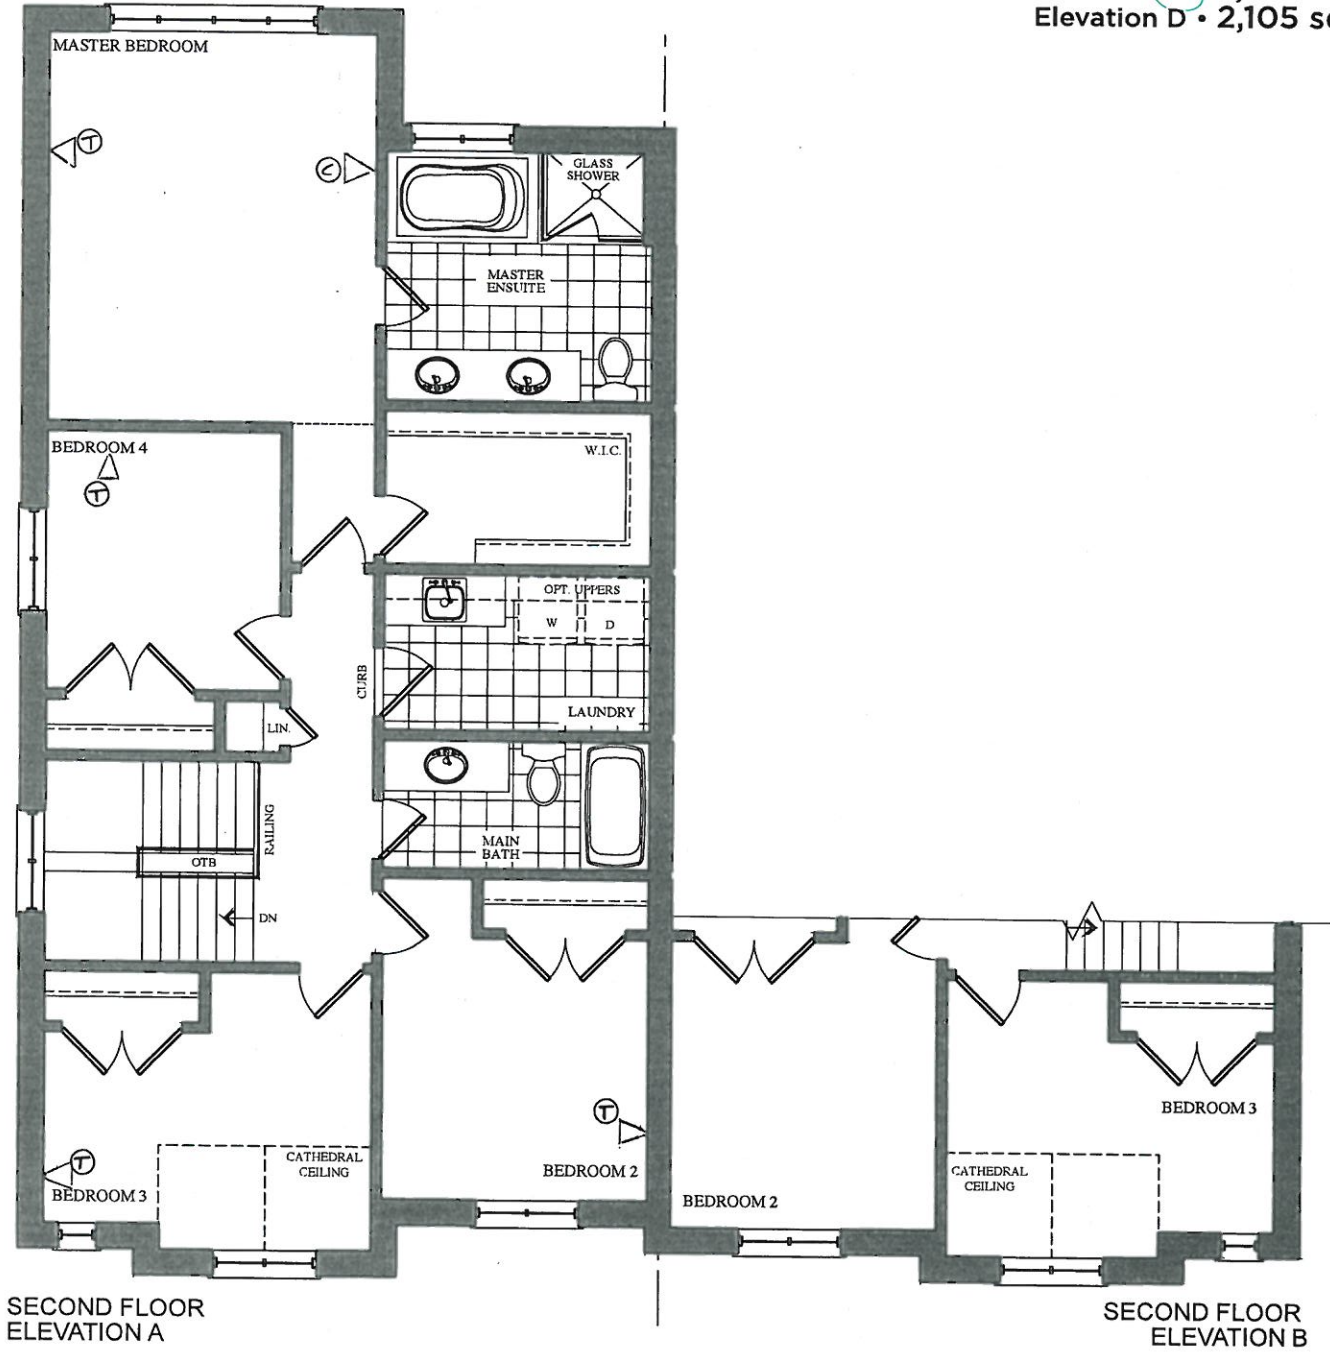

VENDOR

PURCHASER

PURCHASER

GOLDPARK
WORTH MORE™



Prices, figures, illustrations, sizes, features and finishes are subject to change without notice. Areas and dimensions are approximate and actual usable floor space may vary from the stated area. Layout may be reverse of the unit purchased. E. & O.E.

BEZ-75L
APRIL 20 2020

AS
AK

The
Stravinsky
SEMI SERIES

Elevation A • 2,090 sq.ft.
Elevation B • 2,105 sq.ft.
→ Elevation C • 2,160 sq.ft.
Elevation D • 2,105 sq.ft.

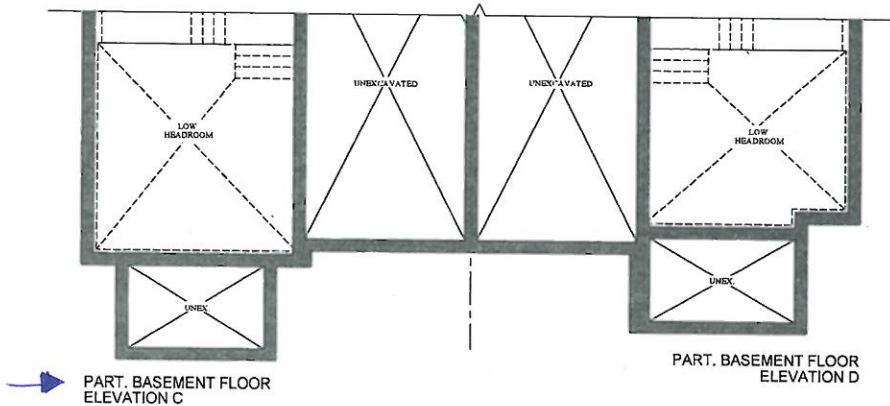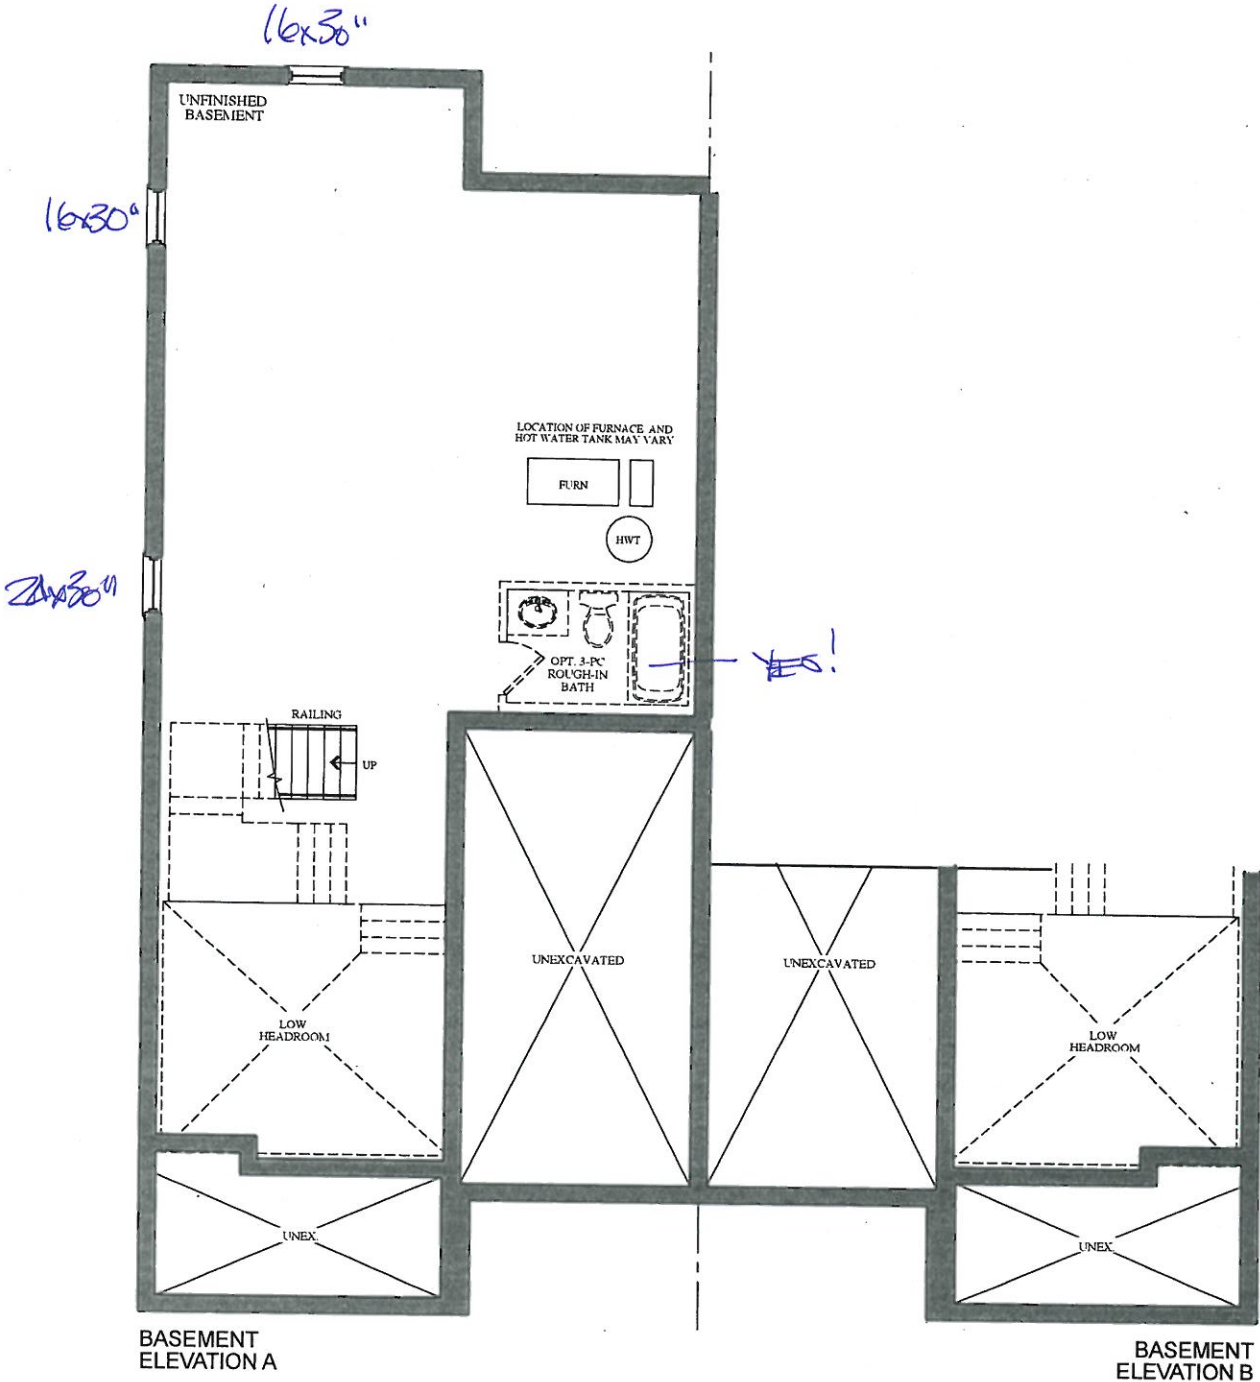

VENDOR

PURCHASER

PURCHASER

GOLDPARK
WORTH MORE™

Prices, figures, illustrations, sizes, features and finishes are subject to change without notice. Areas and dimensions are approximate and actual usable floor space may vary from the stated area. Layout may be reverse of the unit purchased. E. & O.E.