

GOLDPARK

WORTH MORE™

CONSTRUCTION SUMMARY

Lot: 119

Model: 38-4 Elev.B VIVALDI

Project/Phase: Brampton Encore / 2

CENTRAL VAC AND WIRING

Invoice	Qty.	Description
2243 31819 21Apr20	1	FAMILY ROOM: CONDUIT PIPE- FOR TELEVISION- LOCATE APPROX. 66' A.F.F. ABOVE FIREPLACE, TERMINATING AT CABLE LOCATION

ELECTRICAL

Invoice	Qty.	Description
2243 31821 21Apr20	1	FAMILY ROOM: 110V WALL RECEPTACLE ON DEDICATED CIRCUIT- LOCATE APPROX. 66" A.F.F. ABOVE FIREPLACE
2243 31823 21Apr20 NoCat	2	KITCHEN: ADD CAPPED CEILING OUTLET, APPROX CENTERED ABOVE ISLAND
2243 31824 21Apr20 NoCat	1	KITCHEN: SINGLE POLE SWITCH FOR ISLAND LIGHTS
2243 31825 21Apr20 NoCat	1	POWDER ROOM: ADD CAPPED CEILING OUTLET, APPROX CENTER OF CEILING - USE SAME SWITCH AS VANITY LIGHT
2243 31826 21Apr20 NoCat	4	FAMILY ROOM: CAPPED CEILING OUTLET - SEE PLAN FOR LOCATION (NOTE: PURCHASER TO CHANGE TO POTLIGHTS AFTER CLOSING) SAME SWITCH AS STANDARD CEILING LIGHT
2243 32247 21Apr20 NoCat	5	KITCHEN: CAPPED CEILING OUTLET (PURCHASER TO CHANGE TO POTLIGHT AFTER CLOSING)
2243 32249 21Apr20 NoCat	4	BREAKFAST ROOM: CAPPED CEILING OUTLET (PURCHASER TO CHANGE TO POTLIGHTS AFTER CLOSING) LOCATE APPROX 30" FROM EACH WALL
2243 32250 21Apr20 NoCat	1	BREAKFAST: SINGLE POLE SWITCH FOR CAPPED CEILING OUTLETS

EXTERIOR COLOURS

Invoice	Qty.	Description
2243 32603 21Apr20 NoCat	1	EXTERIOR COLOUR PACKAGE # 2

FORMING

Invoice	Qty.	Description
2243 31833 21Apr20 **	2	BASEMENT WINDOWS - UPGRADE EXISTING BASEMENT WINDOW TO 30 INCH X 24 INCH - MAY REQUIRE INSTALLATION OF WINDOW WELL

ryDiscipline.rpt 14Mar20

Page 1 of 2

GOLDPARK

WORTH MORE™

CONSTRUCTION SUMMARY

Lot: 119

Model: 38-4 Elev.B VIVALDI

Project/Phase: Brampton Encore / 2

FRAMING

Invoice	Qty.	Description
2243 32616 21Apr20 NoCat	4	MAIN FLOOR; EXTENDED HEIGHT ARCHWAYS -96"
2243 32617 21Apr20 NoCat	1	BREAKFAST ROOM: 12" SIDELITES FOR 80" OPENING - (SLIDING DOOR WITH 2 FIXED PANELS)

INTERIOR TRIM AND DOORS

Invoice	Qty.	Description
2243 31836 21Apr20	4	MAIN FLOOR; EXTENDED HEIGHT ARCHWAY (PRICE PER DOORWAY) -96"
2243 31837 21Apr20	4	MAIN FLOOR; STANDARD DOOR EXTENDED HEIGHT 96" (PRICE PER DOOR)- GROUND FLOOR 2 STOREY MODELS

KITCHEN AND BATH CABINETRY

Invoice	Qty.	Description
2243 32248 21Apr20 NoCat	1	KITCHEN: SINGLE POLE SWITCH FOR CAPPED CEILING LIGHTS - SEE PLAN

MISC.

Invoice	Qty.	Description
2243 31846 21Apr20 NoCat	1	BONUS PACKAGE: \$10,000.00 (INCLUDING TAXES) WORTH OF UPGRADES FROM GOLD PARK HOMES DÉCOR CENTRE IS BEING APPLIED TOWARD THIS ORDER. PURCHASER HAS A REMAINING AMOUNT OF \$00 (INCLUDING TAXES).

WINDOWS - BASEMENT

Invoice	Qty.	Description
2243 31833 21Apr20	2	BASEMENT WINDOWS - UPGRADE EXISTING BASEMENT WINDOW TO 30 INCH X 24 INCH - MAY REQUIRE INSTALLATION OF WINDOW WELL
2243 31842 21Apr20	1	BASEMENT WINDOWS - *ADD* EXTRA BASEMENT WINDOW 30 INCH X 24 INCH - MAY REQUIRE INSTALLATION OF WINDOW WELL SEE PLAN FOR LOCATION

WINDOWS AND DOORS

Invoice	Qty.	Description
2243 31839 21Apr20 NoCat	1	BREAKFAST ROOM: 12" SIDELITES FOR 80" OPENING - (SLIDING DOOR WITH 2 FIXED PANELS)

This Document is Extremely Time Sensitive - Printed 21 Apr 20 at 10:46

ryDiscipline.rpt 14Mar20


Page 2 of 2

BEZ-119 ~~see attached~~
APRIL 9 2020

The
Vivaldi
38' SERIES

Elevation A • 2,518 sq.ft. | Elevation B • 2,518 sq.ft.



LOOK OUT BASEMENT.

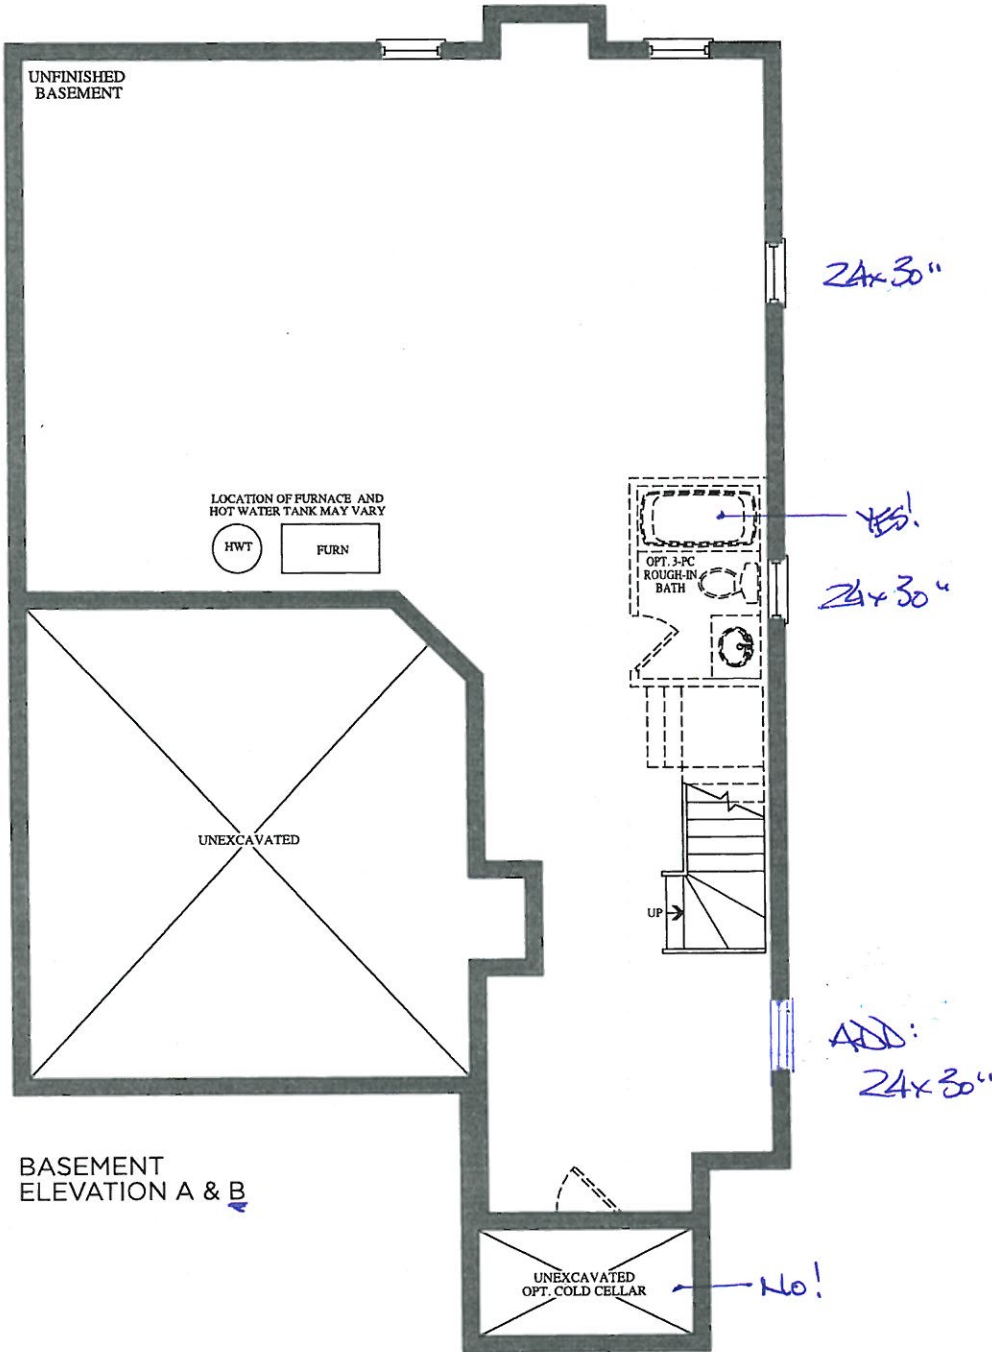

BE2-119.
April 2020
See attached

The
Vivaldi
38' SERIES

Elevation A • 2,518 sq.ft. | Elevation B • 2,518 sq.ft.

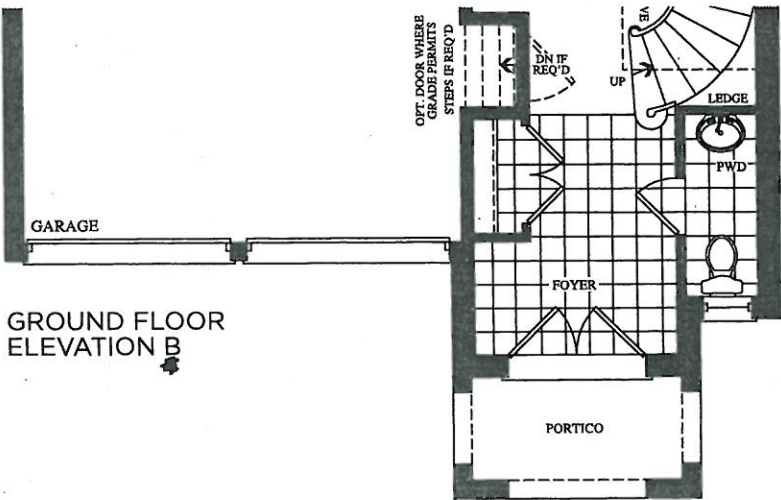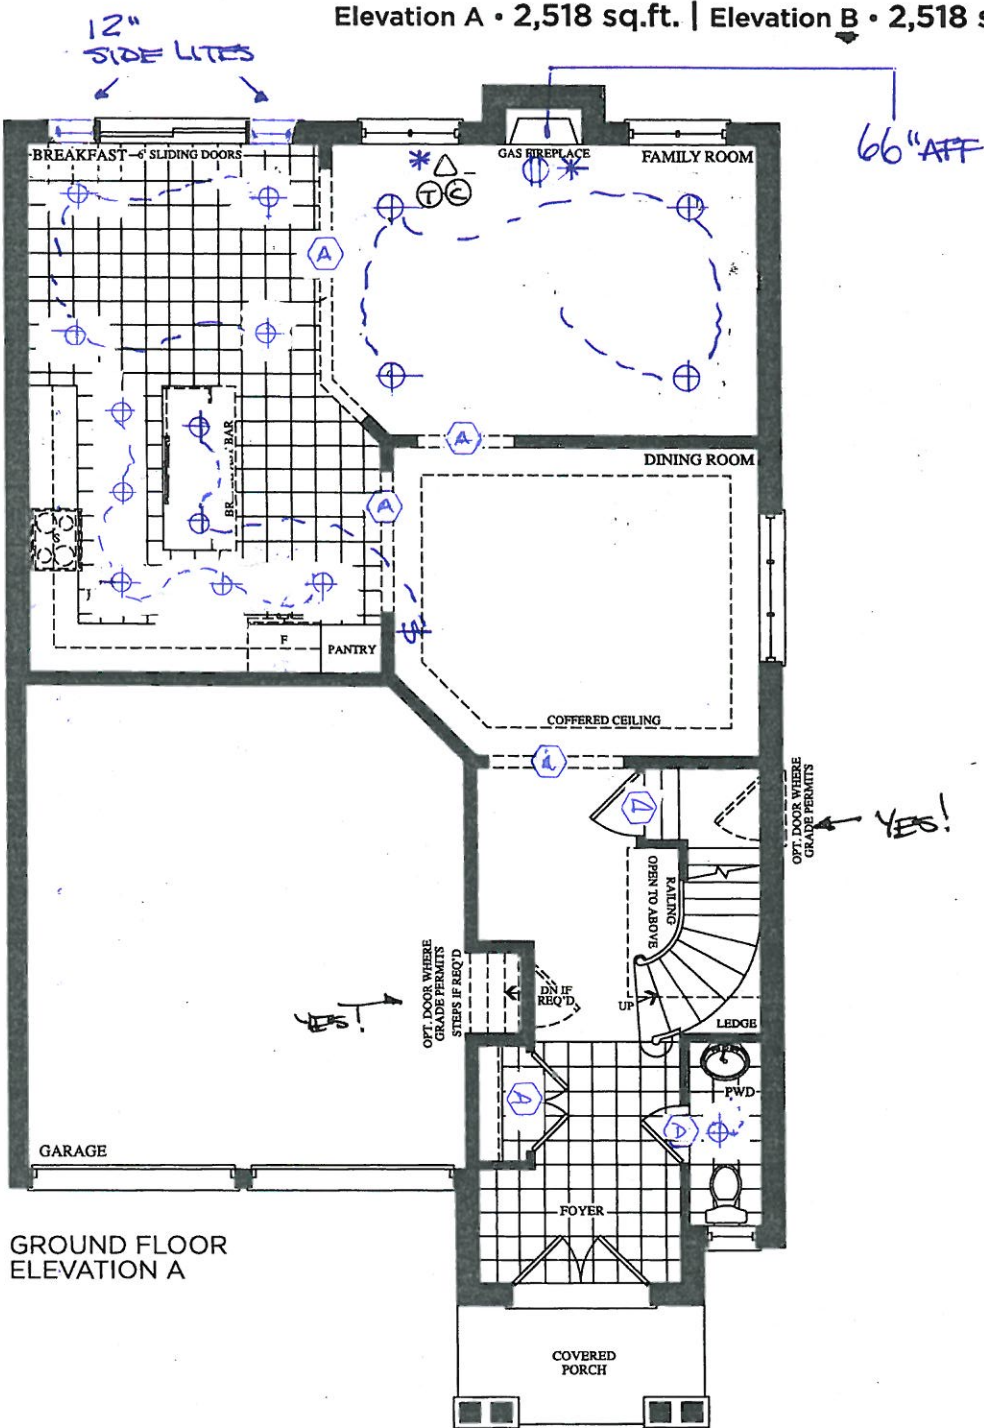


Prices, figures, illustrations, sizes, features and finishes are subject to change without notice. E.&O.E. Areas and dimensions are approximate and actual usable floor space may vary from the stated area. Layout may be reverse of the unit purchased. E. & O.E.


BE2-119
April 9 2020
see attached

The
Vivaldi
38' SERIES

Elevation A • 2,518 sq.ft. | Elevation B • 2,518 sq.ft.

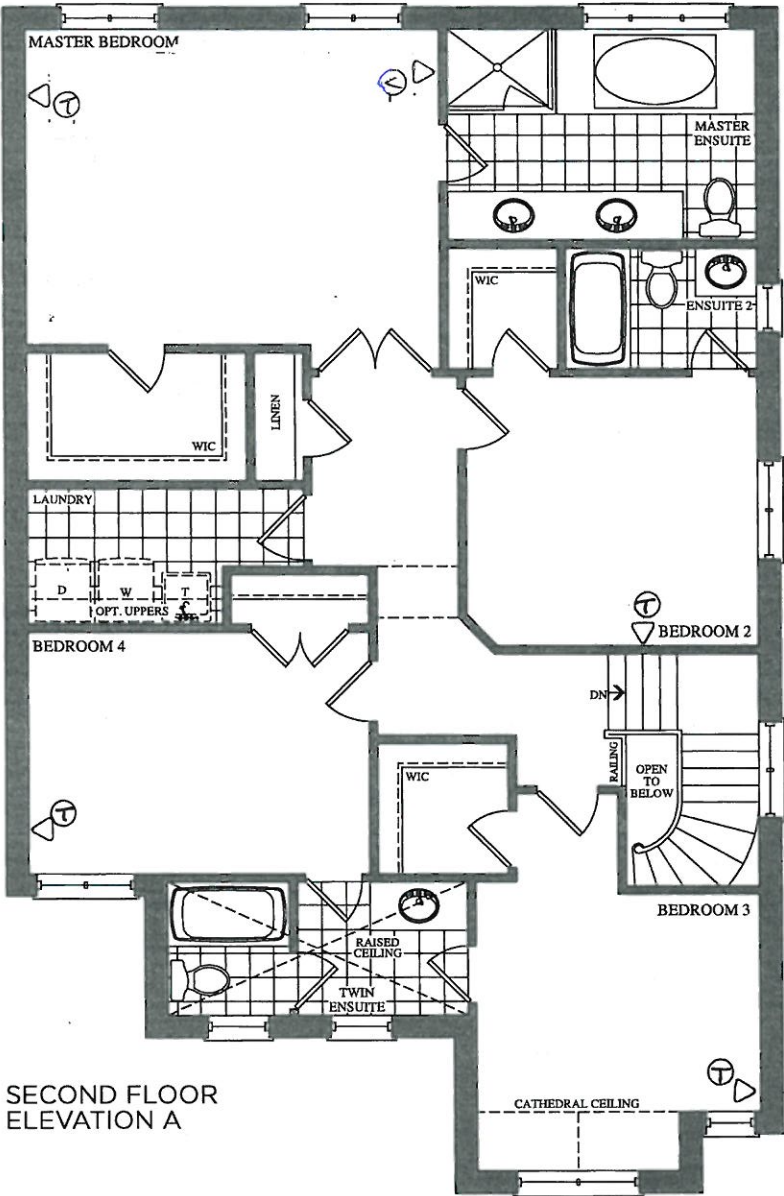

SECOND FLOOR
ELEVATION A

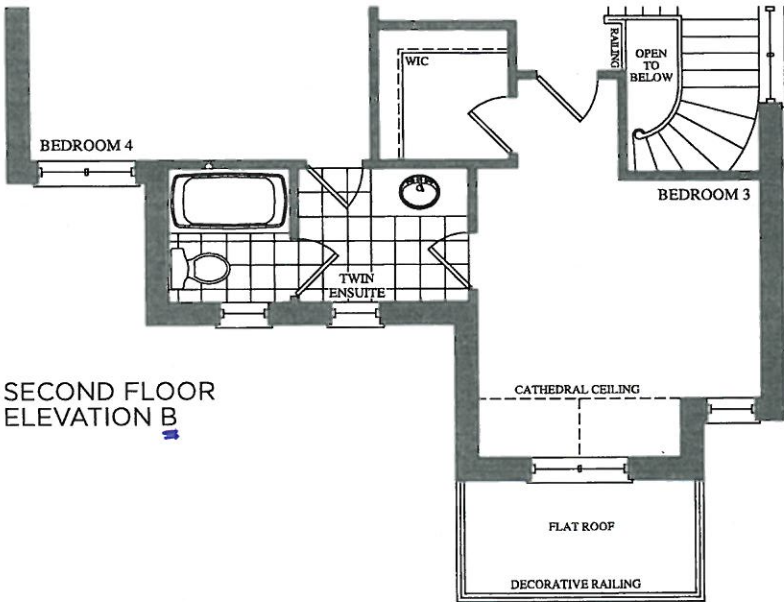

SECOND FLOOR
ELEVATION B

Prices, figures, illustrations, sizes, features and finishes are subject to change without notice. E.&O.E. Areas and dimensions are approximate and actual usable floor space may vary from the stated area. Layout may be reverse of the unit purchased. E. & O.E.


encore
BRAMPTON

BEZ-119
APRIL 9 2020

The
Vivaldi
38' SERIES

Elevation A • 2,518 sq.ft. | Elevation B • 2,518 sq.ft.

LOOK OUT BASEMENT.

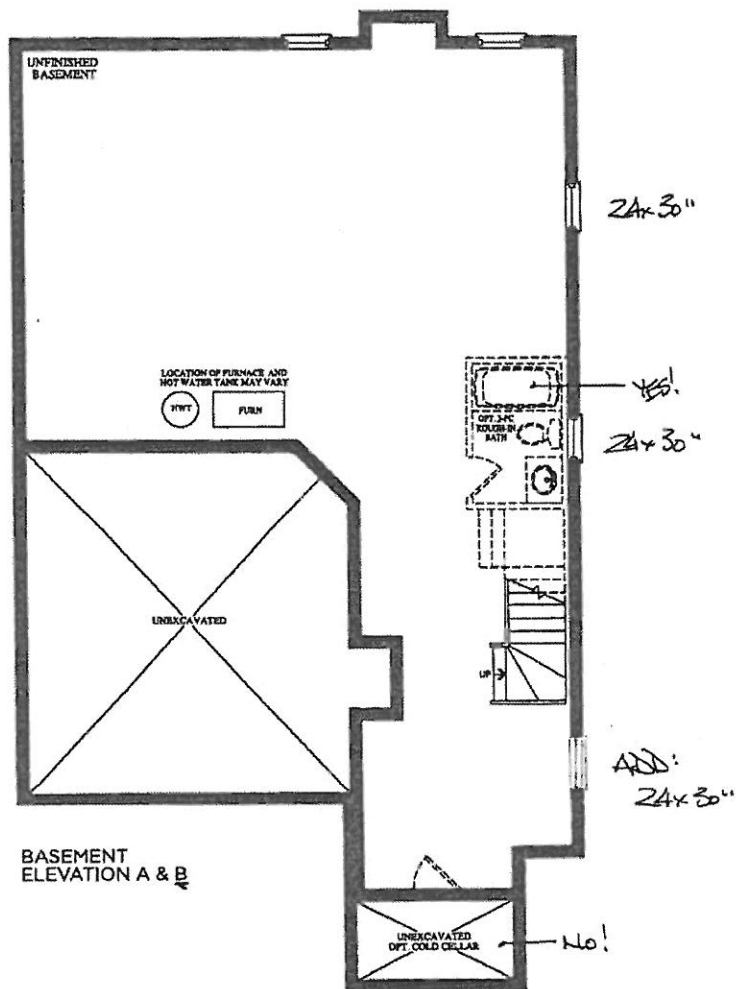

Prices, figures, illustrations, sizes, features and finishes are subject to change without notice. E.&O.E. Areas and dimensions are approximate and actual usable floor space may vary from the stated area. Layout may be reverse of the unit purchased. E. & O.E.

GOLDPARK
HOMES


encore
BRAMPTON

BE2-119.
April 2020



The
Vivaldi
38' SERIES

Elevation A • 2,518 sq.ft. | Elevation B • 2,518 sq.ft.

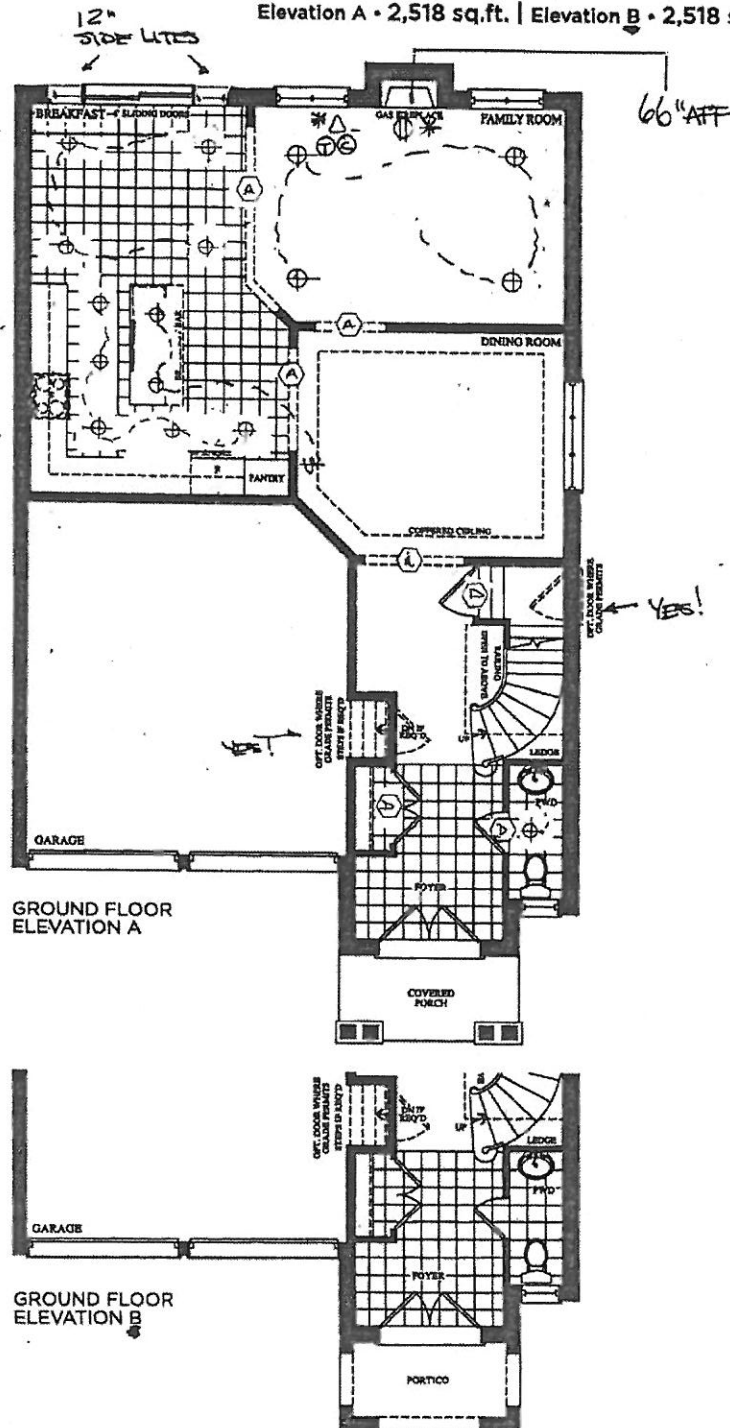

Prices, figures, illustrations, sizes, features and finishes are subject to change without notice. E.&O.E. Areas and dimensions are approximate and actual usable floor space may vary from the stated area. Layout may be reverse of the unit purchased. E. & O.E.

GOLDPARK
HOMES



encore
BRAMPTON

BE2-119
April 9 2020

119
2020

The
Vivaldi
38' SERIES

Elevation A • 2,518 sq.ft. | Elevation B • 2,518 sq.ft.

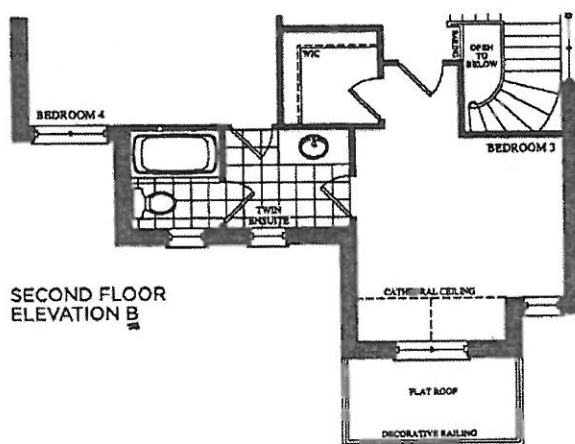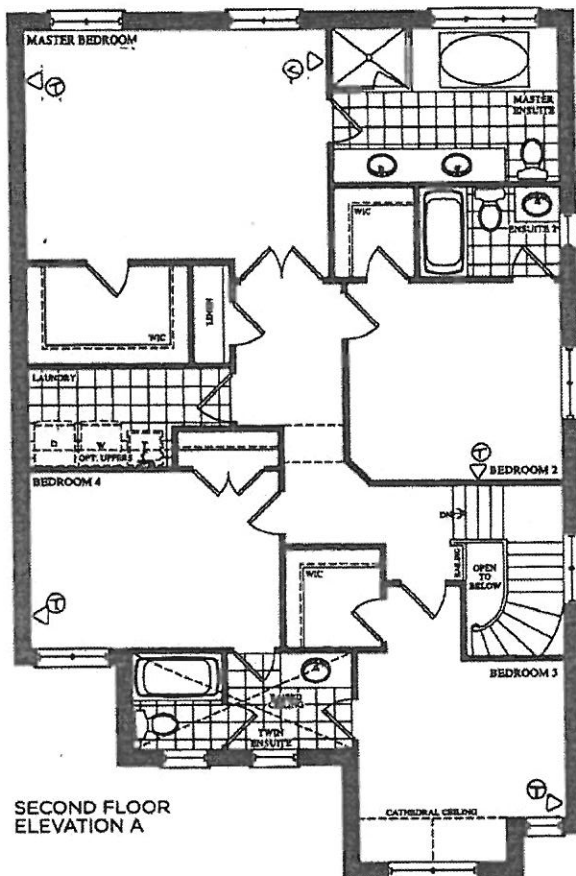

Prices, figures, illustrations, sizes, features and finishes are subject to change without notice. E.&O.E. Areas and dimensions are approximate and actual usable floor space may vary from the stated area. Layout may be reverse of the unit purchased. E. & O.E.

GOLDPARK
HOMES