



CONSTRUCTION SUMMARY

Lot: 133

Model: 50.06 A SILVERWOOD

Project/Phase: Pine Valley Forevergreen / 1

APPLIANCES

Invoice	Qty.	Description
2276 32163	1	KITCHEN - UPGRADE TO 8" DUCT (INTERIOR WALL) IN LIEU OF STANDARD OFFERING
**		HVAC 72,218 APPLIANCES

DRYWALL

Invoice	Qty.	Description
2276 32621	2	GARAGE DOOR OPENER (CHAMBERLAIN BELT DRIVE) - WITH 1 REMOTE - PRICE IS PER DOOR
**		GARAGE DOORS 72,324 DRYWALL
2276 32620	2	INSULATION KIT - SINGLE DOOR (8 FOOT -10 FOOT WIDE) EACH
**		GARAGE DOORS 72,325 DRYWALL
2276 32166	1	THRU OUT: UPGRADE TO ROUNDED CORNERS ENTIRE HOUSE
**		DRYWALL 72,371
2276 32622	1	FAMILY ROOM - OPT. COFFERED CEILING AS PER PLAN
**		MODEL OPTIONS 50.06 72,609 DRYWALL
2276 32623	1	FAMILY ROOM - OPT. WAFFLE CEILING, BEAM DETAIL AS PER PLAN (6 BOXES) OPTION#1 CTR-B07
**		MODEL OPTIONS 50.06 72,608 DRYWALL

ELECTRICAL

Invoice	Qty.	Description
2276 32154 **	2	WIRELESS KEYPAD GARAGE DOOR ENTRY 877LM GARAGE DOORS ONE PER GARAGE DOOR 72,323 ELECTRICAL
2276 32157 NoCat	4	***CUSTOM*** LIBRARY / DINING / BREAKFAST / MASTER BEDROOM: REINFORCE STANDARD CEILING OUTLET FOR FUTURE LIGHTS ELECTRICAL 72,373
2276 32622 **	1	FAMILY ROOM - OPT. COFFERED CEILING AS PER PLAN MODEL OPTIONS 50.06 72,609 ELECTRICAL
2276 32623 **	1	FAMILY ROOM - OPT. WAFFLE CEILING, BEAM DETAIL AS PER PLAN (6 BOXES) OPTION#1 CTR-B07 MODEL OPTIONS 50.06 72,608 ELECTRICAL

ELECTRICAL APPLIANCES

Invoice	Qty.	Description
2276 32129	1	KITCHEN: 110V WALL RECEPTACLE ON SEPARATE CIRCUIT - GAS FIRED APPLIANCE (COOKTOP) - FOR AUX. EQUIPMENT - NOT A STOVE PLUG ELECTRICAL APPLIANCES 72,273

ELECTRICAL INTERIOR

Invoice	Qty.	Description	
2276 32104	1	FAMILY ROOM: INTERIOR WALL ADDITIONAL 110V WALL INTERIOR RECEPTACLE ON EXISTING CIRCUIT FOR WALL MOUNTED TV - LOCATE ABOVE FIREPLACE, APPROX. 66" A.F.F. ELECTRICAL INTERIOR	72,281
2276 32112	1	MASTER BEDROOM: INTERIOR WALL OUTLET: ADDITIONAL 110V WALL INTERIOR RECEPTACLE ON EXISTING CIRCUIT FOR WALL MOUNTED TV - LOCATE APPROX.66" A.F.F. - SEE PLAN ELECTRICAL INTERIOR	72,281
2276 32113	1	MASTER BEDROOM: *IN ADDITION TO ELECTRICAL RECEPTACLE ON EXTERIOR WALL* ADD INTERIOR WALL OUTLET: 110V WALL INTERIOR RECEPTACLE ON EXISTING CIRCUIT, SEE PLAN FOR LOCATION ELECTRICAL INTERIOR	72,268
2276 32114	1	MASTER ENSUITE: INTERIOR WALL OUTLET: ADDITIONAL INTERIOR GFI RECEPTACLE - LOCATE *BEHIND TOILET* APPROX RIGHT OF CENTER, APPROX. 9" FROM CENTER AND 9" A.F.F. ELECTRICAL INTERIOR	72,285
2276 32127	2	SERVERY: IN ADDITION TO STANDARD COUNTER RECEPTACLE, ADD (3) INTERIOR WALL OUTLETS: ADDITIONAL SPLIT CIRCUIT RECEPTACLE (IN KITCHEN ABOVE COUNTER).- (TOTAL 3) LOCATE 2 AT RIGHT SIDE AND 1 IN APPROX. CENTER ELECTRICAL INTERIOR	72,284
2276 32128	1	KITCHEN: 240V WALL RECEPTACLE ON SEPARATE CIRCUIT FOR WALL OVENS - SEE PLAN FOR LOCATION ELECTRICAL INTERIOR	72,275
2276 32131	1	KITCHEN: INTERIOR WALL OUTLET: 110V WALL INTERIOR RECEPTACLE ON SEPARATE CIRCUIT FOR BUILT-IN FREEZER ELECTRICAL INTERIOR	72,269
2276 32144	1	KITCHEN ISLAND: INTERIOR WALL OUTLET: 110V WALL INTERIOR RECEPTACLE ON SEPARATE CIRCUIT ELECTRICAL INTERIOR FOR FUTURE MICROWAVE DRAWER IN ISLAND	72,269
2276 32155	1	LAUNDRY: ADD INTERIOR WALL OUTLET: ADDITIONAL INTERIOR GFI RECEPTACLE - LOCATE APPROX. 42" A.F.F. -SEE PLAN FOR LOCATION ELECTRICAL INTERIOR	72,285
2276 32162	1	KITCHEN: FIXTURE: UNDER CABINET FLUORESCENT LIGHT FIXTURES - DOES NOT INCLUDE (AND REQUIRES) LIGHT VALANCE ELECTRICAL INTERIOR	72,303
2276 32596	5	LIBRARY / DINING ROOM / BREAKFAST ROOM / FAMILY ROOM / MASTER BEDROOM: CEILING OUTLET: ADDITIONAL REINFORCED CEILING OUTLET - SEE PLAN FOR LOCATION ELECTRICAL INTERIOR	72,280



CONSTRUCTION SUMMARY

Lot: 133

Model: 50.06 A SILVERWOOD

Project/Phase: Pine Valley Forevergreen / 1

ELECTRICAL POTLIGHT

Invoice	Qty.	Description
2276 32117	1	FOYER: UPGRADE STANDARD CEILING MOUNT FIXTURE TO (1) LED POT LIGHT - GROUND FLOOR - SEE PLAN FOR LOCATION ELECTRICAL POTLIGHT 72,309
2276 32118	4	FOYER: ADD 4" E/S LED INTERIOR POT LIGHT - GROUND FLOOR - EACH ELECTRICAL POTLIGHT 72,289 USE SAME SWITCH AS STANDARD LIGHT
2276 32119	2	MAIN HALL/SIDE HALL: UPGRADE STANDARD CEILING MOUNT FIXTURE TO (1) LED POT LIGHT - GROUND FLOOR - MUST SPECIFY LOCATION (CAN BE RELOCATED) ELECTRICAL POTLIGHT 72,309
2276 32120	4	MAIN HALL/SIDE HALL: 4" E/S LED INTERIOR POT LIGHT - GROUND FLOOR - EACH ELECTRICAL POTLIGHT 72,289 USE SAME SWITCH AS STANDARD LIGHTS
2276 32121	1	KITCHEN: UPGRADE STANDARD CEILING MOUNT FIXTURE TO (1) LED POT LIGHT - GROUND FLOOR - *ABOVE ISLAND* SEE PLAN FOR LOCATION ELECTRICAL POTLIGHT 72,309
2276 32122	3	KITCHEN: 4" E/S LED INTERIOR POT LIGHT - GROUND FLOOR - EACH *LOCATE ABOVE ISLAND*, SEE PLAN FOR LOCATION ELECTRICAL POTLIGHT 72,289 USE SAME SWITCH AS STANDARD LIGHT
2276 32123	2	KITCHEN: 4" E/S LED INTERIOR POT LIGHT - GROUND FLOOR - EACH SEE PLAN FOR LOCATION ELECTRICAL POTLIGHT 72,289 USE SAME SWITCH AS STANDARD
2276 32124	6	KITCHEN: 4" E/S LED INTERIOR POT LGIHT - GROUND FLOOR - EACH ELECTRICAL POTLIGHT 72,278 INCLUDED IN APS
2276 32125	1	SERVERY: UPGRADE STANDARD CEILING MOUNT FIXTURE TO (1) LED POT LIGHT - GROUND FLOOR - SEE PLAN FOR LOCATION ELECTRICAL POTLIGHT 72,309
2276 32126	1	SERVERY: 4" E/S LED INTERIOR POT LIGHT - GROUND FLOOR - EACH ELECTRICAL POTLIGHT 72,289 USE SAME SWITCH AS STANDARD LIGHT
2276 32132	1	POWDER ROOM: UPGRADE STANDARD CEILING MOUNT FIXTURE TO (1) LED POT LIGHT - GROUND FLOOR - MUST SPECIFY LOCATION (CAN BE RELOCATED) ELECTRICAL POTLIGHT 72,309

ELECTRICAL POTLIGHT

Invoice	Qty.	Description
2276 32134	1	POWDER ROOM: 4" E/S LED INTERIOR POT LIGHT - GROUND FLOOR - EACH ELECTRICAL POTLIGHT 72,289 SAME SWITCH AS STANDARD LIGHT
2276 32135	1	ENSUITE 2: UPGRADE STANDARD CEILING MOUNT FIXTURE TO (1) LED POT LIGHT - GROUND FLOOR - SEE PLAN FOR LOCATION ELECTRICAL POTLIGHT 72,309
2276 32136	2	ENSUITE 2: 4" E/S LED INTERIOR POT LIGHT - GROUND FLOOR - EACH ELECTRICAL POTLIGHT 72,289 SAME SWITCH AS STANDARD LIGHT
2276 32137	1	MASTER BEDROOM 'ANTE ROOM': UPGRADE STANDARD CEILING MOUNT FIXTURE TO (1) LED POT LIGHT - GROUND FLOOR - SEE PLAN FOR LOCATION ELECTRICAL POTLIGHT 72,309
2276 32138	1	MASTER WIC: UPGRADE STANDARD CEILING MOUNT FIXTURE TO (1) LED POT LIGHT - GROUND FLOOR - SEE PLAN FOR LOCATION ELECTRICAL POTLIGHT 72,309
2276 32139	2	MASTER WIC: 4" E/S LED INTERIOR POT LIGHT - GROUND FLOOR - EACH ELECTRICAL POTLIGHT 72,289
2276 32140	2	MASTER ENSUITE: UPGRADE STANDARD CEILING MOUNT FIXTURE TO (1) LED POT LIGHT - GROUND FLOOR - SEE PLAN FOR LOCATION ELECTRICAL POTLIGHT 72,309
2276 32141	7	MASTER ENSUITE: 4" E/S LED INTERIOR POT LIGHT - GROUND FLOOR - EACH ELECTRICAL POTLIGHT 72,289 USE SAME SWITCH AS STANDARD
2276 32142	1	MASTER WC: UPGRADE STANDARD CEILING MOUNT FIXTURE TO (1) LED POT LIGHT - GROUND FLOOR - SEE PLAN FOR LOCATION ELECTRICAL POTLIGHT 72,309
2276 32143	1	MASTER WC: 4" E/S LED INTERIOR POT LIGHT - GROUND FLOOR - EACH ELECTRICAL POTLIGHT 72,289 USE SAME SWITCH AS STANDARD



CONSTRUCTION SUMMARY

Lot: 133

Model: 50.06 A SILVERWOOD

Project/Phase: Pine Valley Forevergreen / 1

ELECTRICAL ROUGH-IN

Invoice	Qty.	Description
2276 32598 ✓	1	LOGGIA: ROUGH-IN FOR CEILING FAN COMPLETE WITH 1 SWITCH ELECTRICAL ROUGH-IN SEE PLAN FOR LOCATION 72,299

Invoice	Qty.	Description

FRAMING

Invoice	Qty.	Description
2276 32106 NoCat	1	***CUSTOM LAYOUT*** FAMILY ROOM: RELOCATE FIREPLACE TO EXTERIOR WALL - SEE PLAN FOR LOCATION FRAMING FIREPLACE TO BE BUMPED INTO ROOM AND BOX OUT DOUBLE-HEIGHT TO CEILING. SEE ATTACHED SKETCH
2276 32107 NoCat	1	***CUSTOM REQUEST*** MASTER BEDROOM: DELETE GARDEN DOORS FROM MASTER BEDROOM, FINISH WALL AS PER STANDARD FINISHES. FRAMING
2276 32145 NoCat	1	MASTER ENSUITE: SHOWER BENCH COMPLETE WITH STANDARD TILE AND MATCHING MARBLE JAMB COLOUR SEAT TOP - SEE PLAN FOR LOCATION FRAMING
2276 32146 NoCat	1	MASTER ENSUITE: SHOWER NICHE [SHAMPOO SHELF] - COMPLETE WITH MATCHING MARBLE JAMBS ON 4 SIDES, STANDARD TILE, APPROX. 12 X 18 INSTALLED VERTICALLY - SEE PLAN FOR LOCATION FRAMING
2276 32147 NoCat	1	ENSUITE 2: SHOWER NICHE [SHAMPOO SHELF] - COMPLETE WITH MATCHING MARBLE JAMBS ON 4 SIDES, STANDARD TILE, APPROX. 12 X 18 INSTALLED VERTICALLY - SEE PLAN FOR LOCATION FRAMING
2276 32148 NoCat	1	SHARED BATH: SHOWER NICHE [SHAMPOO SHELF] - COMPLETE WITH MATCHING MARBLE JAMBS ON 4 SIDES, STANDARD TILE, APPROX. 12 X 18 INSTALLED VERTICALLY - SEE PLAN FOR LOCATION FRAMING
2276 32149 NoCat	1	***CUSTOM LAYOUT*** SHARED BATHROOM, REVISE LAYOUT - RELOCATE DOOR FROM BEDROOM 4 TO HALLWAY & CHANGE LOCATION OF VANITY TO ADJACENT TO SHOWER. SEE PLAN FOR REVISED LAYOUT FRAMING
2276 32158 NoCat	1	***CUSTOM*** FAMILY ROOM: REINFORCE/BLOCK WALL FOR FUTURE TV FRAMING
2276 32593 NoCat	1	***CUSTOM LAYOUT*** 2ND FLOOR LOFT: ADD FULL WALL AT UPPER HALL & (OTB) FAMILY ROOM FRAMING JULIETTE BALCONY WITH RAILING AT FRENCH DOORS



CONSTRUCTION SUMMARY

Lot: 133

Model: 50.06 A SILVERWOOD

Project/Phase: Pine Valley Forevergreen / 1

GARAGE DOORS

Invoice	Qty.	Description
2276 32621	2	GARAGE DOOR OPENER (CHAMBERLAIN BELT DRIVE) - WITH 1 REMOTE - PRICE IS PER DOOR GARAGE DOORS72,324GARAGE DOORS
2276 32620	2	INSULATION KIT - SINGLE DOOR (8 FOOT -10 FOOT WIDE) EACH GARAGE DOORS72,325GARAGE DOORS
2276 32154	2	WIRELESS KEYPAD GARAGE DOOR ENTRY 877LM GARAGE DOORS72,323GARAGE DOORS ONE PER GARAGE DOOR

HVAC

Invoice	Qty.	Description
2276 32130	1	KITCHEN: GAS LINE ROUGH-IN - MAIN FLOOR FOR GAS COOKTOP - SEE PLAN FOR LOCATION HVAC72,224
2276 32163	1	KITCHEN - UPGRADE TO 8" DUCT (INTERIOR WALL) IN LIEU OF STANDARD OFFERING HVAC72,218HVAC

INTERIOR DOORS

Invoice	Qty.	Description
2276 32152	1	DINING ROOM/SERVERY: ADD SINGLE #205 POCKET DOOR, COMPLETE WITH BUILDERS STANDARD OFFERINGS INTERIOR DOORS72,660
2276 32595 NoCat	13	***CUSTOM LAYOUT***GROUND FLOOR: INCREASE DOOR HEIGHT TO 9' SOLID CORE DOORS INTERIOR DOORS
2276 32618	2	2ND FLOOR LOFT: DOUBLE FRENCH DOOR #203 BEVEL GLASS COMPLETE WITH BUILDERS STANDARD OFFERINGS INTERIOR DOORS72,649 SEE PLAN FOR LOCATION
2276 32619	12	2ND FLOOR: ADDITIONAL FOR OVER HEIGHT SINGLE DOOR UP TO 8 FOOT INTERIOR DOORS72,642



CONSTRUCTION SUMMARY

Lot: 133

Model: 50.06 A SILVERWOOD

Project/Phase: Pine Valley Forevergreen / 1

INTERIOR TRIM /MOULDINGS

Invoice	Qty.	Description
2276 32622	1	FAMILY ROOM - OPT. COFFERED CEILING AS PER PLAN
**		MODEL OPTIONS 50.0672,609INTERIOR TRIM /MOULDINGS
2276 32623	1	FAMILY ROOM - OPT. WAFFLE CEILING, BEAM DETAIL AS PER PLAN (6 BOXES) OPTION#1 CTR-B07
**		MODEL OPTIONS 50.0672,608INTERIOR TRIM /MOULDINGS

KITCHEN AND BATH CABINETRY

Invoice	Qty.	Description
2276 32163	1	KITCHEN - UPGRADE TO 8" DUCT (INTERIOR WALL) IN LIEU OF STANDARD OFFERING
**		HVAC72,218KITCHEN AND BATH CABINETRY

MISC.

Invoice	Qty.	Description
2201 31358	1	
NoCat		

MODEL OPTIONS 40.01

Invoice	Qty.	Description
2276 32622	1	FAMILY ROOM - OPT. COFFERED CEILING AS PER PLAN
**		MODEL OPTIONS 50.0672,609MODEL OPTIONS 40.01

MODEL OPTIONS 50.06

Invoice	Qty.	Description
2276 32622	1	FAMILY ROOM - OPT. COFFERED CEILING AS PER PLAN
		MODEL OPTIONS 50.0672,609MODEL OPTIONS 50.06
2276 32623	1	FAMILY ROOM - OPT. WAFFLE CEILING, BEAM DETAIL AS PER PLAN (6 BOXES) OPTION#1 CTR-B07
		MODEL OPTIONS 50.0672,608MODEL OPTIONS 50.06

NETWORK AND WIRING

Invoice	Qty.	Description
2276 32102	1	CONDUIT PIPE - FROM ATTIC TO BASEMENT - APPROX CENTER OF ATTIC TO ELECTRICAL PANEL IN BASEMENT NETWORK AND WIRING 72,260
2276 32103	1	FAMILY ROOM: ADDITIONAL CAT6 ETHERNET OUTLET - EACH SEE PLAN FOR LOCATION NETWORK AND WIRING 72,258
2276 32105	1	FAMILY ROOM: CONDUIT PIPE - FOR WALL MOUNT TV - LOCATE APPROX. 66" A.F.F. ABOVE FIREPLACE, TERMINATING AT CABLE LOCATION - SEE PLAN NETWORK AND WIRING 72,259
2276 32108	1	LIBRARY: ADDITIONAL CAT6 ETHERNET OUTLET - EACH SEE PLAN FOR LOCATION NETWORK AND WIRING 72,258
2276 32110	1	MASTER BEDROOM: ADDITIONAL CAT6 ETHERNET OUTLET - EACH LOCATE APPROX. 66" A.F.F. - SEE PLAN FOR LOCATION NETWORK AND WIRING 72,258
2276 32111	1	MASTER BEDROOM: CONDUIT PIPE - FOR WALL MOUNT TV - LOCATE APPROX. 66" A.F.F., TERMINATING AT CABLE LOCATION - SEE PLAN NETWORK AND WIRING 72,259
2276 32115	1	BEDROOM 2: ADDITIONAL CAT6 ETHERNET OUTLET - EACH SEE PLAN FOR LOCATION NETWORK AND WIRING 72,258
2276 32116	1	BEDROOM 2: ADDITIONAL RG6 HIGH SPEED TV / INTERNET OUTLETS SEE PLAN FOR LOCATION NETWORK AND WIRING 72,256
2276 32150	1	2ND FLOOR LOFT: ADDITIONAL CAT6 ETHERNET OUTLET - EACH SEE PLAN FOR LOCATION NETWORK AND WIRING 72,258
2276 32151	1	2ND FLOOR LOFT: ADDITIONAL RG6 HIGH SPEED TV / INTERNET OUTLETS SEE PLAN FOR LOCATION NETWORK AND WIRING 72,256



CONSTRUCTION SUMMARY

Lot: 133

Model: 50.06 A SILVERWOOD

Project/Phase: Pine Valley Forevergreen / 1

PAINTING

Invoice	Qty.	Description
2276 32622	1	FAMILY ROOM - OPT. COFFERED CEILING AS PER PLAN
**		MODEL OPTIONS 50.06 72,609 PAINTING
2276 32623	1	FAMILY ROOM - OPT. WAFFLE CEILING, BEAM DETAIL AS PER PLAN (6 BOXES) OPTION#1 CTR-B07
**		MODEL OPTIONS 50.06 72,608 PAINTING

PANL - FRAMING

Invoice	Qty.	Description
2276 32621	2	GARAGE DOOR OPENER (CHAMBERLAIN BELT DRIVE) - WITH 1 REMOTE - PRICE IS PER DOOR
**		GARAGE DOORS 72,324 PANL - FRAMING
2276 32620	2	INSULATION KIT - SINGLE DOOR (8 FOOT -10 FOOT WIDE) EACH
**		GARAGE DOORS 72,325 PANL - FRAMING
2276 32622	1	FAMILY ROOM - OPT. COFFERED CEILING AS PER PLAN
**		MODEL OPTIONS 50.06 72,609 PANL - FRAMING
2276 32623	1	FAMILY ROOM - OPT. WAFFLE CEILING, BEAM DETAIL AS PER PLAN (6 BOXES) OPTION#1 CTR-B07
**		MODEL OPTIONS 50.06 72,608 PANL - FRAMING

PLUMBING

Invoice	Qty.	Description
2276 32590 NoCat	1	***CUSTOM LAYOUT*** MASTER ENSUITE SHOWER: LOCATE SHOWER VALVE ON WC WALL - SEE PLAN FOR PREFERRED LOCATION PLUMBING
2276 32591 NoCat	1	***CUSTOM LAYOUT*** ENSUITE 2 SHOWER: LOCATE SHOWER VALVE ON CLOSET WALL - SEE PLAN FOR PREFERRED LOCATION PLUMBING
2276 32592 NoCat	1	***CUSTOM LAYOUT*** SHARED ENSUITE SHOWER: LOCATE SHOWER VALVE ON VANITY WALL - SEE PLAN FOR PREFERRED LOCATION PLUMBING
2276 32624 NoCat	1	**REVISED LAYOUT** CHANGE LAUNDRY TO STACKING - SEE PLAN FOR PREFERRED ORIENTATION PLUMBING REQUIRED DUE TO SITE CONDITION
2276 32625 NoCat	1	MUD ROOM: ADDITIONAL LAUNDRY TUB - BUILDERS STANDARD OFFERING PLUMBING MAY UPGRADE TO CABINETRY AT COLOUR APPOINTMENT

ROUGH CARPENTRY

Invoice	Qty.	Description
2276 32622 **	1	FAMILY ROOM - OPT. COFFERED CEILING AS PER PLAN MODEL OPTIONS 50.06 72,609 ROUGH CARPENTRY
2276 32623 **	1	FAMILY ROOM - OPT. WAFFLE CEILING, BEAM DETAIL AS PER PLAN (6 BOXES) OPTION#1 CTR-B07 MODEL OPTIONS 50.06 72,608 ROUGH CARPENTRY

Invoice	Qty.	Description

SCHEDULE 'F'



PV-133
April 21, 2020


The Silverwood

50' SERIES

Elevation A • 3,545 sq.ft.
Elevation B • 3,465 sq.ft.

91 DOORS
on MAIN FLOOR

GAS
FIREPLACE
BORED OUT
to ceiling
66" AFF

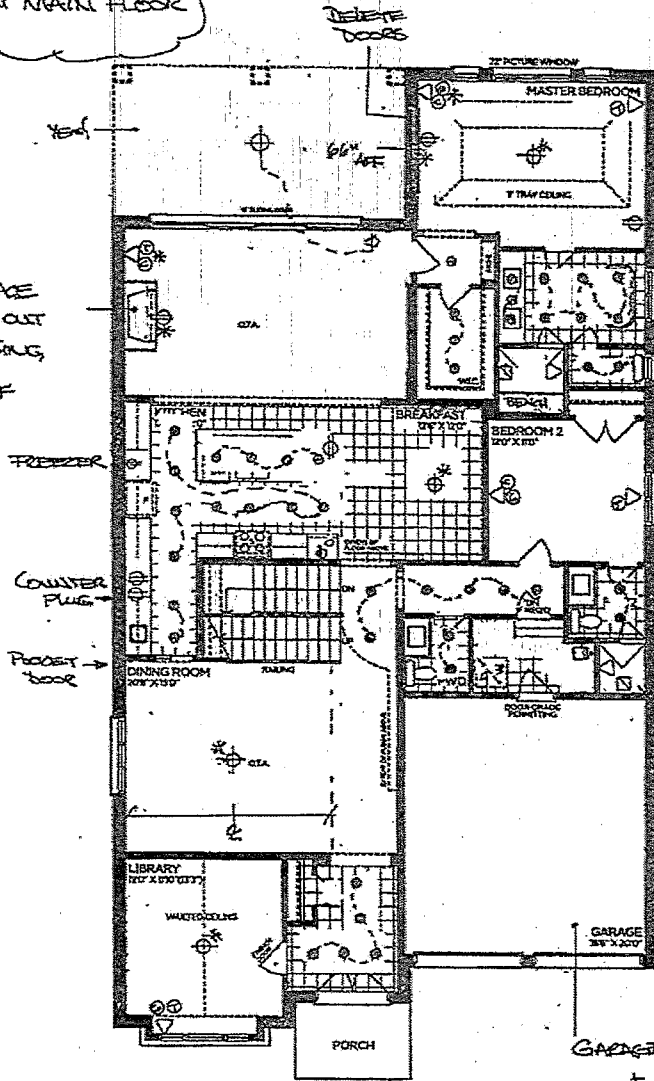

GROUND FLOOR | ELEV. A

GARAGE DOORS
+
KEY FOR (both doors)

VENDOR
PURCHASER
PURCHASER

GOLDPARK
WORTH MORE™

Prices, figures, illustrations, sizes, features and finishes are subject to change without notice. Areas and dimensions are approximate and actual usable floor space may vary from the stated area. Layout may be reverse of the unit purchased. E. & O.E. 5005

SCHEDULE 'F'



PV-DBS
April 20, 2022


The Silverwood

50' SERIES

→ Elevation A • 3,545 sq.ft.
Elevation B • 3,465 sq.ft.

8' DOORS
on 2nd Floor

- LEGEND**
- △ VALVE
 - KITCHEN
 - ⊙ PHONE
 - ⊙ CABLE
 - ⊙ CAT 6
 - ⊙ ELECT. OUTLET
 - * 2" COUNTOUT
 - POTLIGHT
 - * REINFORCED CEILING LIGHT

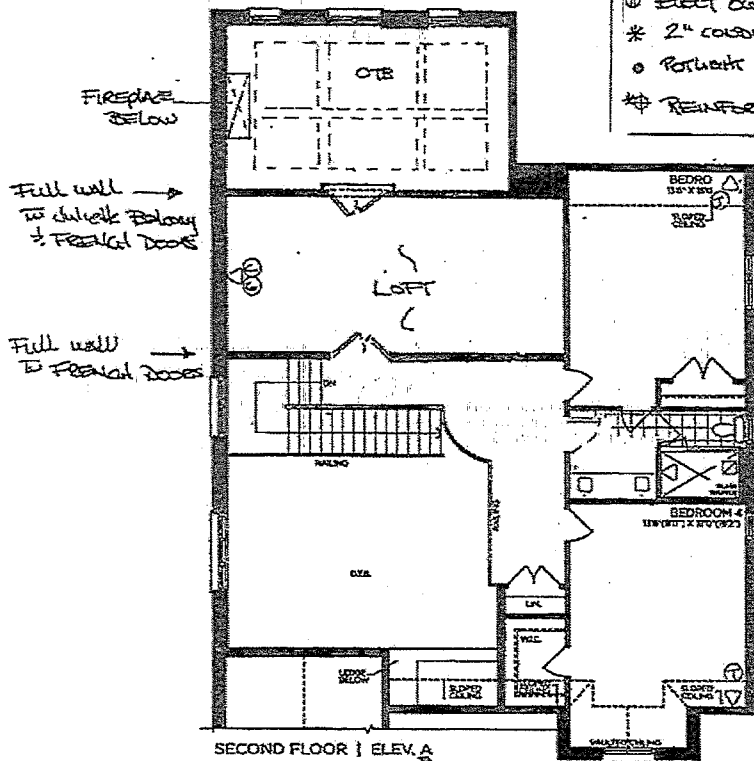

VENDOR
PURCHASER
PURCHASER

GOLDPARK
WORTH MORE

Prices, figures, illustrations, sizes, features and finishes are subject to change without notice. Areas and dimensions are approximate and actual usable floor space may vary from the stated area. Layout may be reverse of the unit purchased. E.A.C.E. 5006


SCHEDULE 'F'



The Silverwood
50' SERIES

Elevation A • 3,545 sq.ft.
Elevation B • 3,465 sq.ft.


PV-153
April 21, 2020

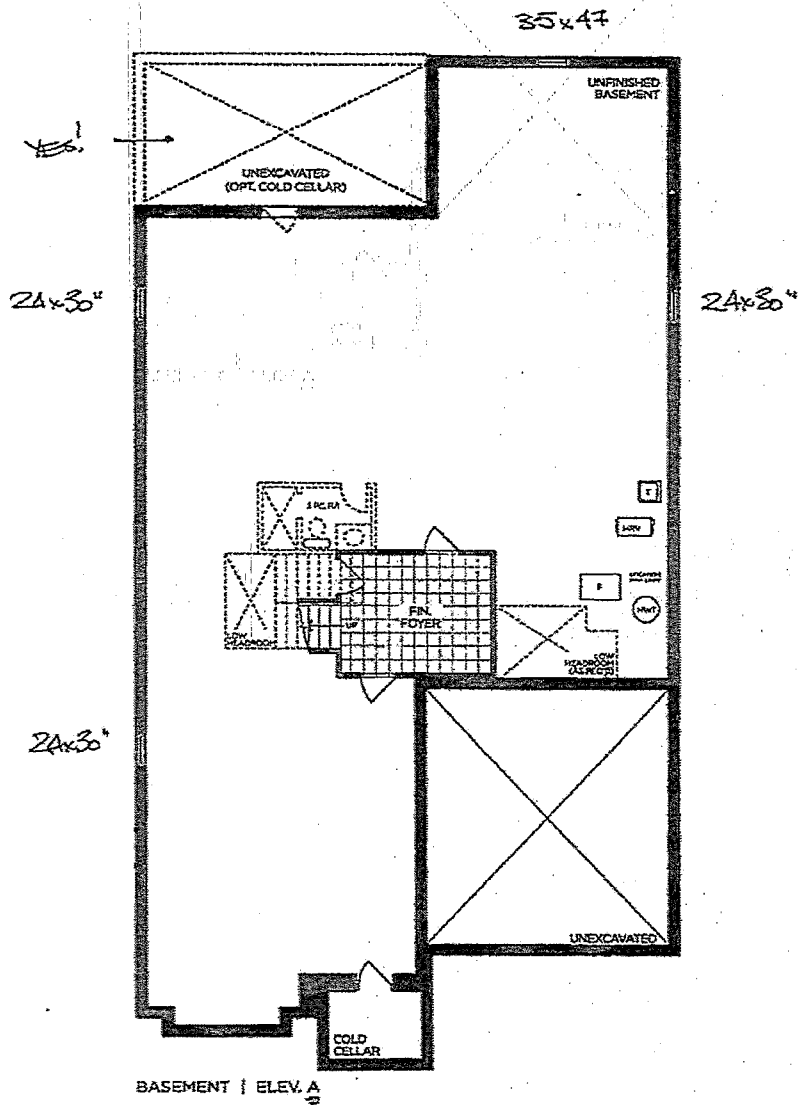

VENDOR
PURCHASER
PURCHASER

GOLDPARK
WORTH MORE™

Prices, figures, illustrations, sizes, features and finishes are subject to change without notice. Areas and dimensions are approximate and actual usable floor space may vary from the stated area. Layout may be reverse of the unit purchased. E & OE 500%.

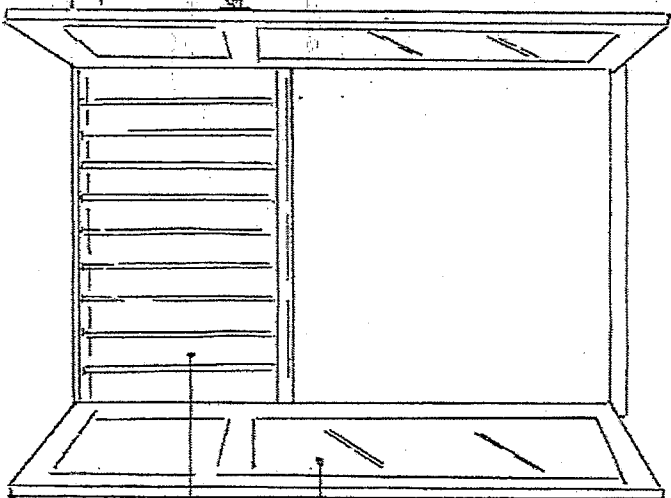

TRIPLE DOORS.

Juliette Bakery

April 21 2020
PN-138

LOFT with Juliette Bakery
OVER. LOOKING FAMILY ROOM BELOW