

GOLDPARK

WORTH MORE™

CONSTRUCTION SUMMARY

Lot: 119

Model: 38-4 Elev.B VIVALDI

Project/Phase: Brampton Encore / 2

CENTRAL VAC AND WIRING

Invoice	Qty.	Description
2243 31819 21Apr20	1	FAMILY ROOM: CONDUIT PIPE- FOR TELEVISION- LOCATE APPROX. 66' A.F.F. ABOVE FIREPLACE, TERMINATING AT CABLE LOCATION

CONCRETE AND DRAIN

Invoice	Qty.	Description
2243 32628 21Apr20 NoCat	1	3PC BASEMENT ROUGH-IN

ELECTRICAL

Invoice	Qty.	Description
2243 31821 21Apr20	1	FAMILY ROOM: 110V WALL RECEPTACLE ON DEDICATED CIRCUIT- LOCATE APPROX. 66" A.F.F. ABOVE FIREPLACE
2243 31823 21Apr20 NoCat	2	KITCHEN: ADD CAPPED CEILING OUTLET, APPROX CENTERED ABOVE ISLAND
2243 31824 21Apr20 NoCat	1	KITCHEN: SINGLE POLE SWITCH FOR ISLAND LIGHTS
2243 31825 21Apr20 NoCat	1	POWDER ROOM: ADD CAPPED CEILING OUTLET, APPROX CENTER OF CEILING - USE SAME SWITCH AS VANITY LIGHT
2243 31826 21Apr20 NoCat	4	FAMILY ROOM: CAPPED CEILING OUTLET - SEE PLAN FOR LOCATION (NOTE: PURCHASER TO CHANGE TO POTLIGHTS AFTER CLOSING) SAME SWITCH AS STANDARD CEILING LIGHT
2243 32247 21Apr20 NoCat	5	KITCHEN: CAPPED CEILING OUTLET (PURCHASER TO CHANGE TO POTLIGHT AFTER CLOSING)
2243 32249 21Apr20 NoCat	4	BREAKFAST ROOM: CAPPED CEILING OUTLET (PURCHASER TO CHANGE TO POTLIGHTS AFTER CLOSING) LOCATE APPROX 30" FROM EACH WALL
2243 32250 21Apr20 NoCat	1	BREAKFAST: SINGLE POLE SWITCH FOR CAPPED CEILING OUTLETS

EXTERIOR COLOURS

Invoice	Qty.	Description
2243 32603 21Apr20 NoCat	1	EXTERIOR COLOUR PACKAGE # 2

ryDiscipline.rpt 14Mar20

Page 1 of 3

GOLDPARK

WORTH MORE™

CONSTRUCTION SUMMARY

Lot: 119

Model: 38-4 Elev.B VIVALDI

Project/Phase: Brampton Encore / 2

FORMING

Invoice	Qty.	Description
2243 31833 21Apr20 **	2	BASEMENT WINDOWS - UPGRADE EXISTING BASEMENT WINDOW TO 30 INCH X 24 INCH - MAY REQUIRE INSTALLATION OF WINDOW WELL

FRAMING

Invoice	Qty.	Description
2243 32616 21Apr20 NoCat	4	MAIN FLOOR; EXTENDED HEIGHT ARCHWAYS -96"
2243 32617 21Apr20 NoCat	1	BREAKFAST ROOM: 12" SIDELITES FOR 80" OPENING - (SLIDING DOOR WITH 2 FIXED PANELS)

INTERIOR TRIM AND DOORS

Invoice	Qty.	Description
2243 31836 21Apr20	4	MAIN FLOOR; EXTENDED HEIGHT ARCHWAY (PRICE PER DOORWAY) -96"
2243 31837 21Apr20	4	MAIN FLOOR; STANDARD DOOR EXTENDED HEIGHT 96" (PRICE PER DOOR)- GROUND FLOOR 2 STOREY MODELS

KITCHEN AND BATH CABINETRY

Invoice	Qty.	Description
2243 32248 21Apr20 NoCat	1	KITCHEN: SINGLE POLE SWITCH FOR CAPPED CEILING LIGHTS - SEE PLAN

MISC.

Invoice	Qty.	Description
2243 31846 21Apr20 NoCat	1	BONUS PACKAGE: \$10,000.00 (INCLUDING TAXES) WORTH OF UPGRADES FROM GOLD PARK HOMES DÉCOR CENTRE IS BEING APPLIED TOWARD THIS ORDER. PURCHASER HAS A REMAINING AMOUNT OF \$00 (INCLUDING TAXES).

PLUMBING

Invoice	Qty.	Description
2243 32627 21Apr20 NoCat	1	3PC BASEMENT ROUGH-IN

ryDiscipline.rpt 14Mar20


Page 2 of 3

BEZ-119 ~~see attached~~
APRIL 9 2020

The
Vivaldi
38' SERIES

Elevation A • 2,518 sq.ft. | Elevation B • 2,518 sq.ft.



LOOK OUT BASEMENT.

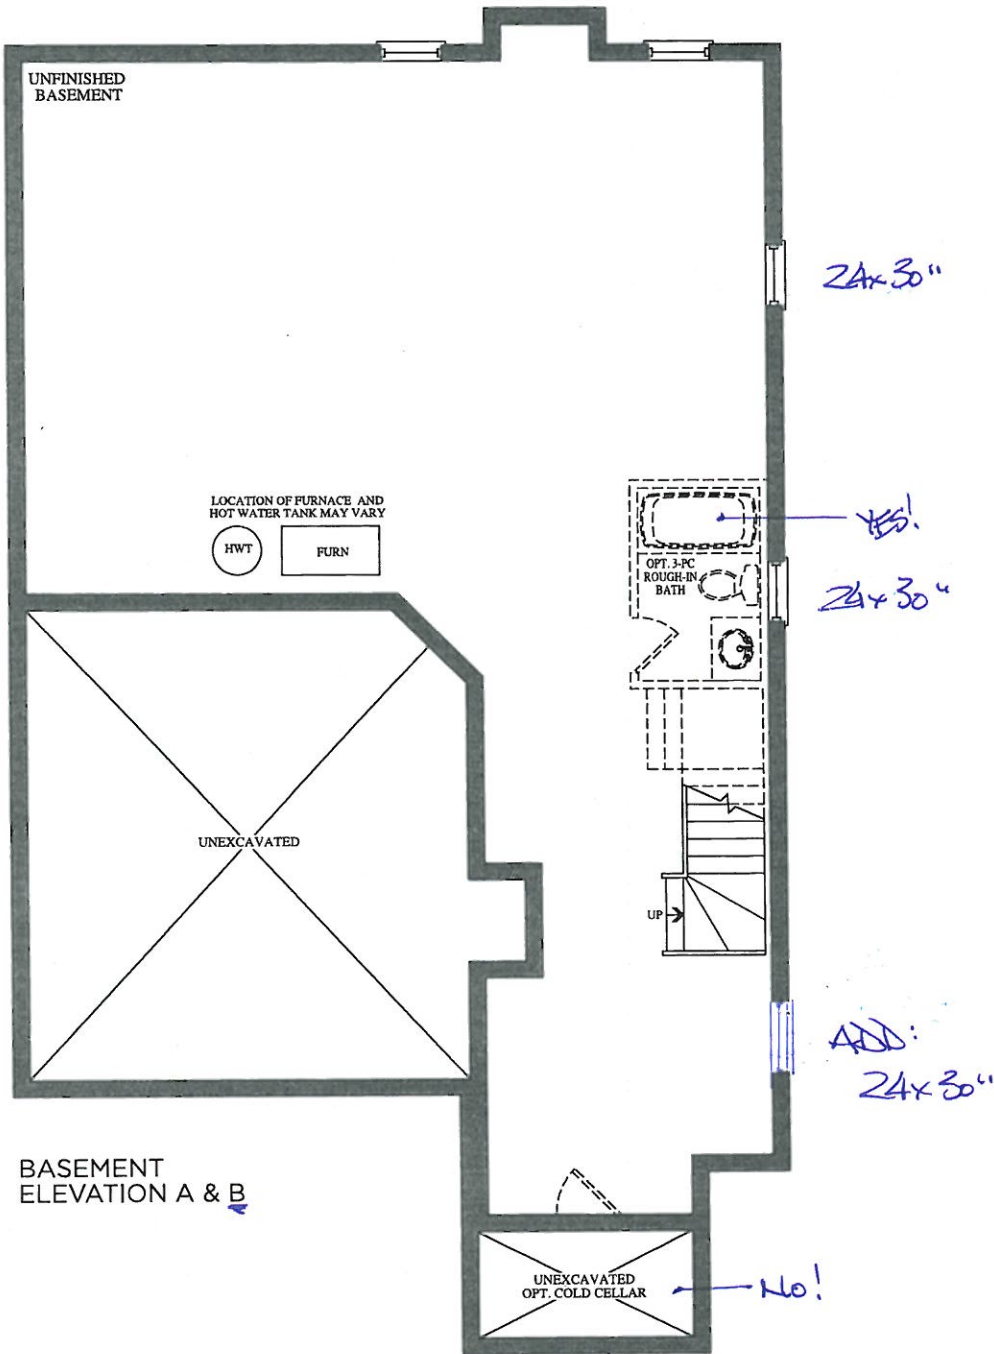

BE2-119.
April 2020
See attached

The
Vivaldi
38' SERIES

Elevation A • 2,518 sq.ft. | Elevation B • 2,518 sq.ft.

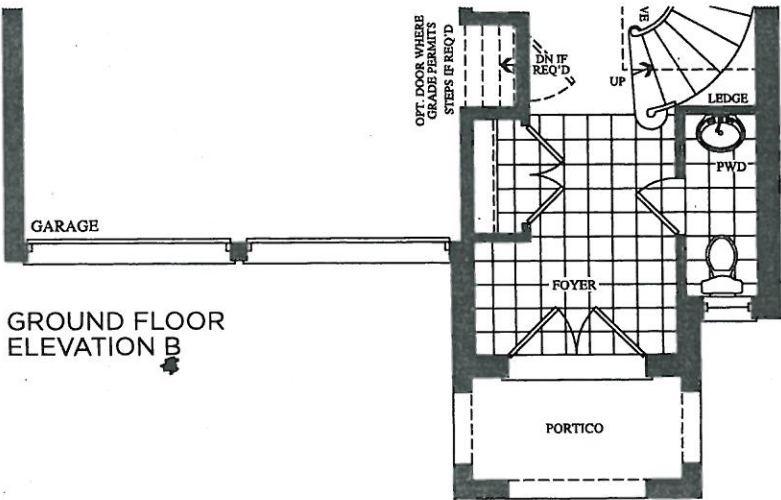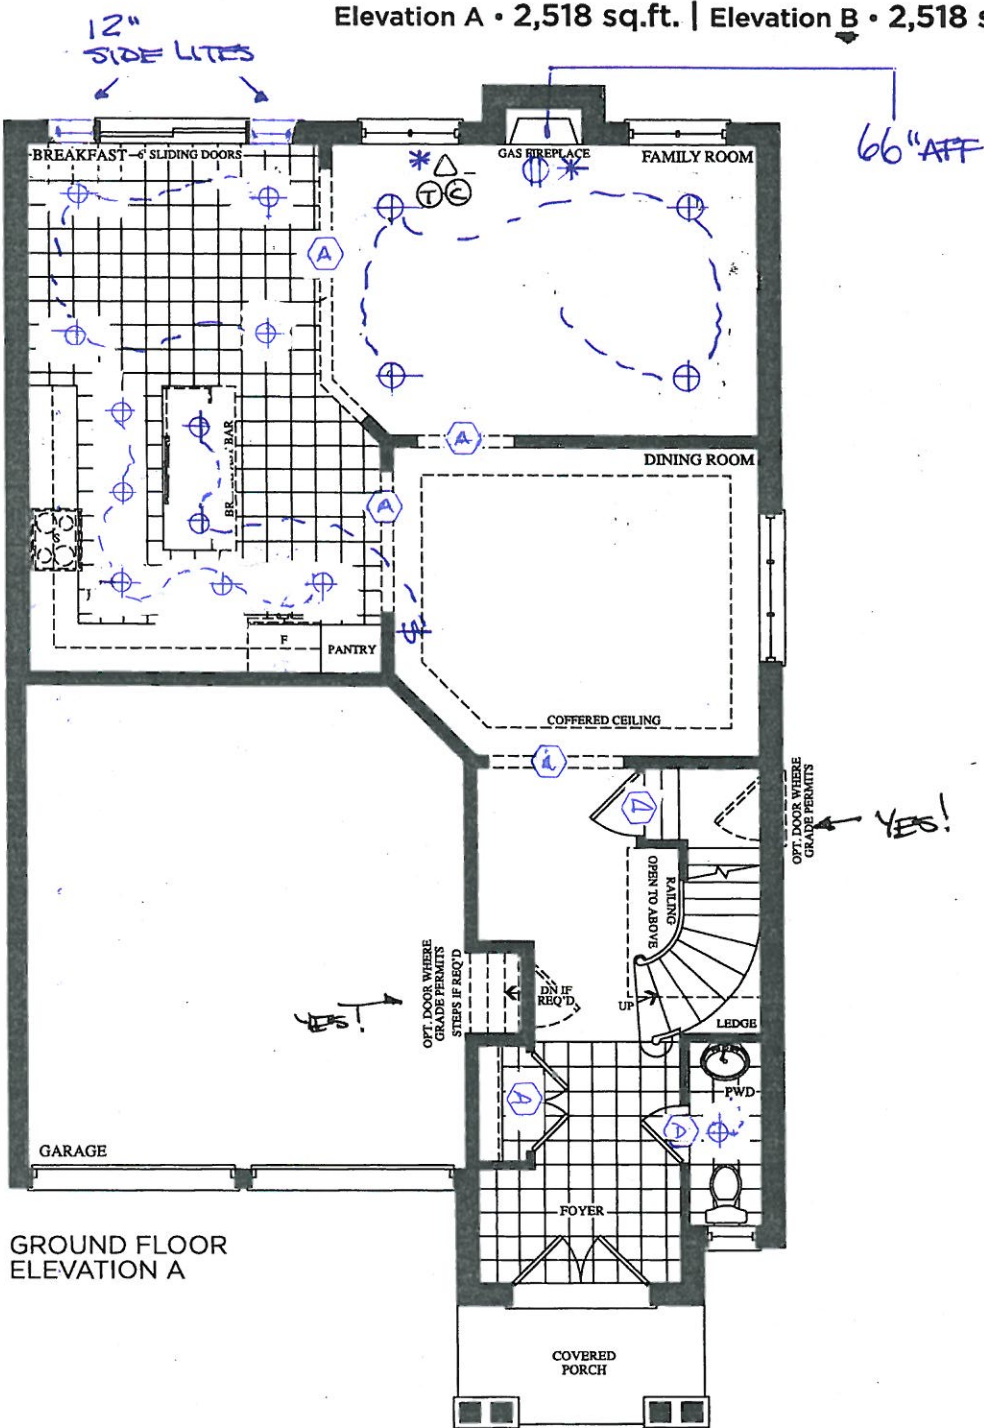


Prices, figures, illustrations, sizes, features and finishes are subject to change without notice. E.&O.E. Areas and dimensions are approximate and actual usable floor space may vary from the stated area. Layout may be reverse of the unit purchased. E. & O.E.


BE2-119
April 9 2020
see attached

The
Vivaldi
38' SERIES

Elevation A • 2,518 sq.ft. | Elevation B • 2,518 sq.ft.

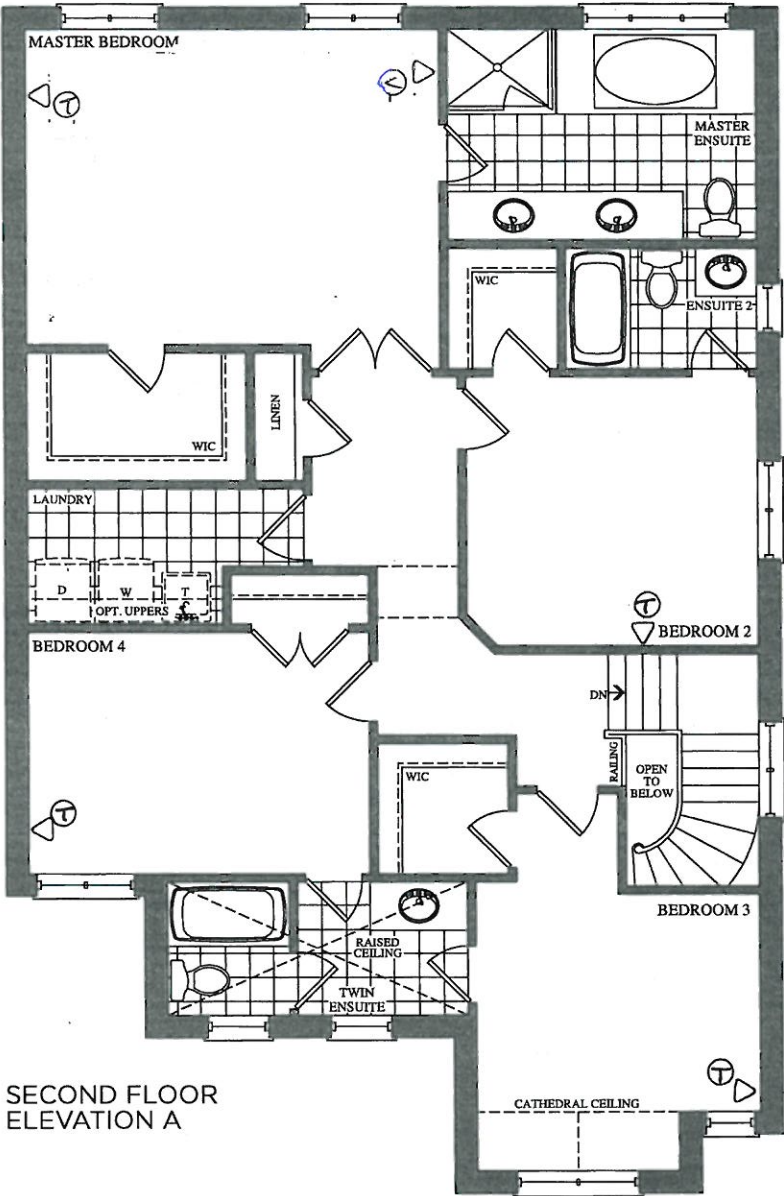

SECOND FLOOR
ELEVATION A

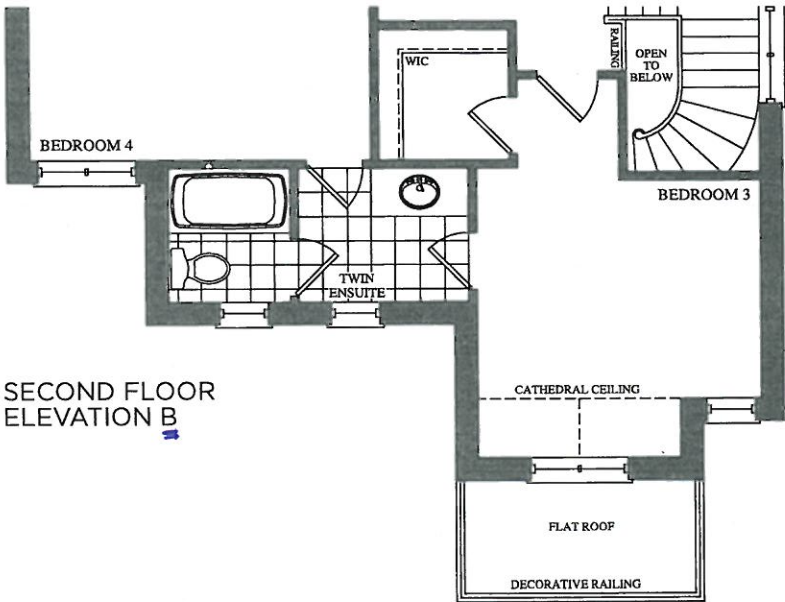

SECOND FLOOR
ELEVATION B

Prices, figures, illustrations, sizes, features and finishes are subject to change without notice. E.&O.E. Areas and dimensions are approximate and actual usable floor space may vary from the stated area. Layout may be reverse of the unit purchased. E. & O.E.


encore
BRAMPTON

BEZ-119
APRIL 9 2020

The
Vivaldi
38' SERIES

Elevation A • 2,518 sq.ft. | Elevation B • 2,518 sq.ft.

LOOK OUT BASEMENT.

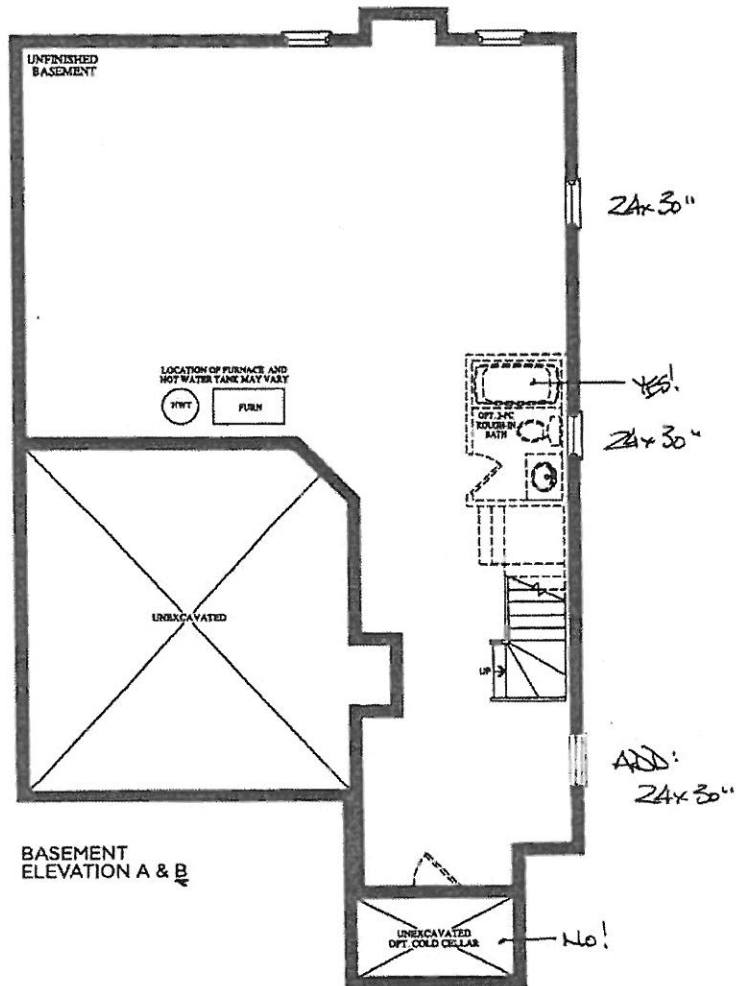

Prices, figures, illustrations, sizes, features and finishes are subject to change without notice. E.&O.E. Areas and dimensions are approximate and actual usable floor space may vary from the stated area. Layout may be reverse of the unit purchased. E. & O.E.

GOLDPARK
HOMES


encore
BRAMPTON

BE2-119.
April 2020



The
Vivaldi
38' SERIES

Elevation A • 2,518 sq.ft. | Elevation B • 2,518 sq.ft.

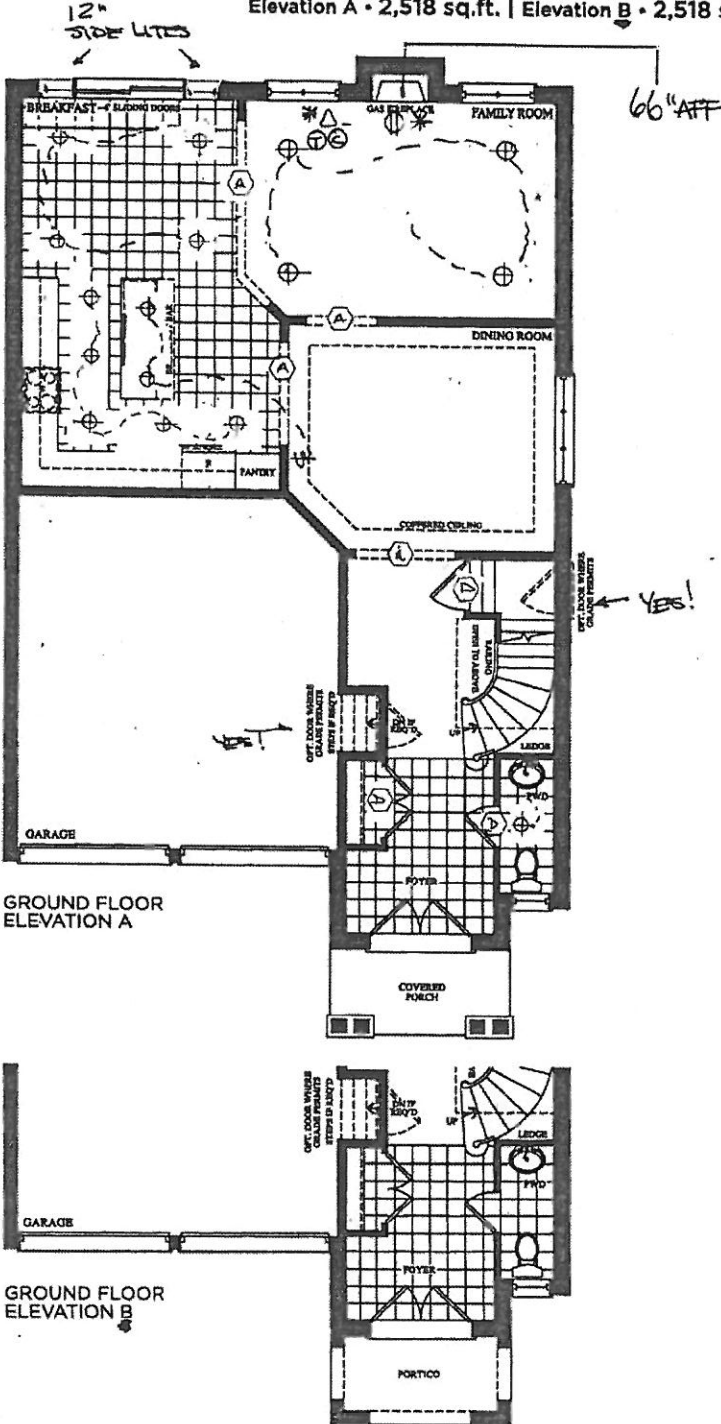

Prices, figures, illustrations, sizes, features and finishes are subject to change without notice. E.O.E. Areas and dimensions are approximate and actual usable floor space may vary from the stated area. Layout may be reverse of the unit purchased. E. & O.E.

GOLDPARK
HOMES



encore
BRAMPTON

BE2-119
April 9 2020

119
2020

The Vivaldi
38' SERIES

Elevation A • 2,518 sq.ft. | Elevation B • 2,518 sq.ft.

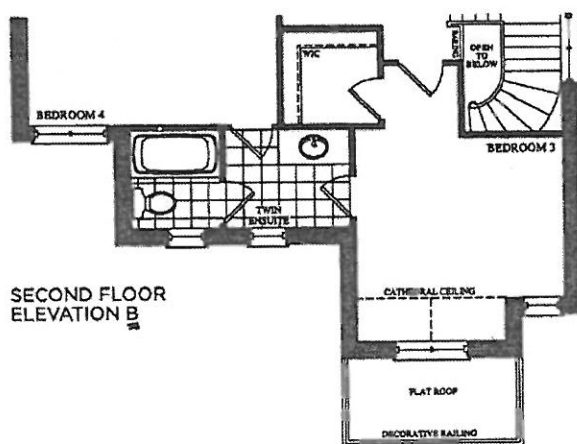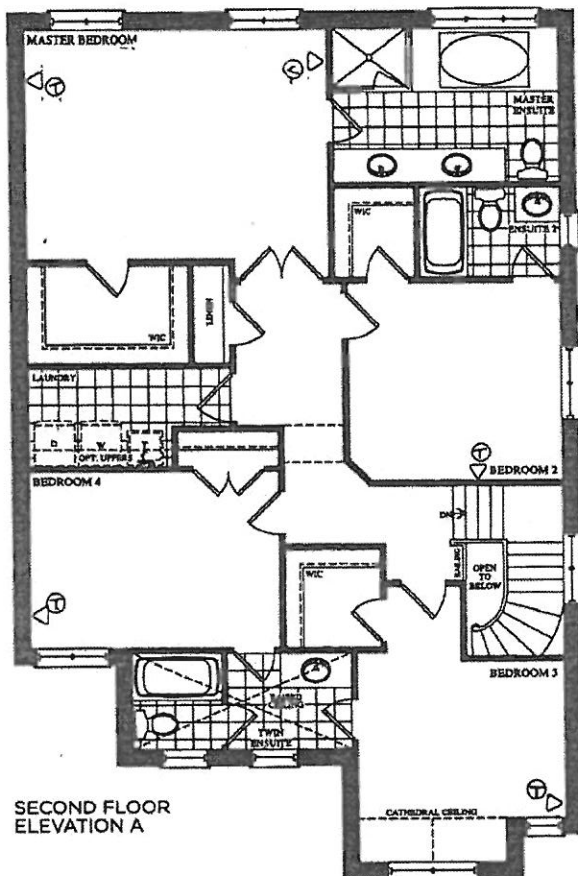

Prices, figures, illustrations, sizes, features and finishes are subject to change without notice. E.&O.E. Areas and dimensions are approximate and actual usable floor space may vary from the stated area. Layout may be reverse of the unit purchased. E. & O.E.

GOLDPARK
HOMES