

GOLDPARK

WORTH MORE™

CONSTRUCTION SUMMARY

Lot: 113

Model: 38-4 Elev.B VIVALDI

Project/Phase: Brampton Encore / 2

CONCRETE AND DRAIN		
Invoice	Qty.	Description
2272 32738 22Apr20 NoCat	1	3PC BASEMENT ROUGH-IN

ELECTRICAL		
Invoice	Qty.	Description
2272 32045 22Apr20	1	200 AMP ELECTRICAL SERVICE

EXTERIOR COLOURS		
Invoice	Qty.	Description
2272 32746 22Apr20 NoCat	1	EXTERIOR COLOUR PACKAGE # 5


FORMING		
Invoice	Qty.	Description
2272 32046 22Apr20 **	2	BASEMENT WINDOWS - UPGRADE EXISTING BASEMENT WINDOW TO 30 INCH X 24 INCH - MAY REQUIRE INSTALLATION OF WINDOW WELL
2272 32739 22Apr20 NoCat	1	SIDE DOOR - AS PER PLAN AND GRADE PERMITTING
2272 32742 22Apr20 NoCat	1	GARAGE MANDOOR - AS PER PLAN AND GRADE PERMITTING

FRAMING		
Invoice	Qty.	Description
2272 32740 22Apr20 NoCat	1	SIDE DOOR - AS PER PLAN AND GRADE PERMITTING
2272 32741 22Apr20 NoCat	1	GARAGE MANDOOR - AS PER PLAN AND GRADE PERMITTING

INTERIOR TRIM AND DOORS		
Invoice	Qty.	Description
2272 32745 22Apr20 NoCat	1	SIDE DOOR AND GARAGE MANDOOR - AS PER PLAN AND GRADE PERMITTING

ryDiscipline.rpt 14Mar20

Page 1 of 2



CONSTRUCTION SUMMARY

Lot: 113

Model: 38-4 Elev.B VIVALDI

Project/Phase: Brampton Encore / 2

MISC.		
Invoice	Qty.	Description
2272 32047 22Apr20 NoCat	1	Purchaser has attended a phone appointment with the Decor Centre & has DECLINED any additional upgrades and accepts and acknowledges that there will be no further changes/additions/deletions to be made upon signing on April 6, 2020.
2272 32048 22Apr20 NoCat	1	BONUS PACKAGE: \$10,000.00 (INCLUDING TAXES) WORTH OF UPGRADES FROM GOLD PARK HOMES DÉCOR CENTRE IS BEING APPLIED TOWARD THIS ORDER. PURCHASER HAS A REMAINING AMOUNT OF \$7,401.00(INCLUDING TAXES).

PAINT		
Invoice	Qty.	Description
2272 32744 22Apr20 NoCat	1	SIDE DOOR AND GARAGE MANDOOR - AS PER PLAN AND GRADE PERMITTING

PLUMBING		
Invoice	Qty.	Description
2272 32737 22Apr20 NoCat	1	3PC BASEMENT ROUGH-IN

WINDOWS - BASEMENT		
Invoice	Qty.	Description
2272 32046 22Apr20	2	BASEMENT WINDOWS - UPGRADE EXISTING BASEMENT WINDOW TO 30 INCH X 24 INCH - MAY REQUIRE INSTALLATION OF WINDOW WELL


WINDOWS AND DOORS		
Invoice	Qty.	Description
2272 32743 22Apr20 NoCat	1	SIDE DOOR AND GARAGE MANDOOR - AS PER PLAN AND GRADE PERMITTING

This Document is Extremely Time Sensitive - Printed 22 Apr 20 at 12:56

Elevation A • 2,518 sq.ft. | Elevation B • 2,518 sq.ft.

BE2-113
APRIL 6 2020

LOB

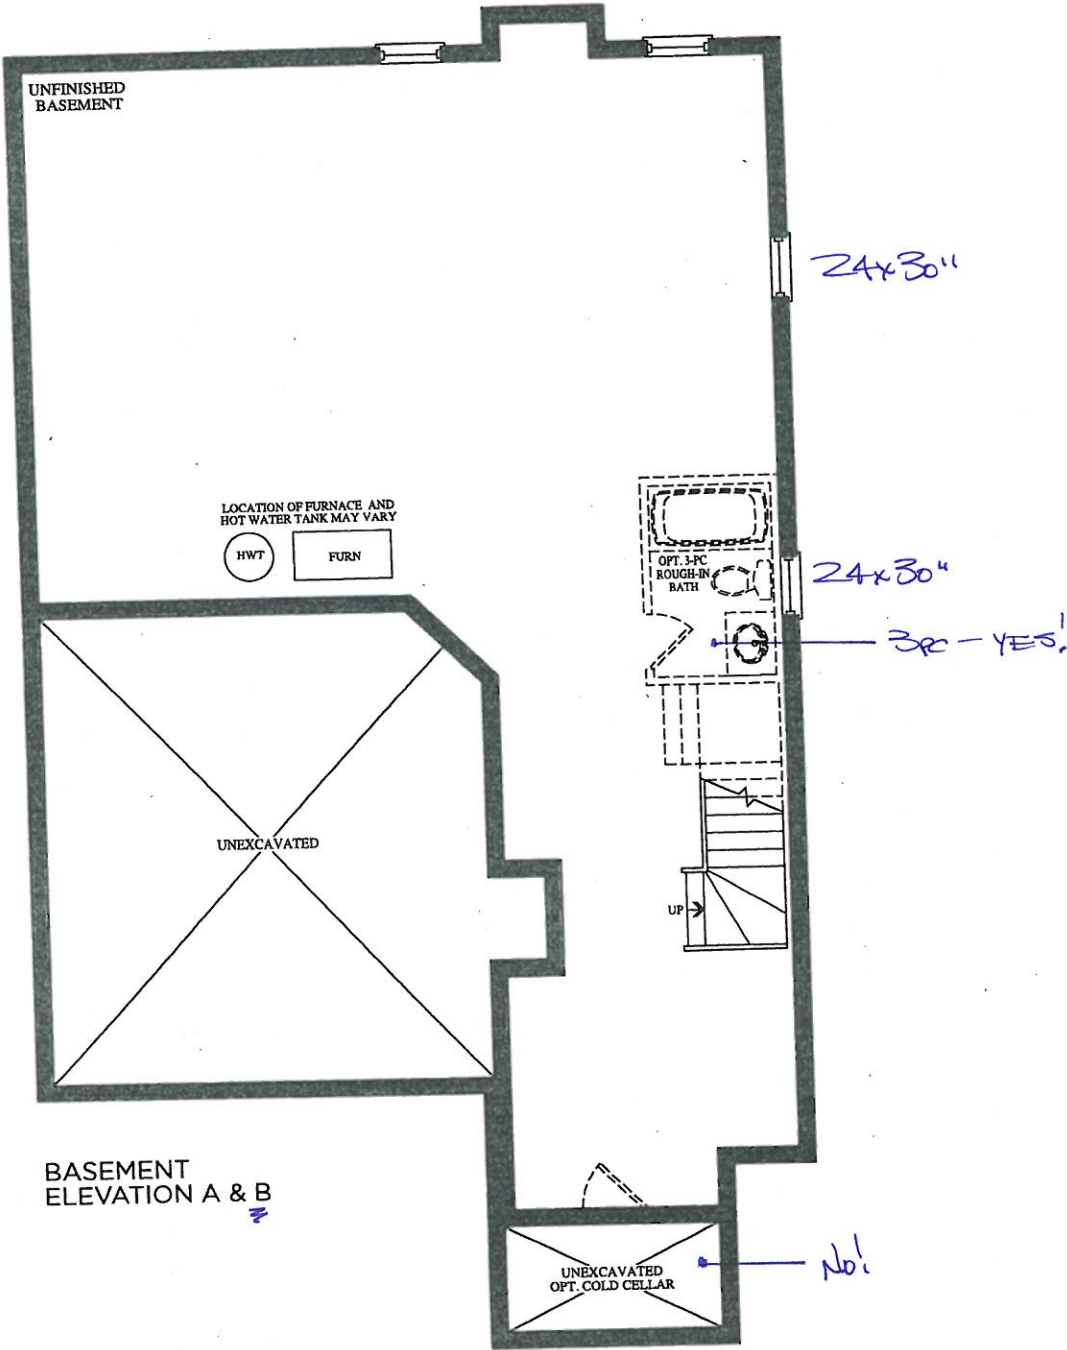


BEZ 113
April 6 2020




The
Vivaldi
38' SERIES

Elevation A • 2,518 sq.ft. | Elevation B • 2,518 sq.ft.

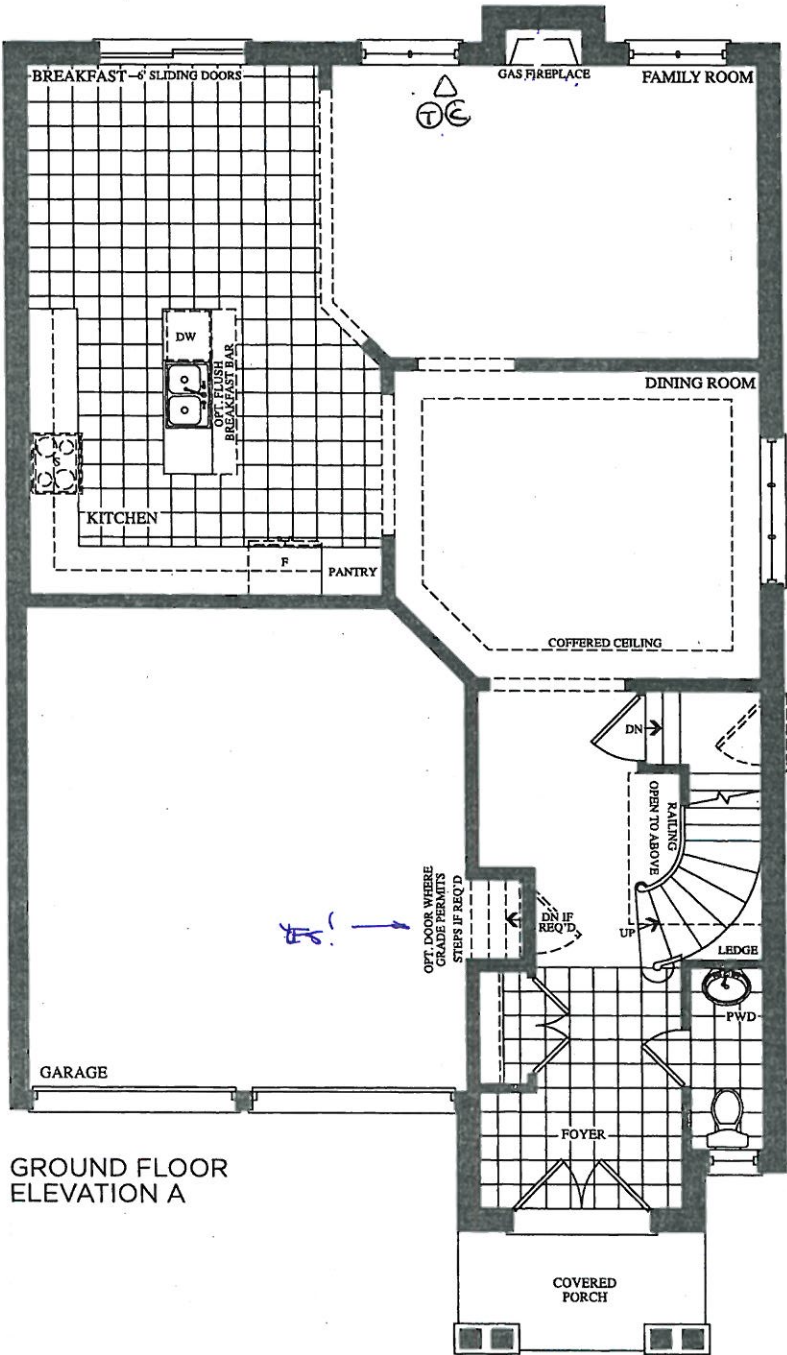

GROUND FLOOR
ELEVATION A

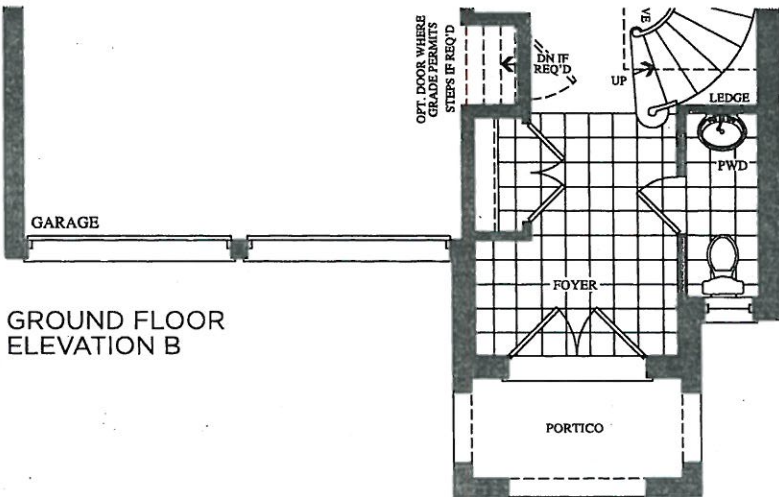



GROUND FLOOR
ELEVATION B

Prices, figures, illustrations, sizes, features and finishes are subject to change without notice. E.&O.E. Areas and dimensions are approximate and actual usable floor space may vary from the stated area. Layout may be reverse of the unit purchased. E. & O.E.

The Vivaldi

38' SERIES

Elevation A • 2,518 sq.ft. | Elevation B • 2,518 sq.ft.

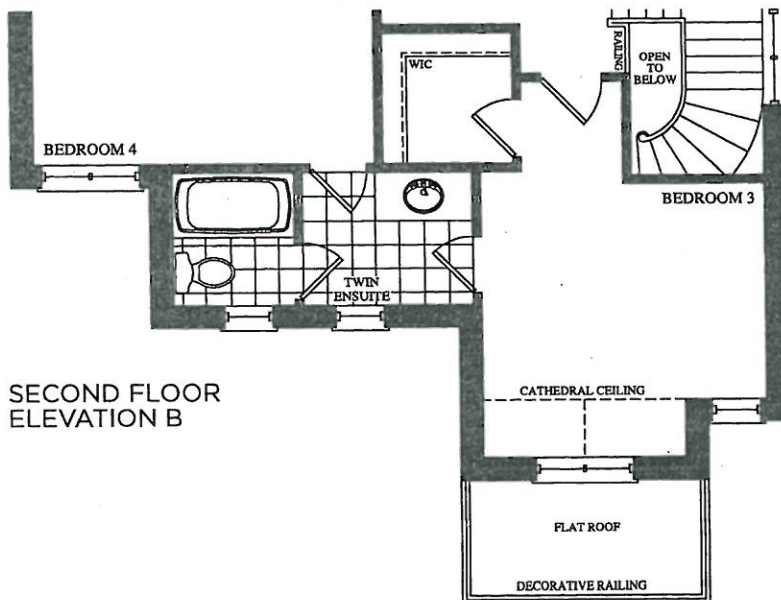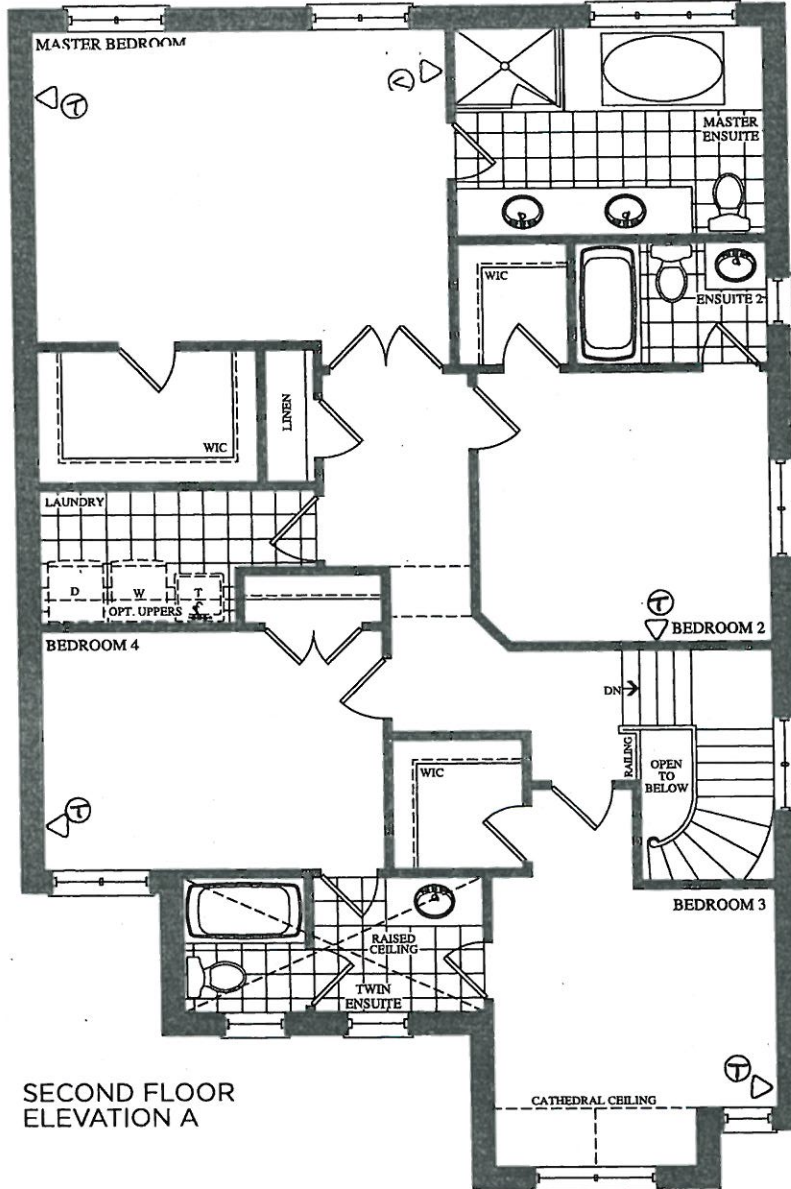


encore
BRAMPTON

The Vivaldi 38' SERIES

Elevation A • 2,518 sq.ft. | Elevation B • 2,518 sq.ft.

As 25
G/S
BE 2-113
APRIL 6 2020

LOB

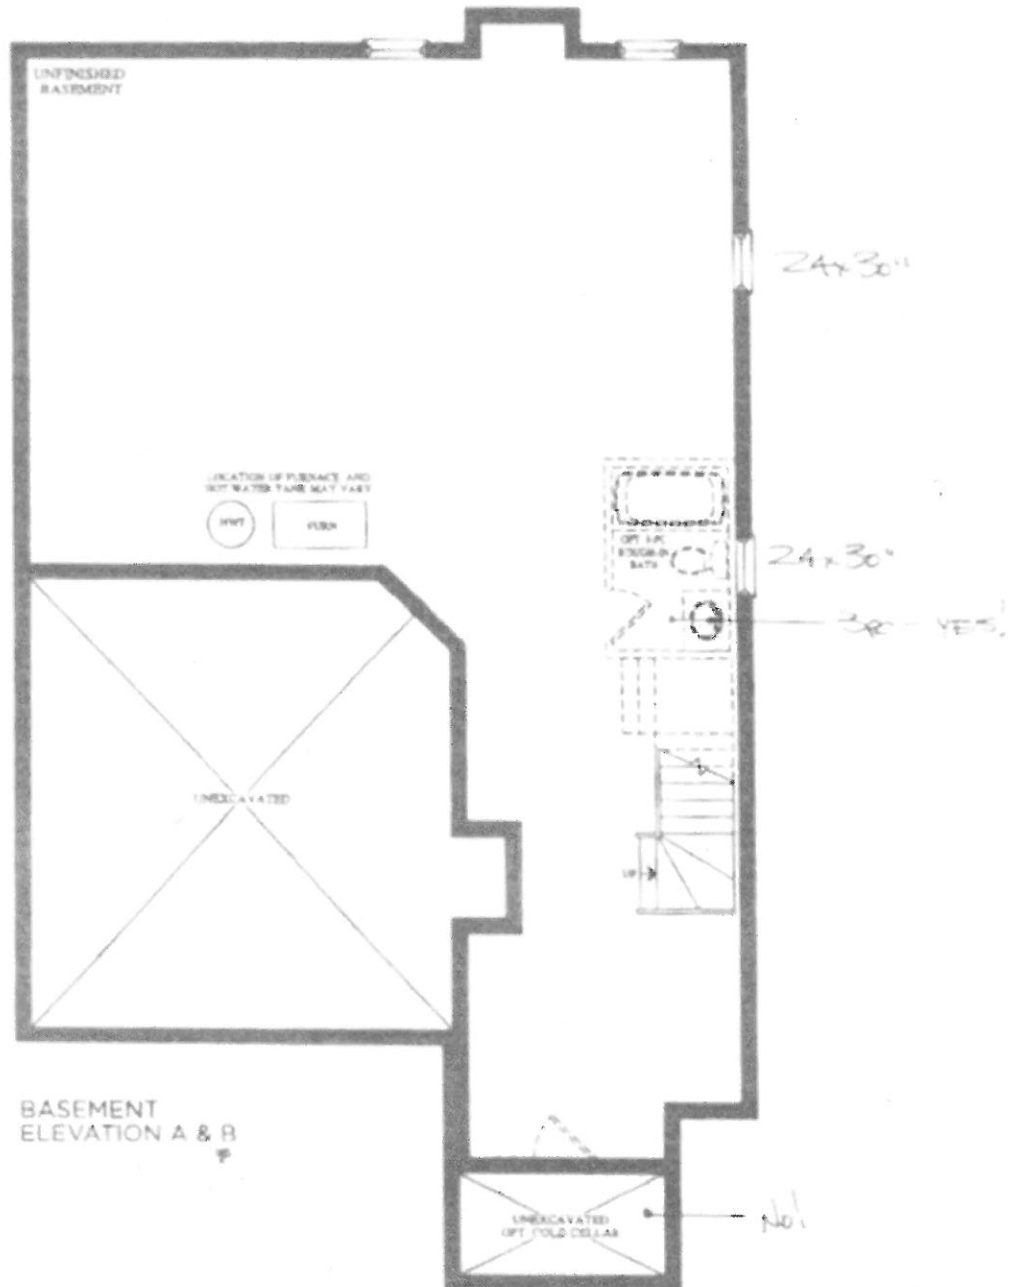

Prices, figures, illustrations, sizes, features and finishes are subject to change without notice. E & OE. Areas and dimensions are approximate and actual usable floor space may vary from the stated area. Layout may be reverse of the unit purchased. E & OE.

GOLDPARK
HOMES


encore
BRAMPTON

BEZ 113
April 6 2020


615
AD/AS

The Vivaldi 38' SERIES

Elevation A • 2,518 sq.ft. | Elevation B • 2,518 sq.ft.

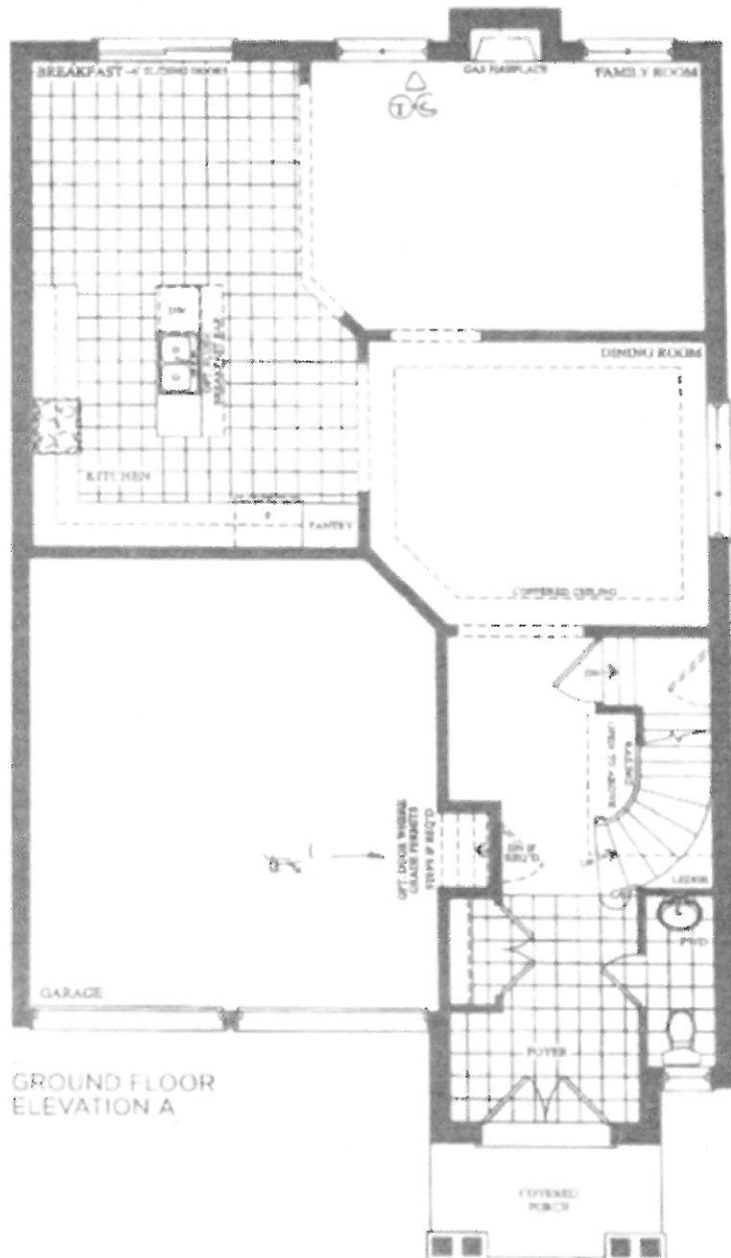

GROUND FLOOR
ELEVATION A

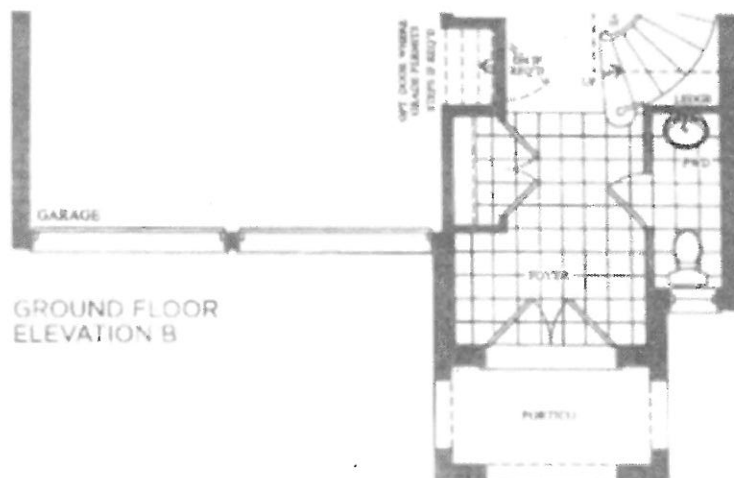

GROUND FLOOR
ELEVATION B

Smooth
Ceiling

Prices, figures, illustrations, sizes, features and finishes are subject to change without notice. E&O.E. Areas and dimensions are approximate and actual usable floor space may vary from the stated area. Layout may be reverse of the unit purchased. E. & O.E.

GOLDPARK
HOMES


encore
BRAMPTON

212-113
APRIL 6, 2020

AS
G.S.

The
Vivaldi
38' SERIES

Elevation A • 2,518 sq.ft. | Elevation B • 2,518 sq.ft.

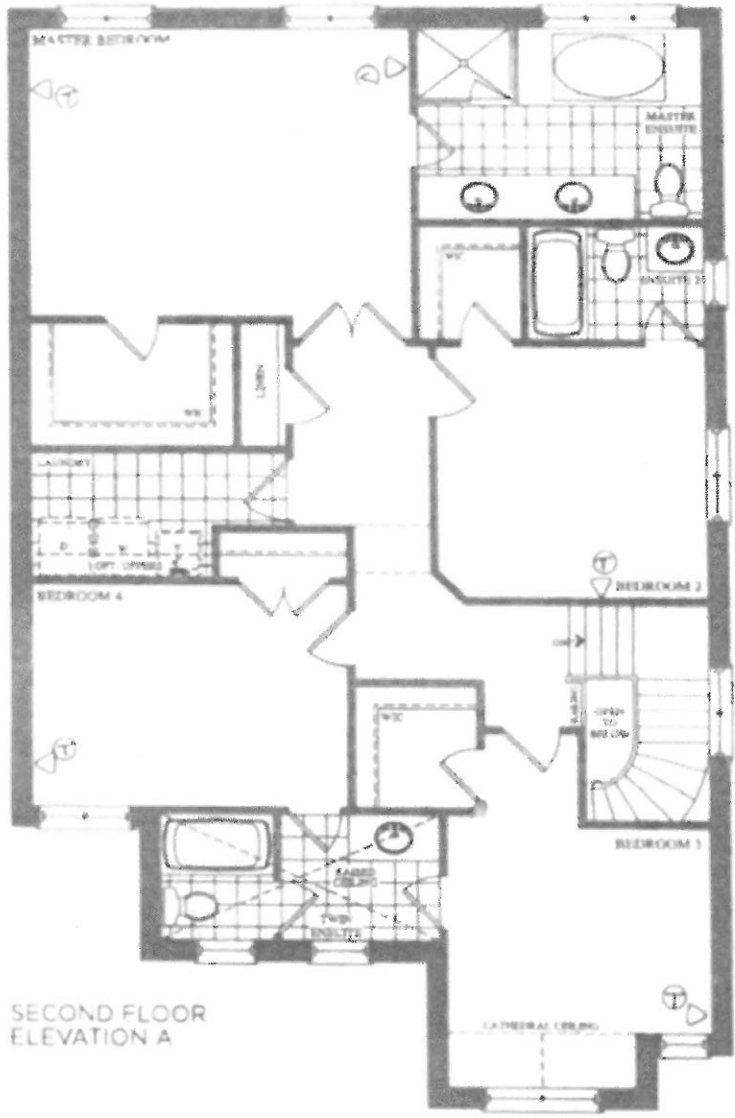

SECOND FLOOR
ELEVATION A



SECOND FLOOR
ELEVATION B

Prices, figures, illustrations, sizes, features and finishes are subject to change without notice. E & G: Areas and dimensions are approximate and actual usable floor space may vary from the stated area. Layout may be reverse of the unit purchased. E & G: E.

GOLDPARK
HOMES