



CONSTRUCTION SUMMARY

Lot: 122
Model: 40.02 A VALLEYVIEW
Project/Phase: Pine Valley Forevergreen / 1

--	--	--

DRYWALL

Invoice	Qty.	Description
2293 32413 23Apr20 **	1	GREAT ROOM - OPT. COFFERED CEILING - AS PER PLAN
2293 32414 23Apr20 **	1	BREAKFAST ROOM OPT. COFFERED CEILING - AS PER PLAN
2293 32416 23Apr20 **	1	MASTER BEDROOM - OPT. 10 FOOT TRAY CEILING AS PER PLAN
2293 32672 23Apr20	2	MAIN HALL: UPGRADE TO CURVED ARCHWAY PRICE PER OPENING SEE PLAN FOR LOCATIONS

ELECTRICAL

Invoice	Qty.	Description
2293 32413 23Apr20 **	1	GREAT ROOM - OPT. COFFERED CEILING - AS PER PLAN
2293 32414 23Apr20 **	1	BREAKFAST ROOM OPT. COFFERED CEILING - AS PER PLAN
2293 32416 23Apr20 **	1	MASTER BEDROOM - OPT. 10 FOOT TRAY CEILING AS PER PLAN

ELECTRICAL APPLIANCES

Invoice	Qty.	Description
2293 32406 23Apr20	1	KITCHEN: 110V WALL RECEPTACLE ON SEPARATE CIRCUIT - FOR MICROWAVE - MICROWAVE NOT INCLUDED
2293 32407 23Apr20	1	KITCHEN: ADDITIONAL 220V RECEPTACLE ON A SEPARATE CIRCUIT - FOR BUILT-IN WALL OVEN - APPLIANCE NOT INCLUDED - DOES NOT INCLUDE BREAKER THAT IS TO BE INSTALLED BY LICENSED ELECTRICIAN AND ARRANGED BY HOMEOWNER AFTER CLOSING
2293 32408 23Apr20	1	KITCHEN: 110V WALL RECEPTACLE ON SEPARATE CIRCUIT - GAS FIRED COOKTOP- FOR AUX. EQUIPMENT - NOT A STOVE PLUG

GOLDPARK

WORTH MORE™

CONSTRUCTION SUMMARY

Lot: 122

Model: 40.02 A VALLEYVIEW

Project/Phase: Pine Valley Forevergreen / 1

ELECTRICAL INTERIOR

Invoice	Qty.	Description
2293 32399 23Apr20	1	GREAT ROOM: INTERIOR WALL OUTLET: 110V WALL INTERIOR RECEPTACLE ON EXISTING CIRCUIT - LOCATE APPROX. 66" A.F.F. ABOVE FIREPLACE OR FUTURE TV
2293 32403 23Apr20	1	KITCHEN: FIXTURE: RELOCATE STANDARD CEILING MOUNT FIXTURE LOCATE APPROX CENTER ABOVE ISLAND
2293 32469 23Apr20	1	KITCHEN: FIXTURE: UNDER CABINET FLUORESCENT LIGHT FIXTURES - DOES NOT INCLUDE (AND REQUIRES) LIGHT VALANCE

ELECTRICAL POTLIGHT

Invoice	Qty.	Description
2293 32404 23Apr20	6	MAIN FLOOR: *GREAT ROOM X 4 POTLIGHTS (WITH SWITCH)* + *DINING ROOM X 2 POTLIGHTS*: 4" E/S LED INTERIOR POT LIGHT - GROUND FLOOR - EACH SEE PLAN FOR LOCATION INCLUDED IN APS

ELECTRICAL SWITCH

Invoice	Qty.	Description
2293 32468 23Apr20	2	GREAT ROOM + MASTER BEDROOM: UPGRADE TO DIMMER SWITCH FOR CEILING LIGHT
2293 32702 23Apr20	1	DINING ROOM: ADDITIONAL INTERIOR SWITCH FOR POTLIGHTS

--	--	--

HVAC

Invoice	Qty.	Description
2293 32410 23Apr20	1	KITCHEN: GAS LINE ROUGH-IN - MAIN FLOOR FOR GAS COOKTOP



CONSTRUCTION SUMMARY

Lot: 122
Model: 40.02 A VALLEYVIEW
Project/Phase: Pine Valley Forevergreen / 1

INTERIOR TRIM /MOULDINGS

Invoice	Qty.	Description
2293 32413 23Apr20 **	1	GREAT ROOM - OPT. COFFERED CEILING - AS PER PLAN
2293 32414 23Apr20 **	1	BREAKFAST ROOM OPT. COFFERED CEILING - AS PER PLAN
2293 32416 23Apr20 **	1	MASTER BEDROOM - OPT. 10 FOOT TRAY CEILING AS PER PLAN

LUM - LUMBER

Invoice	Qty.	Description
2293 32416 23Apr20 **	1	MASTER BEDROOM - OPT. 10 FOOT TRAY CEILING AS PER PLAN

PANL - FRAMING

Invoice	Qty.	Description
2293 32413 23Apr20 **	1	GREAT ROOM - OPT. COFFERED CEILING - AS PER PLAN
2293 32414 23Apr20 **	1	BREAKFAST ROOM OPT. COFFERED CEILING - AS PER PLAN
2293 32416 23Apr20 **	1	MASTER BEDROOM - OPT. 10 FOOT TRAY CEILING AS PER PLAN

PLUMBING

Invoice	Qty.	Description
2208 31627 18Mar20 NoCat	1	BACK-FLOW PREVENTER VALVE
2293 32415 23Apr20	1	KITCHEN: ROUGH-IN 1/4" COLD WATER LINE TO FRIDGE
2293 32483 23Apr20 NoCat	1	MASTER ENSUITE: UPGRADE SHOWER SYSTEM TO MOEN 'ALIGN' POSI TEMP 3 FUNCTION SHOWER - CHROME RAIN SHOWER (FROM CEILING) + HAND SHOWER #T21193EP/3372/128284/T4191/62320/3887EP/A725

ROUGH CARPENTRY

Invoice	Qty.	Description
2293 32413 23Apr20 **	1	GREAT ROOM - OPT. COFFERED CEILING - AS PER PLAN
2293 32414 23Apr20 **	1	BREAKFAST ROOM OPT. COFFERED CEILING - AS PER PLAN
2293 32416 23Apr20 **	1	MASTER BEDROOM - OPT. 10 FOOT TRAY CEILING AS PER PLAN


SCHEDULE 'F'



PV-122
APRIL 22
2020

The Valleyview
40' SERIES

Elevation A • 3,145 sq.ft.
Elevation B • 3,170 sq.ft.

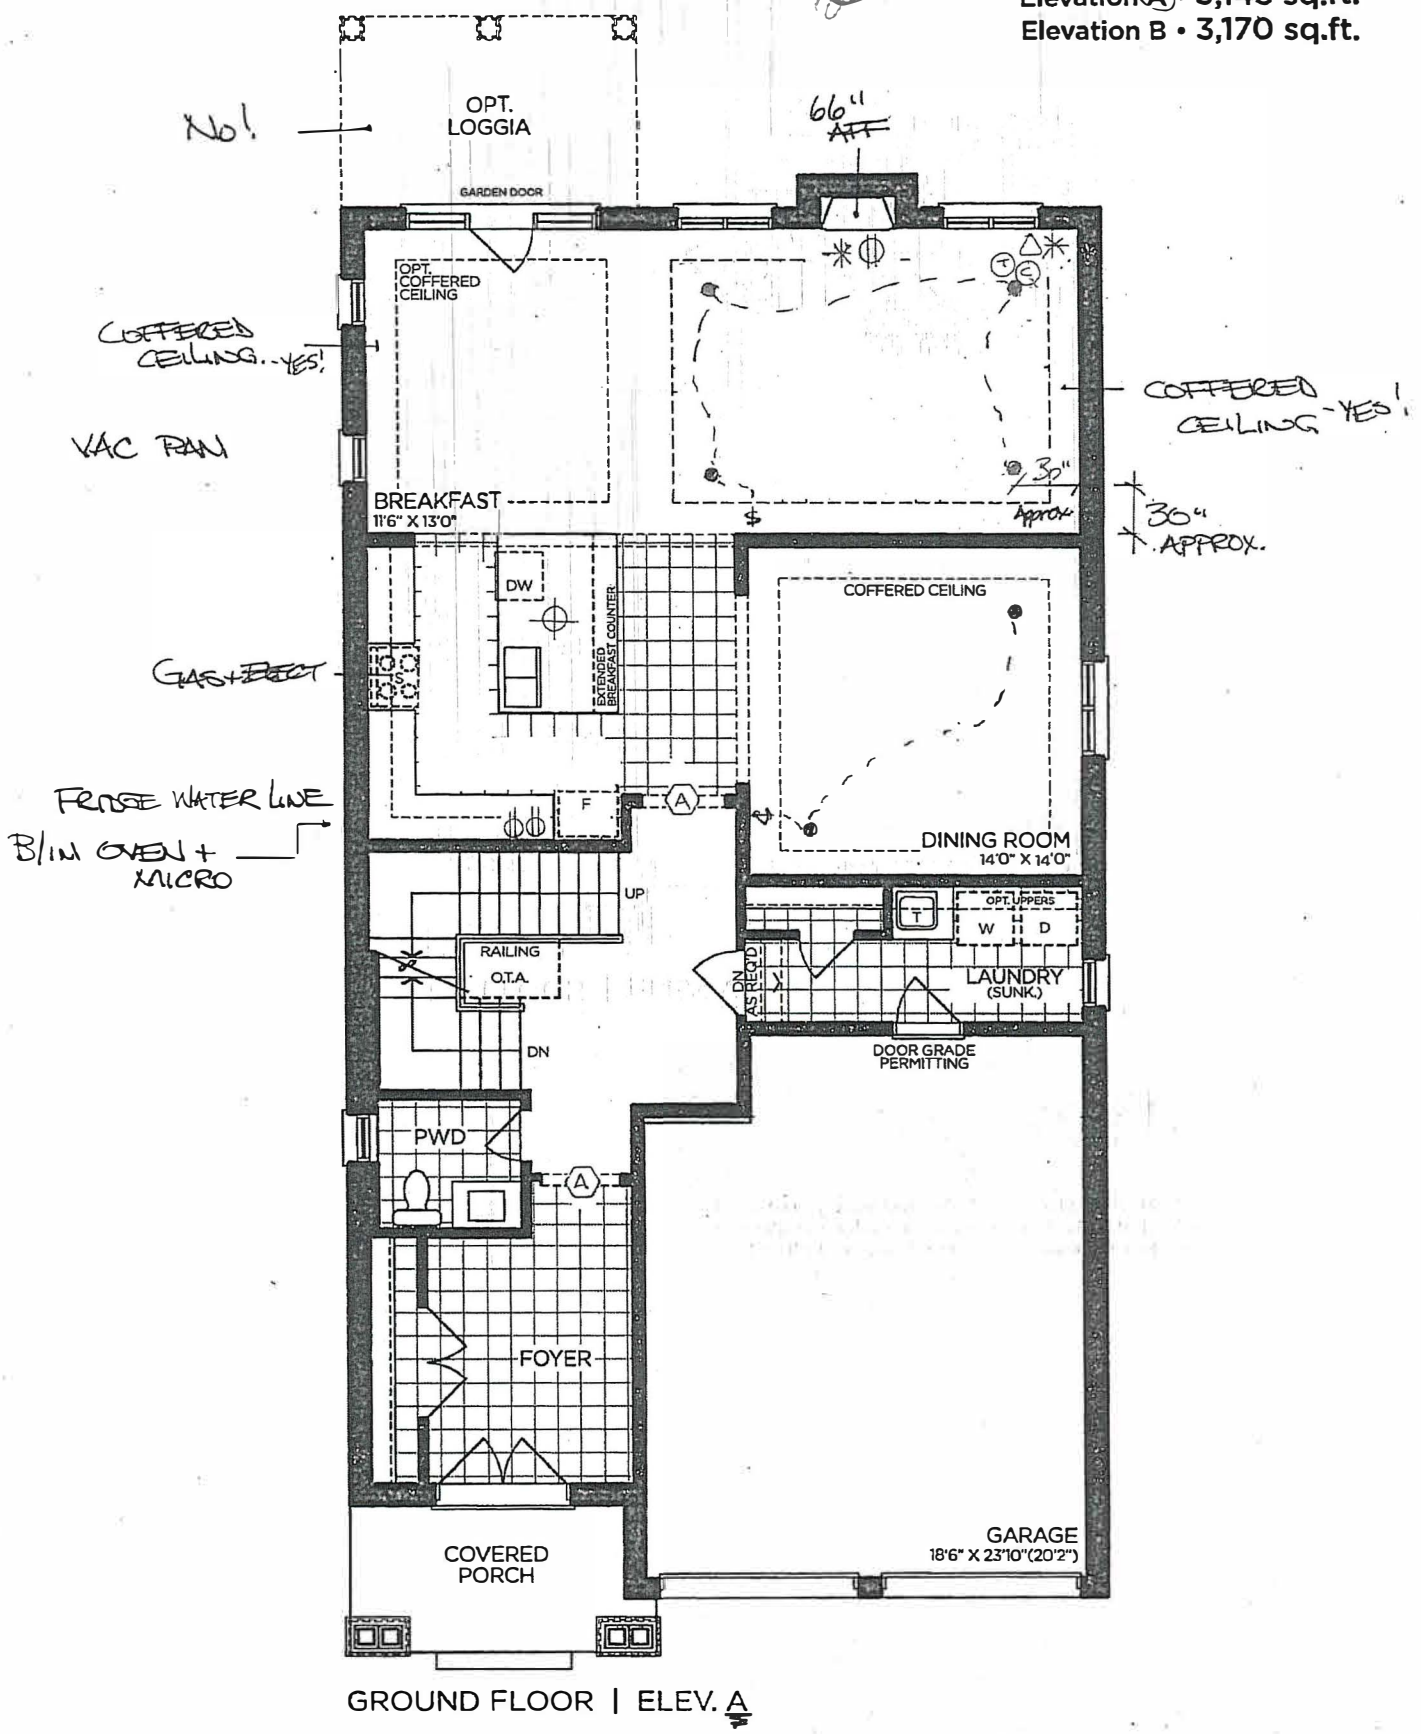

VENDOR

PURCHASER

PURCHASER

GOLDPARK
WORTH MORE™

Prices, figures, illustrations, sizes, features and finishes are subject to change without notice. Areas and dimensions are approximate and actual usable floor space may vary from the stated area. Layout may be reverse of the unit purchased. E. & O.E. 4002


SCHEDULE 'F'



PV-122
APRIL 21, 2020

The Valleyview
40' SERIES

Elevation A • 3,145 sq.ft.
Elevation B • 3,170 sq.ft.

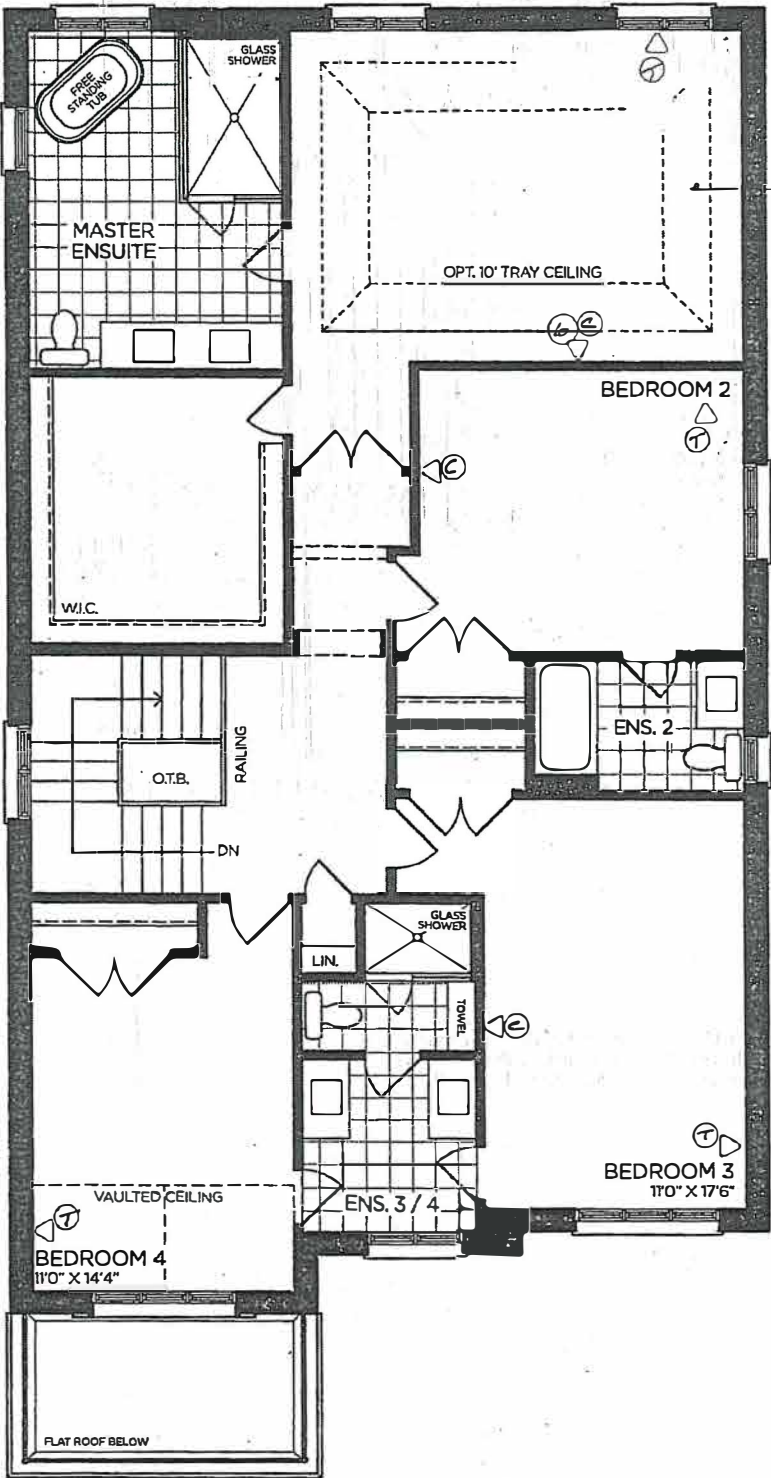

SECOND FLOOR | ELEV. A

VENDOR

PURCHASER

PURCHASER

GOLDPARK
WORTH MORE™

Prices, figures, illustrations, sizes, features and finishes are subject to change without notice. Areas and dimensions are approximate and actual usable floor space may vary from the stated area. Layout may be reverse of the unit purchased. E. & O.E. 4002

SCHEDULE 'F'




FV-122
APRIL 22, 2020

The Valleyview

40' SERIES

Elevation A • 3,145 sq.ft.
Elevation B • 3,170 sq.ft.

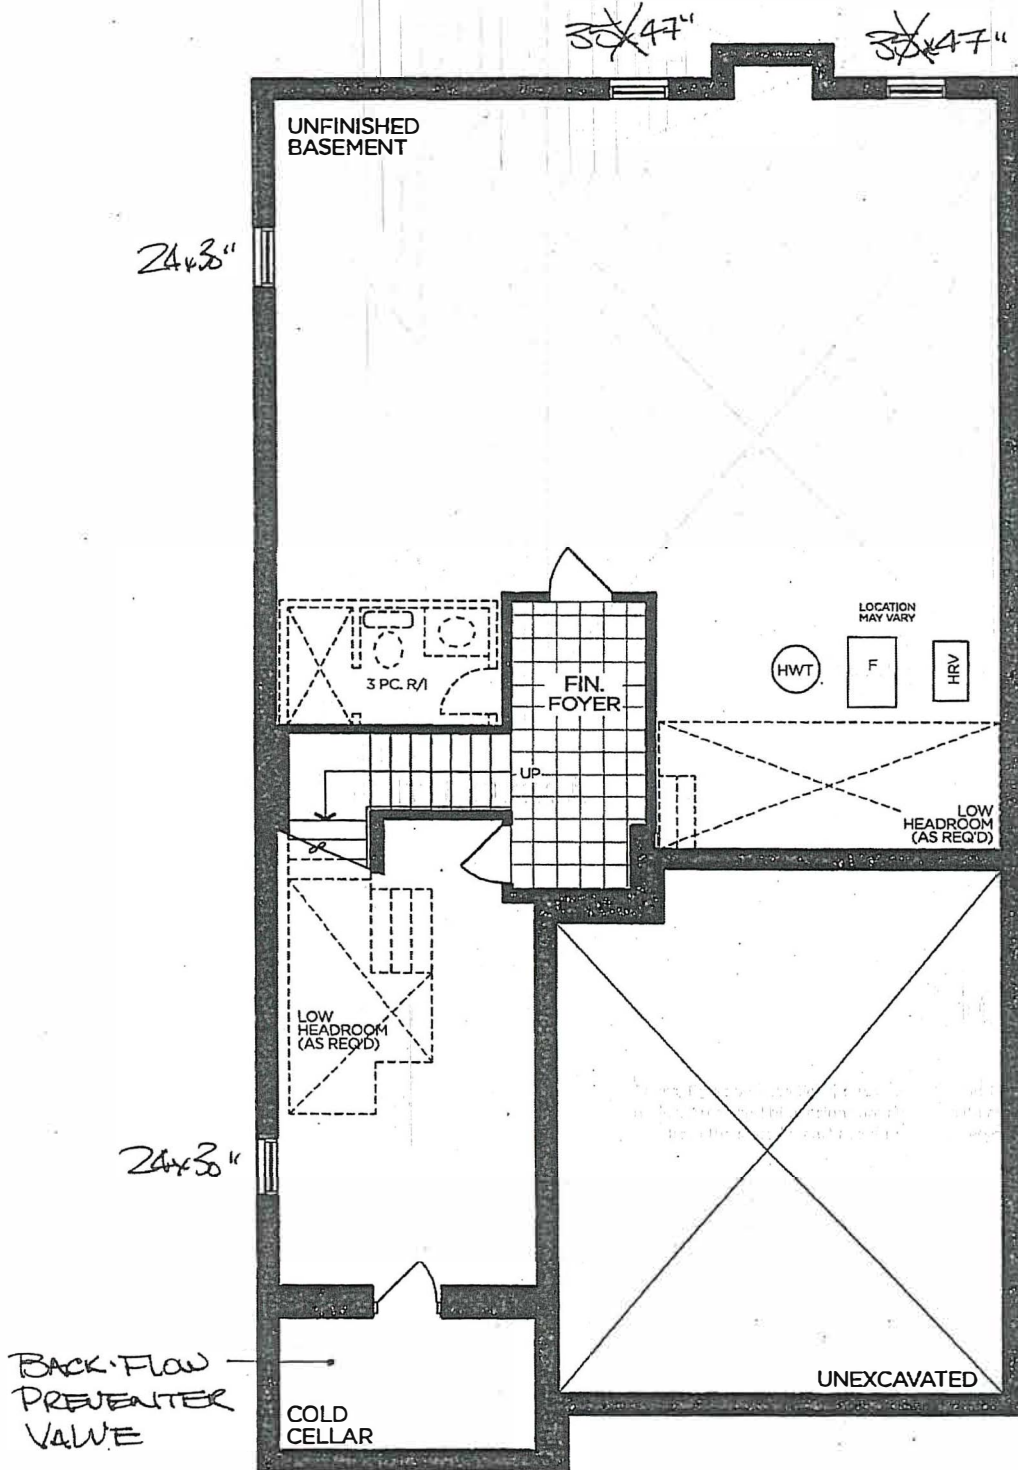

BASEMENT | ELEV. A

VENDOR

PURCHASER

PURCHASER

GOLDPARK
WORTH MORE™

Prices, figures, illustrations, sizes, features and finishes are subject to change without notice. Areas and dimensions are approximate and actual usable floor space may vary from the stated area. Layout may be reverse of the unit purchased. E. & O.E. 4002




PINE VALLEY

FOREVERGREEN

PLUMBING UPGRADES

POSI-TEMP SHOWER ONLY* W/ 3 FUNCTION TRANSFER VALVE/TRIM AND SLIDE BAR W/ HAND SHOWER

MOEN - ALIGN

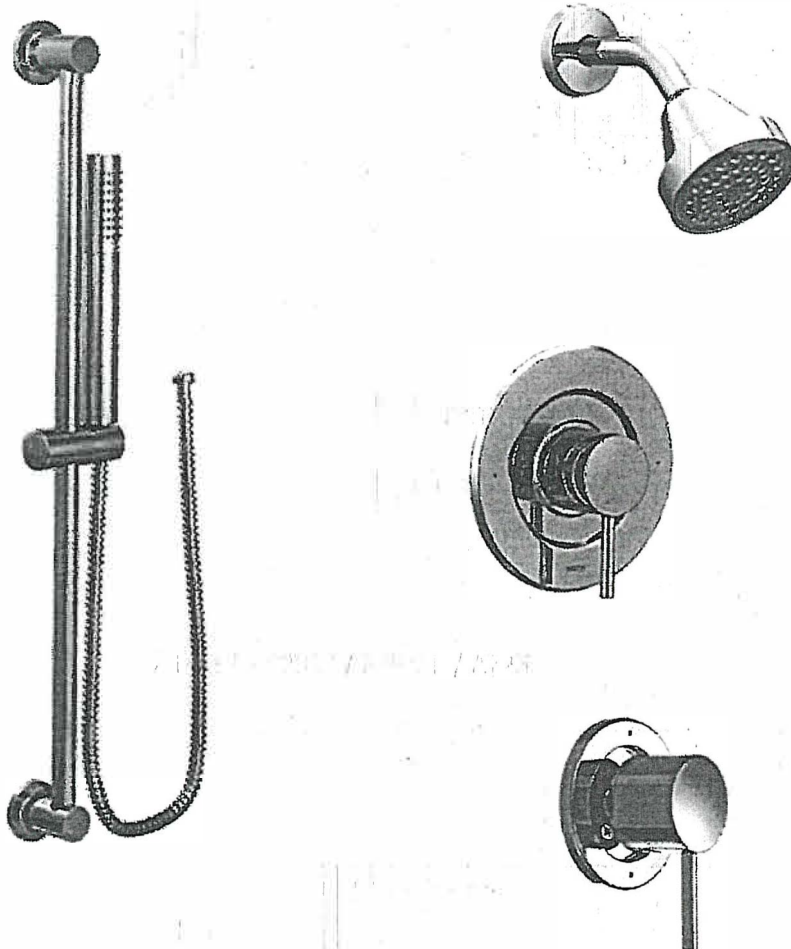

☒ CHROME

☐ BRUSHED GOLD

☐ MATTE BLACK

☐ from WALL

☒ from CEILING

MODEL T21193EP / 3372 / 128284 / T4191 / 62320 / 3887EP / A725

Lot#

122

Room:

MASTER ENSUITE

Signature:

[Signature]

Date:

April 22 2020

Signature:

[Signature]

GOLDPARK
WORTH MORE

SCHEDULE 'F'




PV-122
APRIL 2020

BB
D

The Valleyview
40' SERIES

Elevation A - 3,145 sq.ft.
Elevation B - 3,170 sq.ft.

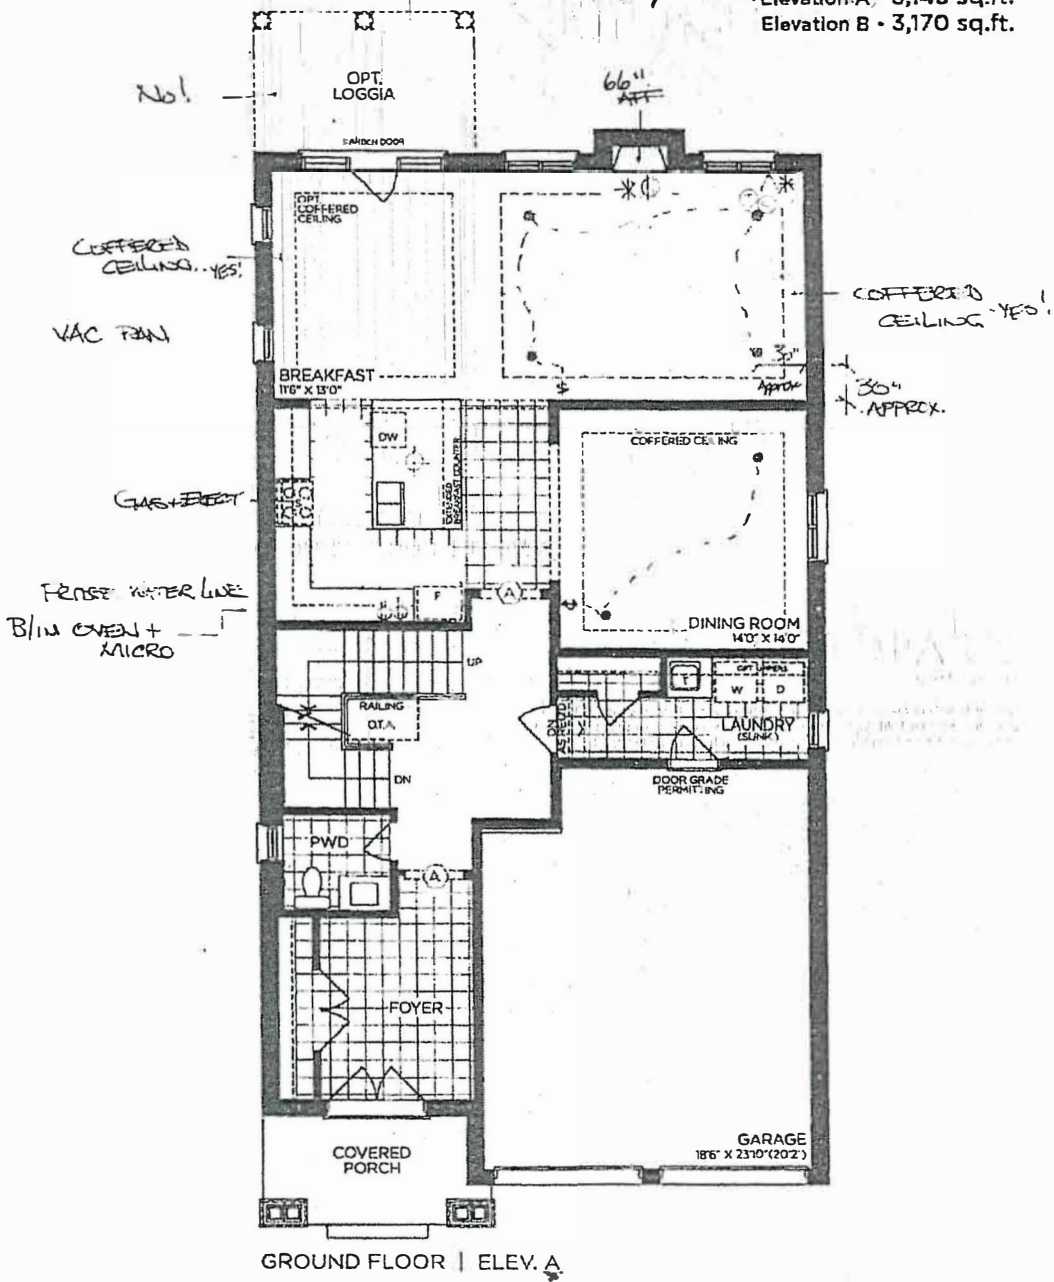

GROUND FLOOR | ELEV. A

VENDOR
PURCHASER
PURCHASER

GOLDPARK
WORTH MORE™

Prices, figures, illustrations, sizes, features and finishes are subject to change without notice. Areas and dimensions are approximate and actual usable floor space may vary from the stated area. Layout may be reverse of the unit purchased. E & O.E. 4002




SCHEDULE 'F'

PV-122 (Rb)
APRIL 22, 2020

The
Valleyview
40' SERIES

Elevation A • 3,145 sq.ft.
Elevation B • 3,170 sq.ft.

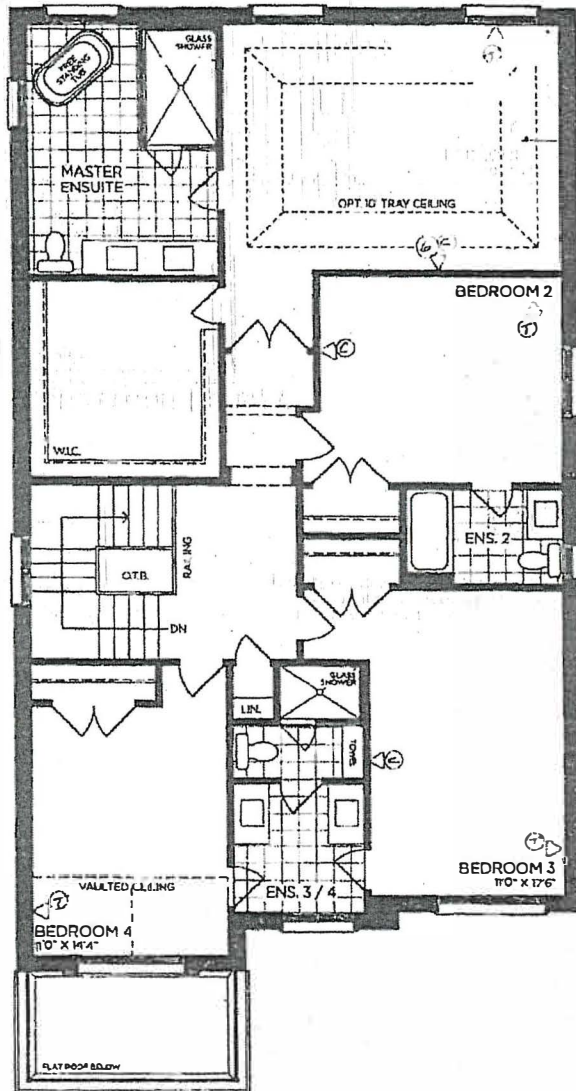

SECOND FLOOR | ELEV. A

VENDOR
PURCHASER
PURCHASER

GOLDPARK
WORTH MORE™

Prices, figures, illustrations, sizes, features and finishes are subject to change without notice. Areas and dimensions are approximate and actual usable floor space may vary from the stated area. Layout may be reverse of the unit purchased. E & O.E. 1002

SCHEDULE 'F'




PV-122
APRIL 22, 2020

The Valleyview

40' SERIES

Elevation A • 3,145 sq.ft.
Elevation B • 3,170 sq.ft.

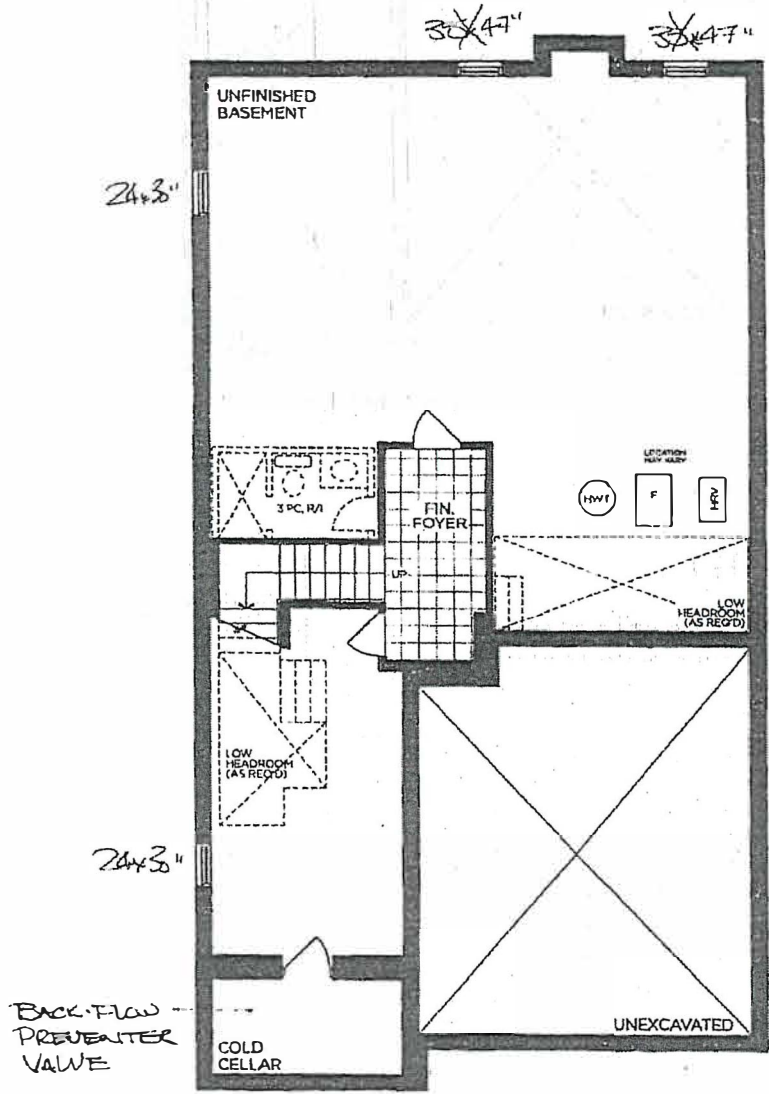

BASEMENT | ELEV. A

VENDOR

PURCHASER

PURCHASER

[Handwritten signatures]

GOLDPARK
WORTH MORE


Prices, figures, illustrations, sizes, features and finishes are subject to change without notice. Areas and dimensions are approximate and actual usable floor space may vary from the stated area. Layout may be reverse of the unit purchased. E & DE 4902

PLUMBING UPGRADES



POST-TEMP SHOWER ONLY* W/ 3 FUNCTION TRANSFER
VALVE/TRIM AND SLIDE BAR W/ HAND SHOWER

MOEN - ALIGN

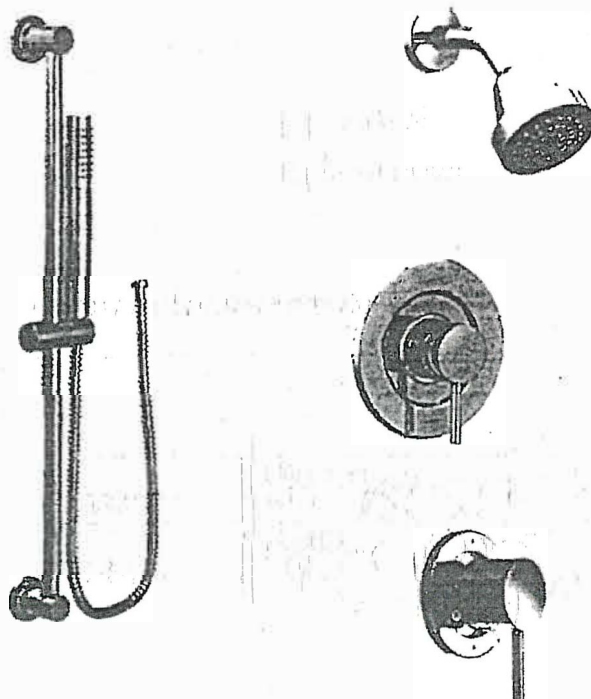

☒ CHROME

☐ from WALL

☐ BRUSHED GOLD

☒ from CEILING

☐ MATTE BLACK

MODEL T21193EP / 3372 / 128284 / T4191 / 62320 / 3887EP / A725

Lot#

122

Room:

MASTER ENSUITE

Signature:

Date:

APRIL 22 2020

Signature:

GOLDPARK
WORTH MORE