



CONSTRUCTION SUMMARY

Lot: 142
Model: 40.02 A VALLEYVIEW
Project/Phase: Pine Valley Forevergreen / 1

WINDOWS - BASEMENT

Invoice	Qty.	Description
2267 32005 08Apr20	2	BASEMENT WINDOWS - UPGRADE BASEMENT WINDOW SIZE TO 30 " X 24" - 8" FRAME
2267 32005 08Apr20	2	BASEMENT WINDOWS - UPGRADE BASEMENT WINDOW SIZE TO 30 " X 24" - 8" FRAME
2305 32701 23Apr20	2	BASEMENT WINDOWS - EGRESS BASEMENT WINDOW 47 " X 35" - 8" FRAME REAR ONLY

This Document is Extremely Time Sensitive - Printed 23 Apr 20 at 10:12

SCHEDULE 'F'




PV-142 *see attached see attached*
APRIL 3 2020

The Valleyview

40' SERIES

→ Elevation A • 3,145 sq.ft.
Elevation B • 3,170 sq.ft.

REVISED
APRIL 22 2020 *see attached see attached*

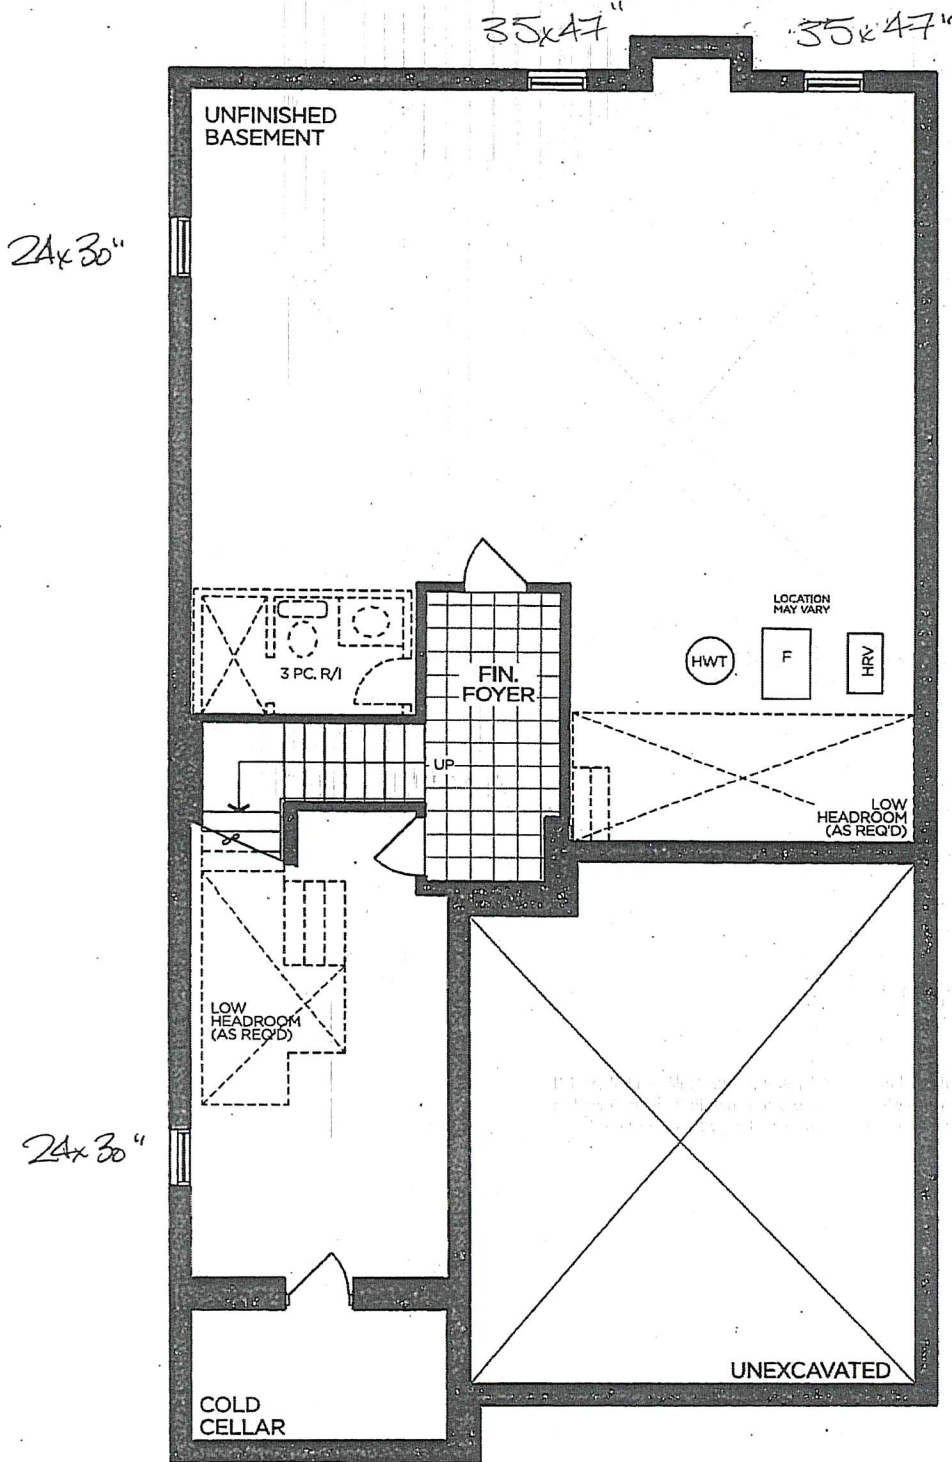

BASEMENT | ELEV. A

VENDOR

PURCHASER

PURCHASER

GOLDPARK

WORTH MORE™

Prices, figures, illustrations, sizes, features and finishes are subject to change without notice. Areas and dimensions are approximate and actual usable floor space may vary from the stated area. Layout may be reverse of the unit purchased. E. & O.E. 4002

SCHEDULE 'F'



The Valleyview
40' SERIES

Elevation A • 3,145 sq.ft.
Elevation B • 3,170 sq.ft.


APRIL 22 2020

TV-142
APRIL 22 2020

John

3748"

3748"

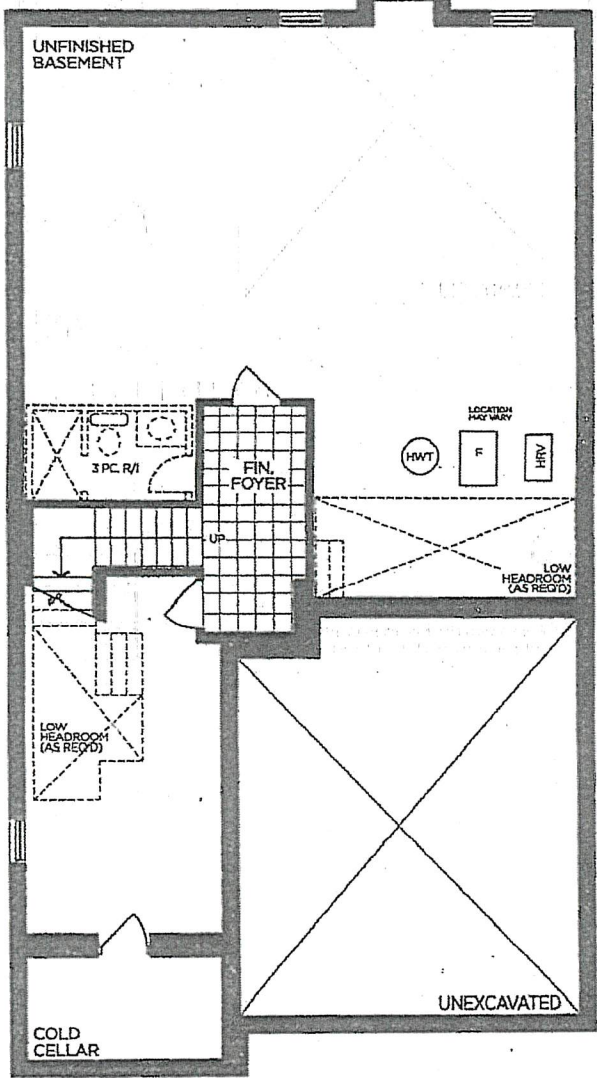

BASEMENT | ELEV. A

VENDOR

PURCHASER

PURCHASER

GOLDPARK
WORTH MORE

Prices, figures, illustrations, sizes, features and finishes are subject to change without notice. Areas and dimensions are approximate and actual usable floor space may vary from the stated area. Layout may be reverse of the unit purchased. E. & O.E. 4002