



CONSTRUCTION SUMMARY

Lot: 130
Model: 40.02 A VALLEYVIEW
Project/Phase: Pine Valley Forevergreen / 1

CONCRETE AND DRAIN

Invoice	Qty.	Description
2288 32304 20Apr20 NoCat	1	BACK-FLOW PREVENTER VALVE CONCRETE AND DRAIN

WINDOWS - BASEMENT

Invoice	Qty.	Description
2288 32302 20Apr20	2	BASEMENT WINDOWS - EGRESS BASEMENT WINDOW 47 " X 35" - 8" FRAME WINDOWS - BASEMENT 72,672 WINDOWS - BASEMENT
2288 32303 20Apr20	2	BASEMENT WINDOWS - UPGRADE BASEMENT WINDOW SIZE TO 30 " X 24" - 8" FRAME WINDOWS - BASEMENT 72,351 WINDOWS - BASEMENT
2288 32303 20Apr20	2	BASEMENT WINDOWS - UPGRADE BASEMENT WINDOW SIZE TO 30 " X 24" - 8" FRAME WINDOWS - BASEMENT 72,351 WINDOWS - BASEMENT
2312 32884 29Apr20	2	**DELETE** BASEMENT WINDOWS - EGRESS BASEMENT WINDOW 47 " X 35" - 8" FRAME WINDOWS - BASEMENT 72,672 DELETE FROM PREVIOUS ORDER
2312 32885 29Apr20	2	BASEMENT WINDOWS - UPGRADE BASEMENT WINDOW SIZE TO 30 " X 24" - 8" FRAME WINDOWS - BASEMENT 72,351 WINDOWS - BASEMENT REAR WINDOWS
2312 32885 29Apr20	2	BASEMENT WINDOWS - UPGRADE BASEMENT WINDOW SIZE TO 30 " X 24" - 8" FRAME WINDOWS - BASEMENT 72,351 WINDOWS - BASEMENT REAR WINDOWS


SCHEDULE 'F'



PV-130
APRIL 14 2020
REVISION APRIL 28 2020

The Valleyview
40' SERIES

Elevation A • 3,145 sq.ft.
Elevation B • 3,170 sq.ft.

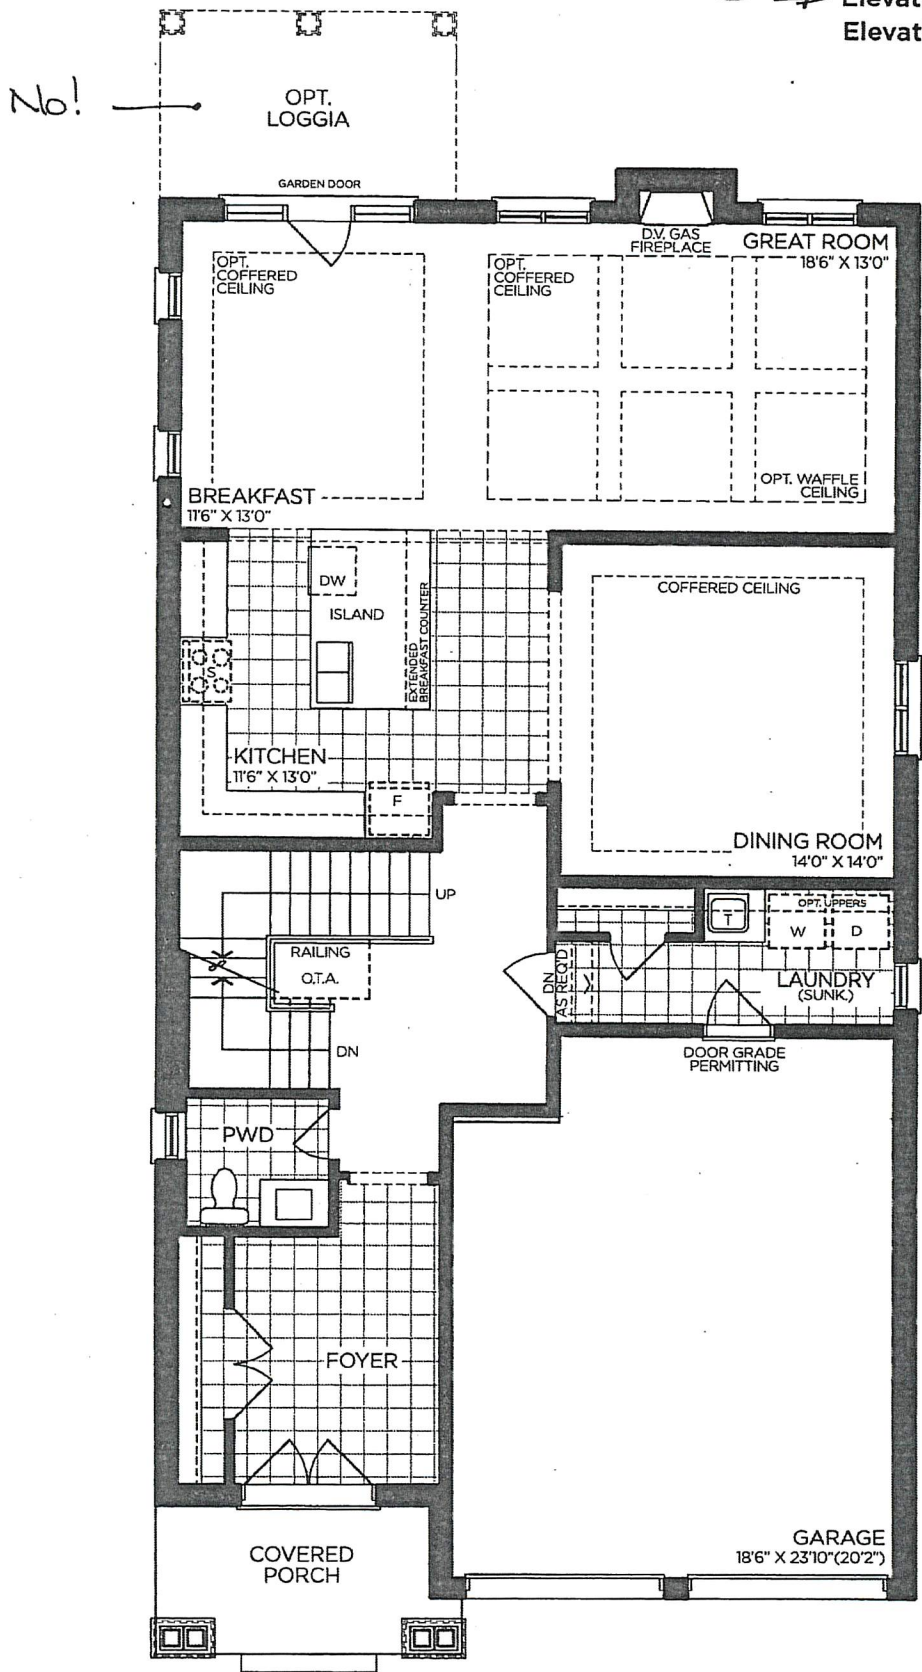

GROUND FLOOR | ELEV. A

VENDOR

PURCHASER

PURCHASER

GOLDPARK
WORTH MORE™

Prices, figures, illustrations, sizes, features and finishes are subject to change without notice. Areas and dimensions are approximate and actual usable floor space may vary from the stated area. Layout may be reverse of the unit purchased. E. & O.E. 4002



SCHEDULE 'F'

PL 130
APRIL 14 2020

* ~~REVISED~~ * APRIL 28 2020


see attached
see attached

see attached

see attached

The Valleyview 40' SERIES

Elevation A • 3,145 sq.ft.
Elevation B • 3,170 sq.ft.

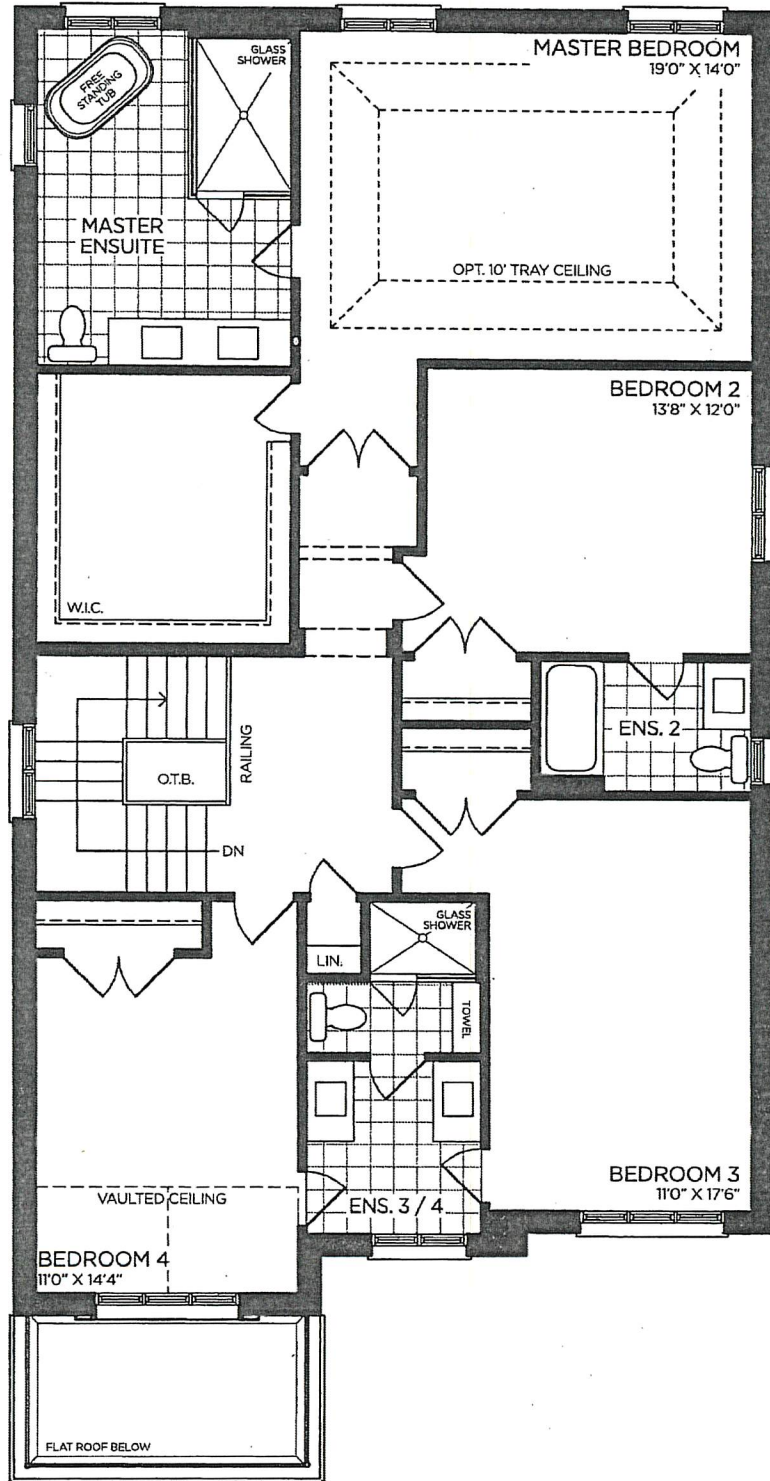

SECOND FLOOR | ELEV. A
3

VENDOR	
PURCHASER	
PURCHASER	

GOLDPARK
WORTH MORE™

Prices, figures, illustrations, sizes, features and finishes are subject to change without notice. Areas and dimensions are approximate and actual usable floor space may vary from the stated area. Layout may be reverse of the unit purchased. E. & O.E. 4002


SCHEDULE 'F'



PV- 130 *See attached*
APRIL 14 2026 *See attached*
*REVISED APRIL 28 2026 *See attached*

The Valleyview
40' SERIES

Elevation A • 3,145 sq.ft.
Elevation B • 3,170 sq.ft.

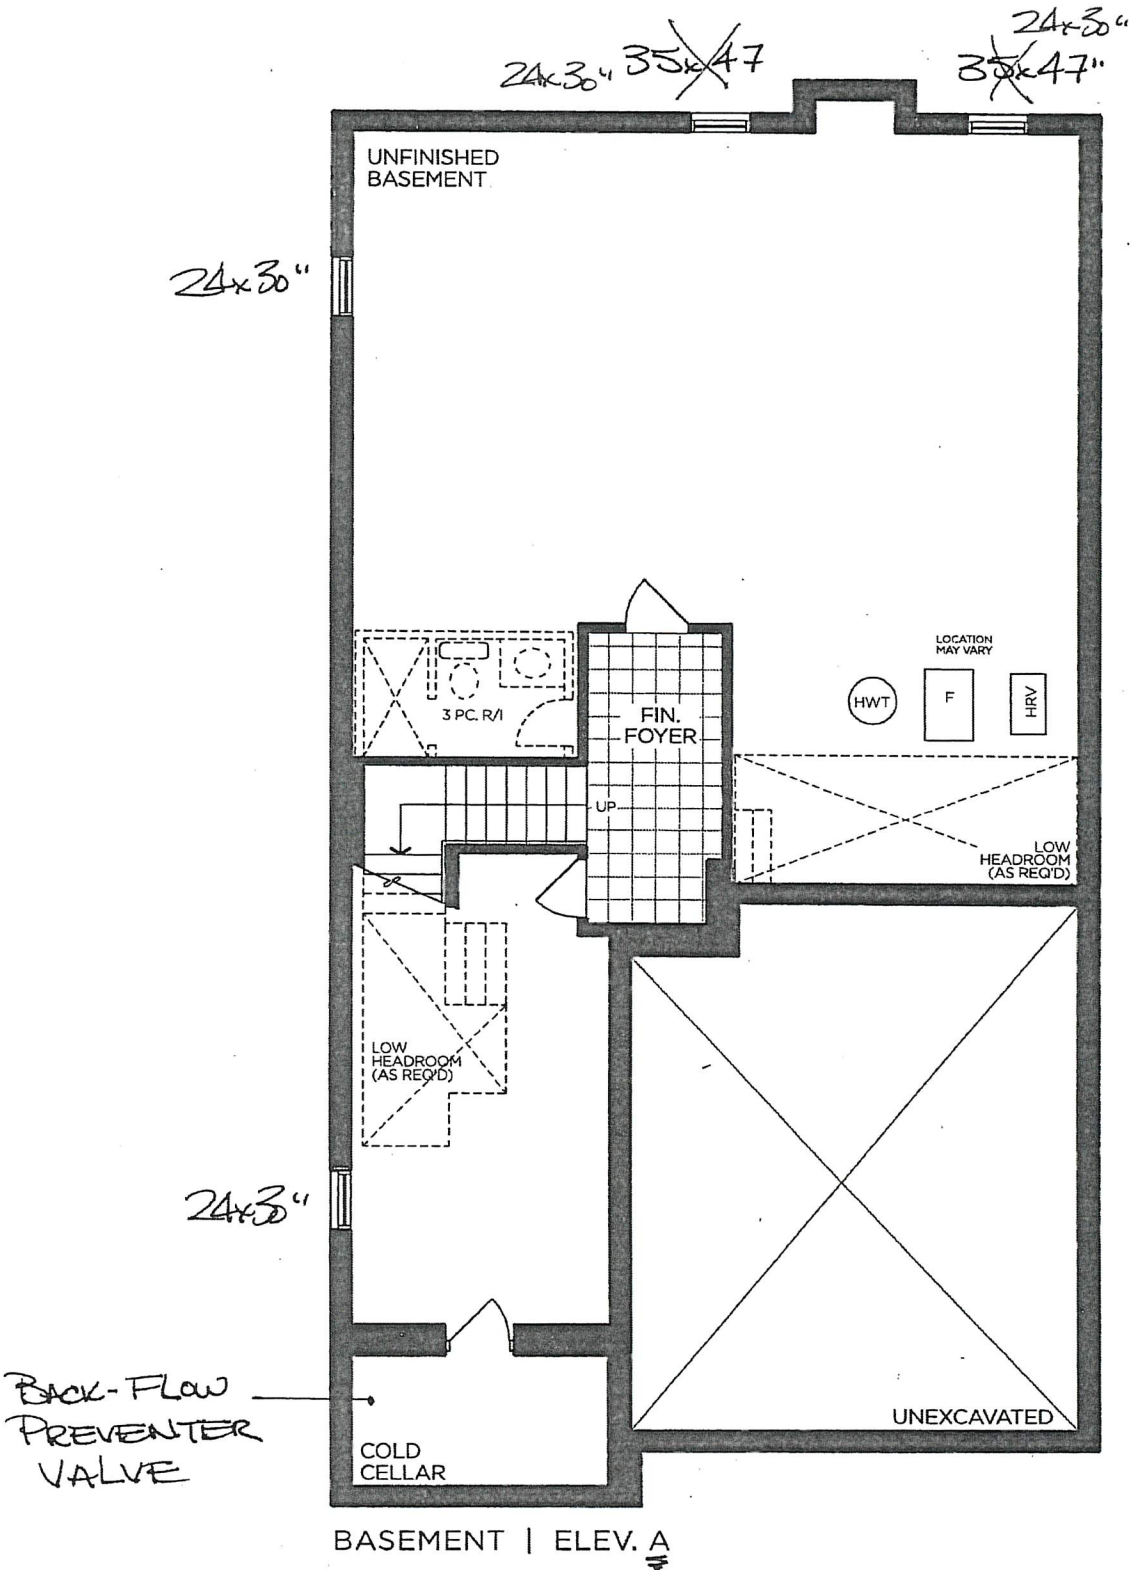

VENDOR

PURCHASER

PURCHASER

GOLDPARK
WORTH MORE™

Prices, figures, illustrations, sizes, features and finishes are subject to change without notice. Areas and dimensions are approximate and actual usable floor space may vary from the stated area. Layout may be reverse of the unit purchased. E. & O.E. 4002


SCHEDULE 'F'



PV 130 attached
April 14 2022
REVISED April 28 2022

The Valleyview
40' SERIES

Elevation A • 3,145 sq.ft.
Elevation B • 3,170 sq.ft.

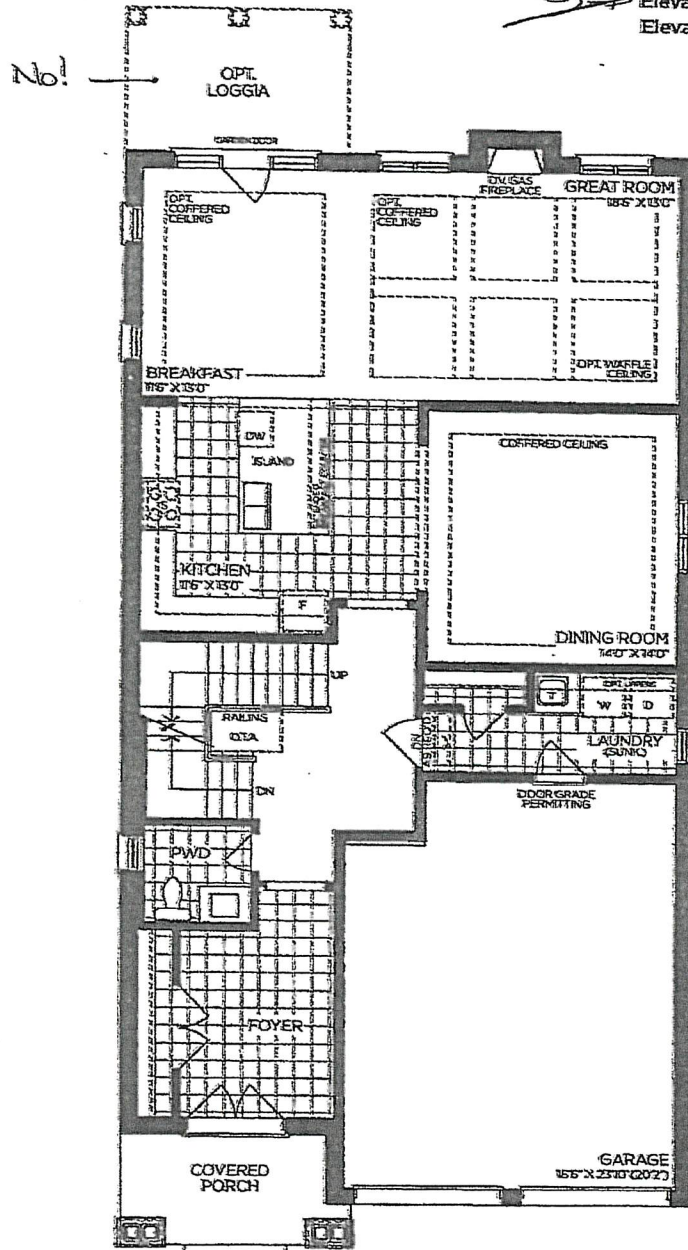

GROUND FLOOR | ELEV. A

VENDOR
PURCHASER
PURCHASER

GOLDPARK
WORTH MORE

Prices, figures, illustrations, sizes, features and finishes are subject to change without notice. Areas and dimensions are approximate and actual usable floor space may vary from the stated area. Layout may be reverse of the unit purchased. E. & OE 40022



SCHEDULE 'F'


PL 130
APRIL 14 2020

* REVERSED * APRIL 28 2020

attached to set attached

The Valleyview
40' SERIES

Elevation A • 3,145 sq.ft.
Elevation B • 3,170 sq.ft.

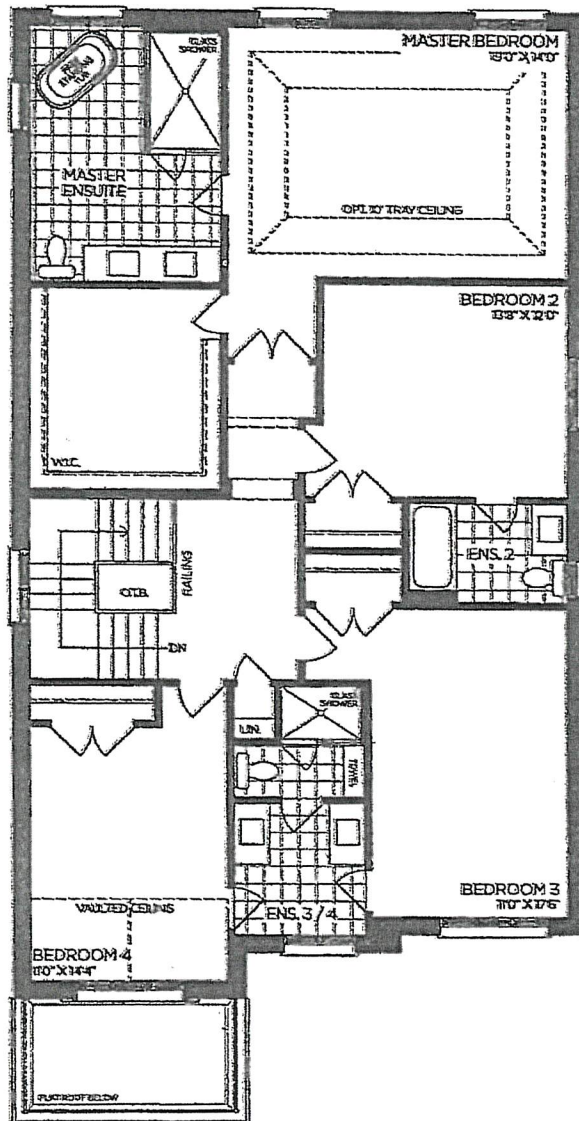

SECOND FLOOR | ELEV. A

VENDOR

PURCHASER

PURCHASER

GOLDPARK
WORTH MORE


Prices, figures, illustrations, sizes, features and finishes are subject to change without notice. Areas and dimensions are approximate and actual usable floor space may vary from the stated area. Layout may be reverse of the unit purchased. E. & G.E. 4002

SCHEDULE 'F'



PV-130 *Set Point Attached*
April 14 2022
~~*REVISED*~~ April 28 2022

The Valleyview
40' SERIES
Elevation A • 3,145 sq.ft.
Elevation B • 3,170 sq.ft.

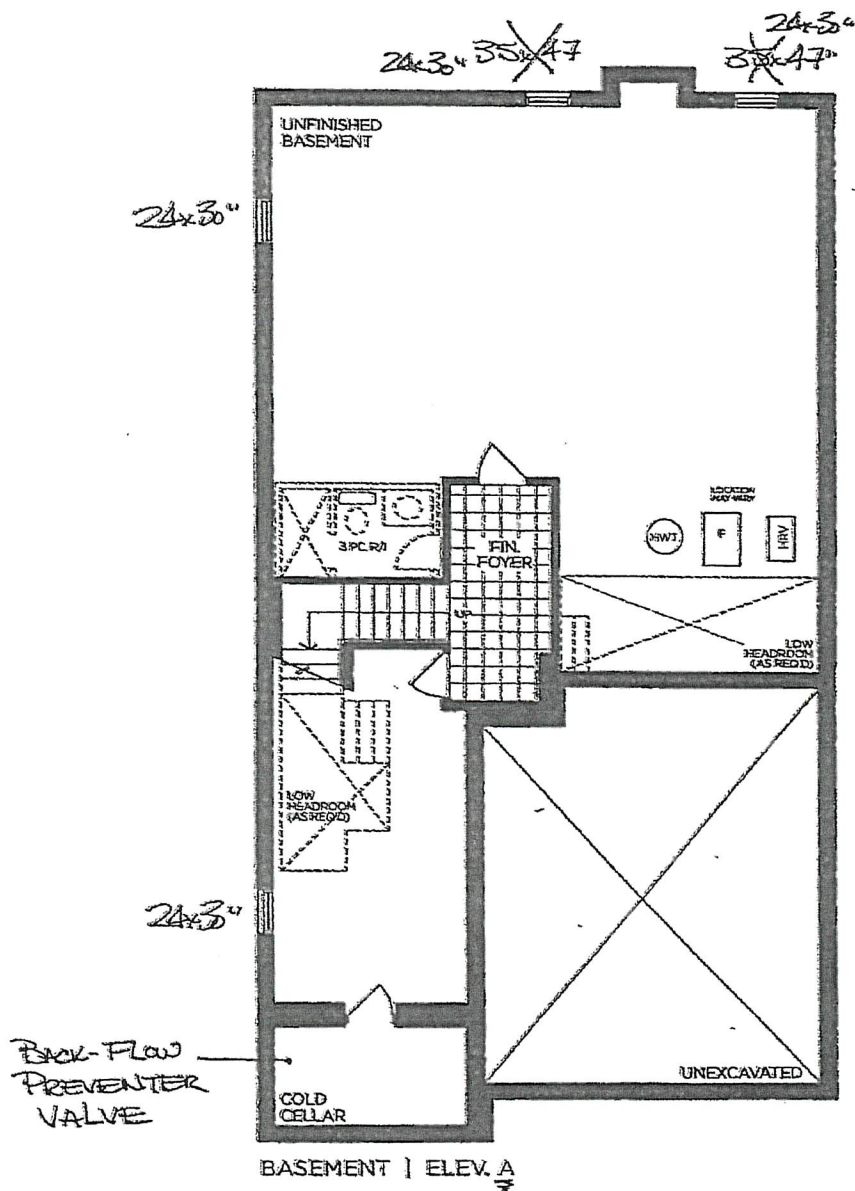

VENDOR

PURCHASER

PURCHASER

GOLDPARK
WORTH MORE™

Prices, figures, illustrations, sizes, features and finishes are subject to change without notice. Areas and dimensions are approximate and actual usable floor space may vary from the stated area. Layout may be reverse of the unit purchased. E & C.E. 4002