



CONSTRUCTION SUMMARY

Lot: 117
Model: 40.06 A LILAC
Project/Phase: Pine Valley Forevergreen / 1

CONCRETE AND DRAIN

Invoice	Qty.	Description
2254 31985 31Mar20 NoCat	1	BACK-FLOW PREVENTER VALVE

DRYWALL

Invoice	Qty.	Description
2254 31931 31Mar20 **	1	BASEMENT WINDOWS - UPGRADE BASEMENT WINDOW SIZE TO 30 " X 24" - 8" FRAME
2303 32682 23Apr20 **	1	GREAT ROOM - OPT. COFFERED CEILING AS PER PLAN
2303 32683 23Apr20 **	1	GREAT ROOM - OPT. WAFFLE CEILING, BEAM DETAIL AS PER PLAN (9 BOXES) OPTION # 1 CTR-B07
2303 32684 23Apr20 **	1	LIBRARY - OPT. LIBRARY COFFERED CEILING AS PER PLAN
2303 32685 23Apr20 **	1	LIBRARY - OPT. WAFFLE CEILING, BEAM DETAIL AS PER PLAN (4 BOXES) OPTION #1 CTR-B07

ELECTRICAL

Invoice	Qty.	Description
2254 31931 31Mar20 **	1	BASEMENT WINDOWS - UPGRADE BASEMENT WINDOW SIZE TO 30 " X 24" - 8" FRAME
2303 32682 23Apr20 **	1	GREAT ROOM - OPT. COFFERED CEILING AS PER PLAN
2303 32683 23Apr20 **	1	GREAT ROOM - OPT. WAFFLE CEILING, BEAM DETAIL AS PER PLAN (9 BOXES) OPTION # 1 CTR-B07
2303 32684 23Apr20 **	1	LIBRARY - OPT. LIBRARY COFFERED CEILING AS PER PLAN
2303 32685 23Apr20 **	1	LIBRARY - OPT. WAFFLE CEILING, BEAM DETAIL AS PER PLAN (4 BOXES) OPTION #1 CTR-B07



CONSTRUCTION SUMMARY

Lot: 117
Model: 40.06 A LILAC
Project/Phase: Pine Valley Forevergreen / 1

ELECTRICAL APPLIANCES

Invoice	Qty.	Description
2303 32676 23Apr20	1	KITCHEN: 240v WALL RECEPTACLE ON SEPARATE CIRCUIT FOR BUILT-INS. - APPROX. LOCATION AS PER ATTACHED DRAWINGS
2303 32677 23Apr20	1	KITCHEN: 110V WALL RECEPTACLE ON SEPARATE CIRCUIT - GAS FIRED APPLIANCE - FOR AUX. EQUIPMENT - NOT A STOVE PLUG

ELECTRICAL INTERIOR

Invoice	Qty.	Description
2303 32693 23Apr20	1	GREAT ROOM: INTERIOR WALL OUTLET: ADDITIONAL 110V WALL INTERIOR RECEPTACLE ON EXISTING CIRCUIT FOR WALL MOUNTED TV - LOCATE APPROX. 66" A.F.F. ABOVE FIREPLACE

ELECTRICAL POTLIGHT

Invoice	Qty.	Description
2303 32681 23Apr20	6	KITCHEN: 4" E/S LED INTERIOR POT LIGHT - GROUND FLOOR - EACH, COMPLETE WITH SWITCH INCLUDED IN APS
2303 32686 23Apr20	8	GREAT ROOM: 4" E/S LED INTERIOR POT LIGHT - GROUND FLOOR - EACH
2303 32690 23Apr20	1	LIBRARY: UPGRADE STANDARD CEILING MOUNT FIXTURE TO (1) LED POT LIGHT - GROUND FLOOR - MUST SPECIFY LOCATION (CAN BE RELOCATED)
2303 32688 23Apr20	3	LIBRARY: 4" E/S LED INTERIOR POT LIGHT - GROUND FLOOR - EACH

ELECTRICAL ROUGH-IN

Invoice	Qty.	Description
2303 32679 23Apr20	2	KTICHEN: ROUGH-IN FOR CAPPED CEILING OUTLET (FUTURE LIGHT FIXTURE) - EACH APPROX CENTERED ABOVE ISLAND



CONSTRUCTION SUMMARY

Lot: 117
Model: 40.06 A LILAC
Project/Phase: Pine Valley Forevergreen / 1

ELECTRICAL SWITCH

Invoice	Qty.	Description
2303 32680 23Apr20	1	KITCHEN: ADDITIONAL INTERIOR SWITCH FOR ISLAND LIGHTS
2303 32687 23Apr20	1	GREAT ROOM: ADDITIONAL INTERIOR SWITCH FOR POTLIGHTS
2303 32689 23Apr20	1	LIBRARY: ADDITIONAL INTERIOR SWITCH FOR POTLIGHTS

FORM - FORMING

Invoice	Qty.	Description
2254 31931 31Mar20 **	1	BASEMENT WINDOWS - UPGRADE BASEMENT WINDOW SIZE TO 30 " X 24" - 8" FRAME

FRAMING

Invoice	Qty.	Description
2303 32691 23Apr20 NoCat	5	MAIN FLOOR: 9' DOORS ON MAIN FLOOR (EXCLUDING MUDROOM AND MUDROOM WIC)
2303 32695 23Apr20	1	DRESSING ROOM: SUN TUNNEL EXTENSION, 6 FOOT RIGID TUNNEL EXTENSION [2TR 6 FOOT] - UP TO 6 FOOT MAX.

HVAC

Invoice	Qty.	Description
2303 32678 23Apr20	1	KITCHEN: GAS LINE ROUGH-IN - MAIN FLOOR FOR APPLIANCE - MUST SPECIFY APPROX. LOCATION

INTERIOR DOORS

Invoice	Qty.	Description
2303 32697 23Apr20	18	2ND FLOOR THRU OUT: INCREASE HEIGHT OF DOOR TO 8FT SECOND FLOOR - PER DOOR



CONSTRUCTION SUMMARY

Lot: 117
Model: 40.06 A LILAC
Project/Phase: Pine Valley Forevergreen / 1

INTERIOR TRIM /MOULDINGS

Invoice	Qty.	Description
2254 31931 31Mar20 **	1	BASEMENT WINDOWS - UPGRADE BASEMENT WINDOW SIZE TO 30 " X 24" - 8" FRAME
2303 32682 23Apr20 **	1	GREAT ROOM - OPT. COFFERED CEILING AS PER PLAN
2303 32683 23Apr20 **	1	GREAT ROOM - OPT. WAFFLE CEILING, BEAM DETAIL AS PER PLAN (9 BOXES) OPTION # 1 CTR-B07
2303 32684 23Apr20 **	1	LIBRARY - OPT. LIBRARY COFFERED CEILING AS PER PLAN
2303 32685 23Apr20 **	1	LIBRARY - OPT. WAFFLE CEILING, BEAM DETAIL AS PER PLAN (4 BOXES) OPTION #1 CTR-B07

MODEL OPTIONS 40.06

Invoice	Qty.	Description
2303 32682 23Apr20	1	GREAT ROOM - OPT. COFFERED CEILING AS PER PLAN
2303 32683 23Apr20	1	GREAT ROOM - OPT. WAFFLE CEILING, BEAM DETAIL AS PER PLAN (9 BOXES) OPTION # 1 CTR-B07
2303 32684 23Apr20	1	LIBRARY - OPT. LIBRARY COFFERED CEILING AS PER PLAN
2303 32685 23Apr20	1	LIBRARY - OPT. WAFFLE CEILING, BEAM DETAIL AS PER PLAN (4 BOXES) OPTION #1 CTR-B07

MODEL OPTIONS 40.06.A

Invoice	Qty.	Description
2303 32694 23Apr20	1	MASTER BEDROOM - OPT. 10 FOOT TRAY CEILING AS PER PLAN **SQUARE OFF - LIKE ELEVATION C**



CONSTRUCTION SUMMARY

Lot: 117
Model: 40.06 A LILAC
Project/Phase: Pine Valley Forevergreen / 1

MODEL OPTIONS 40.07

Invoice	Qty.	Description
2303 32682 23Apr20 **	1	GREAT ROOM - OPT. COFFERED CEILING AS PER PLAN
2303 32683 23Apr20 **	1	GREAT ROOM - OPT. WAFFLE CEILING, BEAM DETAIL AS PER PLAN (9 BOXES) OPTION # 1 CTR-B07

MODEL OPTIONS 42.02

Invoice	Qty.	Description
2303 32683 23Apr20 **	1	GREAT ROOM - OPT. WAFFLE CEILING, BEAM DETAIL AS PER PLAN (9 BOXES) OPTION # 1 CTR-B07

MODEL OPTIONS 50.02

Invoice	Qty.	Description
2303 32685 23Apr20 **	1	LIBRARY - OPT. WAFFLE CEILING, BEAM DETAIL AS PER PLAN (4 BOXES) OPTION #1 CTR-B07

MODEL OPTIONS 50.04

Invoice	Qty.	Description
2303 32685 23Apr20 **	1	LIBRARY - OPT. WAFFLE CEILING, BEAM DETAIL AS PER PLAN (4 BOXES) OPTION #1 CTR-B07

NETWORK AND WIRING

Invoice	Qty.	Description
2303 32692 23Apr20	1	GREAT ROOM: CONDUIT PIPE - FOR WALL MOUNT TV - LOCATE APPROX. 66" A.F.F. TERMINATING AT CABLE SEE PLAN FOR LOCATION



CONSTRUCTION SUMMARY

Lot: 117
Model: 40.06 A LILAC
Project/Phase: Pine Valley Forevergreen / 1

PAINTING

Invoice	Qty.	Description
2254 31931 31Mar20 **	1	BASEMENT WINDOWS - UPGRADE BASEMENT WINDOW SIZE TO 30 " X 24" - 8" FRAME
2303 32682 23Apr20 **	1	GREAT ROOM - OPT. COFFERED CEILING AS PER PLAN
2303 32683 23Apr20 **	1	GREAT ROOM - OPT. WAFFLE CEILING, BEAM DETAIL AS PER PLAN (9 BOXES) OPTION # 1 CTR-B07
2303 32684 23Apr20 **	1	LIBRARY - OPT. LIBRARY COFFERED CEILING AS PER PLAN
2303 32685 23Apr20 **	1	LIBRARY - OPT. WAFFLE CEILING, BEAM DETAIL AS PER PLAN (4 BOXES) OPTION #1 CTR-B07

PANL - FRAMING

Invoice	Qty.	Description
2254 31931 31Mar20 **	1	BASEMENT WINDOWS - UPGRADE BASEMENT WINDOW SIZE TO 30 " X 24" - 8" FRAME
2303 32682 23Apr20 **	1	GREAT ROOM - OPT. COFFERED CEILING AS PER PLAN
2303 32683 23Apr20 **	1	GREAT ROOM - OPT. WAFFLE CEILING, BEAM DETAIL AS PER PLAN (9 BOXES) OPTION # 1 CTR-B07
2303 32684 23Apr20 **	1	LIBRARY - OPT. LIBRARY COFFERED CEILING AS PER PLAN
2303 32685 23Apr20 **	1	LIBRARY - OPT. WAFFLE CEILING, BEAM DETAIL AS PER PLAN (4 BOXES) OPTION #1 CTR-B07

PLUMBING

Invoice	Qty.	Description
2303 32696 23Apr20	1	BASEMENT: ADDITIONAL 3-PC BATHROOM (TOILET, SINK, FAUCET, TUB) COMPLETE WITH BUILDERS STANDARD OFFERINGS
2316 32919 29Apr20	1	***DELETE***ADDITIONAL 3-PC BATHROOM (TOILET, SINK, FAUCET, TUB) COMPLETE WITH BUILDERS STANDARD OFFERINGS DELETE, DO NOT INSTALL - LEAVE STANDARD ROUGH-IN ONLY



CONSTRUCTION SUMMARY

Lot: 117
Model: 40.06 A LILAC
Project/Phase: Pine Valley Forevergreen / 1

ROUGH CARPENTRY

Invoice	Qty.	Description
2254 31931 31Mar20 **	1	BASEMENT WINDOWS - UPGRADE BASEMENT WINDOW SIZE TO 30 " X 24" - 8" FRAME
2303 32682 23Apr20 **	1	GREAT ROOM - OPT. COFFERED CEILING AS PER PLAN
2303 32683 23Apr20 **	1	GREAT ROOM - OPT. WAFFLE CEILING, BEAM DETAIL AS PER PLAN (9 BOXES) OPTION # 1 CTR-B07
2303 32684 23Apr20 **	1	LIBRARY - OPT. LIBRARY COFFERED CEILING AS PER PLAN
2303 32685 23Apr20 **	1	LIBRARY - OPT. WAFFLE CEILING, BEAM DETAIL AS PER PLAN (4 BOXES) OPTION #1 CTR-B07

WINDOWS - BASEMENT

Invoice	Qty.	Description
2254 31931 31Mar20	1	BASEMENT WINDOWS - UPGRADE BASEMENT WINDOW SIZE TO 30 " X 24" - 8" FRAME
2254 31931 31Mar20	1	BASEMENT WINDOWS - UPGRADE BASEMENT WINDOW SIZE TO 30 " X 24" - 8" FRAME

This Document is Extremely Time Sensitive - Printed 29 Apr 20 at 14:19


SCHEDULE 'F'



PV-117
 APRIL 21 2020
 REVISED APRIL 28 2020

The Lilac 40' SERIES

→ Elevation A • 3,425 sq.ft.
 Elevation B • 3,385 sq.ft.

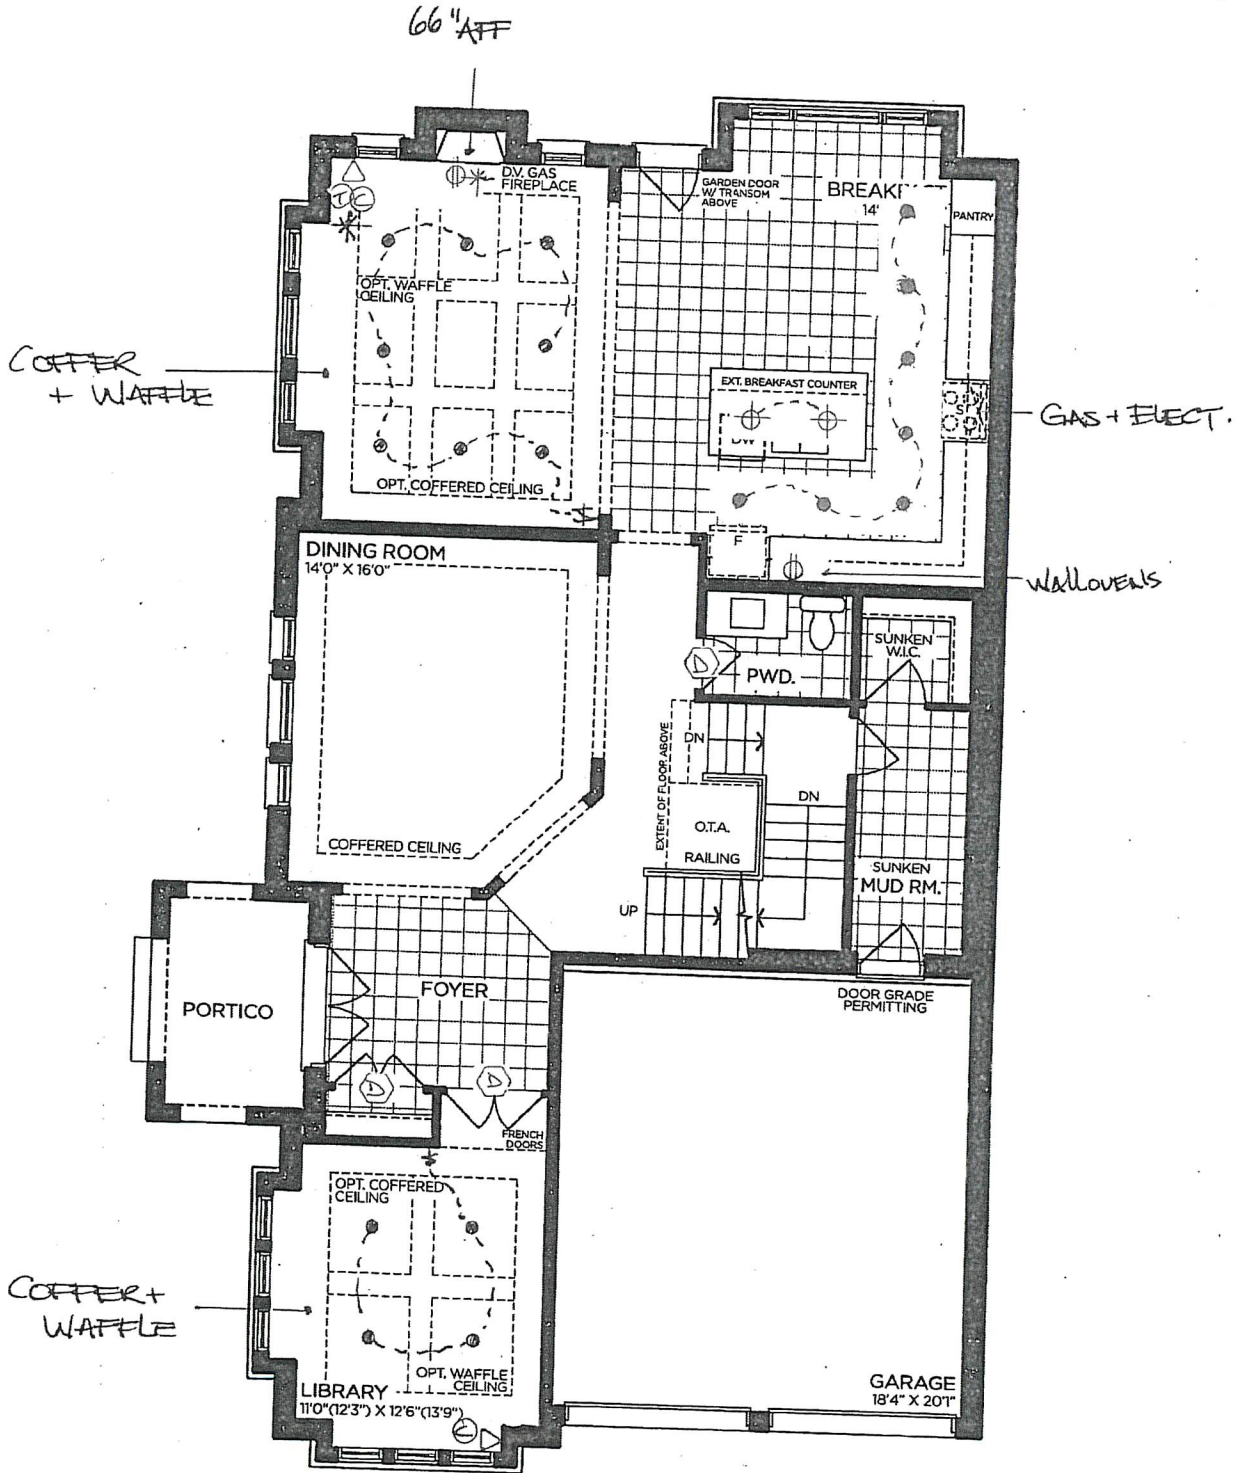

GROUND FLOOR | ELEV. A

VENDOR	
PURCHASER	
PURCHASER	

GOLDPARK
 WORTH MORE™

Prices, figures, illustrations, sizes, features and finishes are subject to change without notice. Areas and dimensions are approximate and actual usable floor space may vary from the stated area. Layout may be reverse of the unit purchased. E. & O.E. 4006

SCHEDULE 'F'




PV-117
APRIL 2, 2020

REVISED APRIL 28, 2020

The
Lilac
40' SERIES

Elevation A • 3,425 sq.ft.
Elevation B • 3,385 sq.ft.

8' DOORS
on 2ND FLOOR

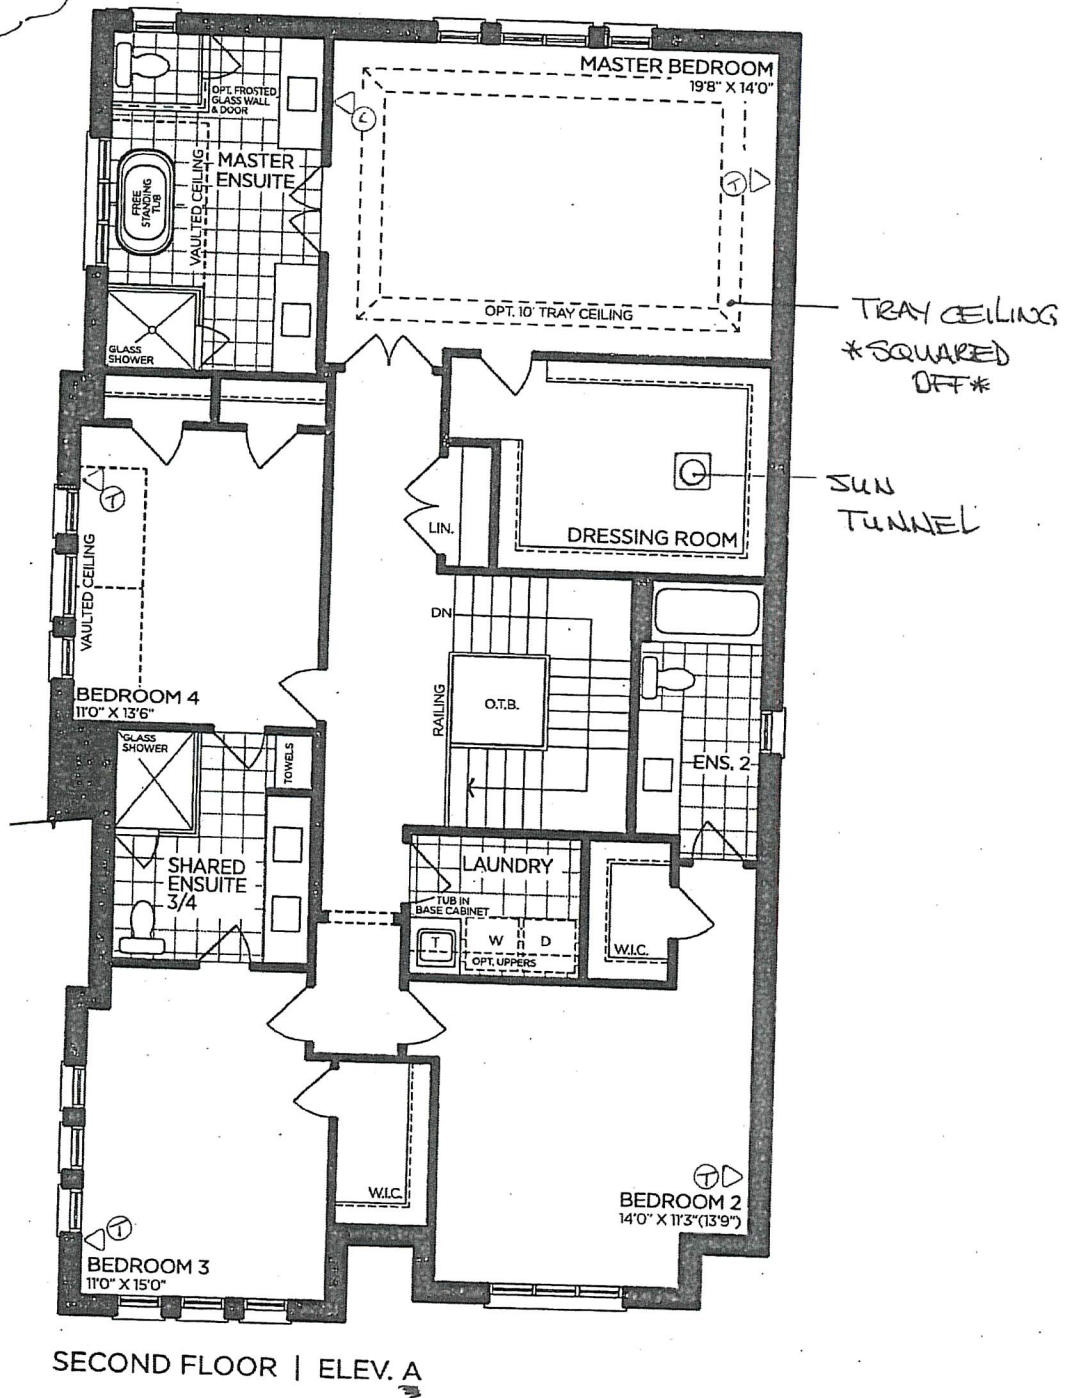

SECOND FLOOR | ELEV. A

VENDOR

PURCHASER

PURCHASER

GOLDPARK
WORTH MORE™

Prices, figures, illustrations, sizes, features and finishes are subject to change without notice. Areas and dimensions are approximate and actual usable floor space may vary from the stated area. Layout may be reverse of the unit purchased. E. & O.E. 4006

SCHEDULE 'F'




PV-117
APRIL 21 2020

REVISED APRIL 28 2020

The
Lilac
40' SERIES

Elevation A • 3,425 sq.ft.
Elevation B • 3,385 sq.ft.

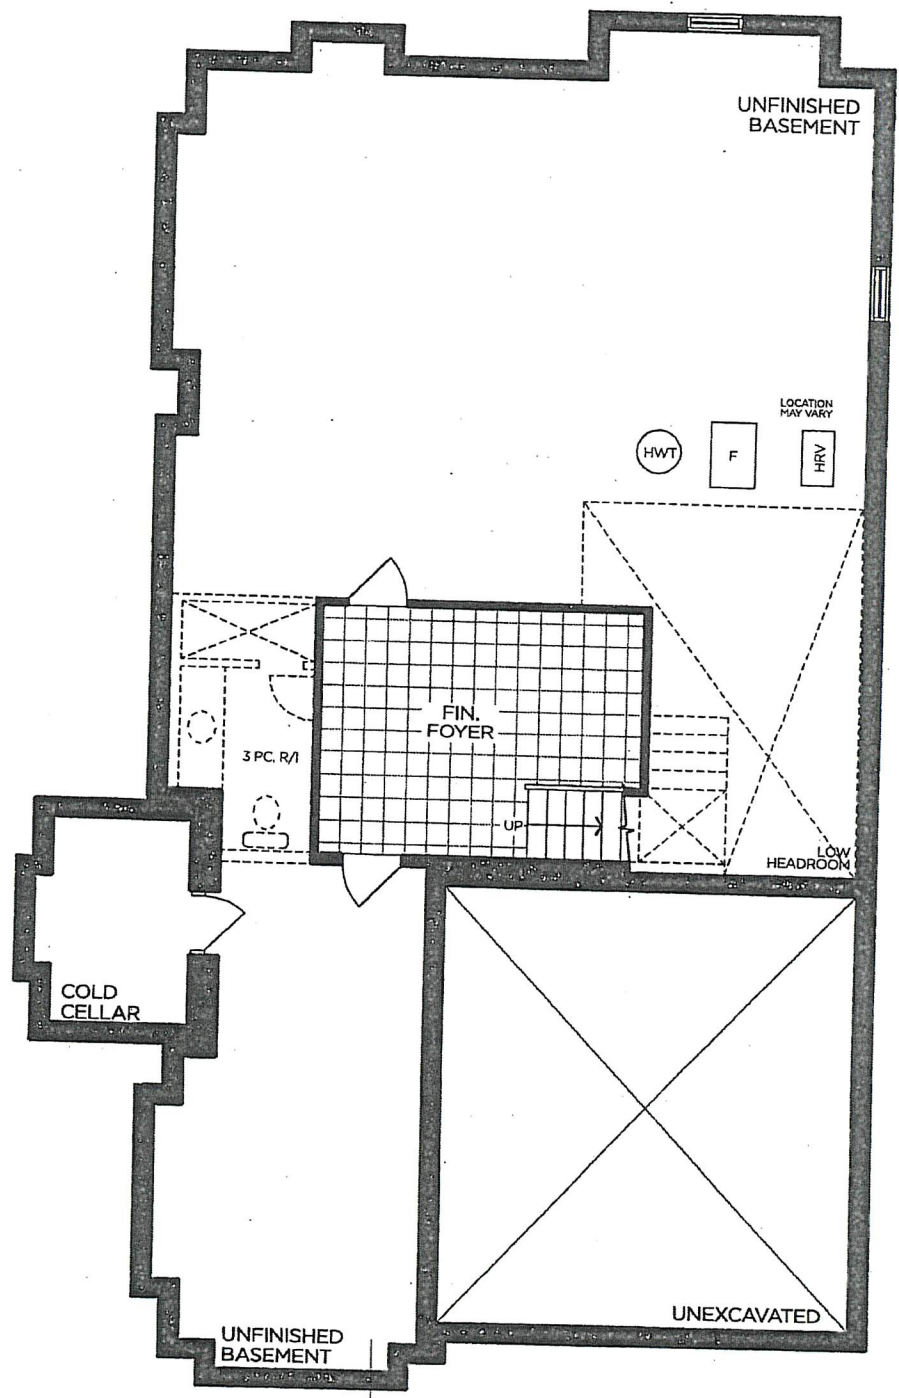

24x30"

BASEMENT | ELEV. A

BACK FLOW
PREVENTER
VALVE

VENDOR	
PURCHASER	
PURCHASER	

GOLDPARK
WORTH MORE™

Prices, figures, illustrations, sizes, features and finishes are subject to change without notice. Areas and dimensions are approximate and actual usable floor space may vary from the stated area. Layout may be reverse of the unit purchased. E. & O.E. 4006