

Lot: 77R

Model: 28-09 Elev B Gershwin Project/Phase: Brampton Encore / 2

APPLIANCES

Invoice	Qty.	Description
---------	------	-------------

2246	1	APPLIANCE PACKAGE: FRIDGE/STOVE/DISHWASHER - STAINLESS STEEL + WASHER/DRYER - WHITE
31883		

30Apr20 INCLUDED IN APS

CERAMIC

Invoice Qty. Description

2246 32989	1	TWIN BATHOOM: UPGRADE TO STANDING SHOWER IN LIEU OF TUB - INCLUDES TILE BASE, POTLIGHT AND FRAMED GLASS ENCLOSURE
30Apr20 NoCat		

CONCRETE AND DRAIN

Invoice Qty. Description

2246	1	ROUGH-IN - 3PC BASEMENT ROUGH-IN
31882		DVGLADED NA ADG
30Apr20		INCLUDED IN APS

ELECTRICAL

Invoice Qty. Description

2246 32988	1	TWIN BATHOOM: UPGRADE TO STANDING SHOWER IN LIEU OF TUB - INCLUDES TILE BASE, POTLIGHT AND FRAMED GLASS ENCLOSURE
30Apr20 NoCat		

ELECTRICAL POTLIGHT

Invoice	Qty. Description	

2246 32992	-	TWIN BATHOOM: UPGRADE TO STANDING SHOWER IN LIEU OF TUB - INCLUDES TILE BASE, POTLIGHT AND FRAMED GLASS ENCLOSURE
30Apr20 NoCat		

EXTERIOR COLOURS

Invoice Qty. Description

2246 32987	1	EXTERIOR COLOUR PACKAGE # 9
32987		
30Apr20		
NoCat		

ryDiscipline.rpt 14Mar20 Page 1 of 4



Lot: 77R

Model: 28-09 Elev B Gershwin Project/Phase: Brampton Encore / 2

FORMING

Invoice	Qty.	Description
2246 31876 30Apr20 **	3	BASEMENT WINDOWS - UPGRADE EXISTING BASEMENT WINDOW TO 30 INCH X 24 INCH - MAY REQUIRE INSTALLATION OF WINDOW WELL
2246 31885 30Apr20	1	SIDE DOOR- HOME TO EXTERIOR- AS PER PLAN AND GRADE PERMITTING INCLUDED IN APS
30Api20		INCLUDED IN AIS
2246 31886	1	MANDOOR - GARAGE TO HOUSE- AS PER PLAN AND GRADE PERMITING
30Apr20 **		INCLUDED IN APS
2246 32993	1	TWIN BATHOOM: UPGRADE TO STANDING SHOWER IN LIEU OF TUB - INCLUDES TILE BASE, POTLIGHT AND FRAMED GLASS ENCLOSURE
30Apr20 NoCat		

FRAMING

FRAMING		
Invoice	Qty.	Description
2246 31886	1	MANDOOR - GARAGE TO HOUSE- AS PER PLAN AND GRADE PERMITING
30Apr20		INCLUDED IN APS
2246 32983 30Apr20 NoCat	1	SIDE DOOR - AS PER PLAN AND GRADE PERMITTING
2246 32984 30Apr20 NoCat	1	MAIN FLOOR: EXTENDED HEIGHT ARCHWAY - 96"
2246 32991 30Apr20 NoCat	1	TWIN BATHOOM: UPGRADE TO STANDING SHOWER IN LIEU OF TUB - INCLUDES TILE BASE, POTLIGHT AND FRAMED GLASS ENCLOSURE

GLASS AND MIRROR

Invoice	Qty.	Description
2246 32990	_	TWIN BATHOOM: UPGRADE TO STANDING SHOWER IN LIEU OF TUB - INCLUDES TILE BASE, POTLIGHT AND FRAMED GLASS ENCLOSURE
30Apr20 NoCat		

HVAC

Invoice	Qty.	Description
2246 31884	1	A/C- 2.0 TON
30Apr20 NoCat		INCLUDED IN APS

ryDiscipline.rpt 14Mar20 Page 2 of 4



Lot: 77R

Model: 28-09 Elev B Gershwin Project/Phase: Brampton Encore / 2

INTERIOR TRIM AND DOORS

Invoice	Qty.	Description
2246 31878 30Apr20	1	MAIN FLOOR: EXTENDED HEIGHT ARCHWAY - 96"
2246 31885 30Apr20 **	1	SIDE DOOR- HOME TO EXTERIOR- AS PER PLAN AND GRADE PERMITTING INCLUDED IN APS
2246 32985 30Apr20 NoCat	1	GARAGE MANDOOR - AS PER PLAN AND GRADE PERMITTING

MISC.

Invoice Qty. Description

2246 31880	BONUS PACKAGE: \$5,000.00 (INCLUDING TAXES) WORTH OF UPGRADES FROM GOLD PARK HOMES DÉCOR CENTRE IS BEING APPLIED TOWARD THIS ORDER. PURCHASER HAS A REMAINING AMOUNT OF \$287.90 (INCLUDING TAXES).
30Apr20 NoCat	

PAINT

Invoice	Qty.	Description
---------	------	-------------

2246 31886 30Apr20 **	1	MANDOOR - GARAGE TO HOUSE- AS PER PLAN AND GRADE PERMITING INCLUDED IN APS
2246 32986 30Apr20 NoCat	1	SIDE DOOR - AS PER PLAN AND GRADE PERMITTING
2246 32994 30Apr20 NoCat	1	TWIN BATHOOM: UPGRADE TO STANDING SHOWER IN LIEU OF TUB - INCLUDES TILE BASE, POTLIGHT AND FRAMED GLASS ENCLOSURE

PLUMBING

2246 31877 30Apr20		TWIN BATHOOM: UPGRADE TO STANDING SHOWER IN LIEU OF TUB - INCLUDES TILE BASE, POTLIGHT AND FRAMED GLASS ENCLOSURE
2246 31882	1	ROUGH-IN - 3PC BASEMENT ROUGH-IN
30Apr20		INCLUDED IN APS

WINDOWS - BASEMENT

Invoice	Otv.	Description

2246 31876 30Apr20	-	BASEMENT WINDOWS - UPGRADE EXISTING BASEMENT WINDOW TO 30 INCH X 24 INCH - MAY REQUIRE INSTALLATION OF WINDOW WELL
--------------------------	---	--

ryDiscipline.rpt 14Mar20 Page 3 of 4



Lot: 77R

Model: 28-09 Elev B Gershwin Project/Phase: Brampton Encore / 2

WINDOWS AND DOORS

Invoice	Qty.	Description
2246 31885	1	SIDE DOOR- HOME TO EXTERIOR- AS PER PLAN AND GRADE PERMITTING
30Apr20 **		INCLUDED IN APS
2246 31886	1	MANDOOR - GARAGE TO HOUSE- AS PER PLAN AND GRADE PERMITING
30Apr20		INCLUDED IN APS

This Document is Extremely Time Sensitive - Printed $\underline{30~Apr~20}$ at $\underline{11:54}$

ryDiscipline.rpt 14Mar20 Page 4 of 4



BEZ-77R & Stack.
MARCH 26 2020


The Gershwin


Elevation A • 1,920 sq.ft.

Elevation B • 1,920 sq.ft.

Elevation C • 1,920 sq.ft.

Elevation D • 1,920 sq.ft.

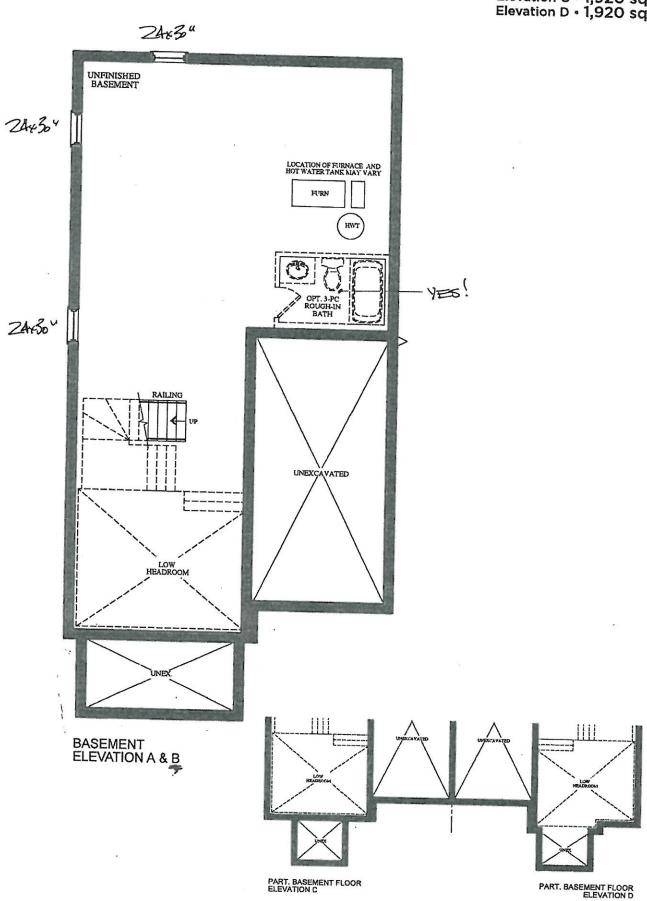

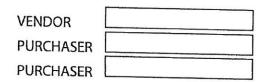

GOLDPARK

WORTH MORE"


Prices, figures, illustrations, sizes, features and finishes are subject to change without notice. Areas and dimensions are approximate and actual usable floor space may vary from the stated area. Layout may be reverse of the unit purchased. E. & O.E.



100 26 2020

The Gershwin

Elevation A • 1,920 sq.ft.
Elevation B • 1,920 sq.ft.
Elevation C • 1,920 sq.ft.

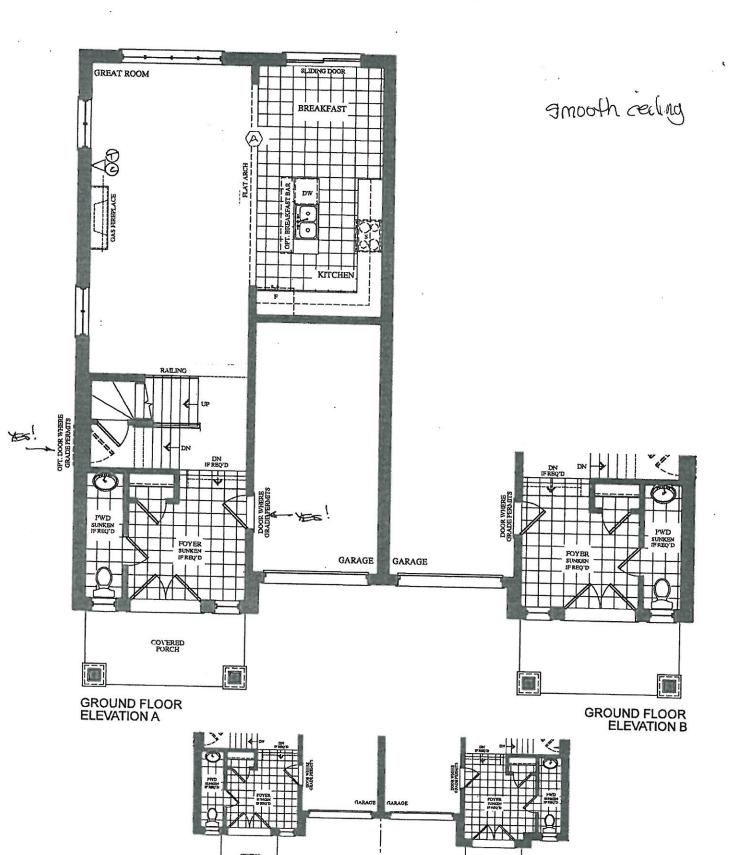

VENDOR
PURCHASER
PURCHASER

PART. GROUND FLOOR ELEVATION C

GOLDPARK

PART. GROUND FLOOR ELEVATION D

WORTH MORE


Prices, figures, illustrations, sizes, features and finishes are subject to change without notice. Areas and dimensions are approximate and actual usable floor space may vary from the stated area. Layout may be reverse of the unit purchased, E. & O.E.



75=2-77R° Markod 26 2020

The Gershwin SEMI SERIES

Elevation A • 1,920 sq.ft. Elevation B • 1,920 sq.ft. Elevation C • 1,920 sq.ft. Elevation D • 1,920 sq.ft.

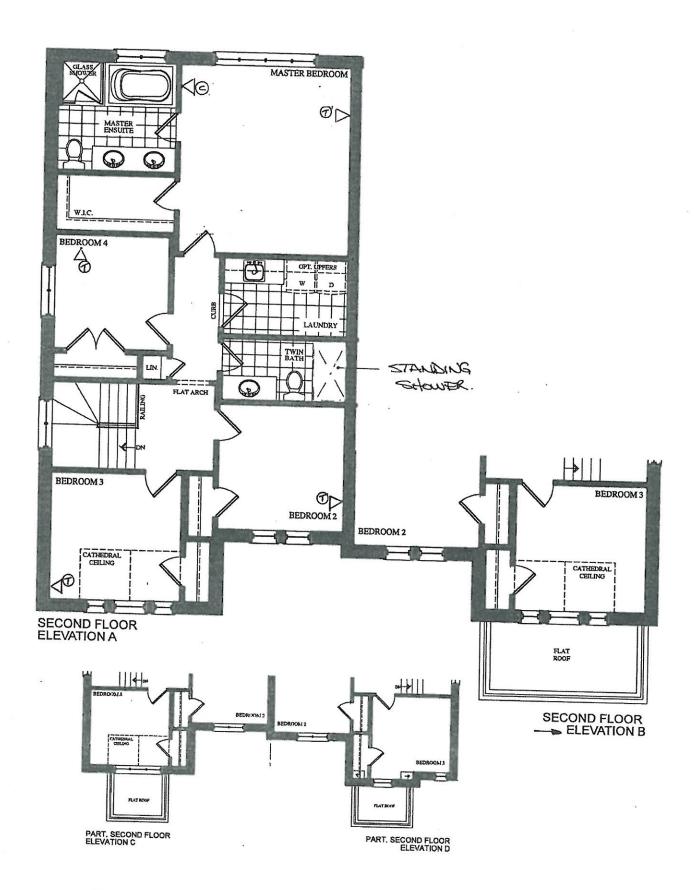

VENDOR PURCHASER PURCHASER GOLDPARK

Prices, figures, illustrations, sizes, features and finishes are subject to change without notice. Areas and dimensions are approximate and actual usable floor space may vary from the stated area. Layout may be reverse of the unit purchased, E. & O.E.