

CONSTRUCTION SUMMARY

Lot: 133

Model: 38-11 Elev B Schumann Project/Phase: Brampton Encore / 2

APPLIANCES

Invoice		Qty. Description			
	2282 32215	1	APPLIANCE PACKAGE: FRIDGE/STOVE/DISHWASHER - STAINLESS STEEL + WASHER/DRYER - WHITE		
	01May20 NoCat		INCLUDED IN APS		

CENTRAL VAC AND WIRING

Invoice Qty. Description		Description
2282 32217 01May20	1	FAMILY ROOM: CONDUIT PIPE- FOR TELEVISION- LOCATE APPROX. 66" A.F.F. ABOVE FIREPLACE, TERMINATING AT CABLE - SEE PLAN FOR LOCATION
2282 32219 01May20	1	FAMILY ROOM / LIVING ROOM / MASTER BEDROOM / BEDROOM 4: CAT 6 WIRING - ADD CAT 6- *PACKAGE OF 4* - SEE PLAN FOR LOCATION

CONCRETE AND DRAIN

Invoice	Qty. Description			
2282	1	ROUGH-IN - 3PC BASEMENT ROUGH-IN		
32214				
01May20 **		INCLUDED IN APS		

ELECTRICAL

ELECTRICAL				
Invoice	Qty.	Description		
2282 32218 01May20 FAMILY ROOM: 110V WALL RECEPTACLE ON DEDICATION OF THE PLACE		FAMILY ROOM: 110V WALL RECEPTACLE ON DEDICATED CIRCUIT- LOCATE APPROX. 66" A.F.F. ABOVE FIREPLACE		
2282 1 LIVING ROOM 32223		LIVING ROOM: ADD CAPPED CEILING OUTLET		
01May20 NoCat		LOCATE APPROX CENTER OF CEILING		
2282 32224 01May20 NoCat	1	LIVING ROOM: SINGLE POLE SWITCH FOR CEILING LIGHT		
2282 32225 01May20 NoCat	2	KITCHEN: : ADD CAPPED CEILING OUTLET, APPROX CENTERED ABOVE ISLAND		
2282 32226 01May20 NoCat	1	KITCHEN: SINGLE POLE SWITCH FOR ISLAND CAPPED CEILING OUTLETS		
2282 32275 01May20	1	200 AMP ELECTRICAL SERVICE		

ryDiscipline.rpt 14Mar20 Page 1 of 3



CONSTRUCTION SUMMARY

Lot: 133

Model: 38-11 Elev B Schumann Project/Phase: Brampton Encore / 2

EXTERIOR COLOURS

Invoice	Qty. Description		
2282 33065	1	EXTERIOR COLOUR PACKAGE # 6	
01May20 NoCat			

FORMING

Invoice Qty. Description		
2282 1 SIDE DOOR- HOME TO EXTERIOR- AS PER P		SIDE DOOR- HOME TO EXTERIOR- AS PER PLAN AND GRADE PERMITTING
01May20		INCLUDED IN APS
2282 32255	3	BASEMENT WINDOWS - UPGRADE EXISTING BASEMENT WINDOW TO 30 INCH X 16 INCH
01May20 **		INCLUDED IN APS
2282 33066	1	GARAGE MANDOOR - AS PER PLAN AND GRADE PERMITTING
01May20 NoCat		

FRAMING

Invoice Qty.		Description			
32213		MANDOOR - GARAGE TO HOUSE- AS PER PLAN AND GRADE PERMITTING			
		INCLUDED IN APS			
2282 33068	2	EXTENDED HEIGHT ARCHWAYS ON MAIN FLOOR - 96" (DOORS REMAIN STND. 80")			
01May20 NoCat					

HVAC

Invoice	Qty.	Description
2282 32216	1	A/C- 2.5 TON
01May20		INCLUDED IN APS
NoCat		

INTERIOR TRIM AND DOORS

Invoice	Qty.	Description
2282 1 SIDE DOOR- HOME TO EXTERIOR- AS PER PLAN AND GRADE PERMITTING 32212 01May20 INCLUDED IN APS		SIDE DOOR- HOME TO EXTERIOR- AS PER PLAN AND GRADE PERMITTING
		INCLUDED IN APS
2282 32221	2	MAIN FLOOR: EXTENDED HEIGHT ARCHWAY (PRICE PER DOORWAY) - 96"
01May20		DOORS REMAIN STD 80"
2282 1 GARAGE MANDOOR - AS PER PLAN AND GRADE PERMITTING 33067		GARAGE MANDOOR - AS PER PLAN AND GRADE PERMITTING
01May20 NoCat		

ryDiscipline.rpt 14Mar20 Page 2 of 3



Qty. Description

CONSTRUCTION SUMMARY

Purchaser has attended a phone appointment with the Decor Centre & has DECLINED any additional upgrades and accepts and

Lot: 133

Model: 38-11 Elev B Schumann Project/Phase: Brampton Encore / 2

1	N /	П	S	•	7
	V			•	

2282

Invoice

32254		acknowledges that there will be no further changes/additions/deletions to be made upon signing on April 9, 2020.			
01May20 NoCat					
PAINT					
Invoice		Description			
	Qty.	SIDE DOOR - AS PER PLAN AND GRADE PERMITTING			
Invoice	Qty.	 			

GARAGE MANDOOR - AS PER PLAN AND GRADE PERMITTING

NoCat	
	•

PLUN	ABIN	G
------	------	---

NoCat

2282 33071 01May20

Invoice	Qty.	Description
2282 32214 01May20		ROUGH-IN - 3PC BASEMENT ROUGH-IN INCLUDED IN APS
2282 32252 01May20	1	KITCHEN: ROUGH-IN - WATERLINE FOR FRIDGE

WINDOWS - BASEMENT

Invoice	Qty.	Description
2282 32255	3	BASEMENT WINDOWS - UPGRADE EXISTING BASEMENT WINDOW TO 30 INCH X 16 INCH
01May20		INCLUDED IN APS


WINDOWS AND DOORS

WINDOWS AND DOOKS				
Invoice	Qty.	Description		
2282 32212	1	SIDE DOOR- HOME TO EXTERIOR- AS PER PLAN AND GRADE PERMITTING		
01May20 **		INCLUDED IN APS		
2282	1	GARAGE MANDOOR - AS PER PLAN AND GRADE PERMITTING		
33069				
01May20 NoCat				

This Document is Extremely Time Sensitive - Printed 1 May 20 at 13:19

ryDiscipline.rpt 14Mar20 Page 3 of 3



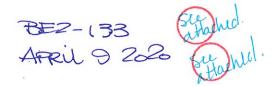


Schumann

38' SERIES

Elevation A • 3,050 sq.ft. Elevation B • 3,050 sq.ft.

16×300

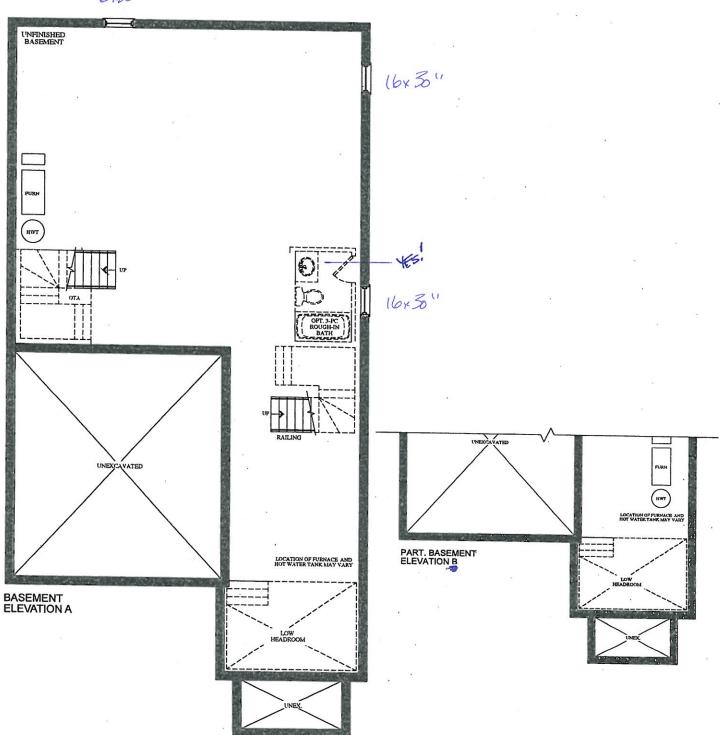



GOLDPARK

WORTH MORE

Prices, figures, illustrations, sizes, features and finishes are subject to change without notice. Areas and dimensions are approximate and actual usable floor space may vary from the stated area. Layout may be reverse of the unit purchased, E. & O.E.



SCHEDULE'F'


133 Surthuhad


APRIL 9 2020 Surahad

Schumann

38' SERIES

Elevation A • 3,050 sq.ft.
Elevation B • 3,050 sq.ft.

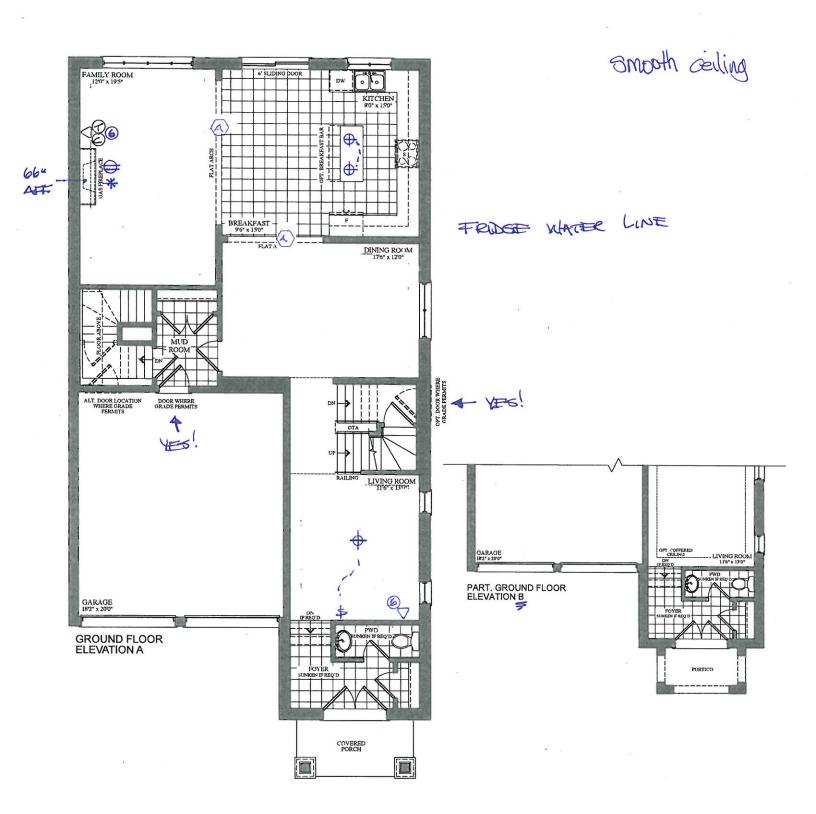

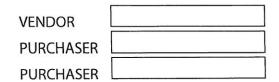



WORTH MORE"

Prices, figures, illustrations, sizes, features and finishes are subject to change without notice. Areas and dimensions are approximate and actual usable floor space may vary from the stated area. Layout may be reverse of the unit purchased. E. & O.E.





The Schumann 38' SERIES

Elevation A • 3,050 sq.ft. Elevation B • 3,050 sq.ft.

