

GOLDPARK

WORTH MORE™

CONSTRUCTION SUMMARY

Lot: 122

Model: 38-11 Elev B Schumann

Project/Phase: Brampton Encore / 2

CENTRAL VAC AND WIRING

Invoice	Qty.	Description
2273 32059 01May20	1	FAMILY ROOM: CONDUIT PIPE- FOR TELEVISION- LOCATE APPROX. 66" A.F.F. ABOVE FIREPLACE, TERMINATING AT CABLE LOCATION.

CERAMIC

Invoice	Qty.	Description
2273 33052 01May20 NoCat	1	ENSUITE 2: UPGRADE SHOWER IN LIEU OF TUB- INCLUDES FRAMED GLASS SHOWER ENCLOSURE WITH TILE BASE AND POTLIGHT IN SHOWER

CONCRETE AND DRAIN

Invoice	Qty.	Description
2273 32087 01May20 NoCat	1	BACK-FLOW PREVENTER VALVE

DRYWALL

Invoice	Qty.	Description
2273 32062 01May20	1	2ND FLOOR: SMOOTH CEILINGS - (2-Story Design) 2ND FLOOR

ryDiscipline.rpt 14Mar20

Page 1 of 7

GOLDPARK

WORTH MORE™

CONSTRUCTION SUMMARY

Lot: 122

Model: 38-11 Elev B Schumann

Project/Phase: Brampton Encore / 2

ELECTRICAL

Invoice	Qty.	Description
2273 32203 01May20 NoCat	1	FRONT ELEVATION: ADD 1 LED SOFFIT LIGHT, SEE ELEVATION FOR LOCATION. COMPLETE WITH SINGLE POLE SWITCH IN FOYER
2273 33048 01May20 NoCat	1	ENSUITE 2: UPGRADE SHOWER IN LIEU OF TUB- INCLUDES FRAMED GLASS SHOWER ENCLOSURE WITH TILE BASE AND POTLIGHT IN SHOWER

ELECTRICAL POTLIGHT

Invoice	Qty.	Description
2273 33051 01May20 NoCat	1	ENSUITE 2: UPGRADE SHOWER IN LIEU OF TUB- INCLUDES FRAMED GLASS SHOWER ENCLOSURE WITH TILE BASE AND POTLIGHT IN SHOWER

EXTERIOR COLOURS

Invoice	Qty.	Description
2273 33061 01May20 NoCat	1	EXTERIOR COLOUR PACKAGE # 8

FORMING

Invoice	Qty.	Description
2273 32081 01May20 **	3	BASEMENT WINDOWS - UPGRADE EXISTING BASEMENT WINDOW TO 30 INCH X 24 INCH - MAY REQUIRE INSTALLATION OF WINDOW WELL

ryDiscipline.rpt 14Mar20

Page 3 of 7

GOLDPARK

WORTH MORE™

CONSTRUCTION SUMMARY

Lot: 122

Model: 38-11 Elev B Schumann

Project/Phase: Brampton Encore / 2

FRAMING

Invoice	Qty.	Description
2273 32071 01May20 NoCat	1	***CUSTOM LAYOUT*** KITCHEN: ADD APPROX 30" TO KITCHEN/DINING WALL - MAKING ARCHWAY NARROWER SEE PLAN FOR LOCATION
2273 32074 01May20	1	FAMILY ROOM: OPTIONAL COFFERED CEILING - FAMILY ROOM (PER ROOM AS PER PLAN)
2273 32075 01May20	1	ENSUITE 2: UPGRADE SHOWER IN LIEU OF TUB- INCLUDES FRAMED GLASS SHOWER ENCLOSURE WITH TILE BASE AND POTLIGHT IN SHOWER
2273 32088 01May20 NoCat	1	***CUSTOM LAYOUT*** MASTER ENSUITE: RELOCATE DOOR, SEE PLAN FOR LOCATION
2273 33041 01May20 NoCat	1	2ND FLOOR: SMOOTH CEILINGS - (2-Story Design) 2ND FLOOR
2273 33058 01May20 NoCat	2	MAIN FLOOR: EXTENDED HEIGHT ARCHWAY -96"
2273 33059 01May20 NoCat	1	BREAKFAST: FRENCH DOORS IN LIEU OF PATIO SLIDERS - 6FT X 80 INCH FRENCH DOORS - NO SCREEN CLEAR GLASS
2300 32529 01May20 NoCat	1	***CUSTOM LAYOUT*** MASTER BEDROOM: RELOCATE DOUBLE DOORS APPROX. 4', CLOSER TO WIC DOOR - SEE PLAN FOR LOCATION

GLASS AND MIRROR

Invoice	Qty.	Description
2273 33050 01May20 NoCat	1	ENSUITE 2: UPGRADE SHOWER IN LIEU OF TUB- INCLUDES FRAMED GLASS SHOWER ENCLOSURE WITH TILE BASE AND POTLIGHT IN SHOWER

HVAC

Invoice	Qty.	Description
2273 32079 01May20	1	KITCHEN: GAS LINE ROUGH - GROUND FLOOR

ryDiscipline.rpt 14Mar20

Page 4 of 7

GOLDPARK

WORTH MORE™

CONSTRUCTION SUMMARY

Lot: 122

Model: 38-11 Elev B Schumann

Project/Phase: Brampton Encore / 2

INTERIOR TRIM AND DOORS

Invoice	Qty.	Description
2273 32084 01May20	2	MAIN FLOOR: EXTENDED HEIGHT ARCHWAY -96"
2273 33043 01May20 NoCat	1	***CUSTOM LAYOUT*** KITCHEN: ADD APPROX 30" TO KITCHEN/DINING WALL - MAKING ARCHWAY NARROWER SEE PLAN FOR LOCATION
2273 33046 01May20 NoCat	1	FAMILY ROOM: OPTIONAL COFFERED CEILING - FAMILY ROOM (PER ROOM AS PER PLAN)
2273 33049 01May20 NoCat	1	ENSUITE 2: UPGRADE SHOWER IN LIEU OF TUB- INCLUDES FRAMED GLASS SHOWER ENCLOSURE WITH TILE BASE AND POTLIGHT IN SHOWER
2273 33053 01May20 NoCat	1	***CUSTOM LAYOUT*** MASTER ENSUITE: RELOCATE DOOR, SEE PLAN FOR LOCATION
2273 33060 01May20 NoCat	1	BREAKFAST: FRENCH DOORS IN LIEU OF PATIO SLIDERS - 6FT X 80 INCH FRENCH DOORS - NO SCREEN CLEAR GLASS
2300 33056 01May20 NoCat	1	***CUSTOM LAYOUT*** MASTER BEDROOM: RELOCATE DOUBLE DOORS APPROX. 4', CLOSER TO WIC DOOR - SEE PLAN FOR LOCATION

MISC.

Invoice	Qty.	Description
2273 32089 01May20 NoCat	1	BONUS PACKAGE: \$10,000.00 (INCLUDING TAXES) WORTH OF UPGRADES FROM GOLD PARK HOMES DÉCOR CENTRE IS BEING APPLIED TOWARD THIS ORDER. PURCHASER HAS A REMAINING AMOUNT OF \$00 (INCLUDING TAXES).
2273 32389 01May20 NoCat	1	Purchaser has attended a phone appointment at the Decor Centre & has DECLINED any additional upgrades and accepts and acknowledges that there will be no further changes/additions/deletions to be made upon signing on April 16, 2020.

ryDiscipline.rpt 14Mar20

Page 5 of 7

PAINT

InvoiceQty. Description

2273 33042 01May20 NoCat	1	2ND FLOOR: SMOOTH CEILINGS - (2-Story Design) 2ND FLOOR
2273 33044 01May20 NoCat	1	***CUSTOM LAYOUT*** KITCHEN: ADD APPROX 30" TO KITCHEN/DINING WALL - MAKING ARCHWAY NARROWER SEE PLAN FOR LOCATION
2273 33045 01May20 NoCat	1	FAMILY ROOM: OPTIONAL COFFERED CEILING - FAMILY ROOM (PER ROOM AS PER PLAN)
2273 33055 01May20 NoCat	1	***CUSTOM LAYOUT*** MASTER ENSUITE: RELOCATE DOOR, SEE PLAN FOR LOCATION

PLUMBING

InvoiceQty. Description

2273 32082 01May20	1	KITCHEN: ROUGH-IN - WATERLINE FOR FRIDGE
2273 32083 01May20	2	GARAGE *AND* REAR YARD: HOSE BIB - STANDARD TO UPGRADED WITH HOT AND COLD WATER VALVE
2273 33040 01May20 NoCat	1	BACK-FLOW PREVENTER VALVE
2273 33047 01May20 NoCat	1	ENSUITE 2: UPGRADE SHOWER IN LIEU OF TUB- INCLUDES FRAMED GLASS SHOWER ENCLOSURE WITH TILE BASE AND POTLIGHT IN SHOWER

PLUMBING FIXTURES

InvoiceQty. Description

2273 32076 01May20 NoCat	1	MASTER ENSUITE: UPGRADE TUB TO WHIRLPOOL - MIROLIN HUDSON 6 #H7242AW
2273 32204 01May20 NoCat	1	MASTER ENSUITE: DELTA 'ARA' MONITOR 14 SERIES SHOWER SYSTEM #DF-KIT4-WS 'CHROME' (INCLUDES HAND SHOWER + SHOWER HEAD ON 16" FROM WALL)
2273 32388 01May20 NoCat	1	ENSUITE 2: UPGRADE SHOWER TO INCLUDE DELTA 'DRYDEN' HAND SHOWER #50570/57051/T11851/R11000 (CHROME)

The Schumann

38' SERIES

Elevation A • 3,050 sq.ft.
Elevation B • 3,050 sq.ft.

BEZ-122. ~~see attach~~
April 16 2020

BEZ-122 ~~see attached~~
April 20 2020

*HOT/COLD H2O BB

COFFERED
CEILING

FRENCH
DOORS.

SMOOTH CEILING.

66"
ATT

GAS+ELECT

BUILT-IN OVENS.
FRIDGE WATER LINE

YES!

GROUND FLOOR
ELEVATION A

HOT/COLD H2O BB

PART. GROUND FLOOR
ELEVATION B

VENDOR
PURCHASER
PURCHASER

GOLDPARK
WORTH MORE™

Prices, figures, illustrations, sizes, features and finishes are subject to change without notice. Areas and dimensions are approximate and actual usable floor space may vary from the stated area. Layout may be reverse of the unit purchased. E. & O.E.

The Schumann


38' SERIES

Elevation A • 3,050 sq.ft.

→ Elevation B • 3,050 sq.ft.

BE2-122 see attached
April 16 2020

BEZ 122
APRIL 20 2020 see attached

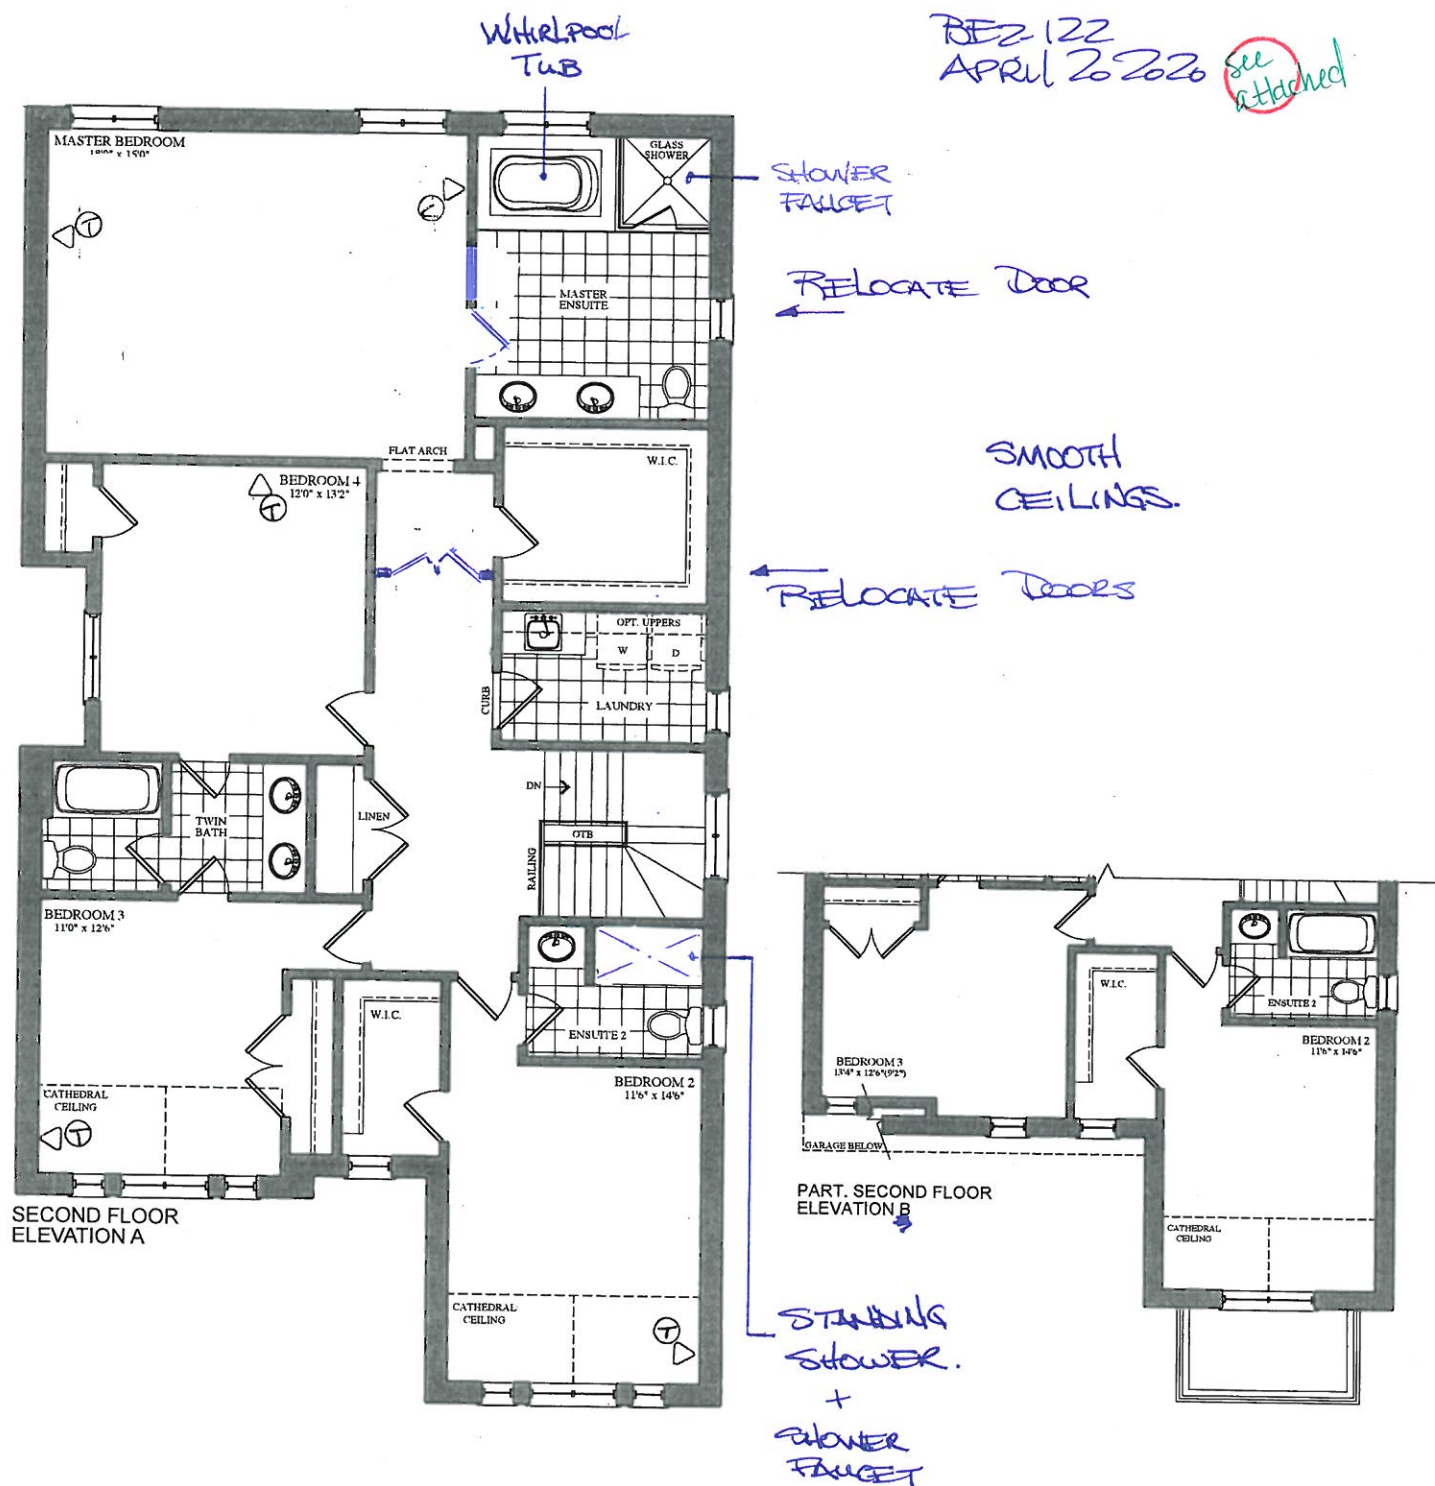

VENDOR

--

PURCHASER

--

PURCHASER

--

GOLDPARK
WORTH MORE™


Prices, figures, illustrations, sizes, features and finishes are subject to change without notice. Areas and dimensions are approximate and actual usable floor space may vary from the stated area. Layout may be reverse of the unit purchased. E. & O.E.

The
Schumann
38' SERIES

Elevation A • 3,050 sq.ft.
→ Elevation B • 3,050 sq.ft.

BE2-122 *see attached*
April 16 2020


BE2-122 *see attached*
April 20 2020

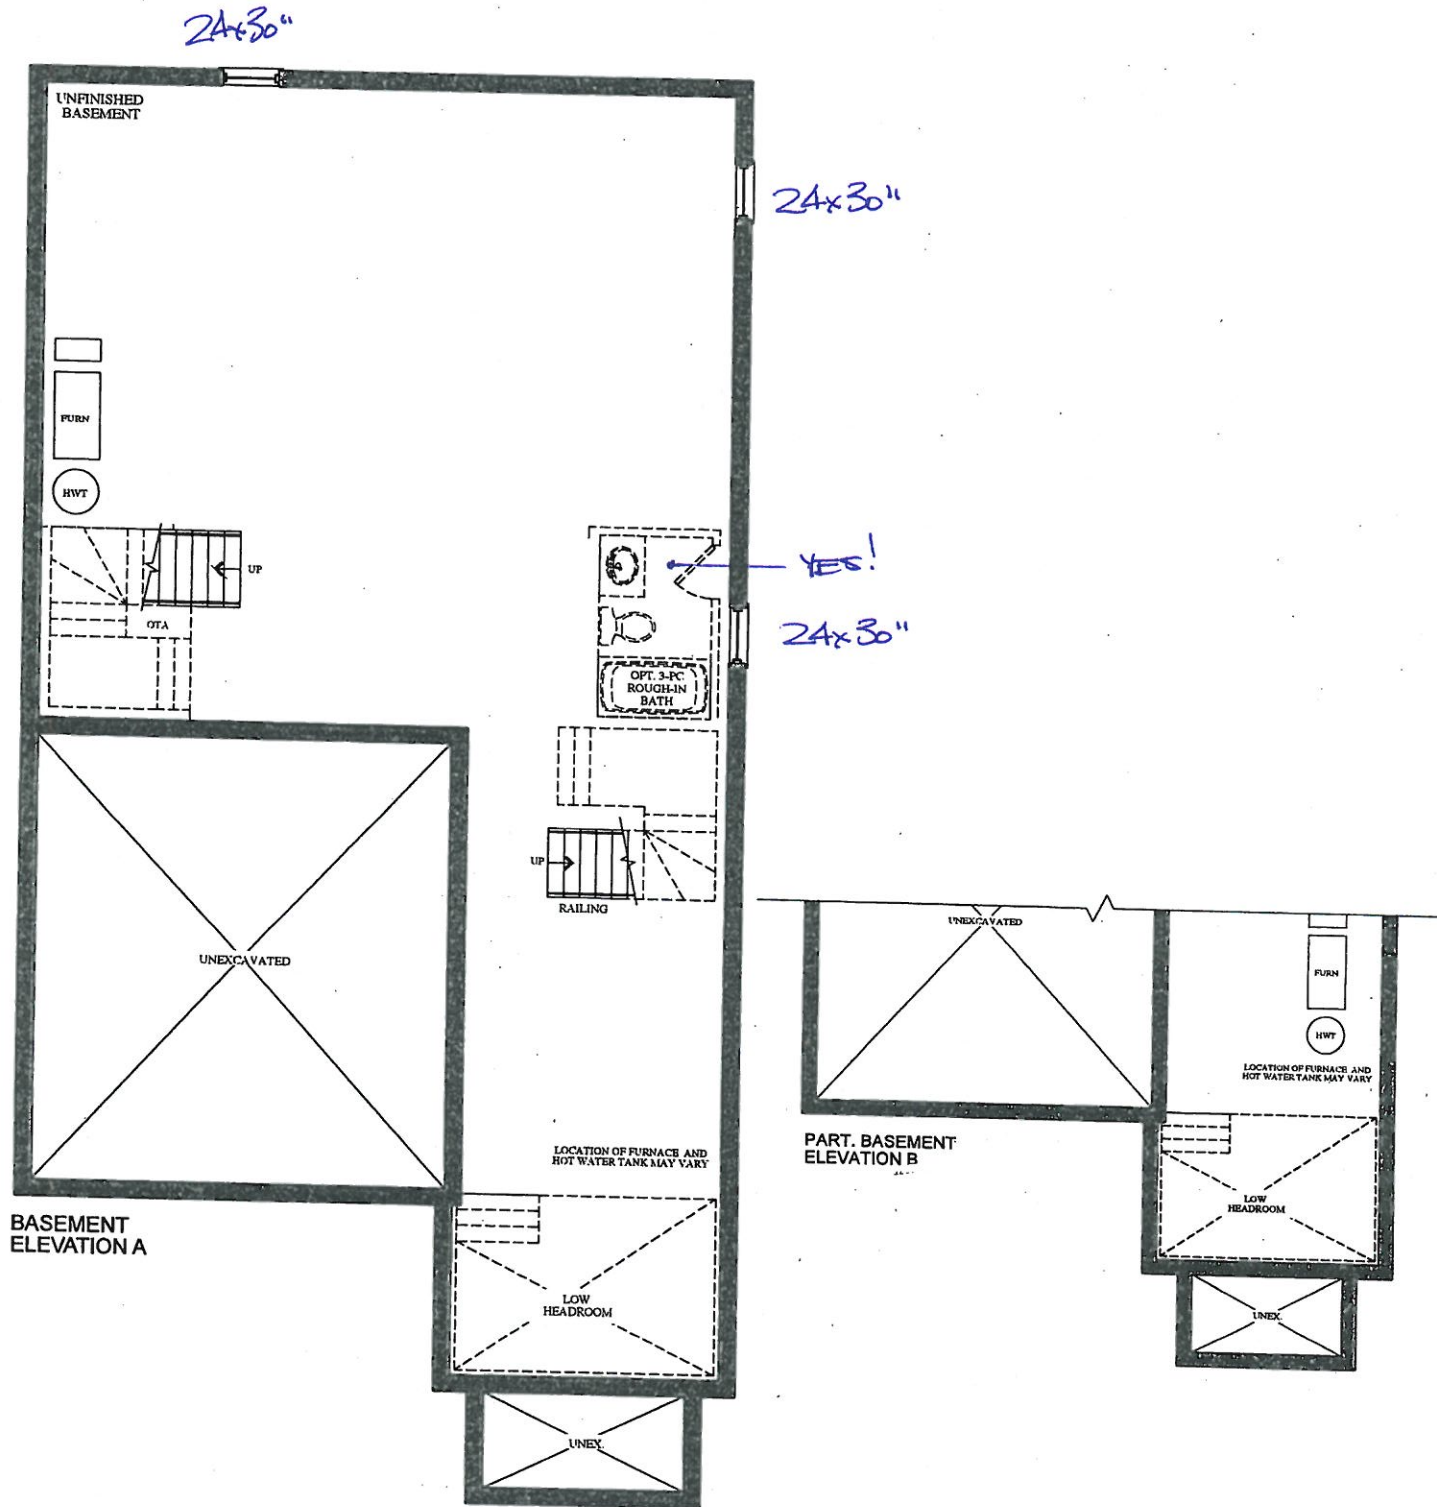

VENDOR	
PURCHASER	
PURCHASER	

GOLDPARK
WORTH MORE™



Prices, figures, illustrations, sizes, features and finishes are subject to change without notice. Areas and dimensions are approximate and actual usable floor space may vary from the stated area. Layout may be reverse of the unit purchased. E. & O.E.

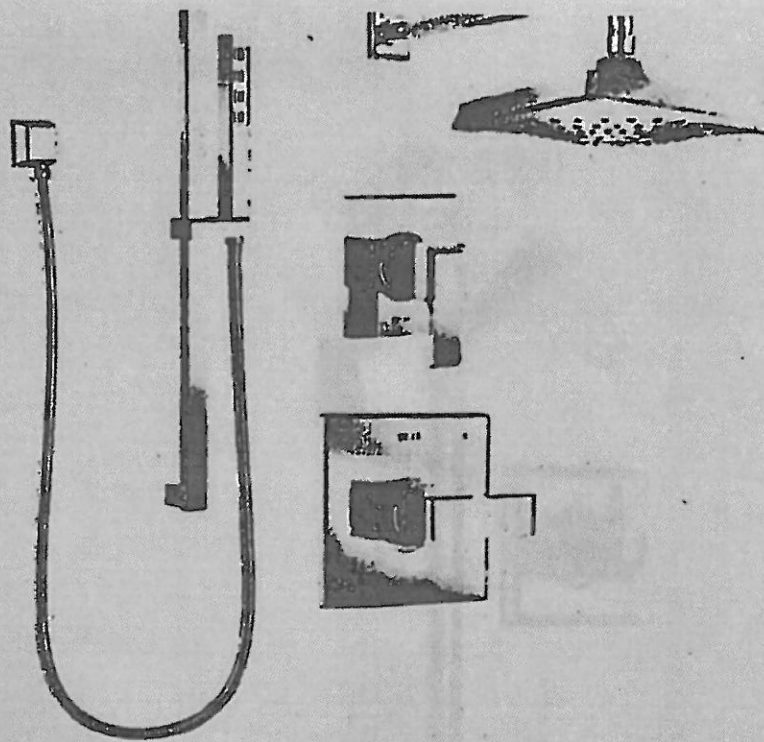


Ara Monitor 14 Series Shower Kit
DF-KIT4-WS - Chrome

Includes:

- # T14067 Valve Only Trim
- # R10000-UNWS MultiChoice Universal Valve w/Stops
- # T11867 Diverter Trim
- # R11000 Diverter Rough
- # 52684 Shower Head
- # RP46870 Shower Arm
- # RP52144 Shower Arm Flange
- # 51567 Wallbar Hand Shower
- # 50570 Wall Elbow

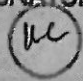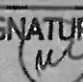LOT # 122.	
ROOM: MASTER ENSUITE	SIGNATURE: 
DATE: APRIL 8 2020	SIGNATURE: 

DRYDEN

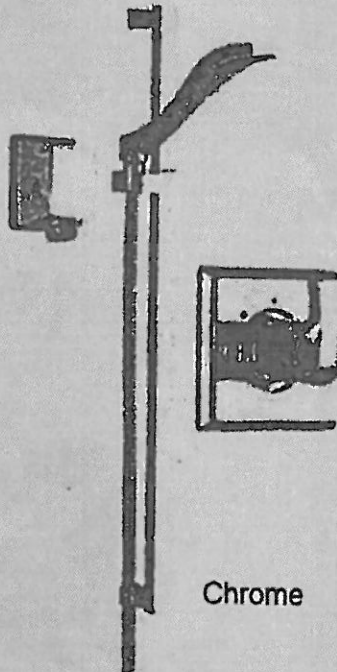

Chrome

Handshower Components


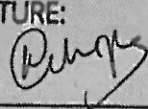
Chrome:

Wall Elbow - # 50570


Slide Bar Hand Shower - # 57051

3-Setting 2-Port Diverter Trim - # T11851

Rough-In - # R11000

LOT # 122.	
ROOM: ENSUITE 2	SIGNATURE: 
DATE: APRIL 16 2020	SIGNATURE: 

Hudson 6

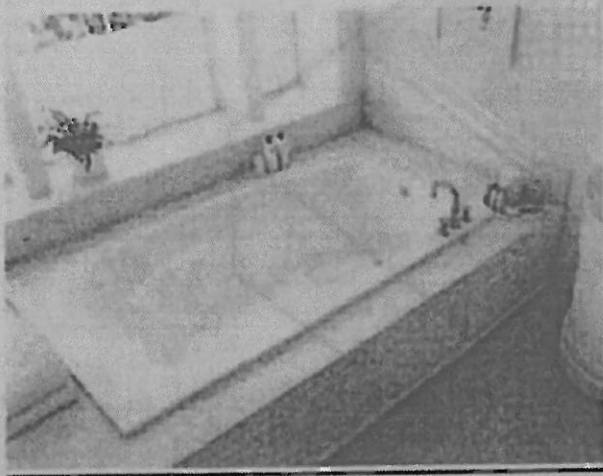

MASTER
ENSUITE

60" x 42" x 20"

Whirlpool
6 side jets, 2 foot jets

H7242AW


Features & Benefit

Accepts deck mounted faucet
Sloped lumbar support
Spacious bathing well
Convenient dual armrests
Above floor rough-in
Patterned bottom

BEZ-122. *ML*
APRIL 16, 2020 *8:00*

BB-122. (7)
April 16 2020

SOFFIT
LIGHT
LOCATION

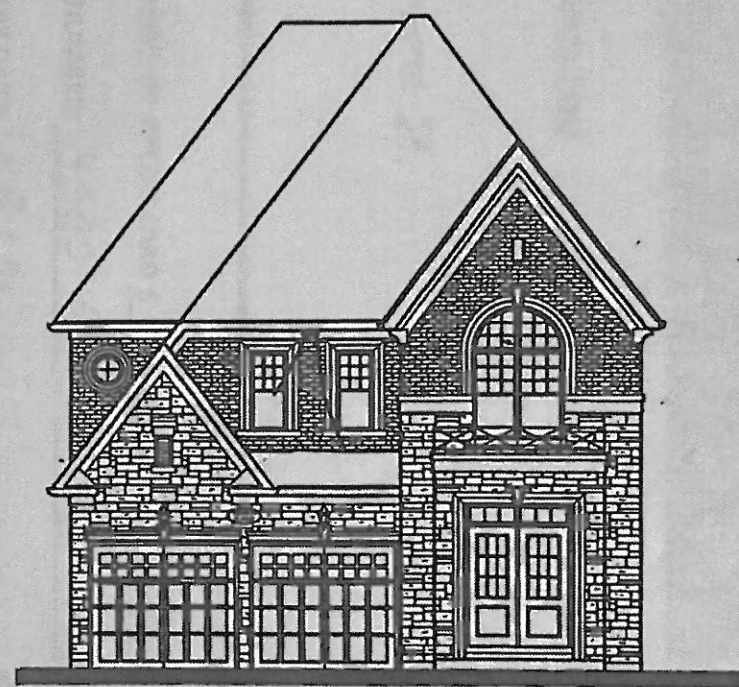

FRONT ELEVATION 'B'

encore
BRAMPTON


SCHEDULE 'F'

BEZ-122. (K-L)
APRIL 16 2020

The Schumann 38' SERIES

Elevation A • 3,050 sq.ft.
→ Elevation B • 3,050 sq.ft.

*HOT/COLD H2O B.B.

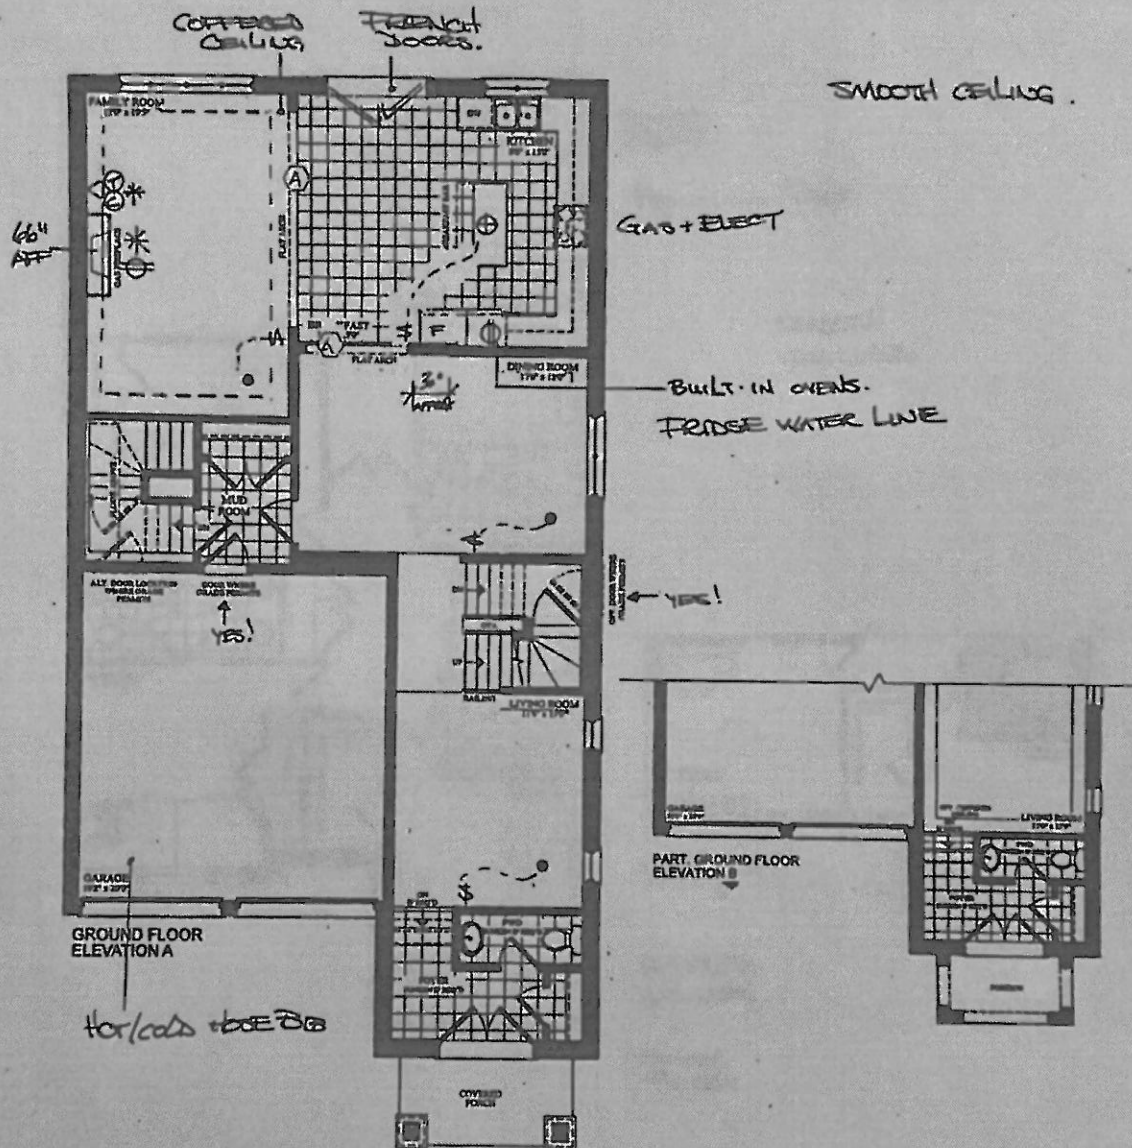

VENDOR
PURCHASER
PURCHASER

GOLDPARK
WORTH MORE™

Prices, figures, illustrations, sizes, features and finishes are subject to change without notice. Areas and dimensions are approximate and actual usable floor space may vary from the stated area. Layout may be reverse of the unit purchased. E. & O.E.


encore
BRAMPTON

SCHEDULE 'F'

REZ-122 (KC)
April 16 2020

The Schumann 38' SERIES

Elevation A • 3,050 sq.ft.
→ Elevation B • 3,050 sq.ft.

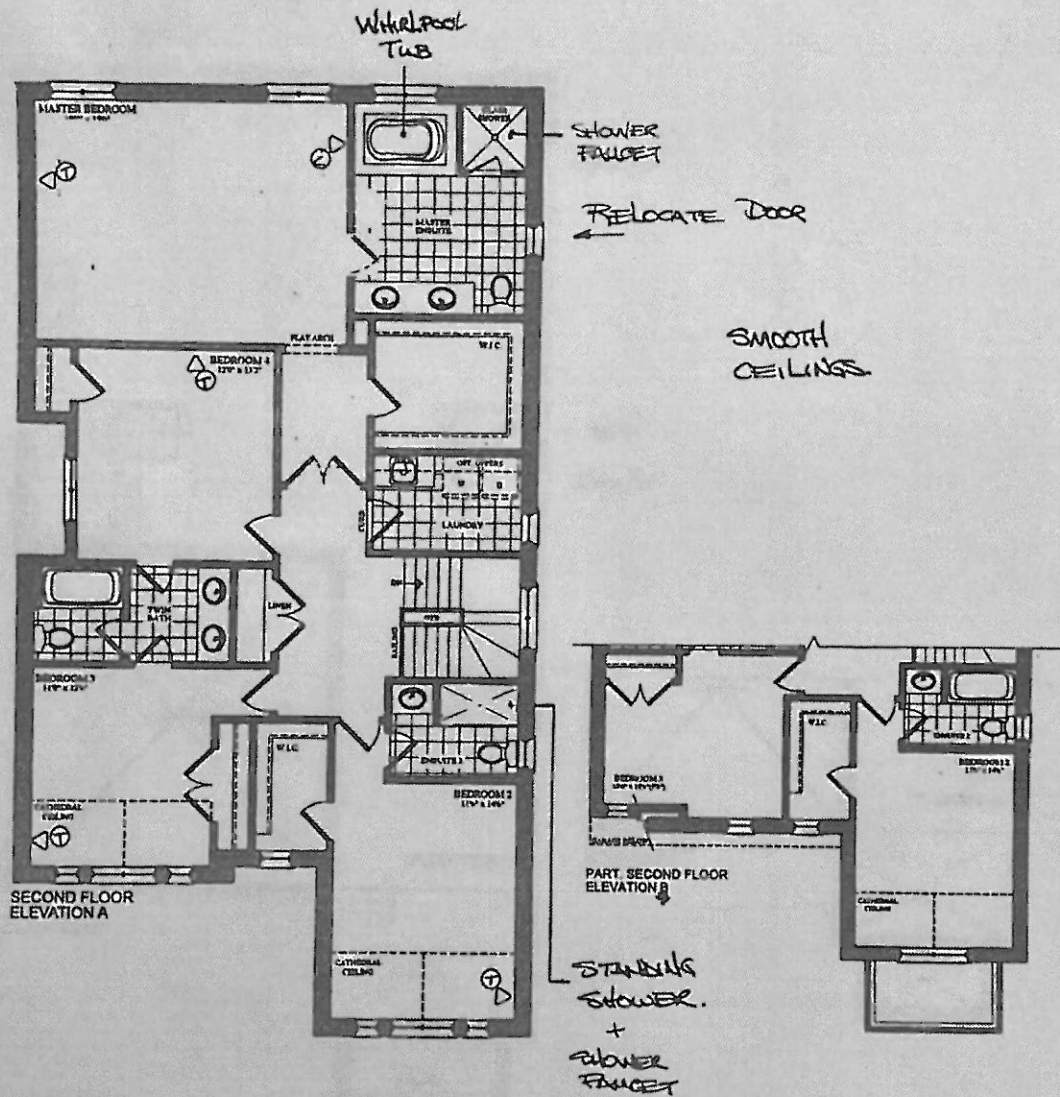

VENDOR _____
PURCHASER _____
PURCHASER _____

GOLDPARK
WORTH MORE™

Prices, figures, illustrations, sizes, features and finishes are subject to change without notice. Areas and dimensions are approximate and actual usable floor space may vary from the stated area. Layout may be reverse of the unit purchased. E. & O.E.

