



CONSTRUCTION SUMMARY

Lot: 141
Model: 40.03 A BROOKSIDE
Project/Phase: Pine Valley Forevergreen / 1

CONCRETE AND DRAIN

Invoice	Qty.	Description
2271 32033 09Apr20 NoCat	1	BACK-FLOW PREVENTER VALVE CONCRETE AND DRAIN

WINDOWS - BASEMENT

Invoice	Qty.	Description
2271 32032 09Apr20	1	BASEMENT WINDOWS - UPGRADE BASEMENT WINDOW SIZE TO 30 " X 24" - 8" FRAME WINDOWS - BASEMENT72,351WINDOWS - BASEMENT
2271 32032 09Apr20	1	BASEMENT WINDOWS - UPGRADE BASEMENT WINDOW SIZE TO 30 " X 24" - 8" FRAME WINDOWS - BASEMENT72,351WINDOWS - BASEMENT
2322 32948 04May20	2	BASEMENT WINDOWS - UPGRADE BASEMENT WINDOW SIZE TO 40 " X 24" - 8" FRAME WINDOWS - BASEMENT72,353WINDOWS - BASEMENT REAR WINDOWS

This Document is Extremely Time Sensitive - Printed 4 May 20 at 8:47

-----	--	--


SCHEDULE 'F'

~~*REVISED*~~
April 29 2022
EC
TC

PINE VALLEY
COMMUNITIES

TV-1A1 EC TC
April 3 2022

The
Brookside
40' SERIES
→ Elevation A - 3,380 sq.ft.
Elevation B - 3,350 sq.ft.

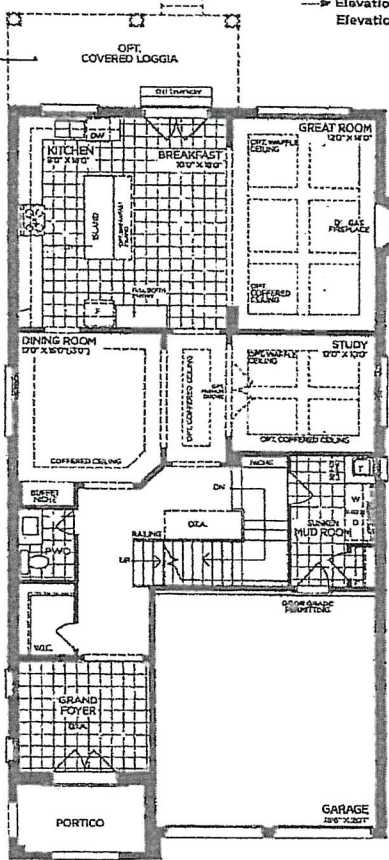

GROUND FLOOR | ELEV. A
3

VENDOR

PURCHASER

PURCHASER

GOLDPARK
WORTH MORE


Prices, figures, illustrations, sizes, features and finishes are subject to change without notice. Areas and dimensions are approximate and actual usable floor space may vary from the stated area. Layout may be subject to the unit purchase, E & G, 4000.

SCHEDULE 'F'



TV-141 ^{EC} _{EC}
APRIL 3 2022
REMOVED APRIL 29 2022
Elevation A • 3,380 sq.ft.
Elevation B • 3,350 sq.ft.

The Brookside
40' SERIES

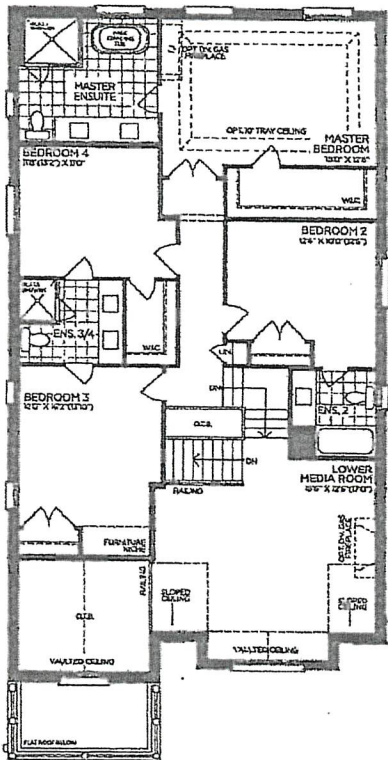

SECOND FLOOR | ELEV. A

VENDOR
PURCHASER
PURCHASER

GOLDPARK
WORTH MORE


Prices, figures, illustrations, sizes, features and finishes are subject to change without notice. Areas and dimensions are approximate and actual usable floor space may vary from the stated area. Layout may be reverse of the unit purchased. E.A.O.E. #003

SCHEDULE 'F'



The Brookside
40' SERIES

Elevation A - 3,380 sq.ft.
Elevation B - 3,350 sq.ft.

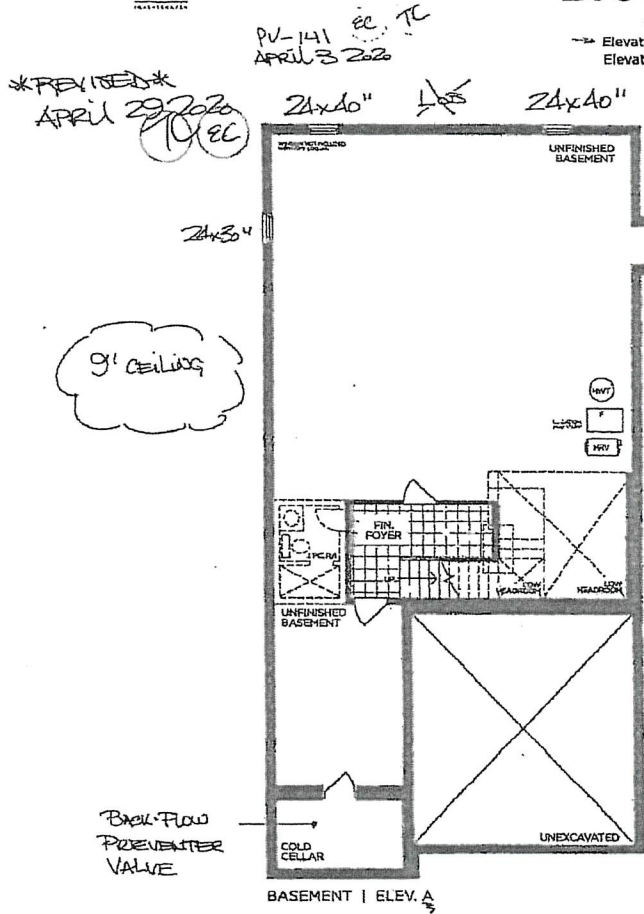

VENDOR

PURCHASER

PURCHASER

GOLDPARK
NORTH MOIST

Prices, features, illustrations, sizes, features and finishes are subject to change without notice. Areas and dimensions are approximate and actual usable floor space may vary from the stated area. Layout may be reverse of the unit purchased. E. & O.E. 4/2023