



CONSTRUCTION SUMMARY

Lot: 118  
Model: 40.02 A VALLEYVIEW  
Project/Phase: Pine Valley Forevergreen / 1

CONCRETE AND DRAIN

| Invoice                               | Qty. | Description                                         |
|---------------------------------------|------|-----------------------------------------------------|
| 2258<br>31986<br><br>31Mar20<br>NoCat | 1    | BACK-FLOW PREVENTER VALVE<br><br>CONCRETE AND DRAIN |

DRYWALL

| Invoice                            | Qty. | Description                                                                                                                      |
|------------------------------------|------|----------------------------------------------------------------------------------------------------------------------------------|
|                                    |      |                                                                                                                                  |
| 2307<br>32803<br><br>04May20<br>** | 1    | GREAT ROOM - OPT. COFFERED CEILING - AS PER PLAN<br><br>MODEL OPTIONS 40.0272,385DRYWALL                                         |
| 2307<br>32804<br><br>04May20<br>** | 1    | GREAT ROOM - OPT. WAFFLE CEILING, BEAM DETAIL AS PER PLAN (6 BOXES) OPTION # 1 - CTR-B07<br><br>MODEL OPTIONS 40.0272,387DRYWALL |
| 2307<br>32806<br><br>04May20<br>** | 1    | MASTER BEDROOM - OPT. 10 FOOT TRAY CEILING AS PER PLAN<br><br>MODEL OPTIONS 40.02.A72,388DRYWALL                                 |

ELECTRICAL

| Invoice                            | Qty. | Description                                                                                                                         |
|------------------------------------|------|-------------------------------------------------------------------------------------------------------------------------------------|
| 2258<br>31959<br><br>31Mar20<br>** | 2    | BASEMENT WINDOWS - UPGRADE BASEMENT WINDOW SIZE TO 30 " X 24" - 8" FRAME<br><br>WINDOWS - BASEMENT72,351ELECTRICAL                  |
| 2307<br>32803<br><br>04May20<br>** | 1    | GREAT ROOM - OPT. COFFERED CEILING - AS PER PLAN<br><br>MODEL OPTIONS 40.0272,385ELECTRICAL                                         |
| 2307<br>32804<br><br>04May20<br>** | 1    | GREAT ROOM - OPT. WAFFLE CEILING, BEAM DETAIL AS PER PLAN (6 BOXES) OPTION # 1 - CTR-B07<br><br>MODEL OPTIONS 40.0272,387ELECTRICAL |
| 2307<br>32806<br><br>04May20<br>** | 1    | MASTER BEDROOM - OPT. 10 FOOT TRAY CEILING AS PER PLAN<br><br>MODEL OPTIONS 40.02.A72,388ELECTRICAL                                 |



CONSTRUCTION SUMMARY

Lot: 118  
Model: 40.02 A VALLEYVIEW  
Project/Phase: Pine Valley Forevergreen / 1

ELECTRICAL

| Invoice                      | Qty. | Description                                                                                                                                                                                                                                                       |
|------------------------------|------|-------------------------------------------------------------------------------------------------------------------------------------------------------------------------------------------------------------------------------------------------------------------|
| 2307<br>32795<br><br>04May20 | 1    | KITCHEN: 110V WALL RECEPTACLE ON SEPARATE CIRCUIT - GAS FIRED COOKTOP - FOR AUX. EQUIPMENT - NOT A STOVE PLUG<br><br>ELECTRICAL APPLIANCES72,273                                                                                                                  |
| 2307<br>32796<br><br>04May20 | 1    | KITCHEN: ADDITIONAL 220V RECEPTACLE ON A SEPARATE CIRCUIT - FOR BUILT-IN WALL OVEN - APPLIANCE NOT INCLUDED - DOES NOT INCLUDE BREAKER THAT IS TO BE INSTALLED BY LICENSED ELECTRICIAN AND ARRANGED BY HOMEOWNER AFTER CLOSING<br><br>ELECTRICAL APPLIANCES72,282 |

ELECTRICAL

| Invoice                      | Qty. | Description                                                                                                                                                                                            |
|------------------------------|------|--------------------------------------------------------------------------------------------------------------------------------------------------------------------------------------------------------|
| 2307<br>32792<br><br>04May20 | 1    | GREAT ROOM: INTERIOR WALL OUTLET: ADDITIONAL 110V WALL INTERIOR RECEPTACLE ON EXISTING CIRCUIT FOR WALL MOUNTED TV - LOCATE APPROX. 60" A.F.F. ABOVE LINEAR FIREPLACE<br><br>ELECTRICAL INTERIOR72,281 |
| 2307<br>32797<br><br>04May20 | 1    | KITCHEN: FIXTURE: UNDER CABINET FLUORESCENT LIGHT FIXTURES - DOES NOT INCLUDE (AND REQUIRES) LIGHT VALANCE<br><br>ELECTRICAL INTERIOR72,303                                                            |
| 2307<br>32801<br><br>04May20 | 1    | KITCHEN: FXITURE: RELOCATE STANDARD CEILING MOUNT FIXTURE LOCATE APPROX CENTER ABOVE ISLAND<br><br>ELECTRICAL INTERIOR72,307                                                                           |



CONSTRUCTION SUMMARY

Lot: 118  
Model: 40.02 A VALLEYVIEW  
Project/Phase: Pine Valley Forevergreen / 1

ELECTRICAL

| Invoice                      | Qty. | Description                                                                                                                                             |
|------------------------------|------|---------------------------------------------------------------------------------------------------------------------------------------------------------|
| 2307<br>32798<br><br>04May20 | 6    | KITCHEN: 4" E/S LED INTERIOR POT LIGHT - GROUND FLOOR - EACH INCLUDES 1 SWITCH<br><br>ELECTRICAL POTLIGHT<br>INCLUDED IN APS<br><br>72,289              |
| 2307<br>32799<br><br>04May20 | 1    | MAIN HALL: UPGRADE STANDARD CEILING MOUNT FIXTURE TO (1) LED POT LIGHT - GROUND FLOOR - SEE PLAN FOR LOCATION<br><br>ELECTRICAL POTLIGHT<br><br>72,309  |
| 2307<br>32800<br><br>04May20 | 5    | MAIN HALL: 4" E/S LED INTERIOR POT LIGHT - GROUND FLOOR - EACH<br><br>ELECTRICAL POTLIGHT<br>USE SAME SWITCH AS STANDARD<br><br>72,289                  |
| 2307<br>32812<br><br>04May20 | 1    | GREAT ROOM: UPGRADE STANDARD CEILING MOUNT FIXTURE TO (1) LED POT LIGHT - GROUND FLOOR - SEE PLAN FOR LOCATION<br><br>ELECTRICAL POTLIGHT<br><br>72,309 |
| 2307<br>32813<br><br>04May20 | 5    | GREAT ROOM: 4" E/S LED INTERIOR POT LIGHT - GROUND FLOOR - EACH<br><br>ELECTRICAL POTLIGHT<br>SAME SWITCH AS STANDARD<br><br>72,289                     |

ELECTRICAL

| Invoice                      | Qty. | Description                                                                                                                                                                                    |
|------------------------------|------|------------------------------------------------------------------------------------------------------------------------------------------------------------------------------------------------|
| 2307<br>32802<br><br>04May20 | 2    | KITCHEN: ROUGH-IN FOR CAPPED CEILING OUTLET ( FUTURE LIGHT FIXTURE) - EACH - LOCATE APPROX CENTERED ABOVE ISLAND<br><br>ELECTRICAL ROUGH-IN<br>USE SAME SWITCH AS STANDARD LIGHT<br><br>72,667 |

FIREPLACE - GAS

| Invoice                      | Qty. | Description                                                                                                                                                                                                  |
|------------------------------|------|--------------------------------------------------------------------------------------------------------------------------------------------------------------------------------------------------------------|
| 2307<br>32809<br><br>04May20 | 1    | GREAT ROOM: UPGRADE MAIN FLOOR LINEAR 1 SIDED FIREPLACE - JADE SERIES 42" LINEAR DIRECT VENT GAS FIREPLACE IN LIEU OF STANDARD<br>INSTALL *VIEWING AREA* APPROX. 12" A.F.F.<br>FIREPLACE - GAS<br><br>72,620 |

FORM - FORMING

| Invoice                            | Qty. | Description                                                                                                                            |
|------------------------------------|------|----------------------------------------------------------------------------------------------------------------------------------------|
| 2258<br>31959<br><br>31Mar20<br>** | 2    | BASEMENT WINDOWS - UPGRADE BASEMENT WINDOW SIZE TO 30 " X 24" - 8" FRAME<br><br>WINDOWS - BASEMENT<br><br>72,351<br><br>FORM - FORMING |



CONSTRUCTION SUMMARY

Lot: 118  
Model: 40.02 A VALLEYVIEW  
Project/Phase: Pine Valley Forevergreen / 1

HVAC

| Invoice                      | Qty. | Description                                                                                  |
|------------------------------|------|----------------------------------------------------------------------------------------------|
| 2307<br>32794<br><br>04May20 | 1    | KTICHEN: GAS LINE ROUGH-IN - MAIN FLOOR FOR COOKTOP -SEE PLAN FOR LOCATION<br><br>HVAC72,224 |

INTERIOR DOORS

| Invoice                      | Qty. | Description                                                                                            |
|------------------------------|------|--------------------------------------------------------------------------------------------------------|
| 2307<br>32811<br><br>04May20 | 18   | THRU OUT 2ND FLOOR: INCREASE HEIGHT OF DOOR TO 8FT SECOND FLOOR - PER DOOR<br><br>INTERIOR DOORS72,644 |

INTERIOR TRIM /MOULDINGS

| Invoice                            | Qty. | Description                                                                                                                                       |
|------------------------------------|------|---------------------------------------------------------------------------------------------------------------------------------------------------|
|                                    | 1    |                                                                                                                                                   |
| 2307<br>32803<br><br>04May20<br>** | 1    | GREAT ROOM - OPT. COFFERED CEILING - AS PER PLAN<br><br>MODEL OPTIONS 40.0272,385INTERIOR TRIM /MOULDINGS                                         |
| 2307<br>32804<br><br>04May20<br>** | 1    | GREAT ROOM - OPT. WAFFLE CEILING, BEAM DETAIL AS PER PLAN (6 BOXES) OPTION # 1 - CTR-B07<br><br>MODEL OPTIONS 40.0272,387INTERIOR TRIM /MOULDINGS |
| 2307<br>32806<br><br>04May20<br>** | 1    | MASTER BEDROOM - OPT. 10 FOOT TRAY CEILING AS PER PLAN<br><br>MODEL OPTIONS 40.02.A72,388INTERIOR TRIM /MOULDINGS                                 |

LUM - LUMBER

| Invoice                            | Qty. | Description                                                                                           |
|------------------------------------|------|-------------------------------------------------------------------------------------------------------|
| 2307<br>32806<br><br>04May20<br>** | 1    | MASTER BEDROOM - OPT. 10 FOOT TRAY CEILING AS PER PLAN<br><br>MODEL OPTIONS 40.02.A72,388LUM - LUMBER |





CONSTRUCTION SUMMARY

Lot: 118  
Model: 40.02 A VALLEYVIEW  
Project/Phase: Pine Valley Forevergreen / 1

| Invoice | Qty. | Description |
|---------|------|-------------|
|         | 1    |             |

NETWORK AND WIRING

| Invoice                      | Qty. | Description                                                                                                                                                    |
|------------------------------|------|----------------------------------------------------------------------------------------------------------------------------------------------------------------|
| 2307<br>32791<br><br>04May20 | 1    | GREAT ROOM: CONDUIT PIPE - FOR WALL MOUNT TV - LOCATE APPROX. 60" A.F.F. ABOVE LINEAR FIREPLACE, TERMINATING AT CABLE LOCATION<br><br>NETWORK AND WIRING72,259 |

PAINTING

| Invoice                            | Qty. | Description                                                                                                                       |
|------------------------------------|------|-----------------------------------------------------------------------------------------------------------------------------------|
| 2258<br>31959<br><br>31Mar20<br>** | 2    | BASEMENT WINDOWS - UPGRADE BASEMENT WINDOW SIZE TO 30 " X 24" - 8" FRAME<br><br>WINDOWS - BASEMENT72,351PAINTING                  |
| 2307<br>32803<br><br>04May20<br>** | 1    | GREAT ROOM - OPT. COFFERED CEILING - AS PER PLAN<br><br>MODEL OPTIONS 40.0272,385PAINTING                                         |
| 2307<br>32804<br><br>04May20<br>** | 1    | GREAT ROOM - OPT. WAFFLE CEILING, BEAM DETAIL AS PER PLAN (6 BOXES) OPTION # 1 - CTR-B07<br><br>MODEL OPTIONS 40.0272,387PAINTING |
| 2307<br>32806<br><br>04May20<br>** | 1    | MASTER BEDROOM - OPT. 10 FOOT TRAY CEILING AS PER PLAN<br><br>MODEL OPTIONS 40.02.A72,388PAINTING                                 |



CONSTRUCTION SUMMARY

Lot: 118  
Model: 40.02 A VALLEYVIEW  
Project/Phase: Pine Valley Forevergreen / 1

FRAMING

| Invoice                            | Qty. | Description                                                                                                                             |
|------------------------------------|------|-----------------------------------------------------------------------------------------------------------------------------------------|
| 2258<br>31959<br><br>31Mar20<br>** | 2    | BASEMENT WINDOWS - UPGRADE BASEMENT WINDOW SIZE TO 30 " X 24" - 8" FRAME<br><br>WINDOWS - BASEMENT72,351PANL - FRAMING                  |
| 2307<br>32803<br><br>04May20<br>** | 1    | GREAT ROOM - OPT. COFFERED CEILING - AS PER PLAN<br><br>MODEL OPTIONS 40.0272,385PANL - FRAMING                                         |
| 2307<br>32804<br><br>04May20<br>** | 1    | GREAT ROOM - OPT. WAFFLE CEILING, BEAM DETAIL AS PER PLAN (6 BOXES) OPTION # 1 - CTR-B07<br><br>MODEL OPTIONS 40.0272,387PANL - FRAMING |
| 2307<br>32806<br><br>04May20<br>** | 1    | MASTER BEDROOM - OPT. 10 FOOT TRAY CEILING AS PER PLAN<br><br>MODEL OPTIONS 40.02.A72,388PANL - FRAMING                                 |

PLUMBING FIXTURES

| Invoice                               | Qty. | Description                                                                                                                                                                                            |
|---------------------------------------|------|--------------------------------------------------------------------------------------------------------------------------------------------------------------------------------------------------------|
| 2307<br>32810<br><br>04May20<br>NoCat | 1    | MASTER ENSUITE: UPGRADE SHOWER FAUCET TO MOEN 'ARRIS' 3-FUNCTION RAIN SHOWER (from ceiling) WITH HAND SHOWER AND SLIDE BAR - CHROME #TS22002EP/3372/TS23005/62320/3887EP/A725<br><br>PLUMBING FIXTURES |

ROUGH CARPENTRY

| Invoice                            | Qty. | Description                                                                                                                              |
|------------------------------------|------|------------------------------------------------------------------------------------------------------------------------------------------|
| 2258<br>31959<br><br>31Mar20<br>** | 2    | BASEMENT WINDOWS - UPGRADE BASEMENT WINDOW SIZE TO 30 " X 24" - 8" FRAME<br><br>WINDOWS - BASEMENT72,351ROUGH CARPENTRY                  |
| 2307<br>32803<br><br>04May20<br>** | 1    | GREAT ROOM - OPT. COFFERED CEILING - AS PER PLAN<br><br>MODEL OPTIONS 40.0272,385ROUGH CARPENTRY                                         |
| 2307<br>32804<br><br>04May20<br>** | 1    | GREAT ROOM - OPT. WAFFLE CEILING, BEAM DETAIL AS PER PLAN (6 BOXES) OPTION # 1 - CTR-B07<br><br>MODEL OPTIONS 40.0272,387ROUGH CARPENTRY |
| 2307<br>32806<br><br>04May20<br>** | 1    | MASTER BEDROOM - OPT. 10 FOOT TRAY CEILING AS PER PLAN<br><br>MODEL OPTIONS 40.02.A72,388ROUGH CARPENTRY                                 |



CONSTRUCTION SUMMARY

Lot: 118  
Model: 40.02 A VALLEYVIEW  
Project/Phase: Pine Valley Forevergreen / 1

WINDOWS - BASEMENT

| Invoice                      | Qty. | Description                                                                                                                |
|------------------------------|------|----------------------------------------------------------------------------------------------------------------------------|
| 2258<br>31959<br><br>31Mar20 | 2    | BASEMENT WINDOWS - UPGRADE BASEMENT WINDOW SIZE TO 30 " X 24" - 8" FRAME<br><br>WINDOWS - BASEMENT72,351WINDOWS - BASEMENT |
| 2258<br>31959<br><br>31Mar20 | 2    | BASEMENT WINDOWS - UPGRADE BASEMENT WINDOW SIZE TO 30 " X 24" - 8" FRAME<br><br>WINDOWS - BASEMENT72,351WINDOWS - BASEMENT |

WINDOWS AND DOORS

| Invoice                               | Qty. | Description                                               |
|---------------------------------------|------|-----------------------------------------------------------|
| 2307<br>32808<br><br>04May20<br>NoCat | 1    | THRU OUT: BLACK INTERIOR WINDOWS<br><br>WINDOWS AND DOORS |

This Document is Extremely Time Sensitive - Printed 4 May 20 at 9:04

SCHEDULE 'F'




TV-118  
MAR 30 2020  
~~\*REVISED\*~~ APRIL 27 2020

The  
Valleyview  
40' SERIES

→ Elevation A • 3,145 sq.ft.  
Elevation B • 3,170 sq.ft.

Black windows  
Thru out

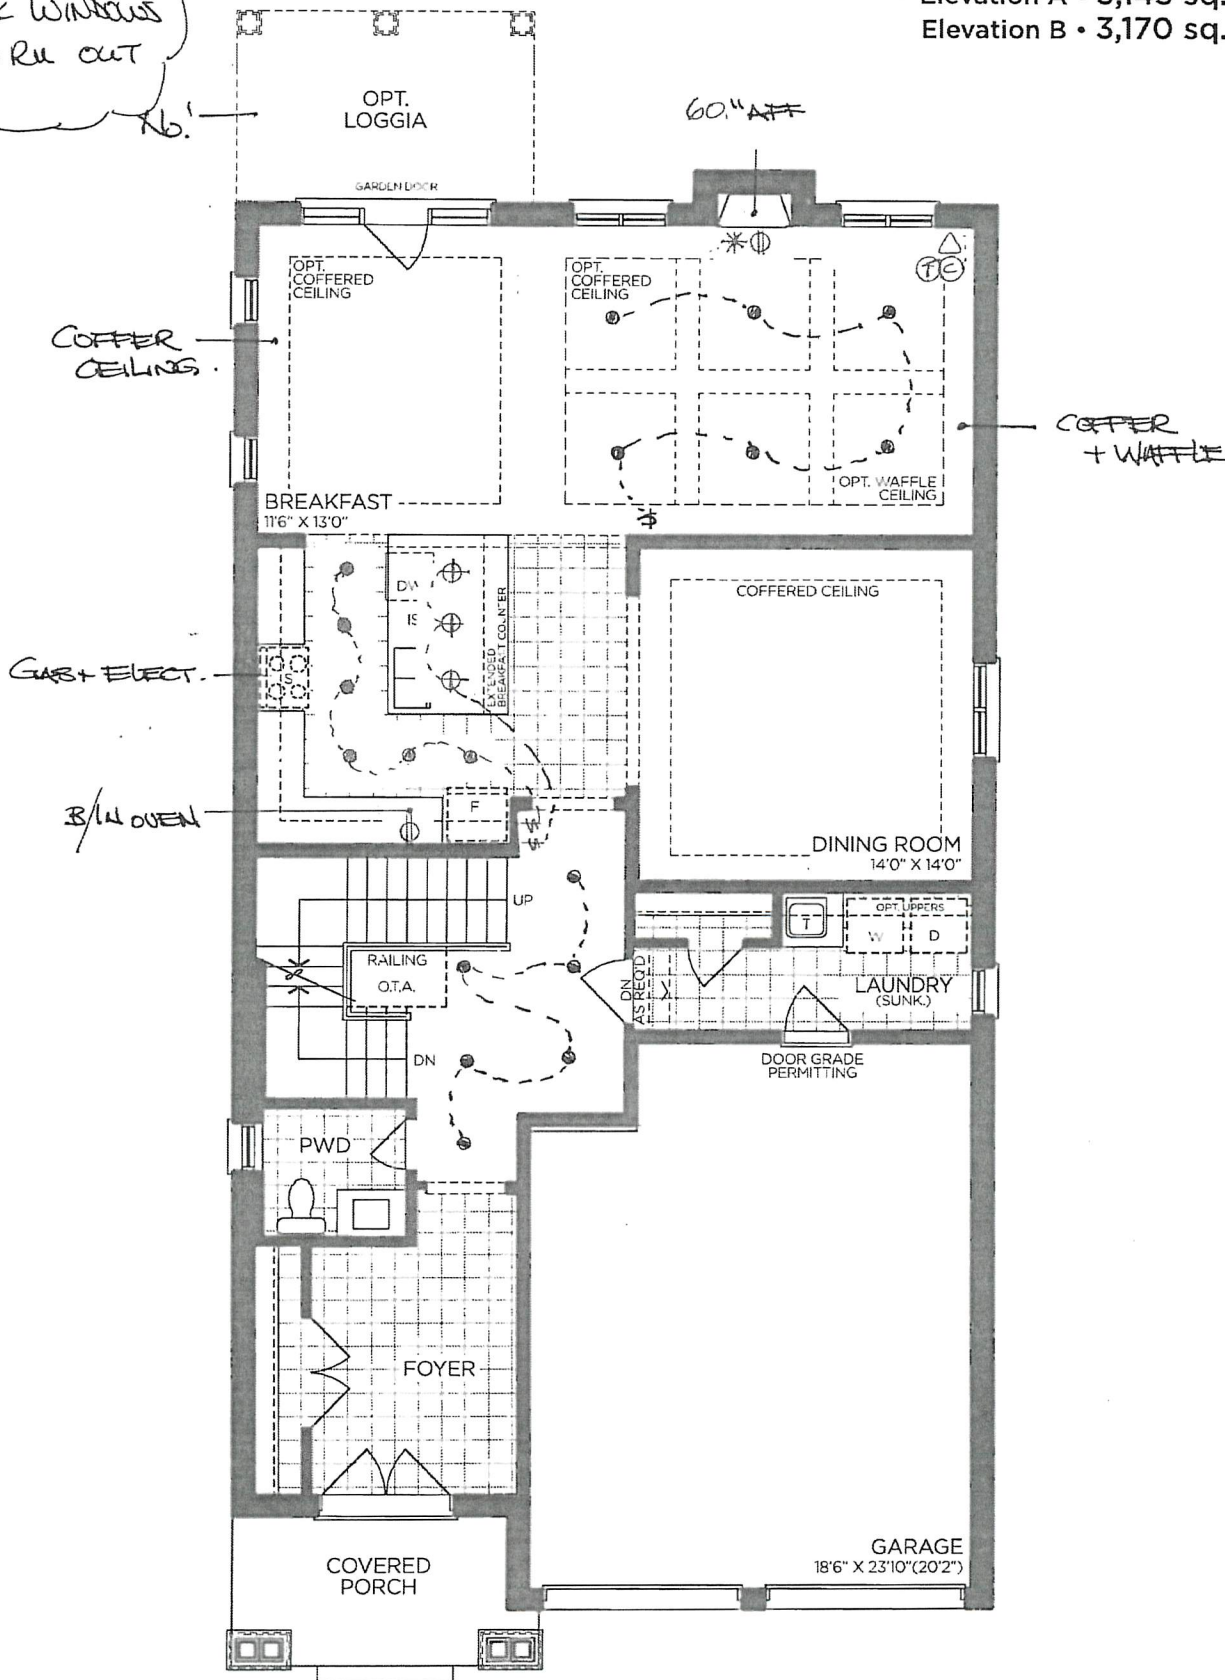

GROUND FLOOR | ELEV. A

|           |  |
|-----------|--|
| VENDOR    |  |
| PURCHASER |  |
| PURCHASER |  |

GOLDPARK  
WORTH MORE™

Prices, figures, illustrations, sizes, features and finishes are subject to change without notice. Areas and dimensions are approximate and actual usable floor space may vary from the stated area. Layout may be reverse of the unit purchased. E. & O.E. 4002




SCHEDULE 'F'



PV-118  
MAR 30 2020  
\*REVISED\* APRIL 27 2020

The  
**Valleyview**  
40' SERIES  
→ Elevation A • 3,145 sq.ft.  
Elevation B • 3,170 sq.ft.

8' Doors  
on 2nd  
Floor

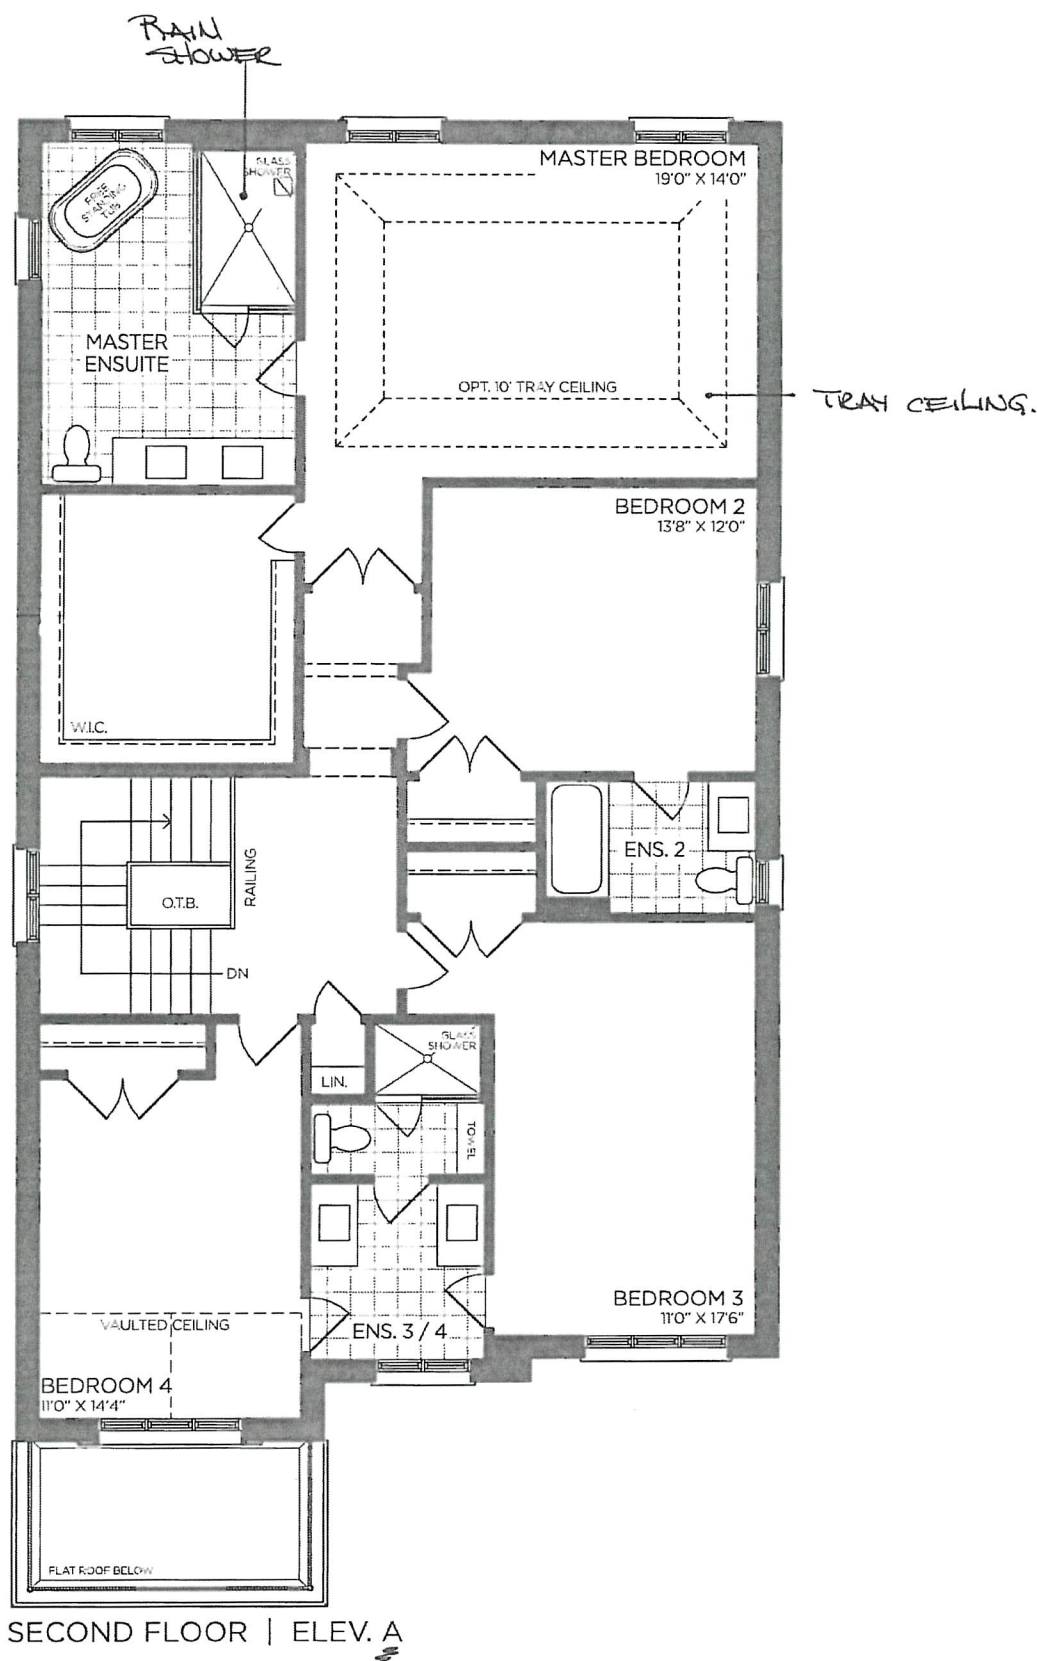

|           |  |
|-----------|--|
| VENDOR    |  |
| PURCHASER |  |
| PURCHASER |  |

**GOLDPARK**  
WORTH MORE™

Prices, figures, illustrations, sizes, features and finishes are subject to change without notice. Areas and dimensions are approximate and actual usable floor space may vary from the stated area. Layout may be reverse of the unit purchased. E. & O.E. 4002


SCHEDULE 'F'



FV-118  
March 30 2020  
\* REVISED \* April 27 2020

The  
Valleyview  
40' SERIES

→ Elevation A • 3,145 sq.ft.  
Elevation B • 3,170 sq.ft.

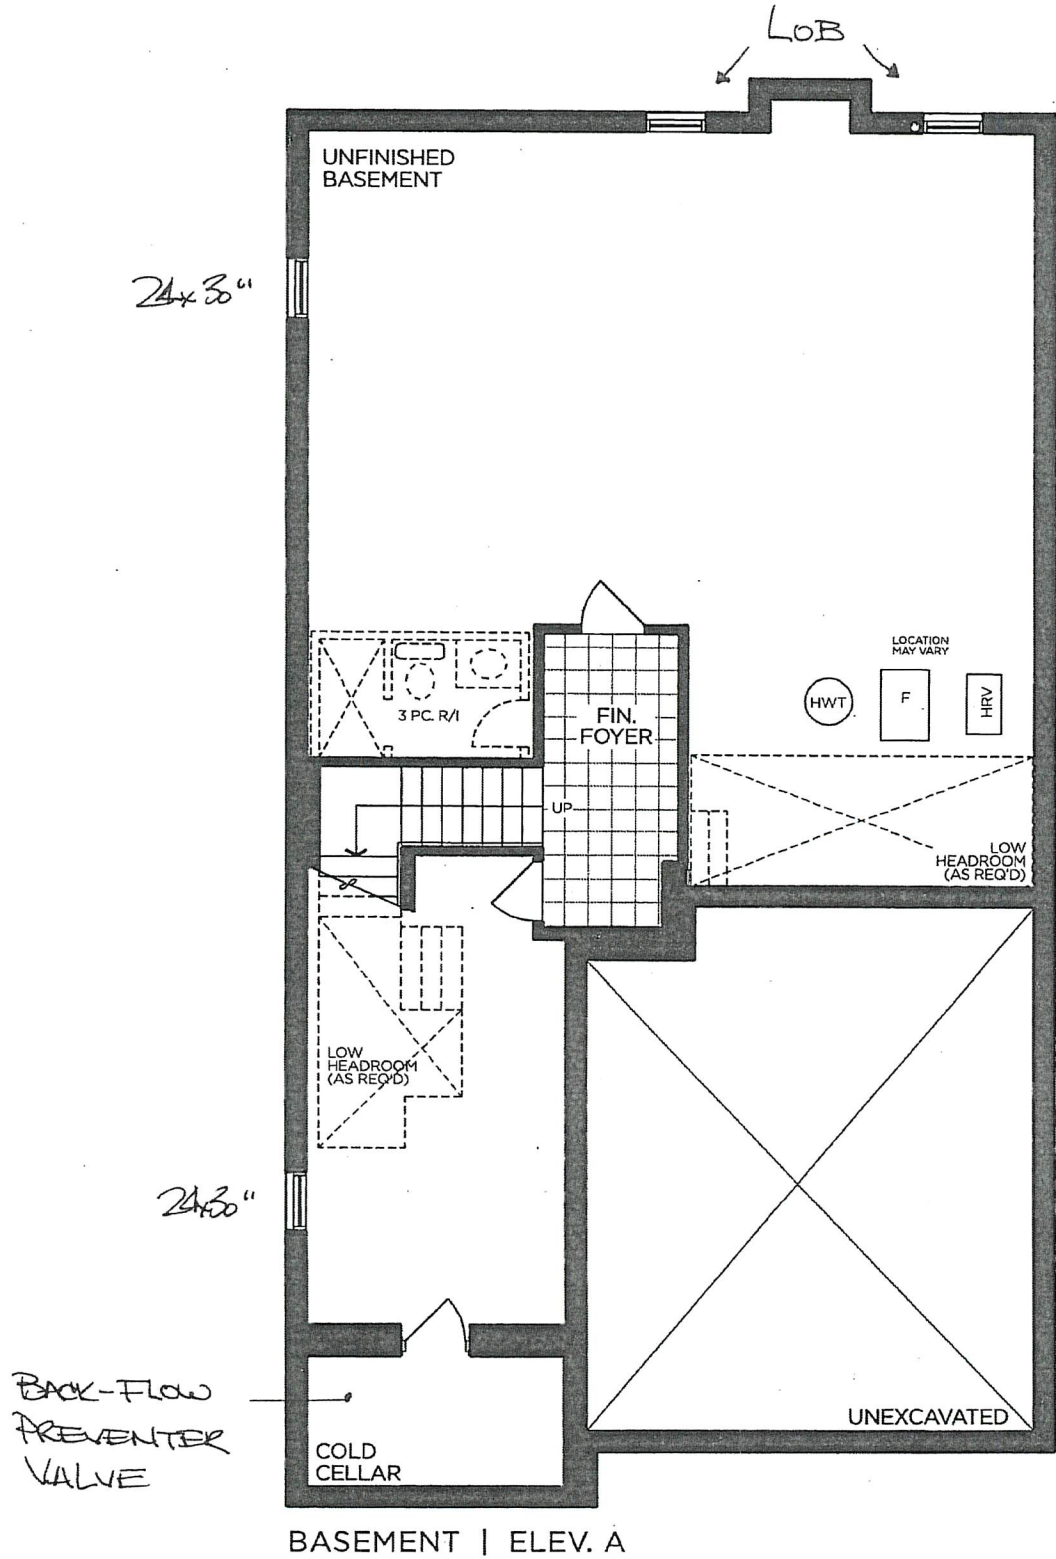

VENDOR

PURCHASER

PURCHASER

**GOLDPARK**  
WORTH MORE™

Prices, figures, illustrations, sizes, features and finishes are subject to change without notice. Areas and dimensions are approximate and actual usable floor space may vary from the stated area. Layout may be reverse of the unit purchased. E. & O.E. 4002