

GOLDPARK

WORTH MORE™

CONSTRUCTION SUMMARY

Lot: 124

Model: 38-8 Elev.A CORELLI OPT - GFA1

Project/Phase: Brampton Encore / 2

CENTRAL VAC AND WIRING

| Invoice                  | Qty. | Description  |
|--------------------------|------|--|
| 2239<br>31760<br>04May20 | 1    | FAMILY ROOM: CONDUIT PIPE- FOR TELEVISION- LOCATE APPROX. 66" A.F.F. ABOVE FIREPLACE, TERMINATING AT CABLE |

CERAMIC

| Invoice                           | Qty. | Description   |
|-----------------------------------|------|---|
| 2239<br>33132<br>04May20<br>NoCat | 1    | **REVISED LAYOUT** MOVE LAUNDRY TO 2ND FLOOR, COMPLETE WITH TILE FLOOR, TUB ON LEGS (BASED ON STANDARD FINISHES)      |
| 2239<br>33141<br>04May20<br>NoCat | 1    | ENSUITE 2: UPGRADE TO STANDING SHOWER IN LIEU OF TUB - INCLUDES TILE BASE, POTLIGHT AND FRAMED GLASS SHOWER ENCLOSURE |
| 2239<br>33146<br>04May20<br>NoCat | 1    | ENSUITE 4: UPGRADE TO STANDING SHOWER IN LIEU OF TUB - INCLUDES TILE BASE, POTLIGHT AND FRAMED GLASS SHOWER ENCLOSURE |

CONCRETE AND DRAIN

| Invoice                           | Qty. | Description               |
|-----------------------------------|------|---------------------------|
| 2239<br>31789<br>04May20<br>NoCat | 1    | BACK-FLOW PREVENTER VALVE |

DRYWALL

| Invoice                  | Qty. | Description                                  |
|--------------------------|------|--|
| 2239<br>31762<br>04May20 | 1    | SMOOTH CEILINGS - (2-Story Design) 2ND FLOOR |

ryDiscipline.rpt 14Mar20

Page 1 of 6



GOLDPARK

WORTH MORE™

CONSTRUCTION SUMMARY

Lot: 124

Model: 38-8 Elev.A CORELLI OPT - GFA1

Project/Phase: Brampton Encore / 2

EXTERIOR COLOURS

| Invoice                           | Qty. | Description                 |
|-----------------------------------|------|-----------------------------|
| 2239<br>33149<br>04May20<br>NoCat | 1    | EXTERIOR COLOUR PACKAGE # 9 |

FORMING

| Invoice                        | Qty. | Description  |
|--------------------------------|------|--|
| 2239<br>31762<br>04May20<br>** | 1    | SMOOTH CEILINGS - (2-Story Design) 2ND FLOOR   |
| 2239<br>31783<br>04May20<br>** | 3    | BASEMENT WINDOWS - UPGRADE EXISTING BASEMENT WINDOW TO 30 INCH X 24 INCH - MAY REQUIRE INSTALLATION OF WINDOW WELL |

FRAMING

| Invoice                           | Qty. | Description   |
|-----------------------------------|------|---|
| 2239<br>31758<br>04May20<br>NoCat | 1    | **REVISED LAYOUT** RECONFIGURE BEDROOM 5 TO CREATE 2 WIC'S AND SPACE FOR 2ND FLOOR LAUNDRY  |
| 2239<br>31763<br>04May20<br>NoCat | 2    | ***REVISE LAYOUT** LIBRARY/DEN: CLOSE (2 ARCHES), CREATE 1 LARGER OPENING APPROX. 60" WIDE. SEE PLAN FOR LOCATION   |
| 2239<br>31788<br>04May20<br>NoCat | 1    | ***REVISE LAYOUT*** MAIN FLOOR: FORMER LAUNDRY - RELOCATE DOOR TO SERVERY SIDE TO CREATE A 'FUTURE' PANTRY - LEAVE WITH TILE FLOOR AND STANDARD CEILING LIGHT. PURCHASER TO ADD OWN SHELVING AFTER CLOSING<br>SEE PLAN FOR LOCATION |
| 2239<br>33134<br>04May20<br>NoCat | 8    | EXTENDED HEIGHT ARCHWAY - 96"   |
| 2239<br>33135<br>04May20<br>NoCat | 1    | STANDARD DOOR EXTENDED HEIGHT 96"- MAIN FLOOR 3 STOREY MODELS   |
| 2239<br>33142<br>04May20<br>NoCat | 1    | ENSUITE 2: UPGRADE TO STANDING SHOWER IN LIEU OF TUB - INCLUDES TILE BASE, POTLIGHT AND FRAMED GLASS SHOWER ENCLOSURE   |
| 2239<br>33147<br>04May20<br>NoCat | 1    | ENSUITE 4: UPGRADE TO STANDING SHOWER IN LIEU OF TUB - INCLUDES TILE BASE, POTLIGHT AND FRAMED GLASS SHOWER ENCLOSURE   |

ryDiscipline.rpt 14Mar20


Page 3 of 6

| GARAGE DOORS             |      |  |
|--------------------------|------|--|
| Invoice                  | Qty. | Description  |
| 2239<br>31780<br>04May20 | 2    | GARAGE DOOR OPENER - WITH 1 REMOTE- PRICE IS PER DOOR **BELT DRIVE** |
| 2239<br>31781<br>04May20 | 1    | GARAGE: DIGITAL ENTRY KEYPAD   |

| GLASS AND MIRROR                  |      |   |
|-----------------------------------|------|---|
| Invoice                           | Qty. | Description   |
| 2239<br>33140<br>04May20<br>NoCat | 1    | ENSUITE 2: UPGRADE TO STANDING SHOWER IN LIEU OF TUB - INCLUDES TILE BASE, POTLIGHT AND FRAMED GLASS SHOWER ENCLOSURE |
| 2239<br>33144<br>04May20<br>NoCat | 1    | ENSUITE 4: UPGRADE TO STANDING SHOWER IN LIEU OF TUB - INCLUDES TILE BASE, POTLIGHT AND FRAMED GLASS SHOWER ENCLOSURE |

| HVAC                     |      |  |
|--------------------------|------|--|
| Invoice                  | Qty. | Description  |
| 2239<br>31772<br>04May20 | 1    | KITCHEN: GAS LINE ROUGH - 2ND FLOOR- (3-STOREY MODELS) |
| 2239<br>31784<br>04May20 | 1    | HUMIDIFIER: WB3 - 18 (3,000+ SQ.FT.)                   |

| INTERIOR TRIM AND DOORS           |      |  |
|-----------------------------------|------|--|
| Invoice                           | Qty. | Description  |
| 2239<br>31785<br>04May20          | 3    | STANDARD DOOR EXTENDED HEIGHT 96"- MAIN FLOOR 3 STOREY MODELS  |
| 2239<br>31786<br>04May20          | 8    | EXTENDED HEIGHT ARCHWAY - 96"  |
| 2239<br>33129<br>04May20<br>NoCat | 1    | **REVISED LAYOUT** RECONFIGURE BEDROOM 5 TO CREATE 2 WIC'S AND SPACE FOR 2ND FLOOR LAUNDRY                       |
| 2239<br>33131<br>04May20<br>NoCat | 1    | **REVISED LAYOUT** MOVE LAUNDRY TO 2ND FLOOR, COMPLETE WITH TILE FLOOR, TUB ON LEGS (BASED ON STANDARD FINISHES) |



CONSTRUCTION SUMMARY

Lot: 124

Model: 38-8 Elev.A CORELLI OPT - GFA1

Project/Phase: Brampton Encore / 2

MISC.

| Invoice                           | Qty. | Description  |
|-----------------------------------|------|--|
| 2239<br>31757<br>04May20<br>NoCat | 1    | ***PLAN CHANGE*** 5 BEDROOM  |
| 2239<br>31790<br>04May20<br>NoCat | 1    | BONUS PACKAGE: \$10,000.00 (INCLUDING TAXES) WORTH OF UPGRADES FROM GOLD PARK HOMES DÉCOR CENTRE IS BEING APPLIED TOWARD THIS ORDER. PURCHASER HAS A REMAINING AMOUNT OF \$00 (INCLUDING TAXES).                                 |
| 2239<br>31791<br>04May20<br>NoCat | 1    | Purchaser has attended an appointment at the Decor Centre & has DECLINED any additional upgrades and accepts & acknowledges that there will be no further changes/additions/deletions to be made upon signing on March 24, 2020. |

PAINTING

| Invoice                           | Qty. | Description  |
|-----------------------------------|------|--|
| 2239<br>31762<br>04May20<br>**    | 1    | SMOOTH CEILINGS - (2-Story Design) 2ND FLOOR   |
| 2239<br>33127<br>04May20<br>NoCat | 1    | **REVISED LAYOUT** RECONFIGURE BEDROOM 5 TO CREATE 2 WIC'S AND SPACE FOR 2ND FLOOR LAUNDRY |

PLUMBING

| Invoice                           | Qty. | Description   |
|-----------------------------------|------|---|
| 2239<br>31759<br>04May20<br>NoCat | 1    | **REVISED LAYOUT** MOVE LAUNDRY TO 2ND FLOOR, COMPLETE WITH TILE FLOOR, TUB ON LEGS (BASED ON STANDARD FINISHES)      |
| 2239<br>31778<br>04May20          | 1    | ENSUITE 2: UPGRADE TO STANDING SHOWER IN LIEU OF TUB - INCLUDES TILE BASE, POTLIGHT AND FRAMED GLASS SHOWER ENCLOSURE |
| 2239<br>31779<br>04May20<br>NoCat | 1    | ENSUITE 4: UPGRADE TO STANDING SHOWER IN LIEU OF TUB - INCLUDES TILE BASE, POTLIGHT AND FRAMED GLASS SHOWER ENCLOSURE |
| 2239<br>31787<br>04May20          | 1    | KITCHEN: ROUGH-IN - WATERLINE FOR FRIDGE  |

PLUMBING FIXTURES

| Invoice                           | Qty. | Description   |
|-----------------------------------|------|---|
| 2239<br>33143<br>04May20<br>NoCat | 1    | ENSUITE 2: UPGRADE TO STANDING SHOWER IN LIEU OF TUB - INCLUDES TILE BASE, POTLIGHT AND FRAMED GLASS SHOWER ENCLOSURE |
| 2239<br>33148<br>04May20<br>NoCat | 1    | ENSUITE 4: UPGRADE TO STANDING SHOWER IN LIEU OF TUB - INCLUDES TILE BASE, POTLIGHT AND FRAMED GLASS SHOWER ENCLOSURE |

GOLDPARK

WORTH MORE™

CONSTRUCTION SUMMARY

Lot: 124

Model: 38-8 Elev.A CORELLI OPT - GFA1

Project/Phase: Brampton Encore / 2

| WINDOWS - BASEMENT       |      |  |
|--------------------------|------|--|
| Invoice                  | Qty. | Description  |
| 2239<br>31783<br>04May20 | 3    | BASEMENT WINDOWS - UPGRADE EXISTING BASEMENT WINDOW TO 30 INCH X 24 INCH - MAY REQUIRE INSTALLATION OF WINDOW WELL |


| WINDOWS AND DOORS                 |      |   |
|-----------------------------------|------|---|
| Invoice                           | Qty. | Description   |
| 2239<br>33136<br>04May20<br>NoCat | 1    | STANDARD DOOR EXTENDED HEIGHT 96"- MAIN FLOOR 3 STOREY MODELS |

This Document is Extremely Time Sensitive - Printed 4 May 20 at 11:47

BE2-124 ~~see~~ attach.  
MAR 24 2020

The  
Corelli  
38' SERIES

Elevation A • 3,878 sq.ft. | Elevation B • 3,878 sq.ft.

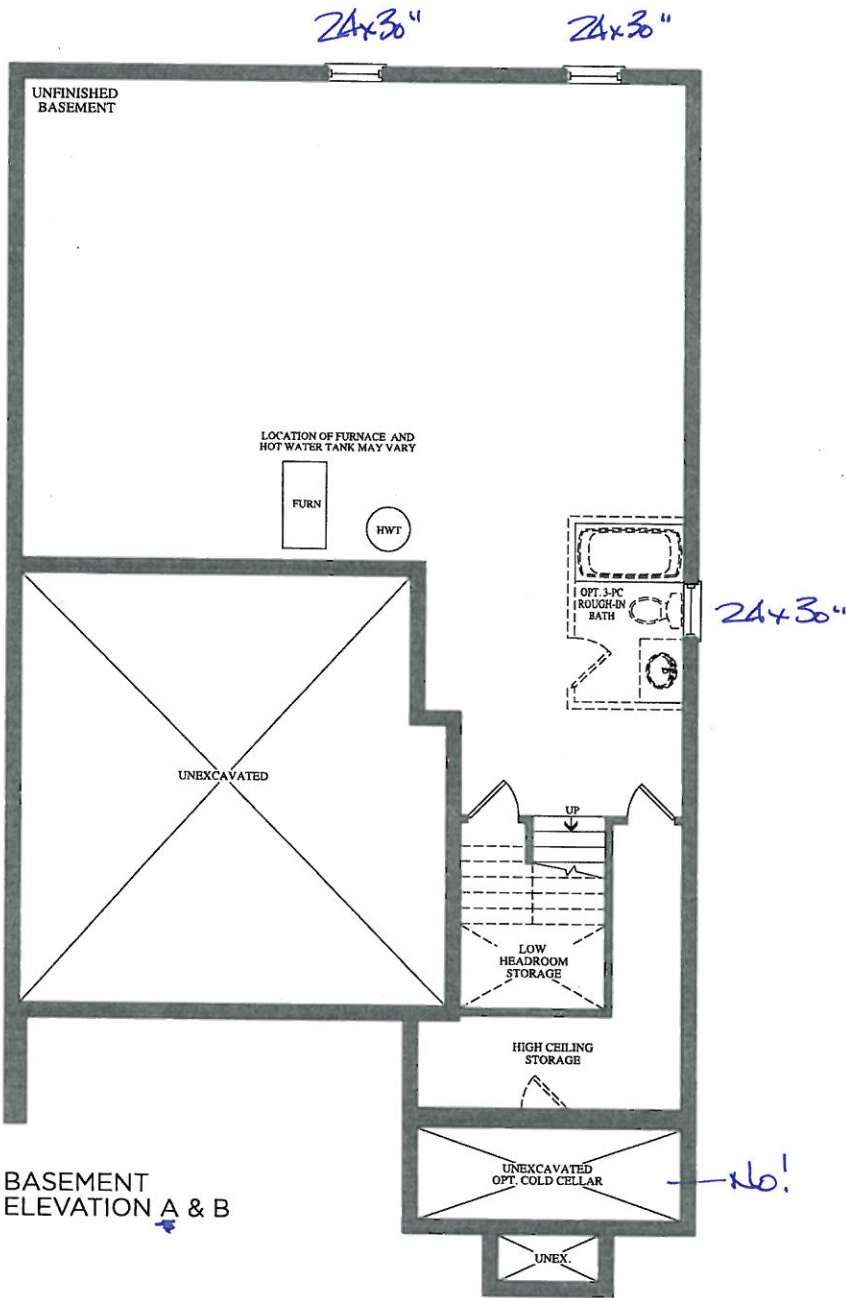


Prices, figures, illustrations, sizes, features and finishes are subject to change without notice. E.&O.E. Areas and dimensions are approximate and actual usable floor space may vary from the stated area. Layout may be reverse of the unit purchased. E. & O.E.

BE2-124. *see sketch*  
March 24 2020

The  
Corelli  
38' SERIES

Elevation A • 3,878 sq.ft. | Elevation B • 3,878 sq.ft.

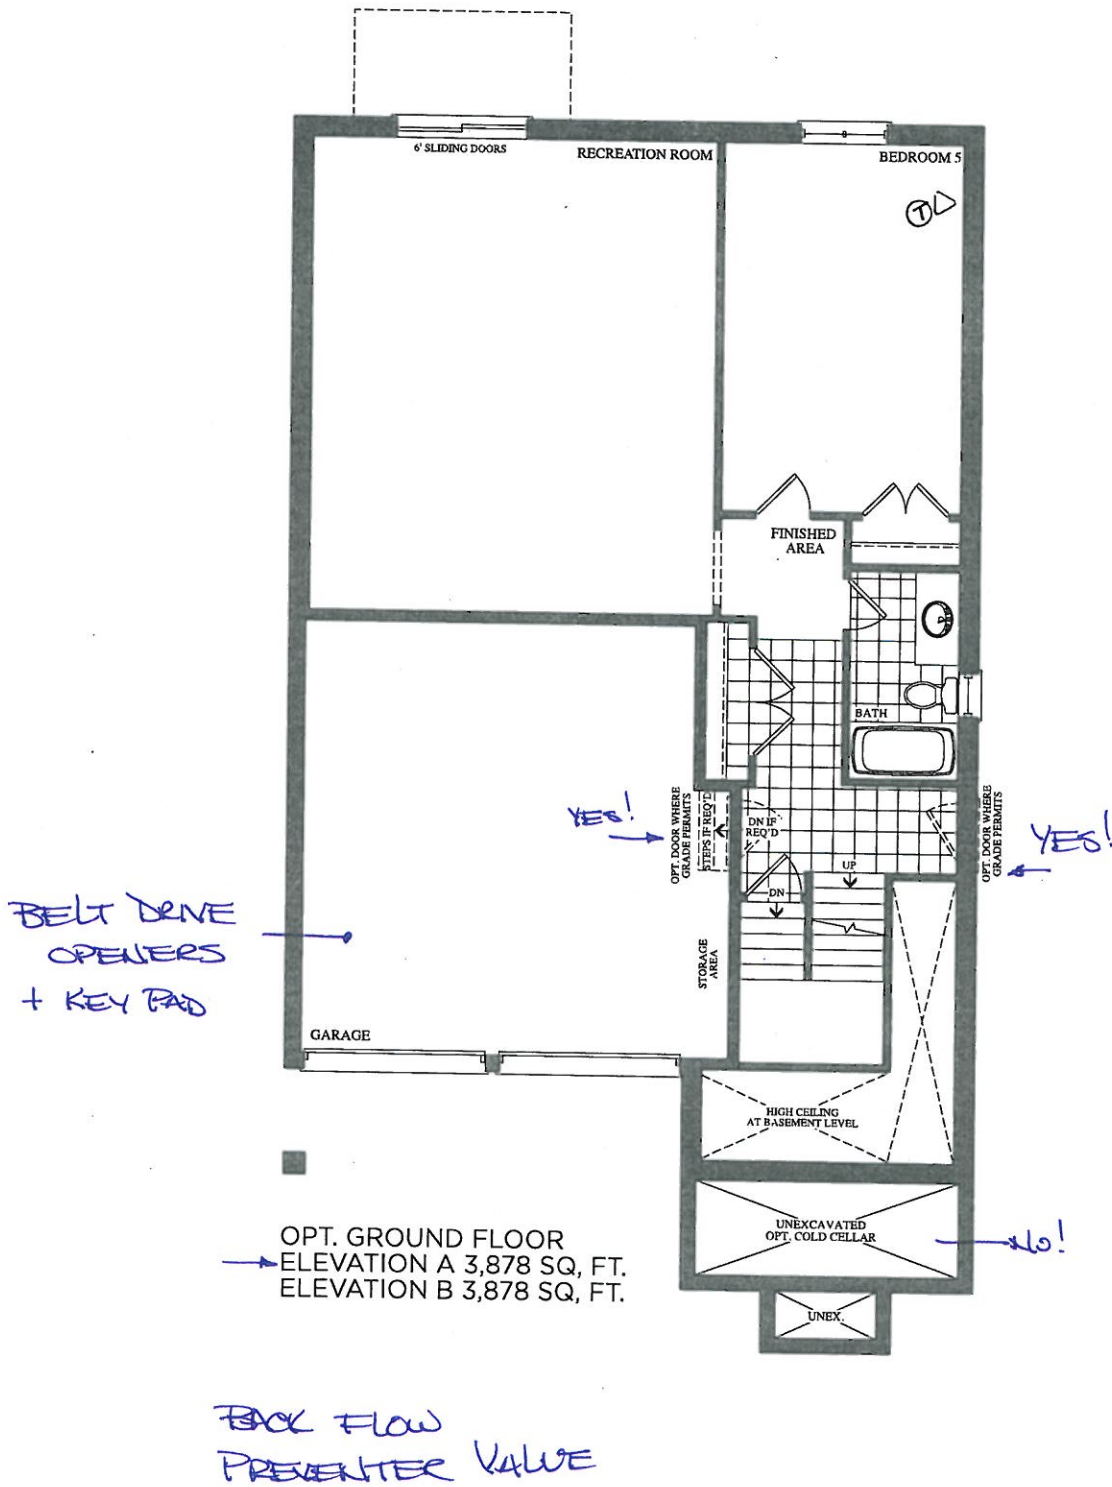



BEZ-124  
MAR 24 2020

See 2/14/20

**The  
Corelli**  
38' SERIES


Elevation A • 3,878 sq.ft. | Elevation B • 3,878 sq.ft.

Smooth  
CEILING.


GAS + ELECT

WALL OVEN  
FRIDGE WATER LINE

Lights to  
be centered to  
CEILING  
(Not Door)

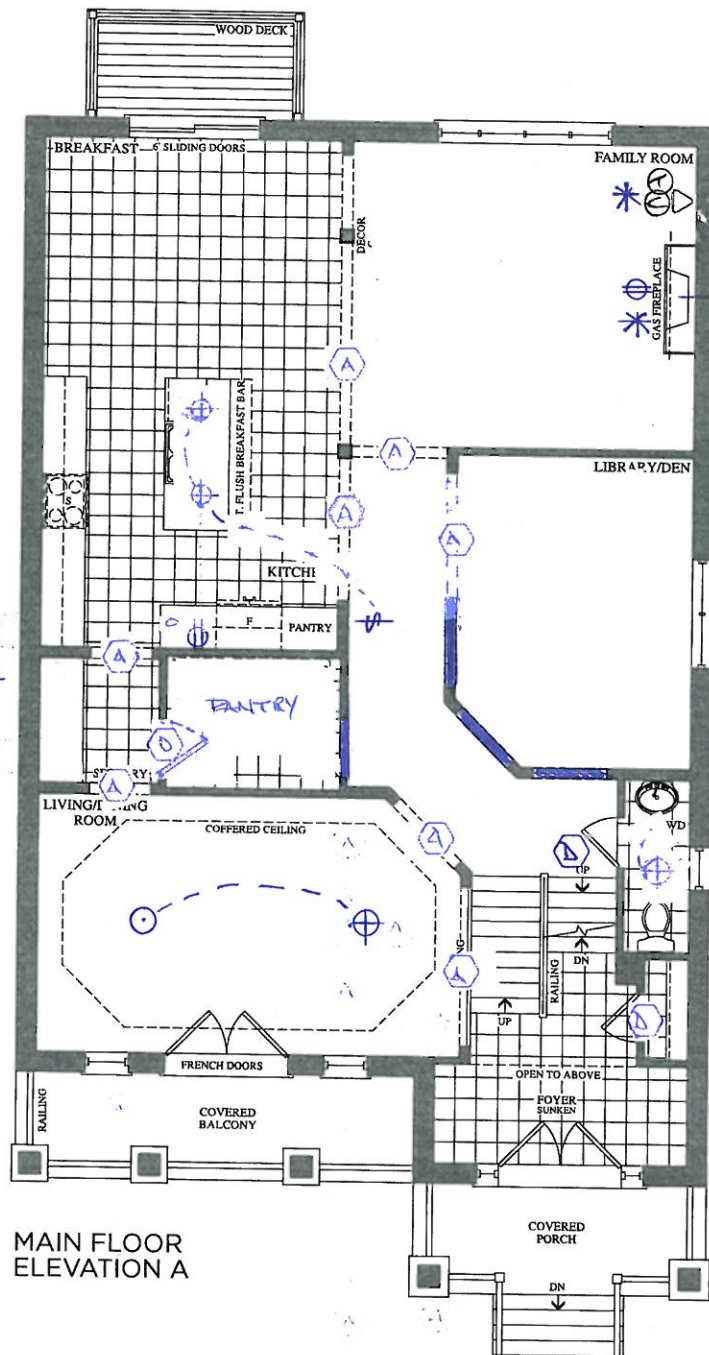



MAIN FLOOR  
ELEVATION A

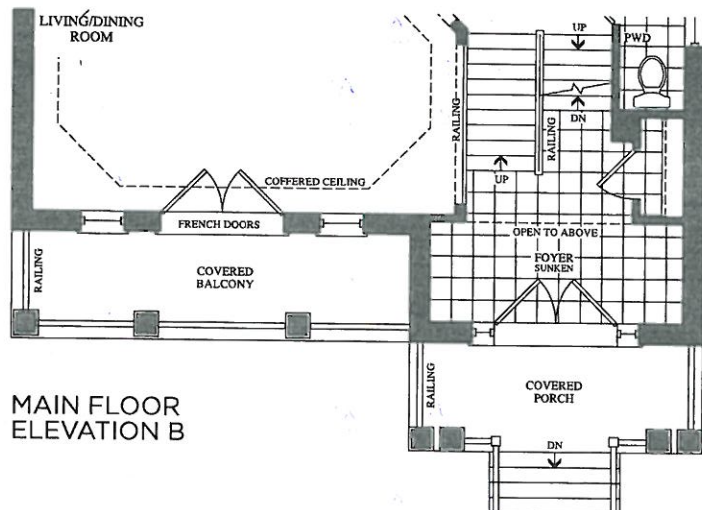

MAIN FLOOR  
ELEVATION B

BEZ-124  
MAR 24 2020  
see other

Elevation A • 3,878 sq.ft. | Elevation B • 3,878 sq.ft.

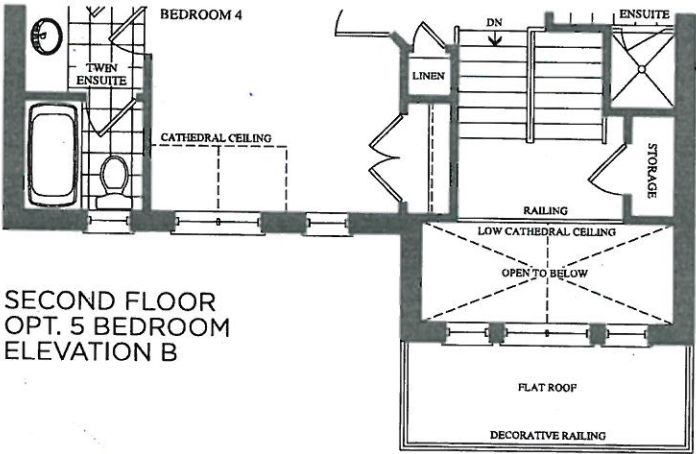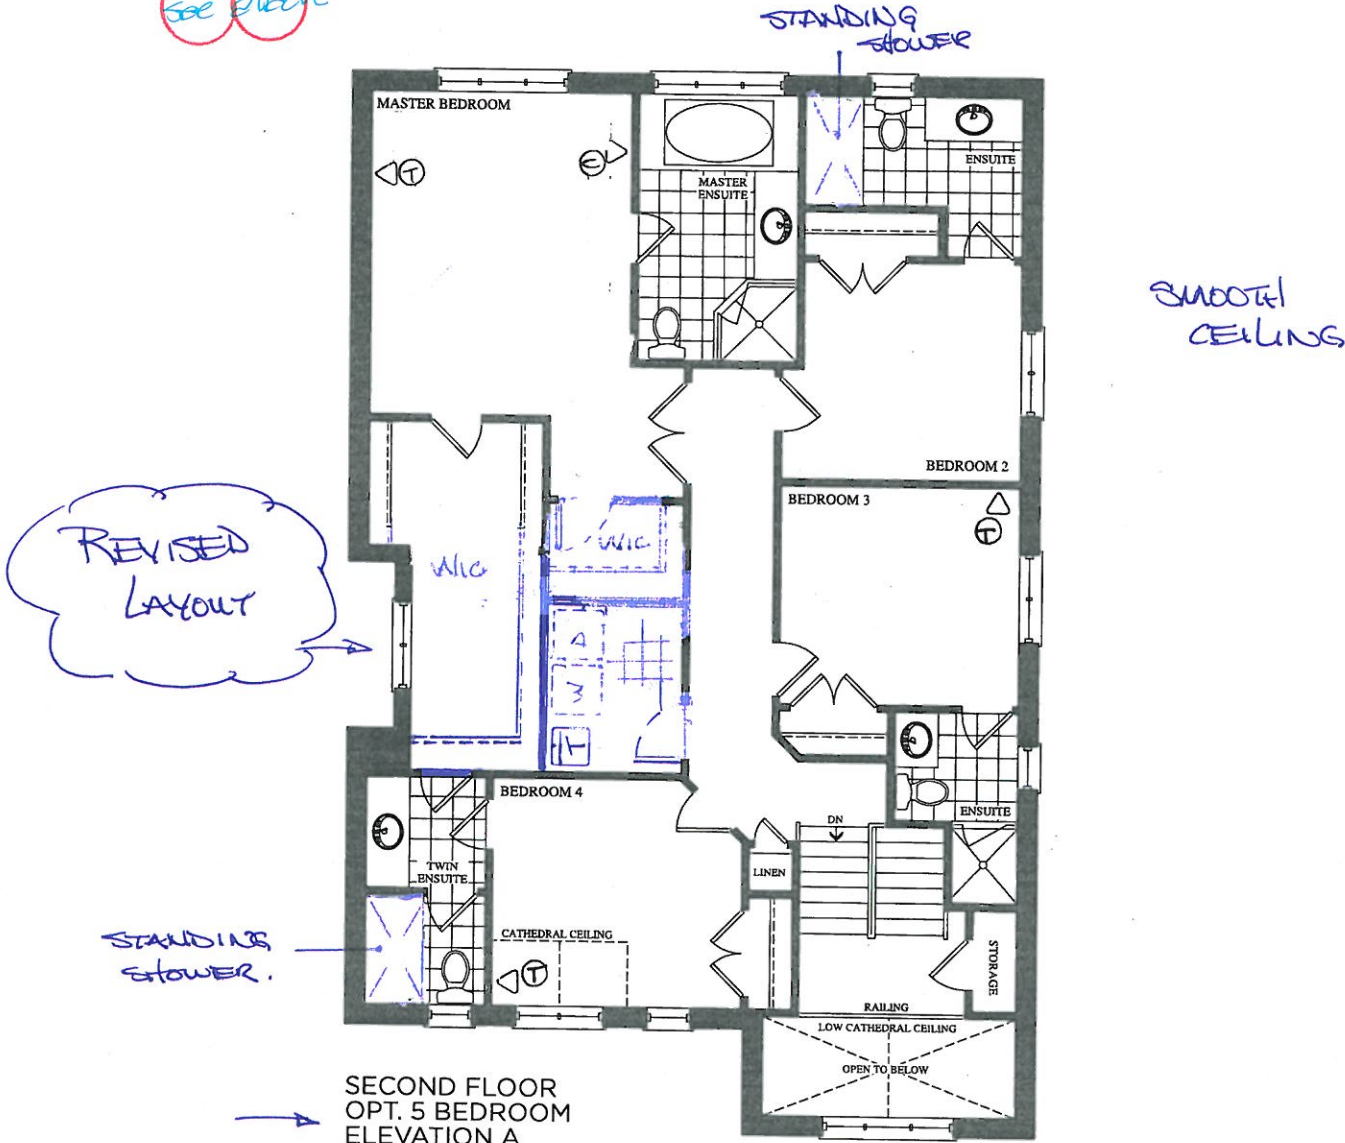


encore  
BRAMPTON

BE2-124 SR SR  
MAR 21 2020

The  
Corelli  
38' SERIES

Elevation A • 3,878 sq.ft. | Elevation B • 3,878 sq.ft.

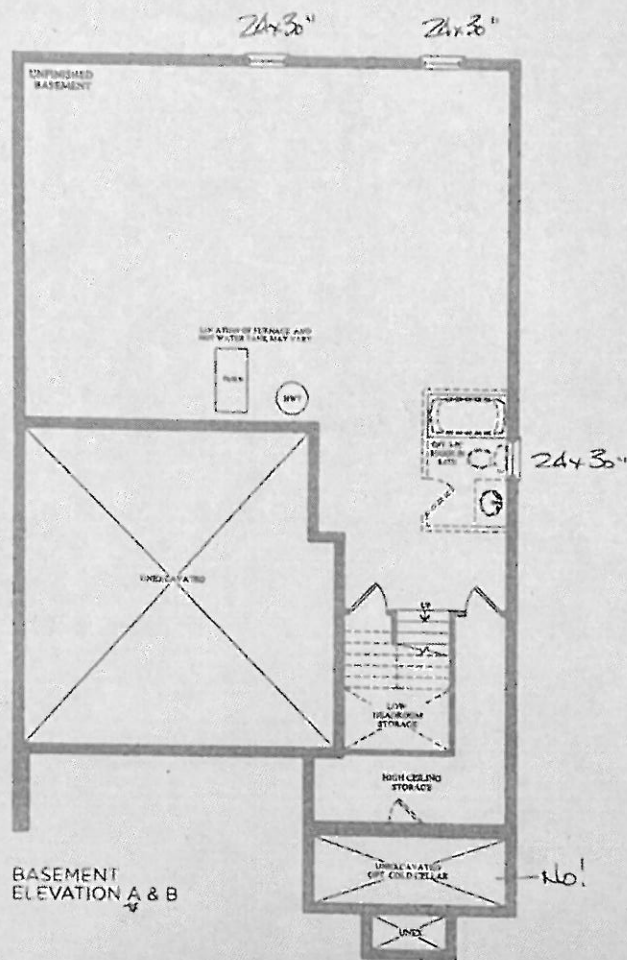

Prices, figures, illustrations, sizes, features and finishes are subject to change without notice. E. & O. Areas and dimensions are approximate and actual usable floor space may vary from the stated area. Layout may be reverse of the unit purchased. E. & O.E.

GOLDPARK  
HOMES




encore  
BRAMPTON

BE2-121. <sup>SR</sup> <sup>SR</sup>  
MAY 24 2020

# The Corelli 38' SERIES

Elevation A • 3,878 sq.ft. | Elevation B • 3,878 sq.ft.

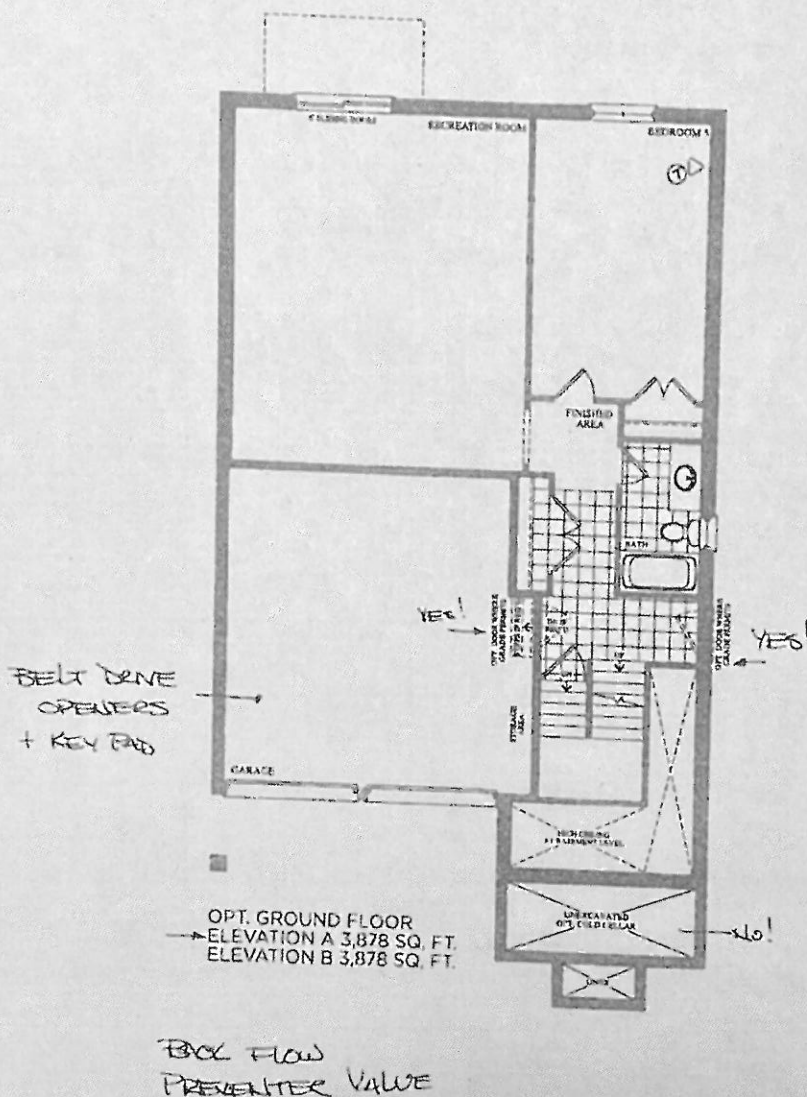

Prices, figures, illustrations, sizes, features and finishes are subject to change without notice. E&OE. Areas and dimensions are approximate and actual usable floor space may vary from the stated area. Layout may be reverse of the unit purchased. E & OE.

GOLDPARK  
HOMES

encore  
BRAMPTON

BEZ-124  
MARCH 24 2020

SR

SR

# The Corelli 38' SERIES



Elevation A • 3,878 sq.ft. | Elevation B • 3,878 sq.ft.

Smooth  
ceiling

GAS + ELECT

WALL OVEN.  
FRIDGE WATER LINE

Lights to  
be centered to  
ceiling  
(NOT DONE)

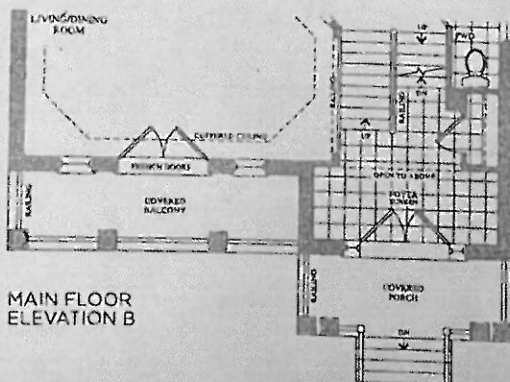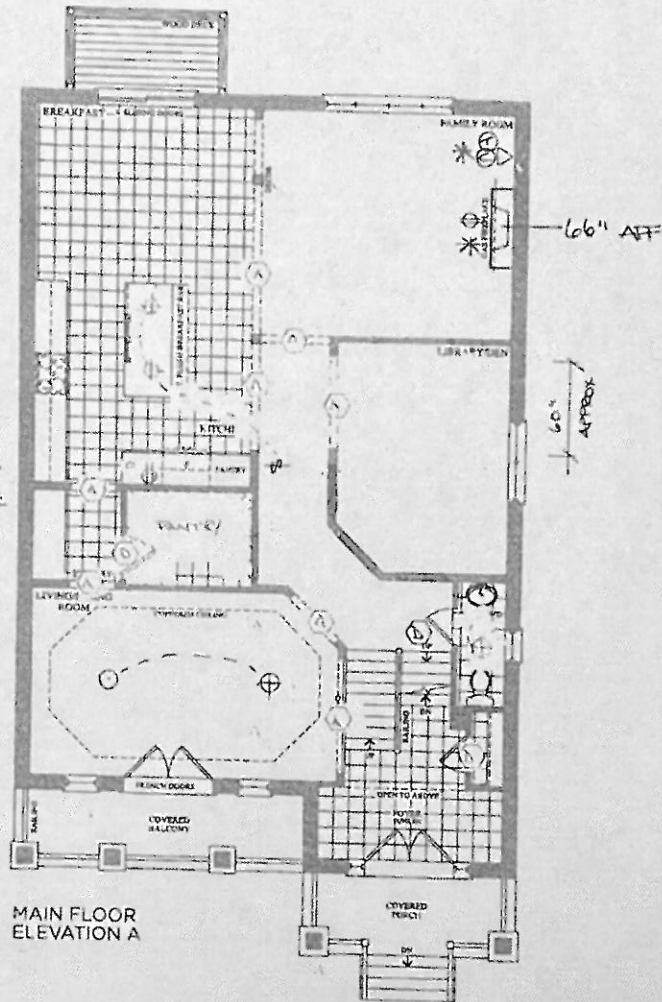

Prices, figures, illustrations, sizes, features and finishes are subject to change without notice. E & OE. Areas and dimensions are approximate and actual usable floor space may vary from the stated area. Layout may be reverse of the unit purchased. E & OE.


GOLDPARK  
HOMES

encore  
BRAMPTON

The  
Corelli  
38' SERIES

Elevation A • 3,878 sq.ft. | Elevation B • 3,878 sq.ft.

FEZ-124  
March 24 2020  
SR SR

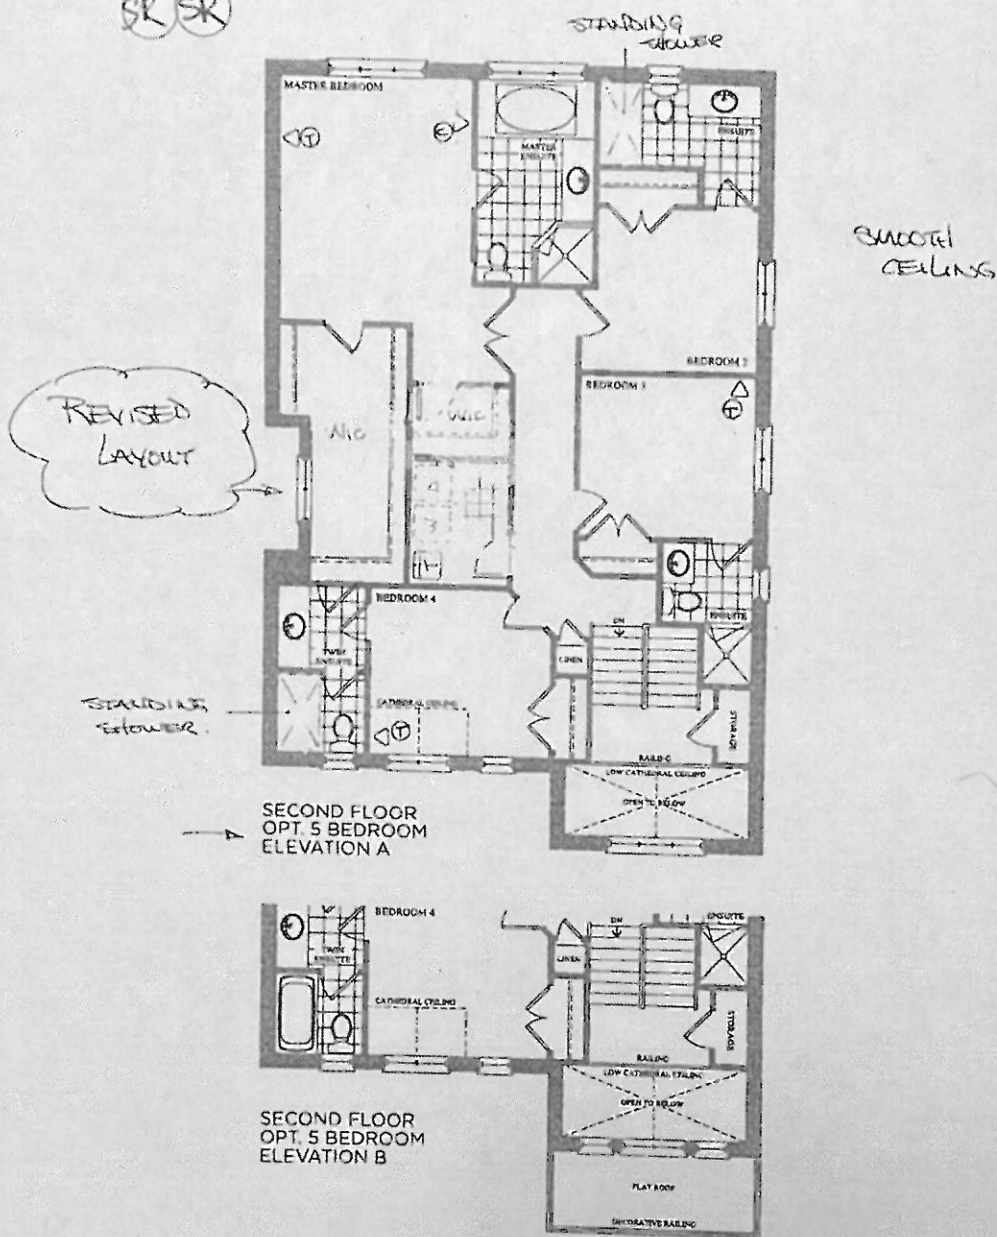

Prices, figures, illustrations, sizes, features and finishes are subject to change without notice. E.S.C.I. Areas and dimensions are approximate and actual usable floor space may vary from the stated area. Layout may be reverse of the unit purchased. E. & O.E.

GOLDPARK  
HOMES