

GOLDPARK

WORTH MORE™

CONSTRUCTION SUMMARY

Lot: 134

Model: 38-11 Elev A Schumann

Project/Phase: Brampton Encore / 2

APPLIANCES		
Invoice	Qty.	Description
2302 32571 04May20 NoCat	1	APPLIANCE PACKAGE: FRIDGE/STOVE/DISHWASHER - STAINLESS STEEL + WASHER/DRYER - WHITE  INCLUDED IN APS

CONCRETE AND DRAIN		
Invoice	Qty.	Description
2302 32570 04May20 **	1	ROUGH-IN - 3PC BASEMENT ROUGH-IN  INCLUDED IN APS


ELECTRICAL		
Invoice	Qty.	Description
2302 32562 04May20	1	LIVING ROOM: ROUGH - IN CEILING OUTLET - DOES NOT INCLUDE FIXTURE - LOCATE APPROX. CENTER OF ROOM - SEE PLAN
2302 32563 04May20 NoCat	1	LIVING ROOM: SINGLE POLE SWITCH FOR CEILING LIGHT
2302 32574 04May20	2	KITCHEN: ROUGH - IN CEILING OUTLET- DOES NOT INCLUDE FIXTURE - LOCATE APPROX. CENTERED ABOVE ISLAND
2302 32575 04May20 NoCat	1	KITCHEN: SINGLE POLE SWITCH FOR ISLAND LIGHTS

EXTERIOR COLOURS		
Invoice	Qty.	Description
2302 33187 04May20 NoCat	1	EXTERIOR COLOUR PACKAGE # 9

FORMING		
Invoice	Qty.	Description
2302 32568 04May20	1	SIDE DOOR- HOME TO EXTERIOR- AS PER PLAN AND GRADE PERMITTING  INCLUDED IN APS
2302 33183 04May20 NoCat	1	GARAGE MANDOOR - AS PER PLAN AND GRADE PERMITTING

ryDiscipline.rpt 14Mar20

Page 1 of 3



CONSTRUCTION SUMMARY

Lot: 134

Model: 38-11 Elev A Schumann

Project/Phase: Brampton Encore / 2

FRAMING		
Invoice	Qty.	Description
2302 32569 04May20	1	MANDOOR - GARAGE TO HOUSE- AS PER PLAN AND GRADE PERMITTING  INCLUDED IN APS
2302 33184 04May20 NoCat	1	SIDE DOOR - AS PER PLAN AND GRADE PERMITTING

HVAC		
Invoice	Qty.	Description
2302 32572 04May20 NoCat	1	A/C- 2.50 TON  INCLUDED IN APS

INTERIOR TRIM AND DOORS		
Invoice	Qty.	Description
2302 32568 04May20 **	1	SIDE DOOR- HOME TO EXTERIOR- AS PER PLAN AND GRADE PERMITTING  INCLUDED IN APS
2302 33185 04May20 NoCat	1	GARAGE MANDOOR - AS PER PLAN AND GRADE PERMITTING

MISC.		
Invoice	Qty.	Description
2302 32567 04May20 NoCat	1	Purchaser has attended a phone appointment with the Decor Centre & has DECLINED any additional upgrades and accepts and acknowledges that there will be no further changes/additions/deletions to be made upon signing on April 20, 2020

PAINT		
Invoice	Qty.	Description
2302 33188 04May20 NoCat	1	SIDE DOOR - AS PER PLAN AND GRADE PERMITTING
2302 33189 04May20 NoCat	1	GARAGE MANDOOR - AS PER PLAN AND GRADE PERMITTING

PLUMBING		
Invoice	Qty.	Description
2302 32570 04May20	1	ROUGH-IN - 3PC BASEMENT ROUGH-IN  INCLUDED IN APS

WINDOWS - BASEMENT		
Invoice	Qty.	Description
2302 32573 04May20	3	BASEMENT WINDOWS - UPGRADE EXISTING BASEMENT WINDOW TO 30 INCH X 24INCH

WINDOWS AND DOORS		
Invoice	Qty.	Description
2302 32568 04May20 **	1	SIDE DOOR- HOME TO EXTERIOR- AS PER PLAN AND GRADE PERMITTING  INCLUDED IN APS
2302 33186 04May20 NoCat	1	GARAGE MANDOOR - AS PER PLAN AND GRADE PERMITTING

This Document is Extremely Time Sensitive - Printed 4 May 20 at 16:25

encore  
BRAMPTON

SCHEDULE 'F'

BEZ-184


APRIL 24 2020

PP

PP

# The Schumann 38' SERIES

→ Elevation A • 3,050 sq.ft.  
Elevation B • 3,050 sq.ft.

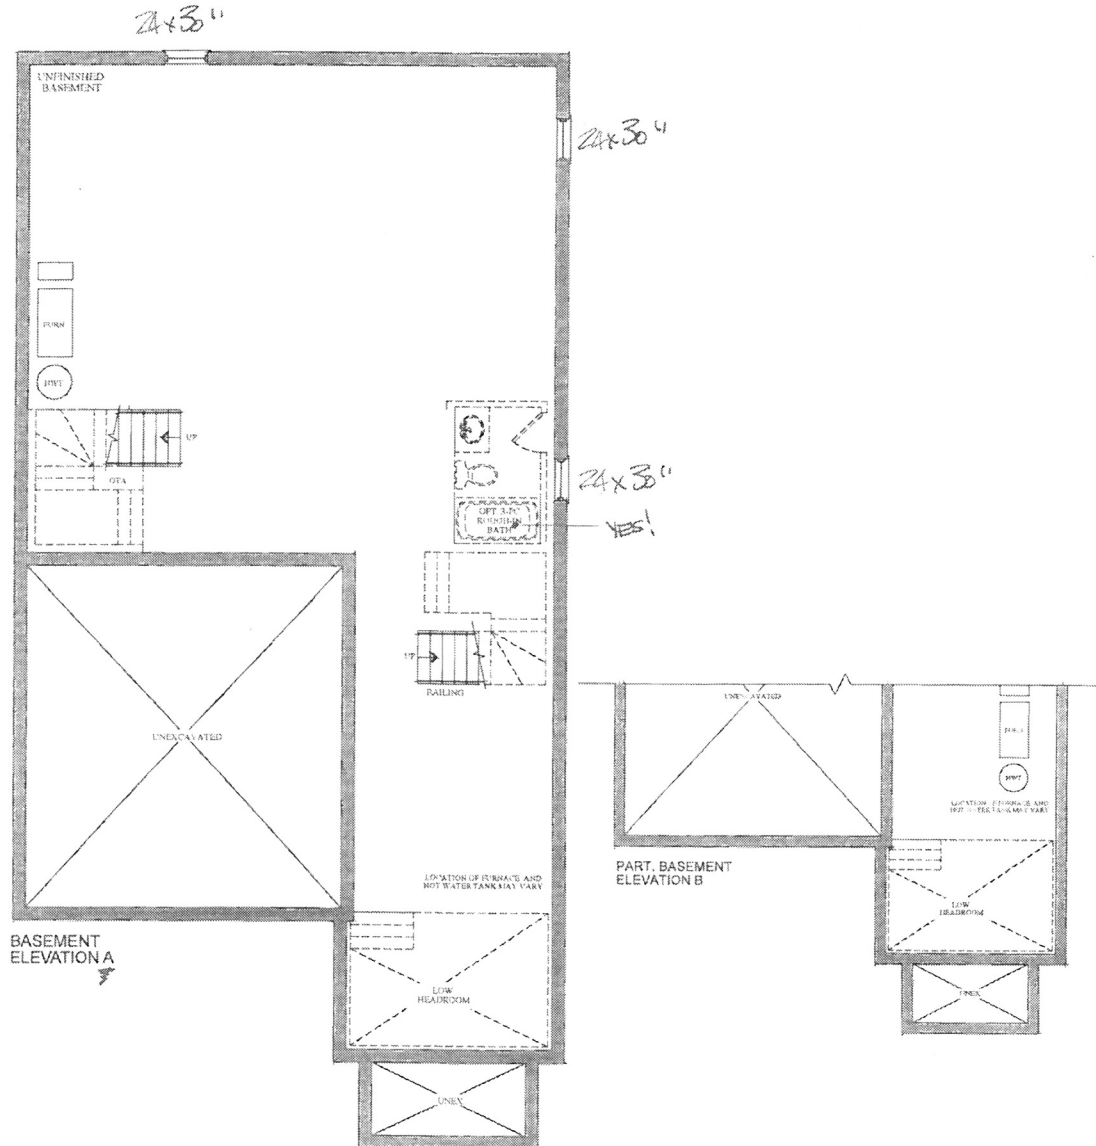

VENDOR

PURCHASER

PURCHASER

*Parul P. Patel*

**GOLD PARK**  
WORTH MORE™

Prices, figures, illustrations, sizes, features and finishes are subject to change without notice. Areas and dimensions are approximate and actual usable floor space may vary from the stated area. Layout may be reverse of the unit purchased. E. & O.E.

# The Schumann



## 38' SERIES

→ Elevation A • 3,050 sq.ft.  
Elevation B • 3,050 sq.ft.

BE2-134.  
APRIL 24 2020

pp  
ppp

smooth ceiling

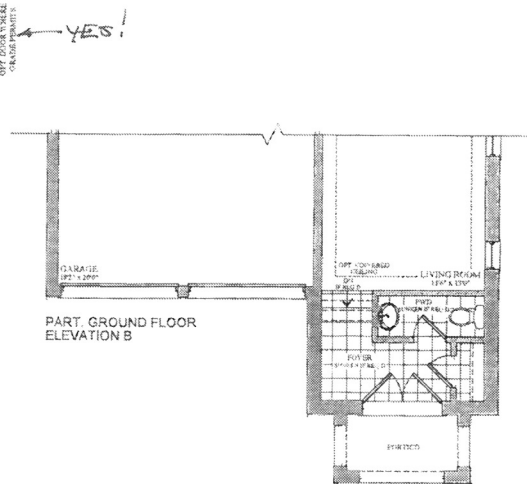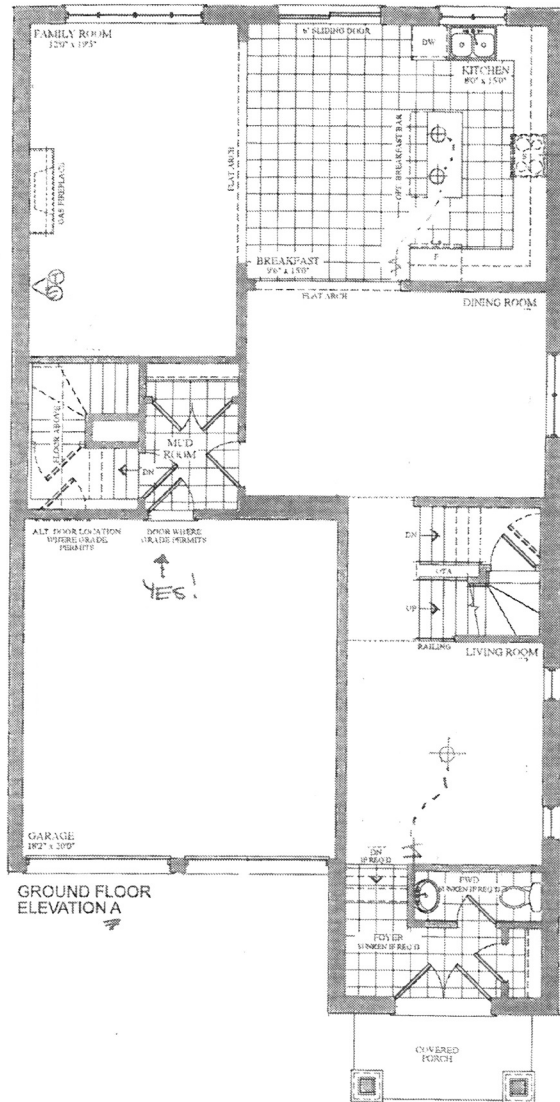

VENDOR

PURCHASER

PURCHASER

*Biyush*  
*Parmit P. Patel*

**GOLD PARK**  
WORTH MORE™

Prices, figures, illustrations, sizes, features and finishes are subject to change without notice. Areas and dimensions are approximate and actual usable floor space may vary from the stated area. Layout may be reverse of the unit purchased. E. & O.E.



encore  
BRAMPTON

SCHEDULE 'F'

2E2-134 PP  
April 24 2020 PPF

The  
**Schumann**  
38' SERIES

→ Elevation A • 3,050 sq.ft.  
Elevation B • 3,050 sq.ft.

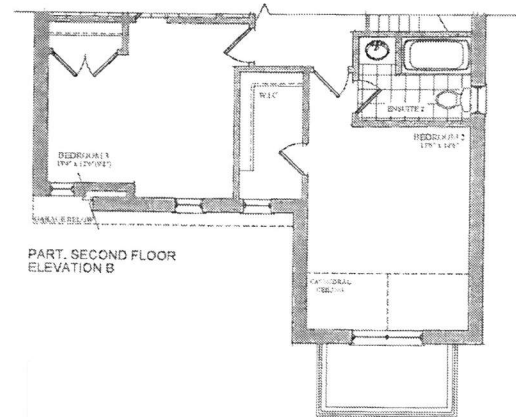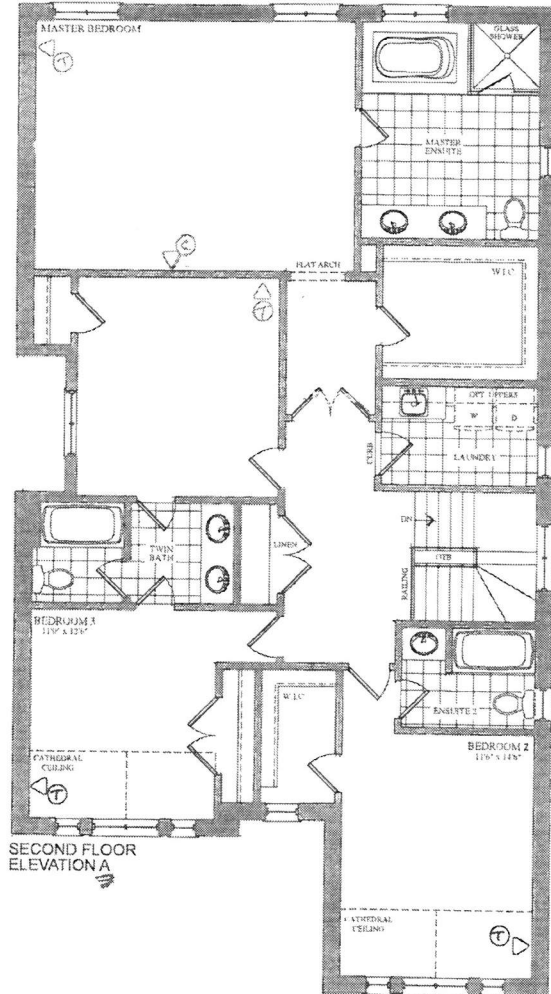

VENDOR  
PURCHASER  
PURCHASER

*Buyer*  
*Ram P. Patel*

**GOLD PARK**  
WORTH MORE™

Prices, figures, illustrations, sizes, features and finishes are subject to change without notice. Areas and dimensions are approximate and actual usable floor space may vary from the stated area. Layout may be reverse of the unit purchased. E. & O.E.