


UNIT NAME: HILLSBOROUGH ELEVATION: UPG.REAR EL. A (REV) UNIT NUMBER: 5001-LOT 112



LOT NUMBER: 112
UNIT NAME: HILLSBOROUGH ELEVATION: A (REV)
UNIT NUMBER: 5001-LOT 112

PURPLE CREEK ROAD

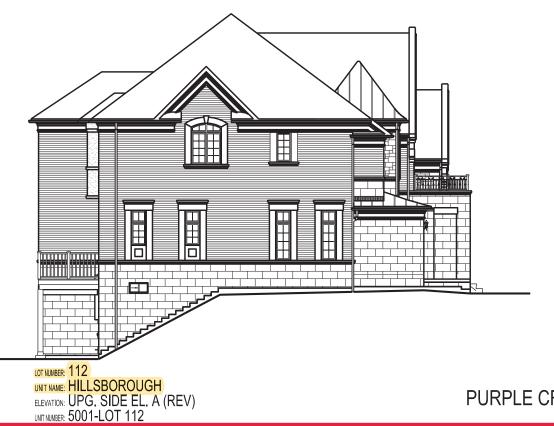

LOTNUMBER: 113
UNIT NAME: MODEL
ELEVATION: A (REV)
UNIT NUMBER: 4207-LOT 113



LOT NUMBER: 113 UNIT NAME: MODEL
ELEVATION: FLANKAGE EL. A (REV)
UNIT NUMBER: 4207-LOT 113



It is the builder's complete responsibility to ensure that all plans submitted for approval fully comply with the Architectural Guidelines and all applicable regulations and requirements including zoning provisions and any provisions in the subdivision agreement. The Control Architect is not responsible in any way for examining or approving site (lotting) plans or working drawings with respect to any zoning or building code or permit matter or that any house can be properly built or located on its lot. ELEVATION: REAR UPG. EL. A (REV) UNIT NUMBER: 4207-LOT 113

This is to certify that these plans comply with the applicable Architectural Design Guidelines approved by the City of VAUGHAN.

LOTS 112 & 113 JOHN G. WILLIAMS LTD., ARCHITECT MAY 05, 2020

ROSSHAVEN CRESCENT

BRICK/ STONE VENEER ON SIDES OF STAIRS (POURED OR BRICK LEDGE PRECAST)

DROP OR RAISE BANDING BY AMOUNT INDICATED.

ADD BANDING AND/OR TRIM AS INDICATED.

4 ADDED CAMBERED HEADERS

5 8'-0" X 8'-0" GARAGE DOORS.



www.huntdesign.ca

LOTNUMBER: 113
UNIT NAME: MODEL

GOLDPARK HOMES - 217020 PINE VALLEY, VAUGHAN ONT.

8966 Woodbine Ave, Markham, ON L3R 0J7 T 7905.737.5133 F 905.737.7326 2020/05/04

LOTS 112-113

6 DROPPED OR RAISED SOFFIT AS INDICATED.

ADJUSTED ROOF OVERHANG
AS INDICATED ON ROOF PLAN.

PROVIDE GUARD PER CONSTRUCTION NOTE 11.

9 FOYER SUNKEN AS INDICATED

LIGHT FIXTURE RELOCATED
AS INDICATED.

217020WSS01