

Invoice Qty. Description

Invoice	Qty.	Description

ELECTRICAL

Invoice Qty. Description

Invoice	Qty.	Description
2294 32418 20Apr20 **	4	BASEMENT WINDOWS - UPGRADE BASEMENT WINDOW SIZE TO 30 " X 24" - 8" FRAME

2324 33013 06May20 NoCat	1	DINING ROOM: DELETE STANDARD CEILING LIGHT
-----------------------------------	---	--

ELECTRICAL

Invoice Qty. Description

2324 33005 06May20	1	KITCHEN: 110V WALL RECEPTACLE ON SEPARATE CIRCUIT - GAS FIRED RANGE - FOR AUX. EQUIPMENT - NOT A STOVE PLUG
--------------------------	---	---

ELECTRICAL

Invoice Qty. Description

2324 33007 06May20	1	SIDE ELEVATION (GARAGE SIDE): IN ADDITION TO STANDARD HOLIDAY GFI, ADD AN ADDITIONAL ON GARAGE SIDE OF HOUSE. LOCATED APPROX 18" FROM FRONT CORNER. ADDITIONAL EXTERIOR GFI RECEPTACLE WITH COVER AND SWITCH FOR HOLIDAY LIGHTS
--------------------------	---	---

ELECTRICAL

Invoice Qty. Description

2324 33001 06May20	1	GREAT ROOM: INTERIOR WALL OUTLET: ADDITIONAL 110V WALL INTERIOR RECEPTACLE ON EXISTING CIRCUIT FOR WALL MOUNTED TV - LOCATE APPROX. 66" A.F.F. ABOVE FIREPLACE.
--------------------------	---	---

ELECTRICAL

Invoice Qty. Description

2324 33012 06May20	6	DINING ROOM: 4" E/S LED INTERIOR POT LIGHT - GROUND FLOOR - EACH INCLUDED IN APS
--------------------------	---	---

Invoice Qty. Description

Invoice	Qty.	Description

FORMING

Invoice	Qty.	Description
2294 32417 20Apr20	1	PINE VALLEY MODEL 40.02 VALLEYVIEW ELEV A - 9 FOOT BASEMENT CEILING HEIGHT IN LIEU OF STANDARD 8 FOOT CEILING.

HVAC

Invoice	Qty.	Description
2324 33004 06May20	1	KITCHEN: GAS LINE ROUGH-IN - MAIN FLOOR FOR GAS RANGE - SEE PLAN FOR LOCATION

Invoice	Qty.	Description
		WT WINDOW SIZE TO 30 " X 24" - 8" FRAME

NETWORK AND WIRING

Invoice	Qty.	Description
2324 32999 06May20	1	GREAT ROOM / DINING ROOM / MASTER BEDROOM / BEDROOM 4: ADDITIONAL CAT6 ETHERNET OUTLET - EACH SEE PLAN FOR LOCATION PACKAGE PRICE
2324 33000 06May20	1	GREAT ROOM CONDUIT PIPE - FOR WALL MOUNT TV - LOCATE APPROX. 66" A.F.F. ABOVE FIREPLACE, THRU TO BASEMENT & TERMINATING AT CABLE - SEE PLAN FOR LOCATION
2324 33002 06May20	1	CONDUIT PIPE - FROM ATTIC TO BASEMENT - FROM BASEMENT AT ELECTRICAL PANET TO APPROX CENTER OF ATTIC
2324 33003 06May20	1	KITCHEN: INSTALL VAC PAN UNDER KITCHEN SINK
2324 33014 06May20 NoCat	1	**NOTE** LOCATE STANDARD PHONE IN DINING ROOM INSTEAD OF KITCHEN

Invoice	Qty.	Description

Invoice Qty. Description

Invoice	Qty.	Description

PLUMBING

Invoice Qty. Description

Invoice	Qty.	Description
2324 33011 06May20 NoCat	1	MASTER ENSUITE: UPGRADE SHOWER FAUCET TO MOEN '90" POSI-TEMP RAIN SHOWER (from ceiling) + HAND SHOWER WITH SLIDE BAR - CHROME #TS2712EP/3372/TS4172/62320/S3879EP/A721

ROUGH CARPENTRY

Invoice Qty. Description

Invoice	Qty.	Description
2294 32418 20Apr20 **	4	BASEMENT WINDOWS - UPGRADE BASEMENT WINDOW SIZE TO 30 " X 24" - 8" FRAME

WINDOWS - BASEMENT

Invoice Qty. Description

Invoice	Qty.	Description
2294 32418 20Apr20	4	BASEMENT WINDOWS - UPGRADE BASEMENT WINDOW SIZE TO 30 " X 24" - 8" FRAME
2294 32418 20Apr20	4	BASEMENT WINDOWS - UPGRADE BASEMENT WINDOW SIZE TO 30 " X 24" - 8" FRAME


SCHEDULE 'F'



TV-147
MAY 1 2020 *see attach*

The Valleyview
40' SERIES

Elevation A • 3,145 sq.ft.
Elevation B • 3,170 sq.ft.

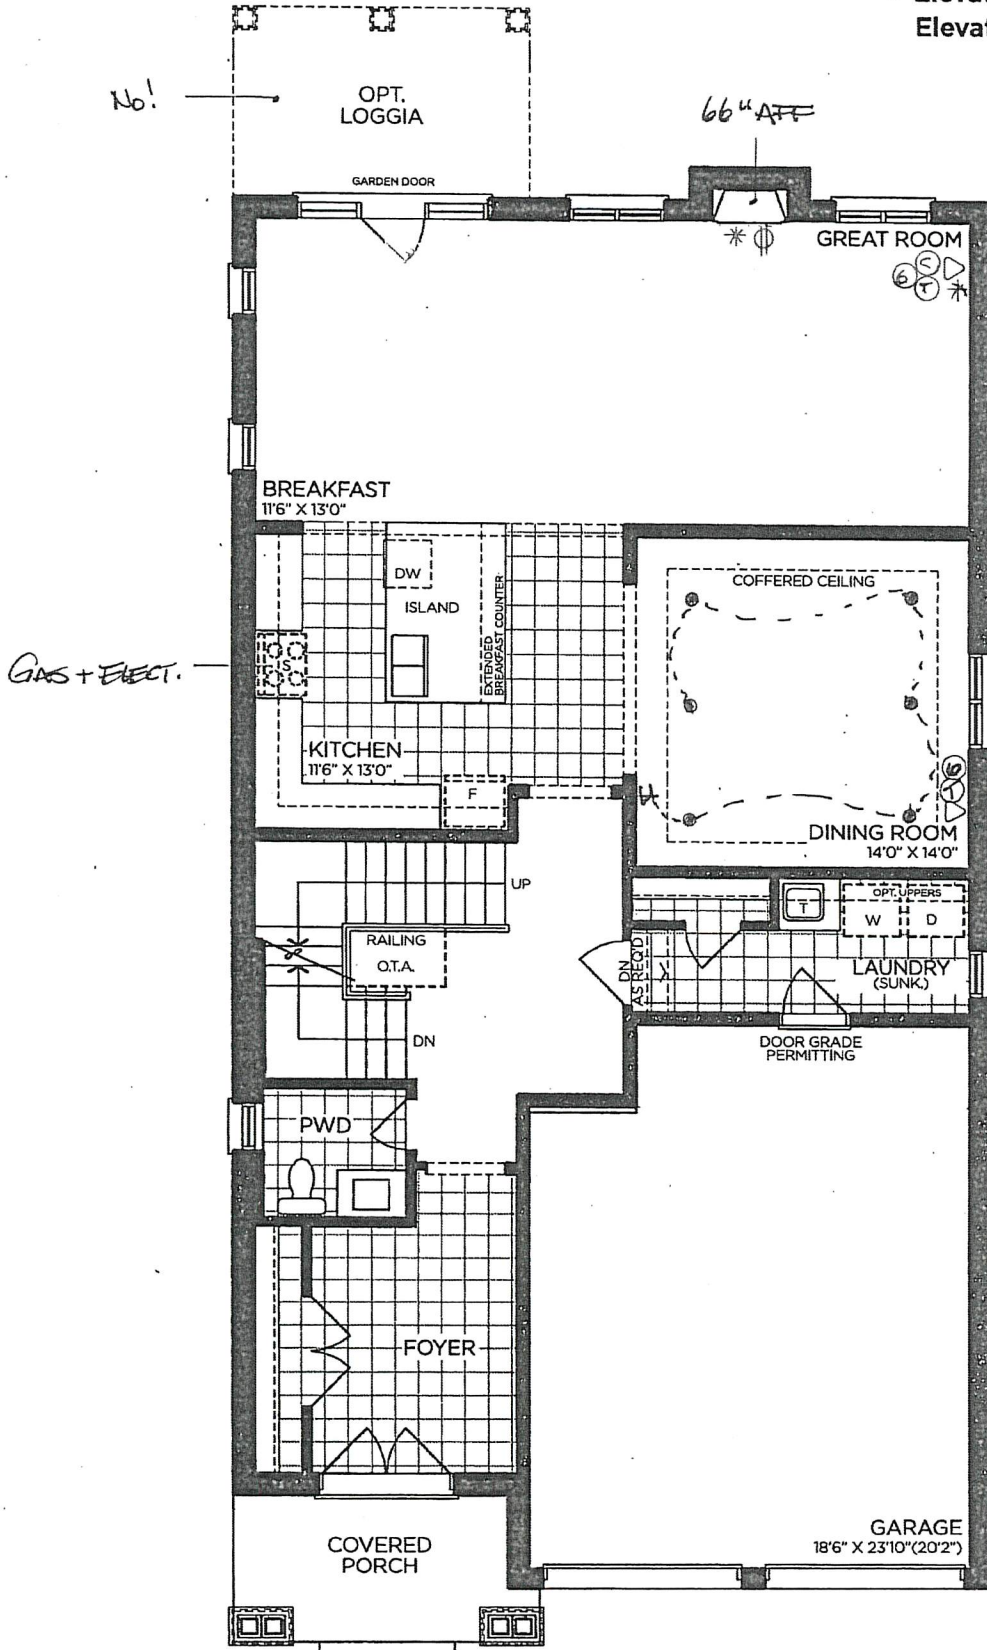

GROUND FLOOR | ELEV. A

VENDOR

PURCHASER

PURCHASER

GOLDPARK
WORTH MORE™

Prices, figures, illustrations, sizes, features and finishes are subject to change without notice. Areas and dimensions are approximate and actual usable floor space may vary from the stated area. Layout may be reverse of the unit purchased. E. & O.E. 4002

SCHEDULE 'F'




PV-147 *see attached*
MAY 1 2020

The Valleyview

40' SERIES

Elevation A • 3,145 sq.ft.
Elevation B • 3,170 sq.ft.

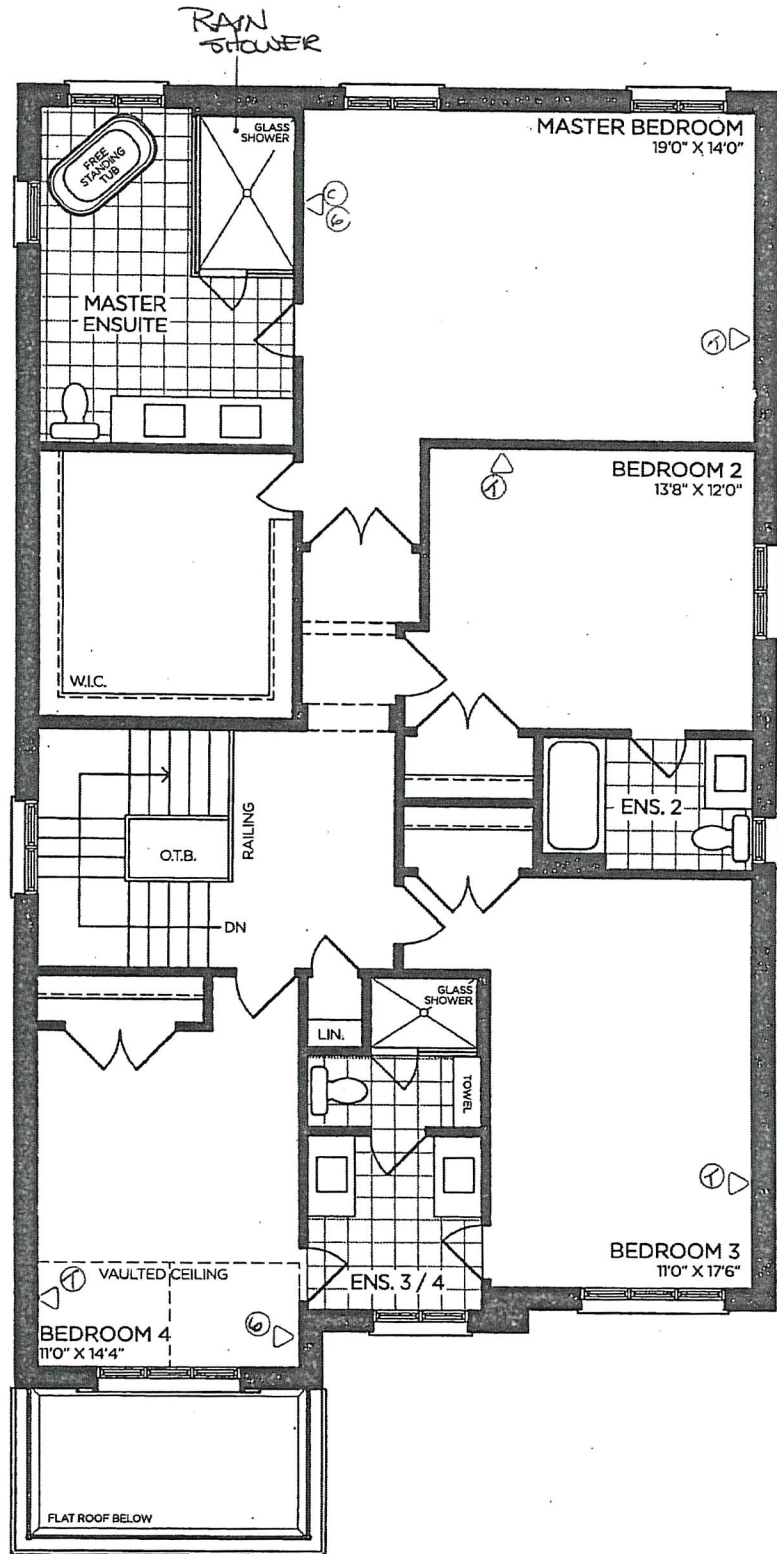

SECOND FLOOR | ELEV. A

VENDOR

PURCHASER

PURCHASER

GOLDPARK
WORTH MORE™

Prices, figures, illustrations, sizes, features and finishes are subject to change without notice. Areas and dimensions are approximate and actual usable floor space may vary from the stated area. Layout may be reverse of the unit purchased. E. & O.E. 4002

SCHEDULE 'F'




PV-147 *see sketch*
MAY 1 2020

The Valleyview

40' SERIES

→ Elevation A • 3,145 sq.ft.
Elevation B • 3,170 sq.ft.

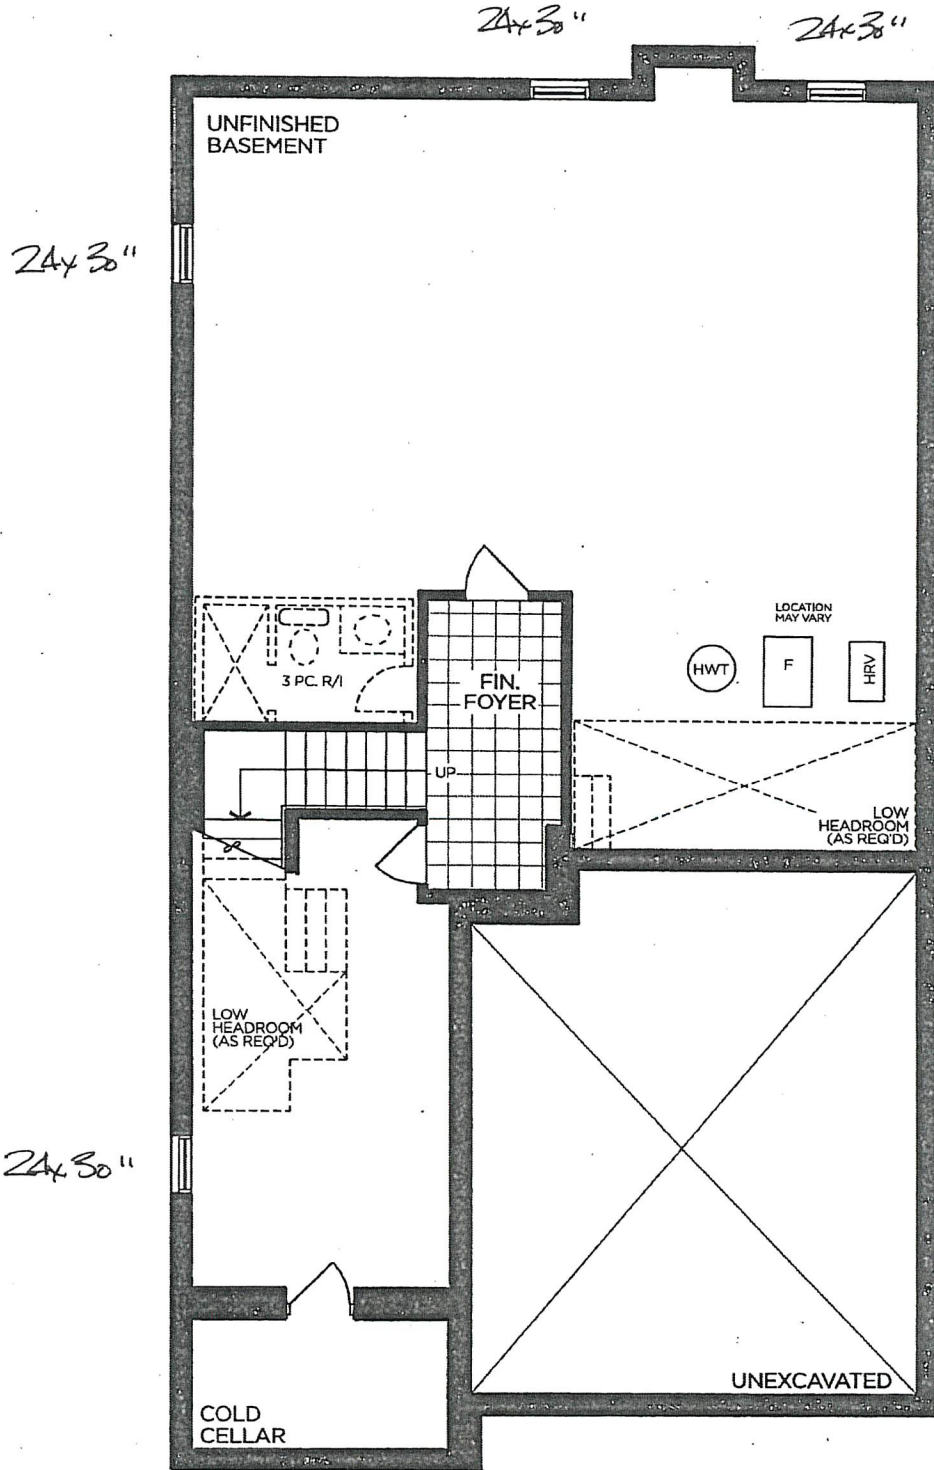

BASEMENT | ELEV. A

VENDOR

PURCHASER

PURCHASER

GOLDPARK
WORTH MORE™

Prices, figures, illustrations, sizes, features and finishes are subject to change without notice. Areas and dimensions are approximate and actual usable floor space may vary from the stated area. Layout may be reverse of the unit purchased. E. & O.E. 4002







PINE VALLEY

FOREVERGREEN

PLUMBING UPGRADES

POSI-TEMP SHOWER ONLY* W/ 3 FUNCTION TRANSFER VALVE/TRIM AND SLIDE BAR WITH HAND SHOWER

MOEN - 90 DEGREE

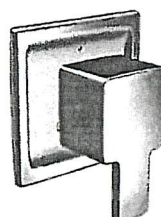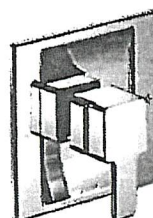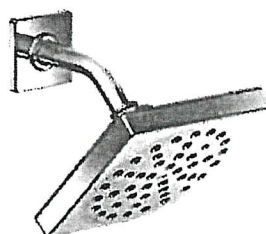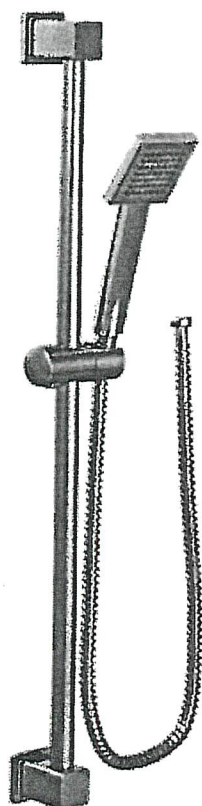

CHROME

from WALL

BRUSHED NICKEL

from CEILING

MATTE BLACK - N/A

MODEL TS2712EP / 3372 / TS4172 / 62320 / S3879EP / A721

Lot#
147

Room:
MASTER ENSUITE

Signature:
[Handwritten Signature]

Date:
MAY 1 2020

Signature:
[Handwritten Signature]

SCHEDULE 'F'




PV-147
MAY 1 2020

(m) (m)

The Valleyview

40' SERIES

Elevation A • 3,145 sq.ft.
Elevation B • 3,170 sq.ft.

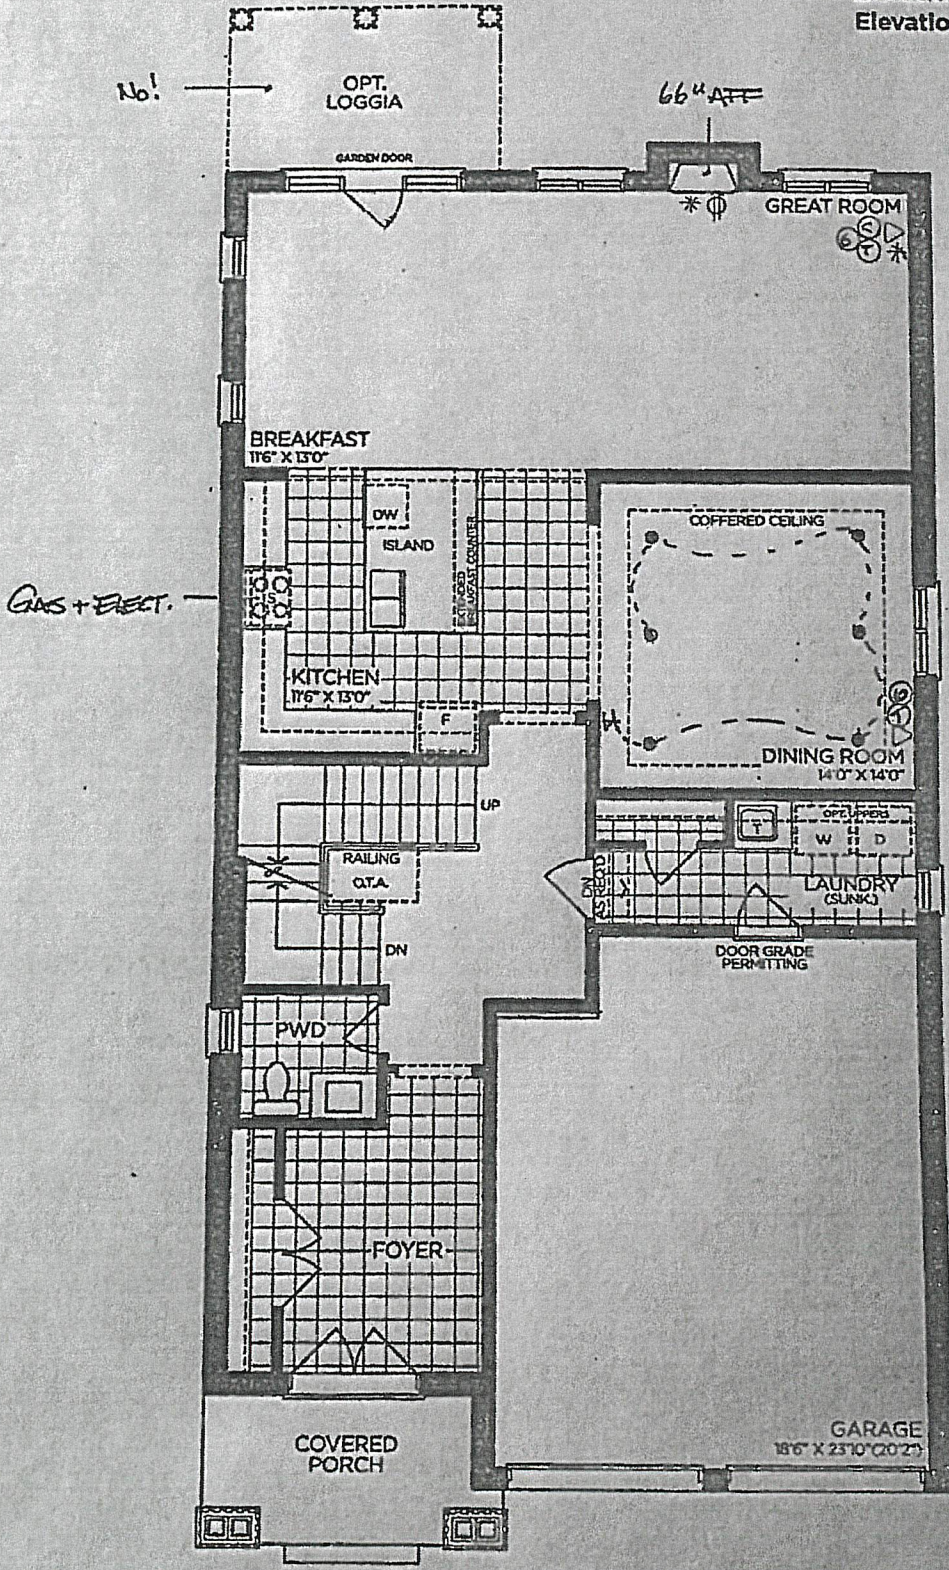

GROUND FLOOR | ELEV. A

VENDOR

PURCHASER

PURCHASER

GOLDPARK
WORTH MORE™

Prices, figures, illustrations, sizes, features and finishes are subject to change without notice. Areas and dimensions are approximate and actual usable floor space may vary from the stated area. Layout may be reverse of the unit purchased. E. & O.E. 4002

SCHEDULE 'F'




PV-147 (MD) (MD)
MAY 1 2020

The Valleyview

40' SERIES

Elevation A • 3,145 sq.ft.
Elevation B • 3,170 sq.ft.

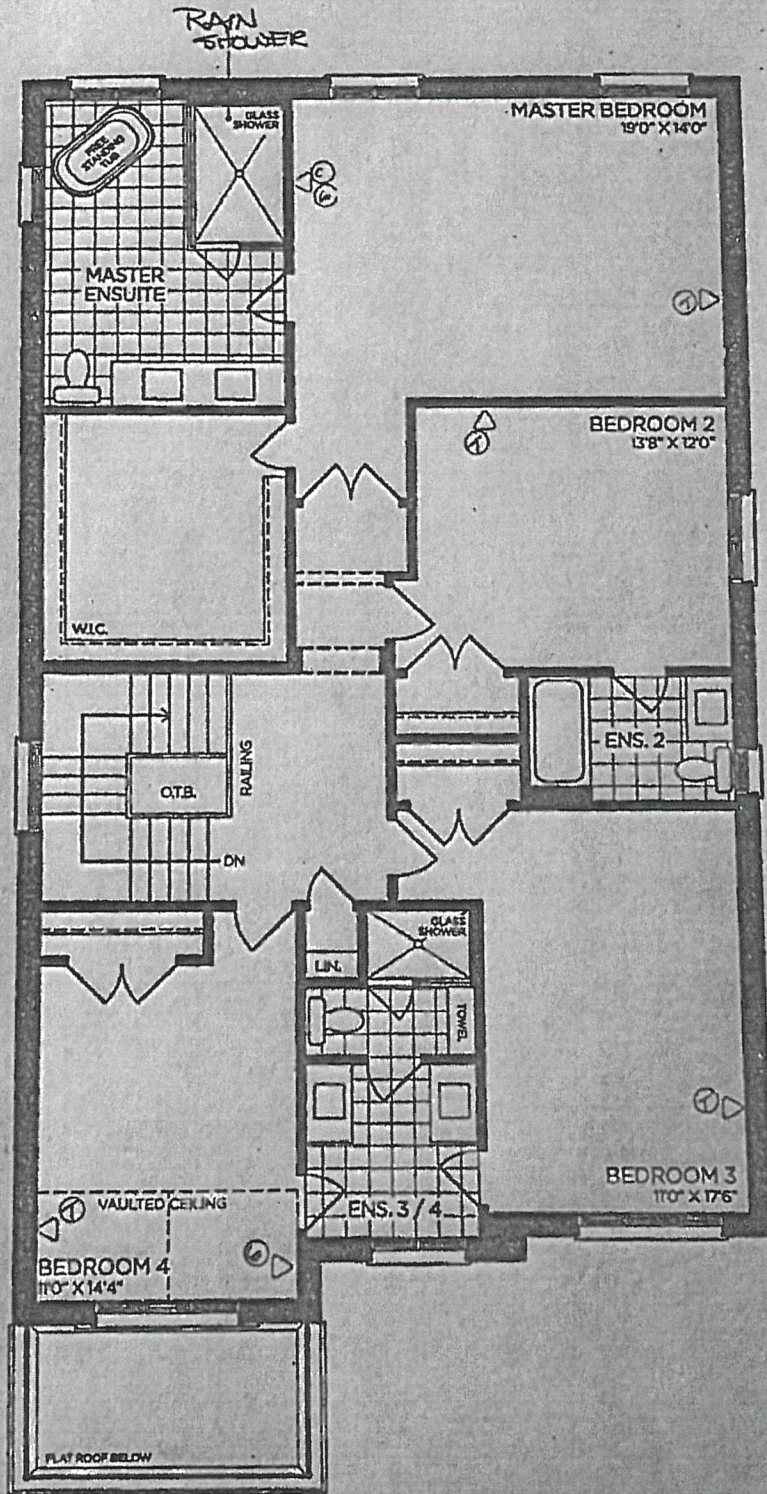

SECOND FLOOR | ELEV. A

VENDOR

PURCHASER

PURCHASER

GOLDPARK
WORTH MORE™

Prices, figures, illustrations, sizes, features and finishes are subject to change without notice. Areas and dimensions are approximate and actual usable floor space may vary from the stated area. Layout may be reverse of the unit purchased. E. & O.E. 4002

SCHEDULE 'F'




PV-147 (MA) (MA)
MAY 1 2020

The Valleyview

40' SERIES

→ Elevation A • 3,145 sq.ft.
Elevation B • 3,170 sq.ft.

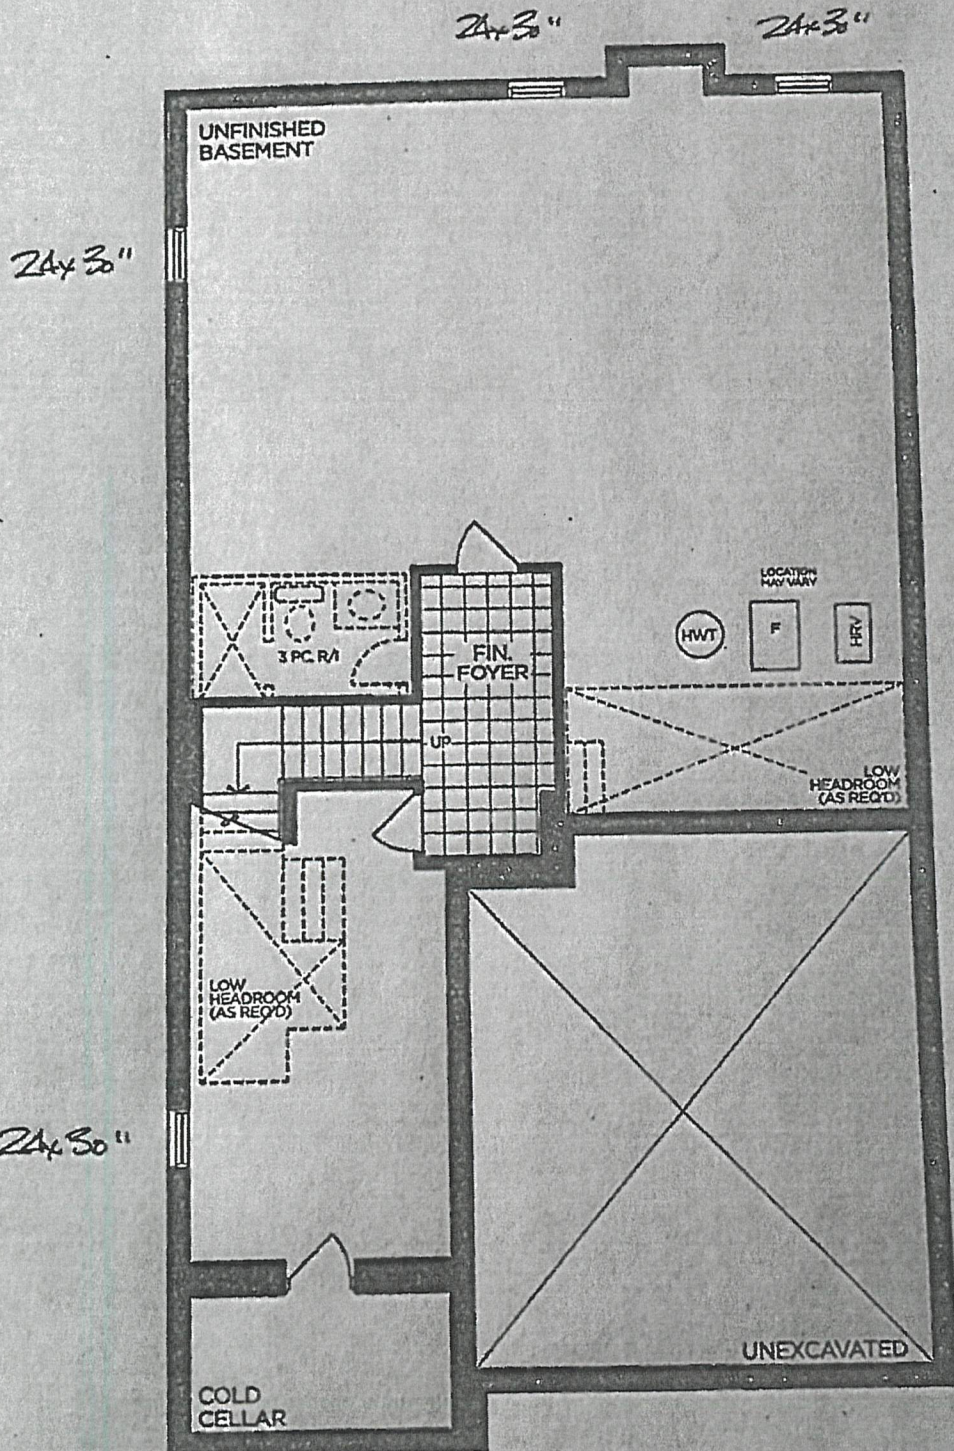

BASEMENT | ELEV. A

VENDOR

PURCHASER

PURCHASER

GOLDPARK




WORTH MORE™

Prices, figures, illustrations, sizes, features and finishes are subject to change without notice. Areas and dimensions are approximate and actual usable floor space may vary from the stated area. Layout may be reverse of the unit purchased. E. & O.E. 4002

PLUMBING UPGRADES

POSI-TEMP SHOWER ONLY* W/ 3 FUNCTION TRANSFER
VALVE/TRIM AND SLIDE BAR WITH HAND SHOWER

MOEN - 90 DEGREE

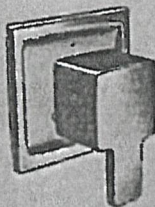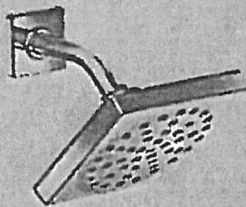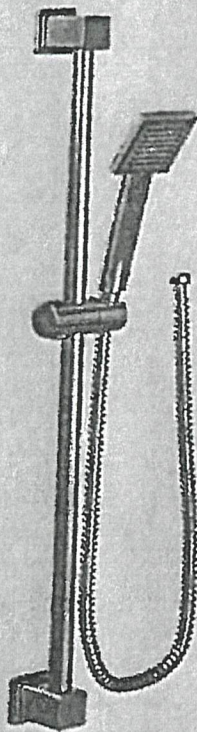

CHROME

from WALL

BRUSHED NICKEL

from CEILING

MATTE BLACK - N/A

MODEL TS2712EP / 3372 / TS4172 / 62320 / S3879EP / A721

Lot#
147

Room:
MASTER ENSUITE

Signature:
M. DiGiacola

Date:
MAY 1 2020

Signature:
M. DiGiacola