



CONSTRUCTION SUMMARY

Lot: 121
Model: 40.01 B SUMMERDALE
Project/Phase: Pine Valley Forevergreen / 1

CENTRAL VAC AND WIRING

Invoice	Qty.	Description
2298 32646 13May20 **	1	INSTALL VAC PAN UNDER KITCHEN SINK

CERAMIC

Invoice	Qty.	Description
2298 33465 13May20 NoCat	1	KITCHEN: RELOCATE KITCHEN APPLIANCE FROM STANDARD LOCATION - APPROX. "NEW" LOCATION AS PER ATTACHED DRAWINGS NOTE: FRIDGE AND RANGE MOVING TO KITCHEN/DINING ROOM WALL

DRYWALL

Invoice	Qty.	Description
2298 32646 13May20 **	1	INSTALL VAC PAN UNDER KITCHEN SINK

ELECTRICAL

Invoice	Qty.	Description
2298 32649 13May20	2	KITCHEN: RELOCATE KITCHEN APPLIANCE FROM STANDARD LOCATION - APPROX. "NEW" LOCATION AS PER ATTACHED DRAWINGS SINK AND DISHWASHER FROM ISLAND TO PERIMETER (AT WINDOW)
2298 32650 13May20	2	KITCHEN: RELOCATE KITCHEN APPLIANCE FROM STANDARD LOCATION - APPROX. "NEW" LOCATION AS PER ATTACHED DRAWINGS NOTE: FRIDGE AND RANGE MOVING TO KITCHEN/DINING ROOM WALL
2298 32657 13May20	1	KITCHEN: 110V WALL RECEPTACLE ON SEPARATE CIRCUIT - FOR FUTURE WINE FRIDGE (APPLIANCE NOT INCLUDED)
2298 33428 13May20	1	KITCHEN ISLAND: 110V WALL RECEPTACLE ON SEPARATE CIRCUIT - FOR MICROWAVE - MICROWAVE NOT INCLUDED

ELECTRICAL

Invoice	Qty.	Description
2298 32656 13May20	6	KITCHEN: 4" E/S LED INTERIOR POT LIGHT - GROUND FLOOR - EACH INCLUDED IN APS



CONSTRUCTION SUMMARY

Lot: 121
Model: 40.01 B SUMMERDALE
Project/Phase: Pine Valley Forevergreen / 1

ELECTRICAL

Invoice	Qty.	Description
2298 32654 13May20	3	KITCHEN: APPROX CENTERED ABOVE ISLAND - ROUGH-IN FOR CAPPED CEILING OUTLET (FUTURE LIGHT FIXTURE) - EACH
2298 32668 13May20	1	MASTER ENSUITE: ROUGH-IN FOR CAPPED CEILING OUTLET (FUTURE LIGHT FIXTURE) - EACH LOCATE APPROX. CENTER ABOVE TUB

ELECTRICAL

Invoice	Qty.	Description
2298 32655 13May20	1	KITCHEN: ADDITIONAL INTERIOR SWITCH FOR R/IN LIGHTS ABOVE ISLAND

FORMING

Invoice	Qty.	Description
2218 31414 17Mar20	1	PINE VALLEY MODEL 40.01 SUMMERDALE ELEV A OR B - 9 FOOT BASEMENT CEILING HEIGHT IN LIEU OF STANDARD 8 FOOT CEILING.

FRAMING

Invoice	Qty.	Description
2298 32647 13May20 NoCat	1	***CUSTOM LAYOUT***DELETE ARCHWAY BETWEEN DINING/KITCHEN, EXTEND STANDARD CABINETRY/COUNTER TOP **ADD** WINDOW AT NEW SINK LOCATION

GRANITE MARBLE QUARTZ

Invoice	Qty.	Description
2298 33457 13May20 NoCat	1	***CUSTOM LAYOUT***DELETE ARCHWAY BETWEEN DINING/KITCHEN, EXTEND STANDARD CABINETRY/COUNTER TOP **ADD** WINDOW AT NEW SINK LOCATION
2298 33461 13May20 NoCat	1	KITCHEN: RELOCATE KITCHEN APPLIANCE FROM STANDARD LOCATION - APPROX. "NEW" LOCATION AS PER ATTACHED DRAWINGS NOTE: FRIDGE AND RANGE MOVING TO KITCHEN/DINING ROOM WALL

HVAC

Invoice	Qty.	Description
2298 33464 13May20 NoCat	1	KITCHEN: RELOCATE KITCHEN APPLIANCE FROM STANDARD LOCATION - APPROX. "NEW" LOCATION AS PER ATTACHED DRAWINGS NOTE: FRIDGE AND RANGE MOVING TO KITCHEN/DINING ROOM WALL



CONSTRUCTION SUMMARY

Lot: 121
Model: 40.01 B SUMMERDALE
Project/Phase: Pine Valley Forevergreen / 1

INTERIOR TRIM AND DOORS

Invoice	Qty.	Description
2298 33460 13May20 NoCat	1	***CUSTOM LAYOUT***DELETE ARCHWAY BETWEEN DINING/KITCHEN, EXTEND STANDARD CABINETRY/COUNTER TOP **ADD** WINDOW AT NEW SINK LOCATION

KITCHEN AND BATH CABINETRY

Invoice	Qty.	Description
2298 32646 13May20 **	1	INSTALL VAC PAN UNDER KITCHEN SINK
2298 33456 13May20 NoCat	1	***CUSTOM LAYOUT***DELETE ARCHWAY BETWEEN DINING/KITCHEN, EXTEND STANDARD CABINETRY/COUNTER TOP **ADD** WINDOW AT NEW SINK LOCATION
2298 33462 13May20 NoCat	1	KITCHEN: RELOCATE KITCHEN APPLIANCE FROM STANDARD LOCATION - APPROX. "NEW" LOCATION AS PER ATTACHED DRAWINGS NOTE: FRIDGE AND RANGE MOVING TO KITCHEN/DINING ROOM WALL

MODEL OPTIONS 40.01

Invoice	Qty.	Description
2298 33285 13May20	1	STUDY - OPT. 8 FOOT HIGH DOUBLE FRENCH DOORS WITH FLAT CLEAR GLASS COMPLETE WITH BUILDERS STANDARD OFFERING

NETWORK AND WIRING

Invoice	Qty.	Description
2298 32646 13May20	1	INSTALL VAC PAN UNDER KITCHEN SINK
2298 32661 13May20	1	LAUNDRY: ROUGH - IN FOR EXTRA SECURITY KEY PAD

NETWORKING/WIRING

Invoice	Qty.	Description
2298 32646 13May20 **	1	INSTALL VAC PAN UNDER KITCHEN SINK

PAINTING

Invoice	Qty.	Description
2298 33285 13May20 **	1	STUDY - OPT. 8 FOOT HIGH DOUBLE FRENCH DOORS WITH FLAT CLEAR GLASS COMPLETE WITH BUILDERS STANDARD OFFERING



CONSTRUCTION SUMMARY

Lot: 121
Model: 40.01 B SUMMERDALE
Project/Phase: Pine Valley Forevergreen / 1

PLUMBING

Invoice	Qty.	Description
2298 33459 13May20 NoCat	1	***CUSTOM LAYOUT***DELETE ARCHWAY BETWEEN DINING/KITCHEN, EXTEND STANDARD CABINETRY/COUNTER TOP **ADD** WINDOW AT NEW SINK LOCATION
2298 33463 13May20 NoCat	1	KITCHEN: RELOCATE KITCHEN APPLIANCE FROM STANDARD LOCATION - APPROX. "NEW" LOCATION AS PER ATTACHED DRAWINGS NOTE: FRIDGE AND RANGE MOVING TO KITCHEN/DINING ROOM WALL

PLUMBING FIXTURES

Invoice	Qty.	Description
2298 32670 13May20 NoCat	1	MASTER ENSUITE: UPRADE TO MOEN '90*" POSI-TEMP 3-FUNCTION RAIN SHOWER (from ceiling) + HAND SHOWER WITH SLIDE BAR CHROME #TS2712EP/3372/TS4172/62320/33879EP/A721

TRIM. MOULDING

Invoice	Qty.	Description
2298 33285 13May20 **	1	STUDY - OPT. 8 FOOT HIGH DOUBLE FRENCH DOORS WITH FLAT CLEAR GLASS COMPLETE WITH BUILDERS STANDARD OFFERING

WINDOWS AND DOORS

Invoice	Qty.	Description
2298 33458 13May20 NoCat	1	***CUSTOM LAYOUT***DELETE ARCHWAY BETWEEN DINING/KITCHEN, EXTEND STANDARD CABINETRY/COUNTER TOP **ADD** WINDOW AT NEW SINK LOCATION

SCHEDULE 'F'




PV-121
MAY 12 2020

See attached

The
Summerdale
40' SERIES

Elevation A • 2,895 sq.ft.

→ Elevation B • 2,880 sq.ft.

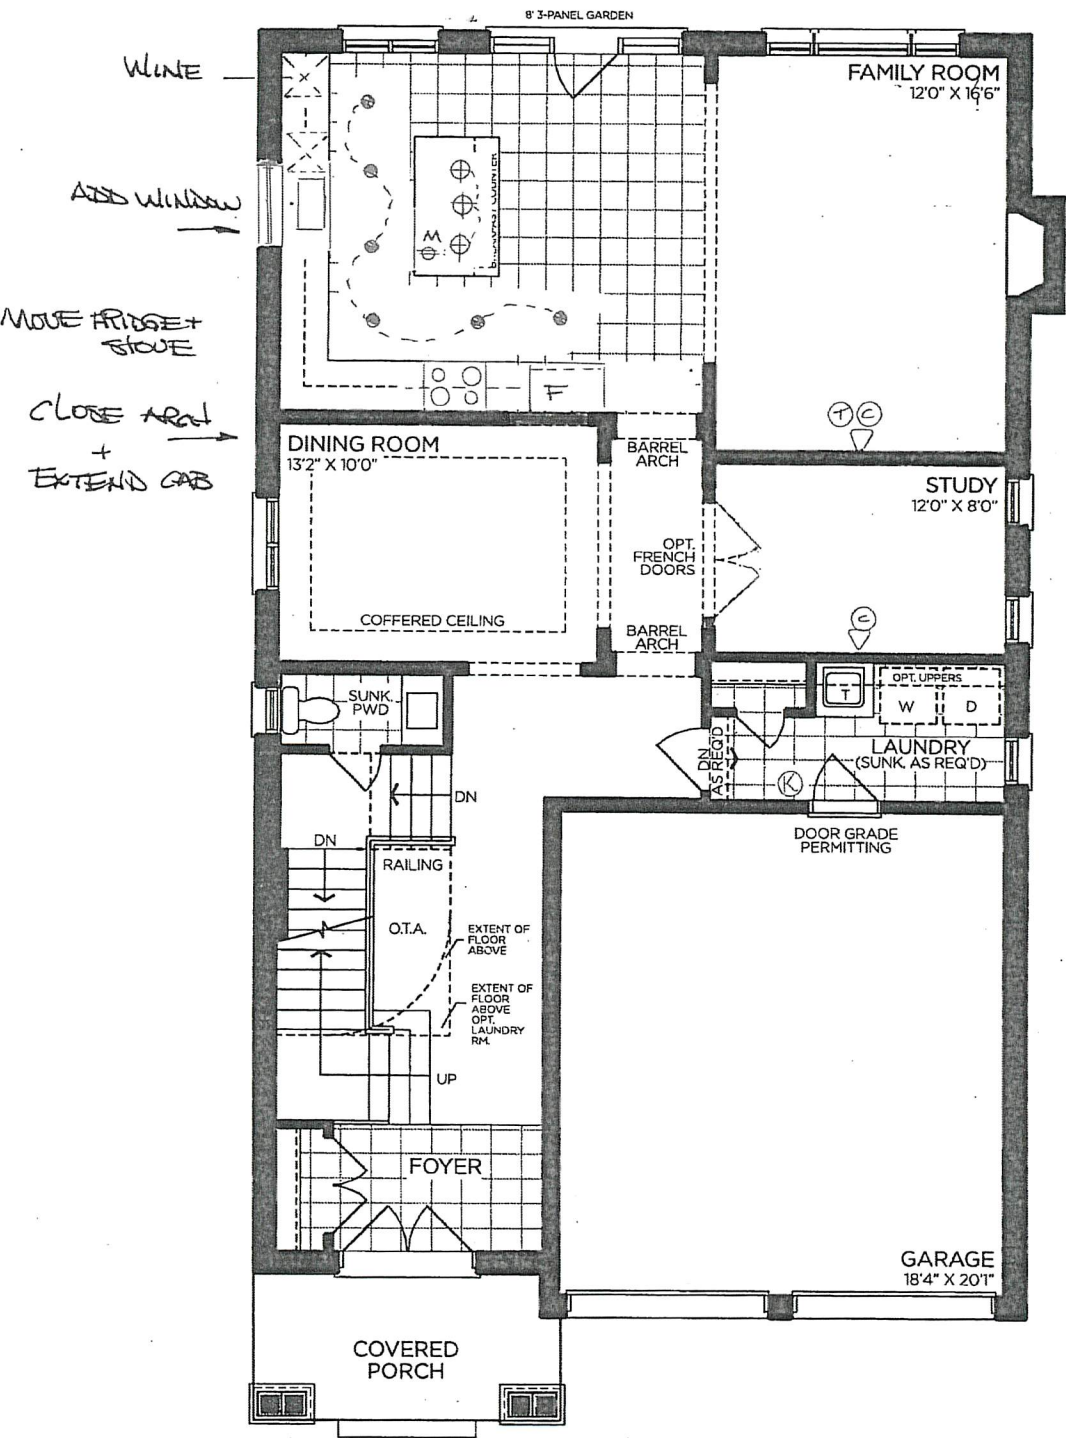

GROUND FLOOR | ELEV. A

VENDOR

PURCHASER

PURCHASER

GOLDPARK
WORTH MORE™

Prices, figures, illustrations, sizes, features and finishes are subject to change without notice. Areas and dimensions are approximate and actual usable floor space may vary from the stated area. Layout may be reverse of the unit purchased. E. & O.E. 4001

SCHEDULE 'F'




see attached
PV-121
MAY 12 2020

The Summerdale

40' SERIES

Elevation A • 2,895 sq.ft.

→ Elevation B • 2,880 sq.ft.

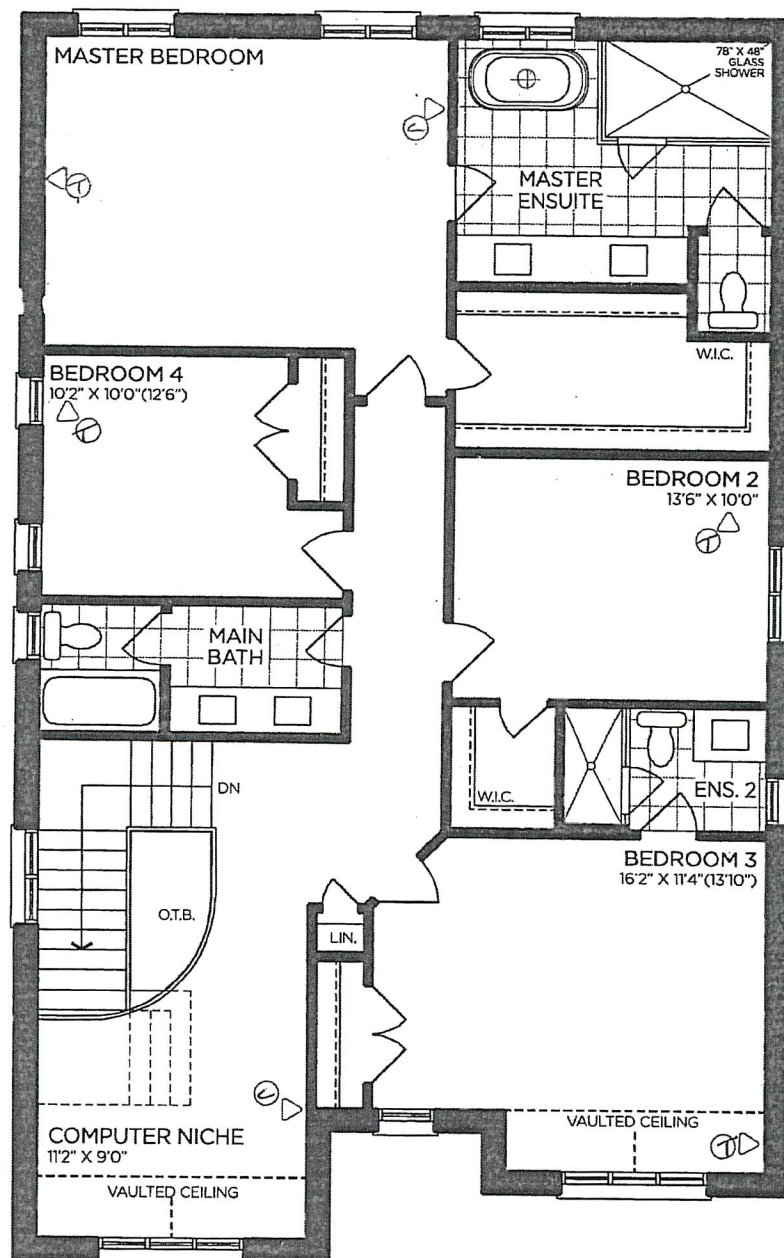

SECOND FLOOR | ELEV. A

VENDOR	<input type="text"/>
PURCHASER	<input type="text"/>
PURCHASER	<input type="text"/>

GOLDPARK

WORTH MORE™

Prices, figures, illustrations, sizes, features and finishes are subject to change without notice. Areas and dimensions are approximate and actual usable floor space may vary from the stated area. Layout may be reverse of the unit purchased. E. & O.E. 4001

SCHEDULE 'F'



PV-121
March 12 2020

MAY 12 2020

LOOK OUT BASEMENT

The Summerdale

40' SERIES


Elevation A • 2,895 sq.ft.

Elevation B • 2,880 sq.ft.

See attached

* 9' BASEMENT

STD 16x30"

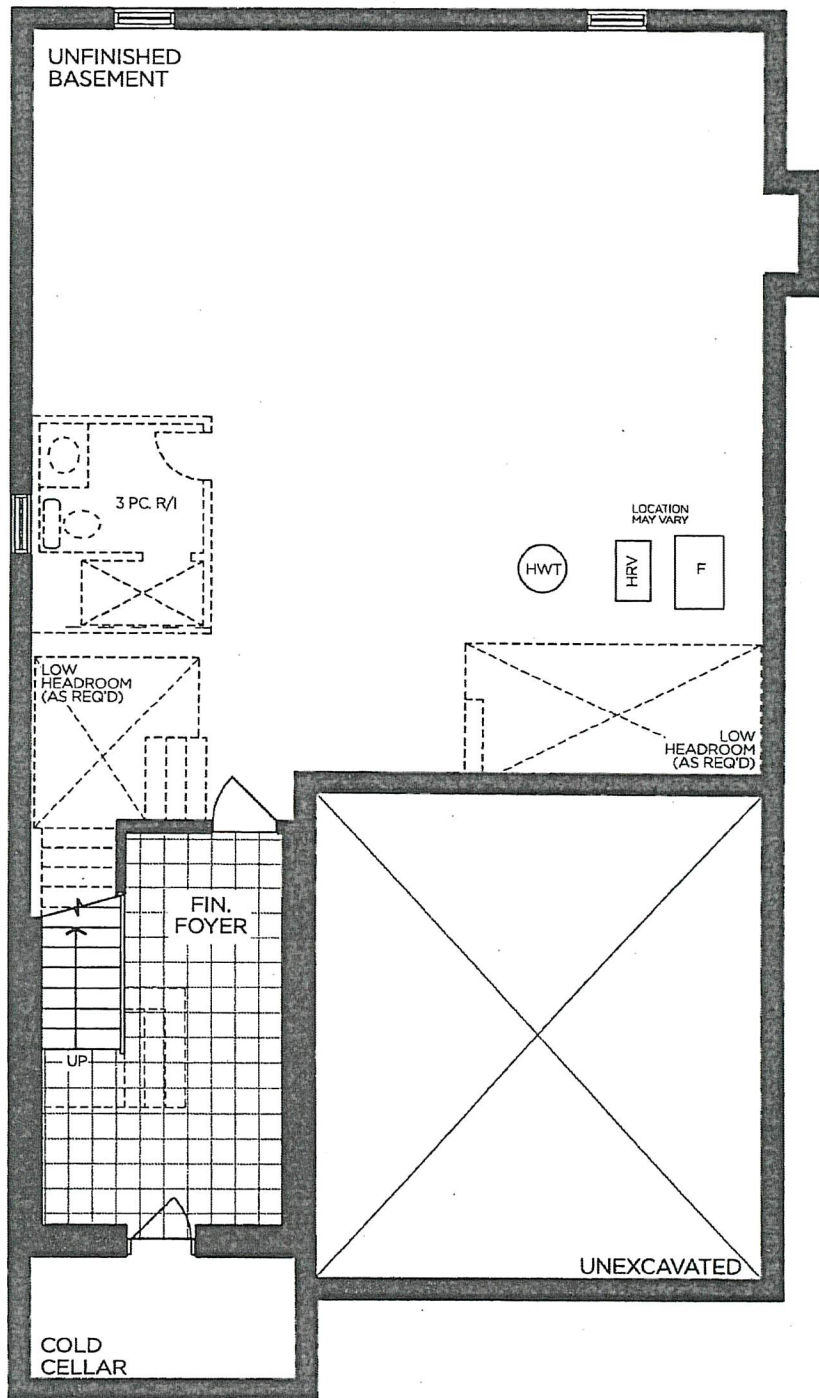

BASEMENT | ELEV. A

VENDOR	<input type="text"/>
PURCHASER	<input type="text"/>
PURCHASER	<input type="text"/>

GOLDPARK

WORTH MORE™

Prices, figures, illustrations, sizes, features and finishes are subject to change without notice. Areas and dimensions are approximate and actual usable floor space may vary from the stated area. Layout may be reverse of the unit purchased. E. & O.E. 4001

SCHEDULE 'F'




PV-121
MAY 12 2020
See attached


The
Summerdale
40' SERIES

Elevation A • 2,895 sq.ft.


→ Elevation B • 2,880 sq.ft.

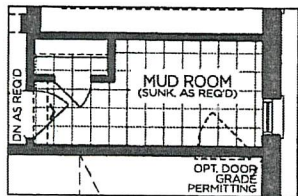


PART. GROUND FLOOR
MUDROOM FOR OPT.
SECOND FLOOR LAUNDRY

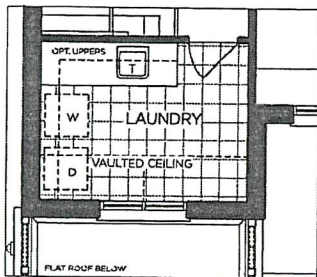


PART. SECOND FLOOR
W/ OPT. LAUNDRY
ELEV. B

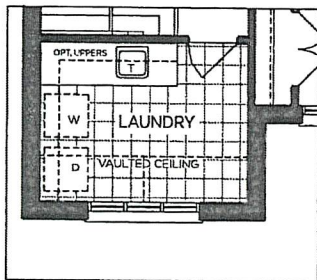


PART. SECOND FLOOR
W/ OPT. LAUNDRY
ELEV. A

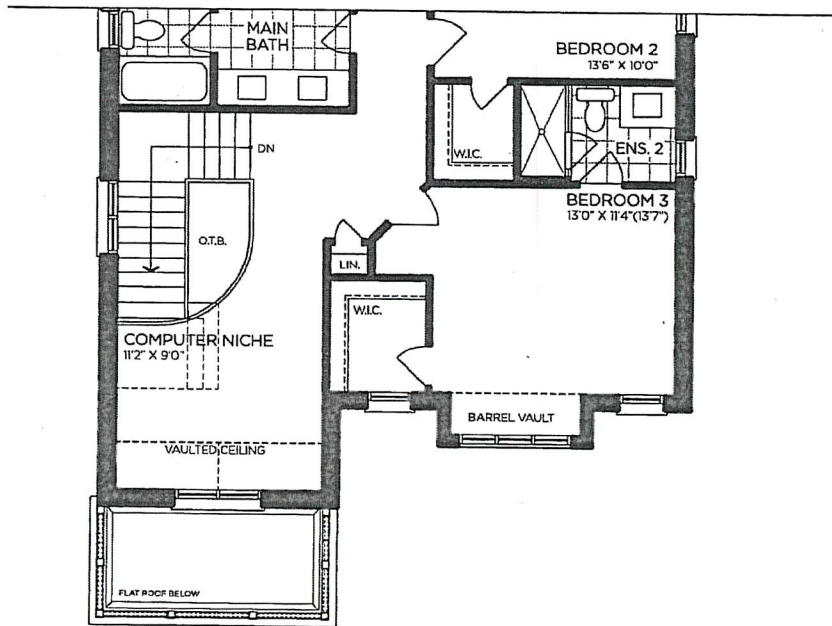

→ PART. SECOND FLOOR | ELEV. B

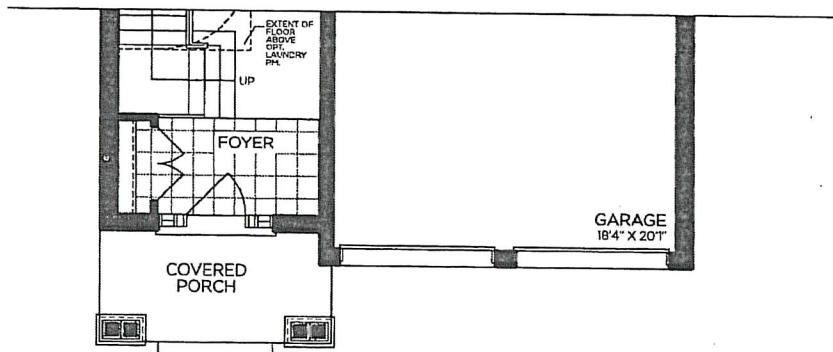

→ PART. GROUND FLOOR | ELEV. B

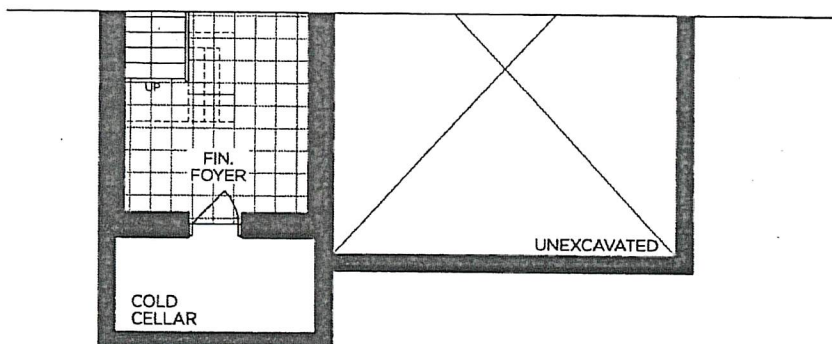

→ PART. BASEMENT | ELEV. B

VENDOR

PURCHASER

PURCHASER

GOLDPARK
WORTH MORE™



Prices, figures, illustrations, sizes, features and finishes are subject to change without notice. Areas and dimensions are approximate and actual usable floor space may vary from the stated area. Layout may be reverse of the unit purchased. E. & O.E. 4001

PLUMBING UPGRADES



POSI-TEMP SHOWER ONLY* W/ 3 FUNCTION TRANSFER VALVE/TRIM AND SLIDE BAR WITH HAND SHOWER

MOEN - 90 DEGREE

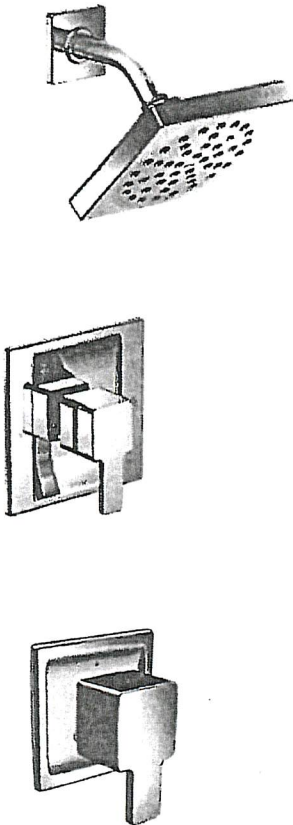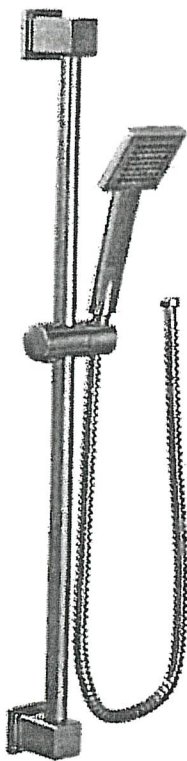

☒ CHROME

☐ BRUSHED NICKEL


☐ from WALL

☒ from CEILING


MODEL TS2712EP / 3372 / TS4172 / 62320 / S3879EP / A721

Lot#
121

Room:
MASTER ENSUITE

Signature:  See attached

Date:
MAY 12 2020


Signature:  See attached

SCHEDULE 'F'



PV-121
MAY 12 2020 MS TG

The
Summerdale
40' SERIES
Elevation A • 2,895 sq.ft.
→ Elevation B • 2,880 sq.ft.

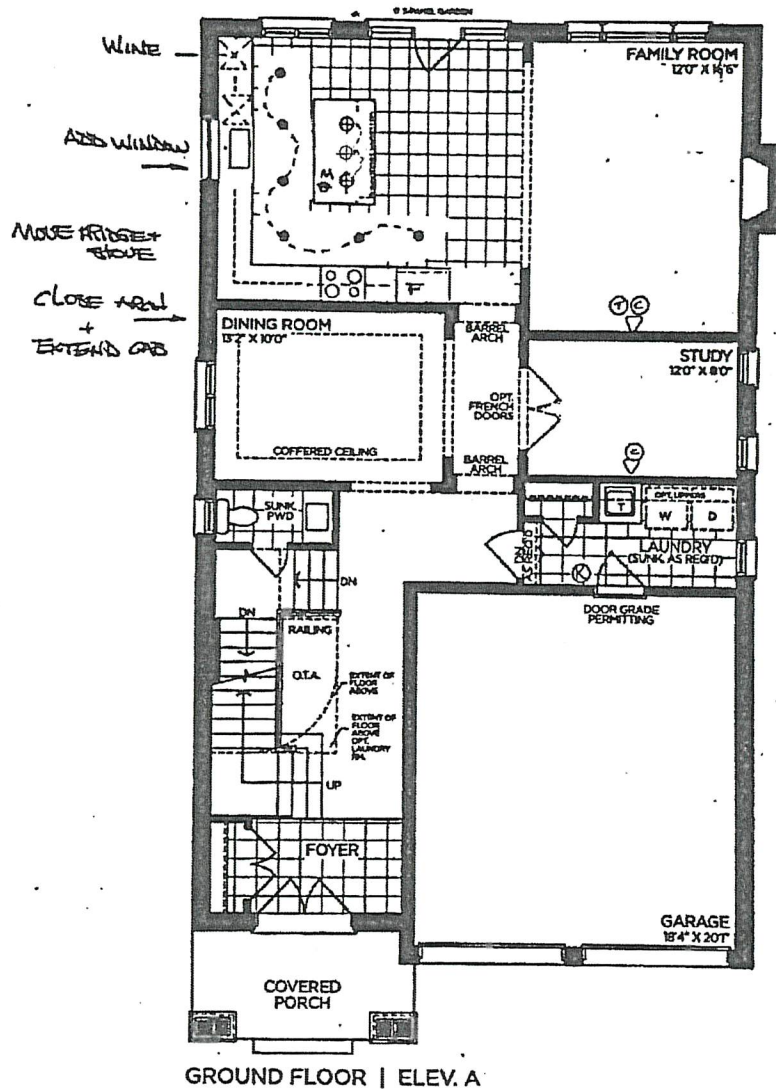

VENDOR
PURCHASER
PURCHASER

GOLDPARK
WORTH MORE™

Prices, figures, illustrations, sizes, features and finishes are subject to change without notice. Areas and dimensions are approximate and actual usable floor space may vary from the stated area. Layout may be reverse of the unit purchased. E & O.E. 4001

SCHEDULE 'F'



PV-121
MAY 12 2020


MS

TG

The Summerdale

40' SERIES

Elevation A • 2,895 sq.ft.
Elevation B • 2,880 sq.ft.

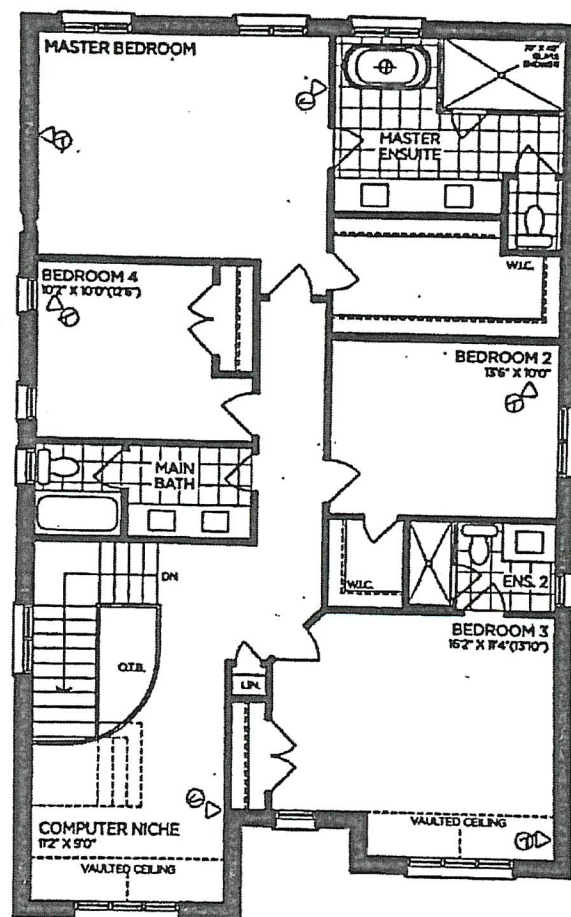

SECOND FLOOR | ELEV. A

VENDOR	
PURCHASER	TG
PURCHASER	MS

GOLDPARK
WORTH MORE

Prices, figures, illustrations, sizes, features and finishes are subject to change without notice. Areas and dimensions are approximate and actual usable floor space may vary from the stated area. Layout may be reverse of the unit purchased. E & O.E. 4001

SCHEDULE 'F'




PV-121
March 12 2020
MAY 12 2020

LOOK OUT BASEMENT

The
Summerdale
40' SERIES
Elevation A • 2,895 sq.ft.
Elevation B • 2,880 sq.ft.

* 9'
BASEMENT

STD
16x30"

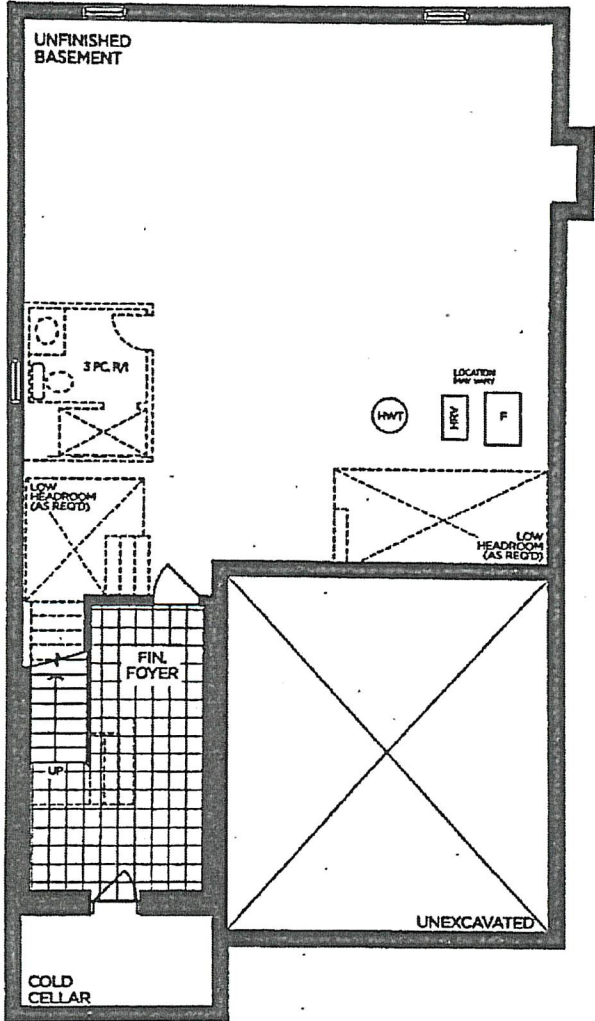

BASEMENT | ELEV. A

VENDOR	
PURCHASER	TG
PURCHASER	MS

GOLDPARK
WORTH MORE™


Prices, figures, illustrations, sizes, features and finishes are subject to change without notice. Areas and dimensions are approximate and actual usable floor space may vary from the stated area. Layout may be reverse of the unit purchased. E & O.E. 4001

SCHEDULE 'F'




PV-121 (MS)
MAY 12 2023 (TR)


The Summerdale
40' SERIES
Elevation A • 2,895 sq.ft.
Elevation B • 2,880 sq.ft.

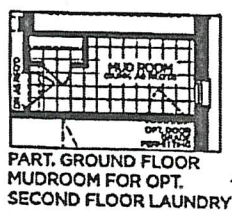


PART. GROUND FLOOR
MUDROOM FOR OPT.
SECOND FLOOR LAUNDRY

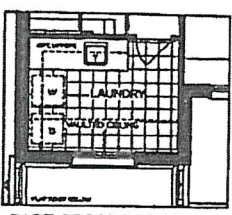


PART. SECOND FLOOR
W/ OPT. LAUNDRY
ELEV. B

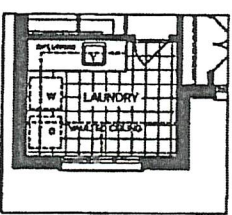


PART. SECOND FLOOR
W/ OPT. LAUNDRY
ELEV. A

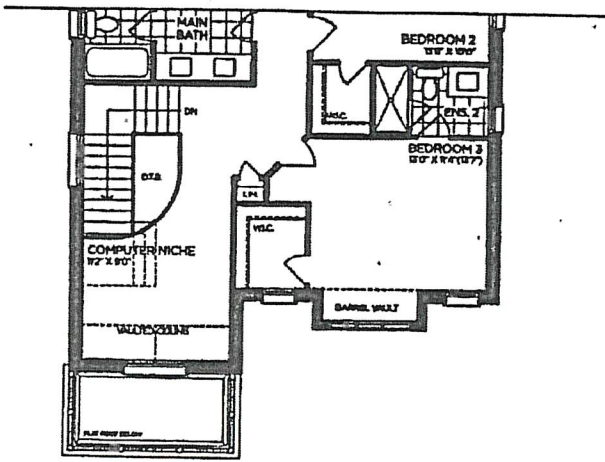

PART. SECOND FLOOR | ELEV. B

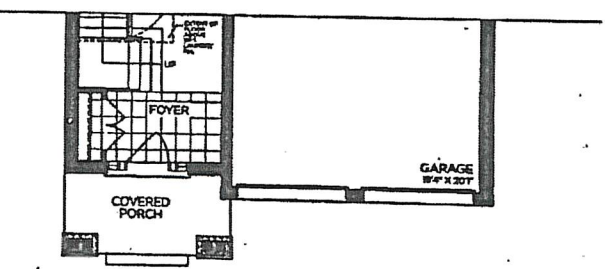

PART. GROUND FLOOR | ELEV. B

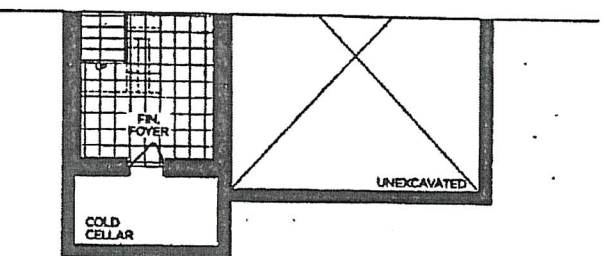

PART. BASEMENT | ELEV. B

VENDOR
PURCHASER
PURCHASER

GOLDPARK
WORTH MORE


Prices, figures, illustrations, sizes, features and finishes are subject to change without notice. Areas and dimensions are approximate and actual usable floor space may vary from the stated area. Layout may be reverse of the unit purchased. E. & C.E. 4001

PLUMBING UPGRADES



POSI-TEMP SHOWER ONLY* W/ 3 FUNCTION TRANSFER
VALVE/TRIM AND SLIDE BAR WITH HAND SHOWER

MOEN - 90 DEGREE

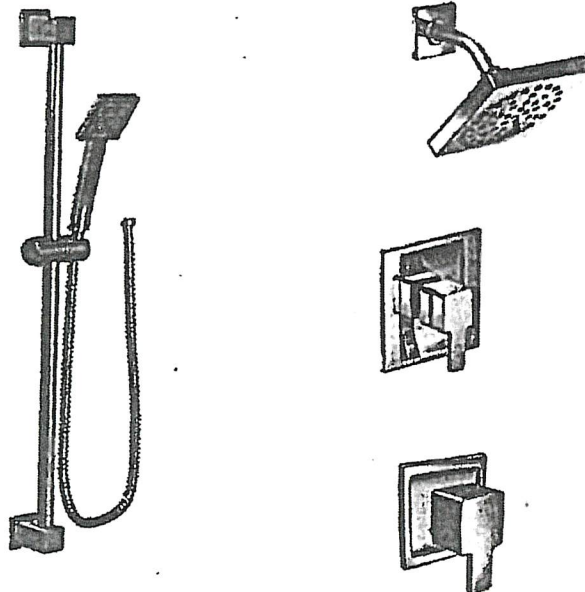

☒ CHROME

☐ from WALL

☐ BRUSHED NICKEL

☒ from CEILING

MODEL TS2712EP / 3372 / TS4172 / 62320 / S3879EP / A721

Lot#
121

Room:
MASTER ENSUITE

Signature: 

Date:
MAY 12 2020

Signature: 

GOLDPARK
SINCE 1989