



CONSTRUCTION SUMMARY

Lot: 135
Model: 40.03 B BROOKSIDE
Project/Phase: Pine Valley Forevergreen / 1

CONCRETE AND DRAIN

Invoice	Qty.	Description
2270 32024 06Apr20 NoCat	1	BACK-FLOW PREVENTER VALVE

Invoice	Qty.	Description

ELECTRICAL

Invoice	Qty.	Description
2325 33093 13May20 NoCat	1	**NOTE** PLEASE LOCATE STANDARD SWITCHES CLOSE TO CASING, IF POSSIBLE (NOT IN CENTER OF WALL)

ELECTRICAL

Invoice	Qty.	Description
2325 33091 13May20	1	GREAT ROOM: INTERIOR WALL OUTLET: ADDITIONAL 110V WALL INTERIOR RECEPTACLE ON EXISTING CIRCUIT FOR WALL MOUNTED TV - LOCATE APPROX. 66" A.F.F.
2325 33096 13May20	1	KITCHEN: FIXTURE: RELOCATE STANDARD CEILING MOUNT FIXTURE LOCATE APPROX CENTERED ABOVE ISLAND
2325 33100 13May20	1	KITCHEN: FIXTURE: UNDER CABINET FLUORESCENT LIGHT FIXTURES - DOES NOT INCLUDE (AND REQUIRES) LIGHT VALANCE

ELECTRICAL

Invoice	Qty.	Description
2325 33110 13May20	6	KITCHEN: 4" E/S LED INTERIOR POT LIGHT - GROUND FLOOR - EACH, INCLUDES 1 SWITCH INCLUDED IN APS



CONSTRUCTION SUMMARY

Lot: 135
Model: 40.03 B BROOKSIDE
Project/Phase: Pine Valley Forevergreen / 1

ELECTRICAL

Invoice	Qty.	Description
2325 33094 13May20	2	FOYER: ROUGH-IN FOR ADDITIONAL WALL SCONCE (1) CAPPED OUTLET ON EXISTING SWITCH - FIXTURE NOT INCLUDED - LOCATE APPROX 80" A.F.F. - SEE PLAN FOR LOCATION
2325 33097 13May20	1	KITCHEN: ROUGH-IN FOR CAPPED CEILING OUTLET (FUTURE LIGHT FIXTURE) - EACH - LOCATE APPROX CENTERED ABOVE ISLAND - SEE PLAN USE STANDARD SWITCH

ELECTRICAL

Invoice	Qty.	Description
2325 33095 13May20	1	FOYER: ADDITIONAL INTERIOR SWITCH FOR WALL SCONCES

Invoice	Qty.	Description
	1	

FRAMING

Invoice	Qty.	Description
2325 33103 13May20	1	MASTER ENSUITE: SHOWER NICHE [SHAMPOO SHELF] - COMPLETE WITH MATCHING MARBLE JAMBS ON 4 SIDES, STANDARD TILE, APPROX. 12 X 18 INSTALLED VERTICALLY

Invoice	Qty.	Description

Invoice	Qty.	Description

Invoice	Qty.	Description



CONSTRUCTION SUMMARY

Lot: 135
Model: 40.03 B BROOKSIDE
Project/Phase: Pine Valley Forevergreen / 1

NETWORK AND WIRING

Invoice	Qty.	Description
2325 33037 13May20 NoCat	1	THRU OUT: DO NOT INSTALL STANDARD PHONE LINES
2325 33038 13May20	1	MEDIA ROOM: ADDITIONAL CAT6 ETHERNET OUTLET - SEE PLAN FOR LOCATION
2325 33039 13May20	1	MEDIA ROOM: CONDUIT PIPE - FOR WALL MOUNT TV - LOCATE APPROX. 66" A.F.F., TERMINATING DIRECTLY BELOW AT CABLE LOCATION
2325 33092 13May20	1	GREAT ROOM: CONDUIT PIPE - FOR WALL MOUNT TV - LOCATE APPROX 66" A.F.F. ABOVE FIREPLACE, THRU TO BASEMENT AND BACK TO CABLE LOCATION SEE PLAN FOR LOCATION
2325 33102 13May20	1	CONDUIT PIPE - FROM ATTIC TO BASEMENT - FROM ELECTRICAL PANEL TO APPROX CENTER OF ATTIC

PAINTING

Invoice	Qty.	Description
2325 33104 13May20 **	1	STUDY - OPT. 8 FOOT HIGH DOUBLE FRENCH DOORS WITH FLAT CLEAR GLASS COMPLETE WITH BUILDERS STANDARD OFFERINGS #203 flat glass

}

Invoice	Qty.	Description

PLUMBING

Invoice	Qty.	Description
2325 33107 13May20	1	MASTER ENSUITE: 3/4" WATER SUPPLY LINE TO ENSUITE SHOWER IN LIEU OF STANDARD

}

Invoice	Qty.	Description



CONSTRUCTION SUMMARY

Lot: 135
Model: 40.03 B BROOKSIDE
Project/Phase: Pine Valley Forevergreen / 1

TRIM. MOULDING

Invoice	Qty.	Description
2325 33104 13May20 **	1	STUDY - OPT. 8 FOOT HIGH DOUBLE FRENCH DOORS WITH FLAT CLEAR GLASS COMPLETE WITH BUILDERS STANDARD OFFERINGS #203 flat glass

WINDOWS - BASEMENT

Invoice	Qty.	Description
2270 32023 06Apr20	1	BASEMENT WINDOWS - UPGRADE BASEMENT WINDOW SIZE TO 30 " X 24" - 8" FRAME
2270 32023 06Apr20	1	BASEMENT WINDOWS - UPGRADE BASEMENT WINDOW SIZE TO 30 " X 24" - 8" FRAME


SCHEDULE 'F'



PV-135 JS DS
APRIL 3 2020
MAY 10 2020 JS DS

The Brookside
40' SERIES

Elevation A • 3,380 sq.ft.
→ Elevation B • 3,350 sq.ft.

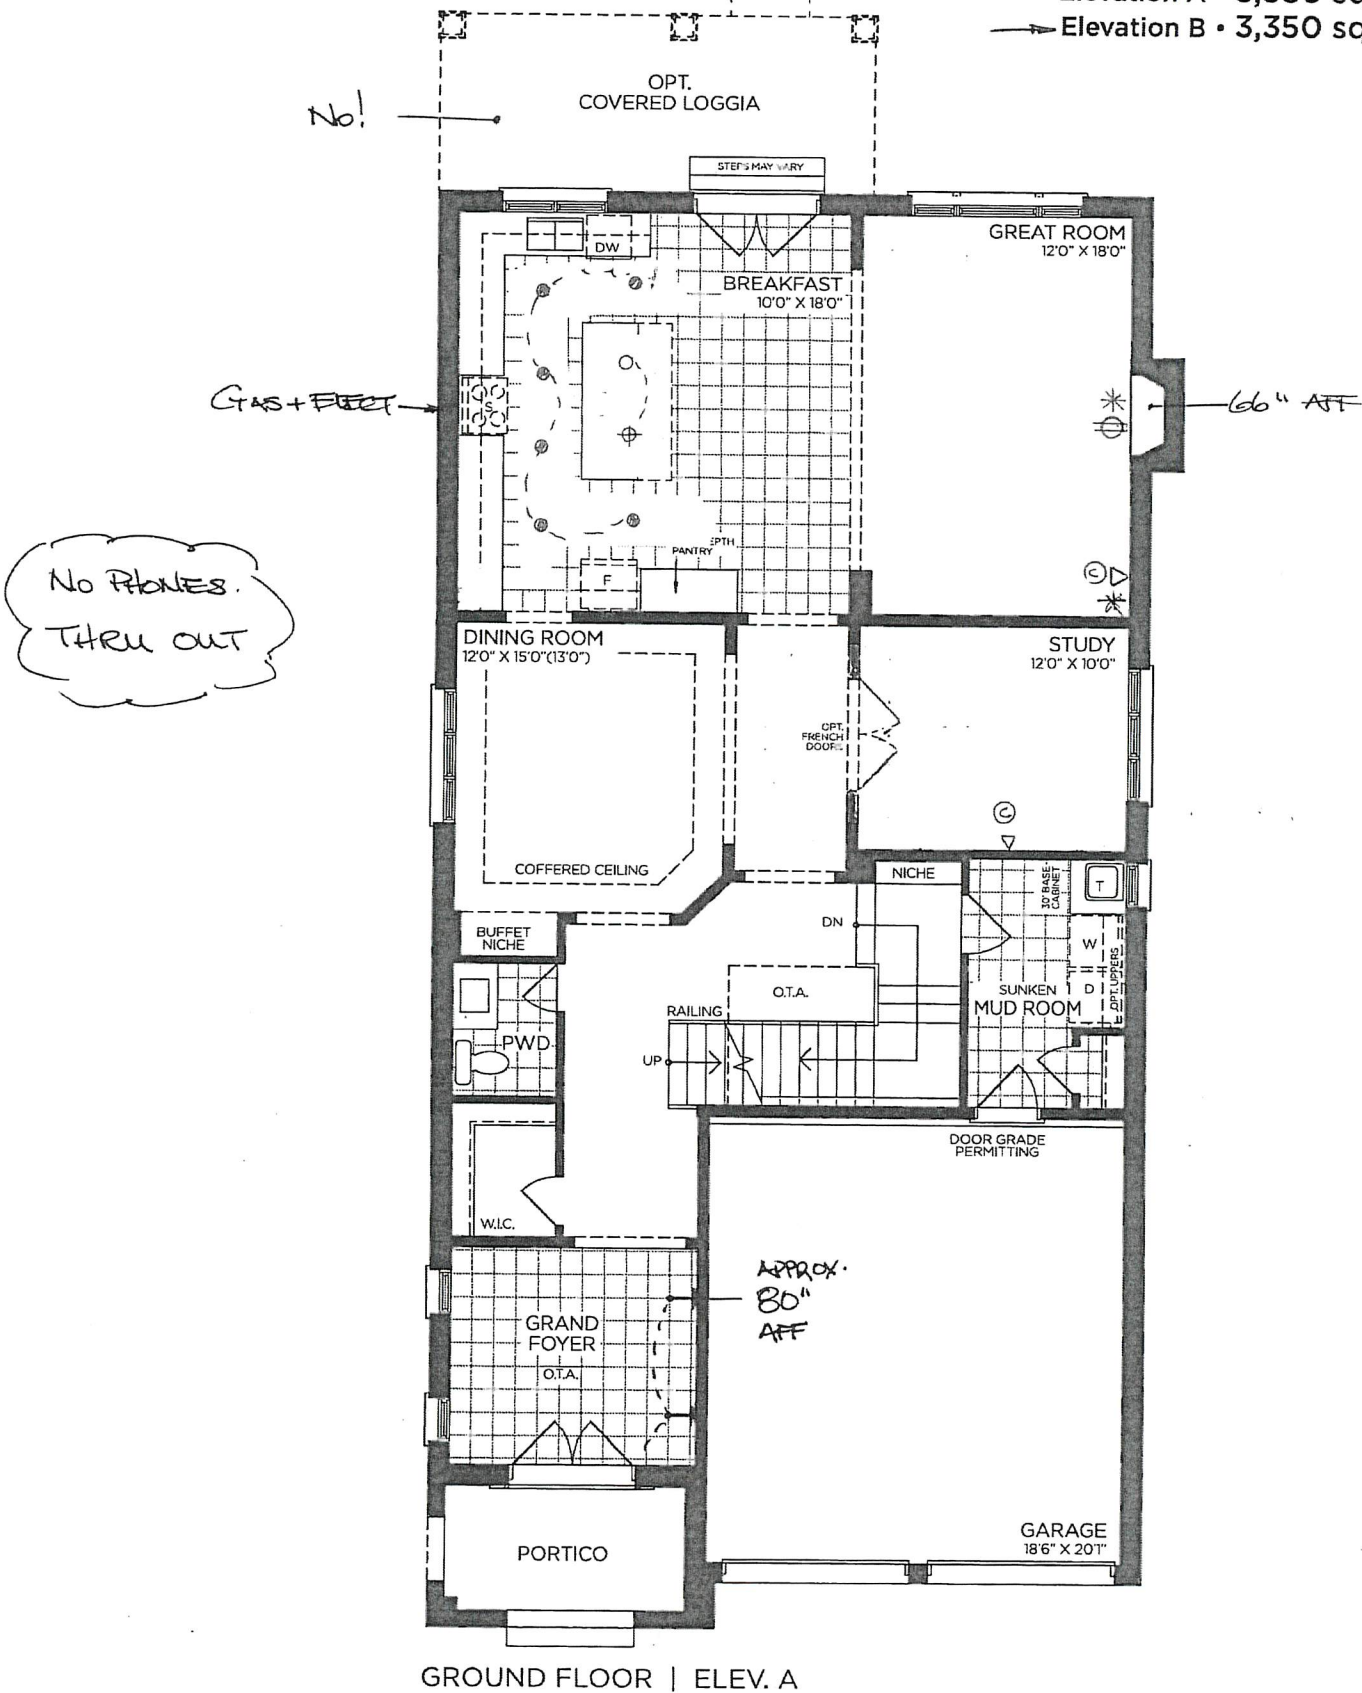

VENDOR

PURCHASER

PURCHASER

GOLDPARK
WORTH MORE™

Prices, figures, illustrations, sizes, features and finishes are subject to change without notice. Areas and dimensions are approximate and actual usable floor space may vary from the stated area. Layout may be reverse of the unit purchased. E. & O.E. 4003

SCHEDULE 'F'




PV-135. JS DS
April 3 2020

MAY 10 2020 JS DS

The Brookside
40' SERIES

Elevation A • 3,380 sq.ft.
Elevation B • 3,350 sq.ft.

No Phones

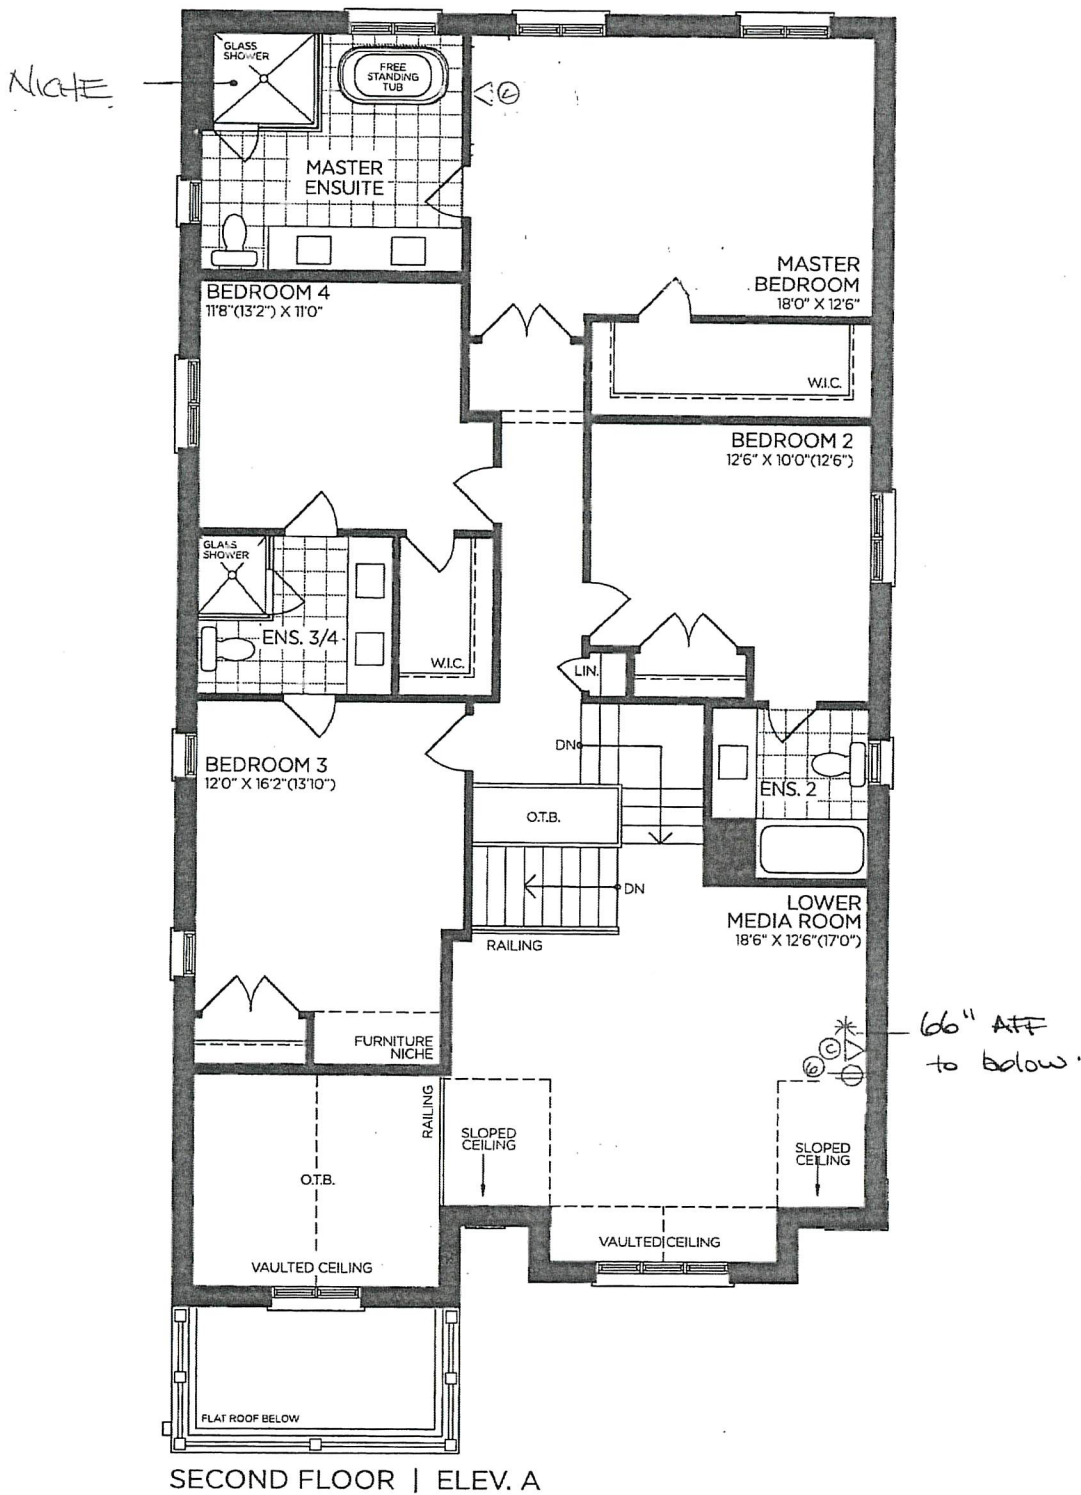

VENDOR

PURCHASER

PURCHASER

GOLDPARK
WORTH MORE™

Prices, figures, illustrations, sizes, features and finishes are subject to change without notice. Areas and dimensions are approximate and actual usable floor space may vary from the stated area. Layout may be reverse of the unit purchased. E. & O.E. 4003