

APPLIANCES

Invoice	Qty.	Description
2320 32971 13May20 **	1	KITCHEN - UPGRADE TO 8" DUCT (EXTERIOR WALL) IN LIEU OF STANDARD OFFERING

CONCRETE AND DRAIN

Invoice	Qty.	Description
2236 31718 23Mar20 NoCat	1	BACK-FLOW PREVENTER VALVE

DRYWALL

Invoice	Qty.	Description
2236 31720 23Mar20 **	2	BASEMENT WINDOWS - UPGRADE BASEMENT WINDOW SIZE TO 30 " X 24" - 8" FRAME
2320 32975 13May20 **	1	DELETE KITCHEN BULKHEAD, IF POSSIBLE, SITE APPROVAL REQUIRED
2320 32976 13May20 **	1	LIVING ROOM - OPT. COFFERED CEILING AS PER PLAN
2320 32977 13May20 **	2	GARAGE DOOR OPENER (CHAMBERLAIN BELT DRIVE) - WITH 1 REMOTE - PRICE IS PER DOOR

ELECTRICAL

Invoice	Qty.	Description
2236 31720 23Mar20 **	2	BASEMENT WINDOWS - UPGRADE BASEMENT WINDOW SIZE TO 30 " X 24" - 8" FRAME
2320 32976 13May20 **	1	LIVING ROOM - OPT. COFFERED CEILING AS PER PLAN

ELECTRICAL

Invoice	Qty.	Description
2320 32965 13May20	1	KITCHEN: 110V WALL RECEPTACLE ON SEPARATE CIRCUIT - GAS FIRED COOKTOP- FOR AUX. EQUIPMENT - NOT A STOVE PLUG
2320 32967 13May20	1	KITCHEN: 110V WALL RECEPTACLE ON SEPARATE CIRCUIT - FUTURE FREEZER BESIDE FRIDGE
2320 32968 13May20	1	SERVERY: 110V WALL RECEPTACLE ON SEPARATE CIRCUIT - FOR FUTURE WINE FRIDGE - APPLIANCE NOT INCLUDED
2320 32998 13May20	1	KITCHEN: ADDITIONAL 220V RECEPTACLE ON A SEPARATE CIRCUIT - FOR BUILT-IN WALL OVEN - APPLIANCE NOT INCLUDED - DOES NOT INCLUDE BREAKER THAT IS TO BE INSTALLED BY LICENSED ELECTRICIAN AND ARRANGED BY HOMEOWNER AFTER CLOSING

ELECTRICAL

Invoice	Qty.	Description
2320 32960 13May20	1	GREAT ROOM: INTERIOR WALL OUTLET: ADDITIONAL 110V WALL INTERIOR RECEPTACLE ON EXISTING CIRCUIT FOR WALL MOUNTED TV - LOCATE APPROX. 66" A.F.F. ABOVE FIREPLACE
2320 32962 13May20	1	LIVING ROOM: CEILING OUTLET: ADDITIONAL REINFORCED CEILING OUTLET - LOCATE APPROX. CENTER IN OTA
2320 32964 13May20	1	KITCHEN: FIXTURE: RELOCATE STANDARD CEILING MOUNT FIXTURE - LOCATE APPROX. CENTER ABOVE ISLAND

ELECTRICAL

Invoice	Qty.	Description
2320 32963 13May20	1	LIVING ROOM: ADDITIONAL INTERIOR SWITCH FOR CEILING LIGHT

G

Invoice	Qty.	Description

FORMING

Invoice	Qty.	Description
2236 31717 23Mar20	1	PINE VALLEY MODEL 42.03 FORESTCREST ELEV A - 9 FOOT BASEMENT CEILING HEIGHT IN LIEU OF STANDARD 8 FOOT CEILING.

FRAMING

Invoice	Qty.	Description
2320 32974 13May20	1	MASTER ENSUITE: SHOWER NICHE [SHAMPOO SHELF] - COMPLETE WITH MATCHING MARBLE JAMBS ON 4 SIDES, STANDARD TILE, APPROX. 12 X 18 INSTALLED VERTICALLY - SEE PLAN FOR PREFERRED LOCATION
2320 32975 13May20	1	DELETE KITCHEN BULKHEAD, IF POSSIBLE, SITE APPROVAL REQUIRED
2320 32980 13May20 NoCat	1	***CUSTOM LAYOUT*** DELETE LINEN CLOSET FROM UPPER HALL, USE IT TO MAKE CLOSET LARGER IN BEDROOM 2
2320 32982 13May20 NoCat	1	***CUSTOM LAYOUT***DELETE STUDY LOFT, CLOSE WALL/RAILING AT OTB TO CREATE LARGER HERS WIC. SEE PLAN FOR LAYOUT. INCLUDES STANDARD INTERIOR ROD AND SHELVING. ISLAND TO BE PURCHASED AT COLOUR APPOINTMENT

GARAGE DOORS

Invoice	Qty.	Description
2320 32977 13May20	2	GARAGE DOOR OPENER (CHAMBERLAIN BELT DRIVE) - WITH 1 REMOTE - PRICE IS PER DOOR
2320 32978 13May20	1	GARAGE: WIRELESS KEYPAD GARAGE DOOR ENTRY 877LM

HVAC

Invoice	Qty.	Description
2320 32966 13May20	1	KITCHEN: GAS LINE ROUGH-IN - MAIN FLOOR FOR COOKTOP - SEE PLAN FOR LOCATION
2320 32971 13May20	1	KITCHEN - UPGRADE TO 8" DUCT (EXTERIOR WALL) IN LIEU OF STANDARD OFFERING
2320 32975 13May20 **	1	DELETE KITCHEN BULKHEAD, IF POSSIBLE, SITE APPROVAL REQUIRED

INTERIOR TRIM /MOULDINGS

Invoice	Qty.	Description
2320 32976 13May20 **	1	LIVING ROOM - OPT. COFFERED CEILING AS PER PLAN

KITCHEN AND BATH CABINETRY

Invoice	Qty.	Description
2320 32971 13May20 **	1	KITCHEN - UPGRADE TO 8" DUCT (EXTERIOR WALL) IN LIEU OF STANDARD OFFERING
2320 32975 13May20 **	1	DELETE KITCHEN BULKHEAD, IF POSSIBLE, SITE APPROVAL REQUIRED

MISC.

Invoice	Qty.	Description
0		

Invoice	Qty.	Description
0		

NETWORK AND WIRING

Invoice	Qty.	Description
2320 32958 13May20	1	GREAT ROOM / MASTER BEDROOM / BEDROOM 3 / BEDROOM 4: ADDITIONAL CAT6 ETHERNET OUTLET - EACH SEE PLAN FOR LOCATION PACKAGE PRICE
2320 32959 13May20	1	GREAT ROOM: CONDUIT PIPE - FOR WALL MOUNT TV - LOCATE APPROX. 66" A.F.F. ABOVE FIREPLACE
2320 32961 13May20	1	GREAT ROOM: CONDUIT PIPE - FOR WALL MOUNT TV - LOCATE APPROX. 66" A.F.F. ABOVE FIREPLACE, TERMINATING AT CABLE. SEE PLAN FOR LOCATION
2320 32973 13May20	1	CONDUIT PIPE - FROM ATTIC TO BASEMENT - FROM NEAR ELECTRICAL PANEL IN BASEMENT TO APPROX CENTER OF ATTIC

PAINTING

Invoice Qty. Description

2320 32975 13May20 **	1	DELETE KITCHEN BULKHEAD, IF POSSIBLE, SITE APPROVAL REQUIRED
2320 32976 13May20 **	1	LIVING ROOM - OPT. COFFERED CEILING AS PER PLAN

FRAMING

Invoice Qty. Description

2320 32975 13May20 **	1	DELETE KITCHEN BULKHEAD, IF POSSIBLE, SITE APPROVAL REQUIRED
2320 32976 13May20 **	1	LIVING ROOM - OPT. COFFERED CEILING AS PER PLAN
	-	

PLUMBING

Invoice Qty. Description

2320 32969 13May20	1	KITCHEN: ROUGH-IN 1/4" COLD WATER LINE TO FRIDGE
--------------------------	---	--

PLUMBING FIXTURES

Invoice Qty. Description

2320 32995 13May20 NoCat	1	MASTER ENSUITE: UPGRADE TO MIROLIN 'SABLE' SLIMLINE SOAKER TUB - WHITE #CF2102
2320 32997 13May20 NoCat	1	MASTER ENSUITE: UPGRADE SHOWER FAUCET TO MOEN 'ARRIS' POSI-TEMP RAIN SHOWER (from ceiling) + HAND SHOWER WITH SLIDE BAR - CHROME #TS22002EP/3372/TS23005/62320/3887EP/A725

ROUGH CARPENTRY

Invoice	Qty.	Description
2320 32976 13May20 **	1	LIVING ROOM - OPT. COFFERED CEILING AS PER PLAN

WINDOWS - BASEMENT

Invoice	Qty.	Description
2236 31720 23Mar20	2	BASEMENT WINDOWS - UPGRADE BASEMENT WINDOW SIZE TO 30 " X 24" - 8" FRAME
2236 31720 23Mar20	2	BASEMENT WINDOWS - UPGRADE BASEMENT WINDOW SIZE TO 30 " X 24" - 8" FRAME

SCHEDULE 'F'




see attach
 PV-100
 MAR 22 2020

PV-100
 MAY 11 2020 (SK) (ET)

The Forestcrest

42' SERIES

→ Elevation A • 3,800 sq.ft.
 Elevation B • 3,785 sq.ft.
 Elevation C • 3,800 sq.ft.

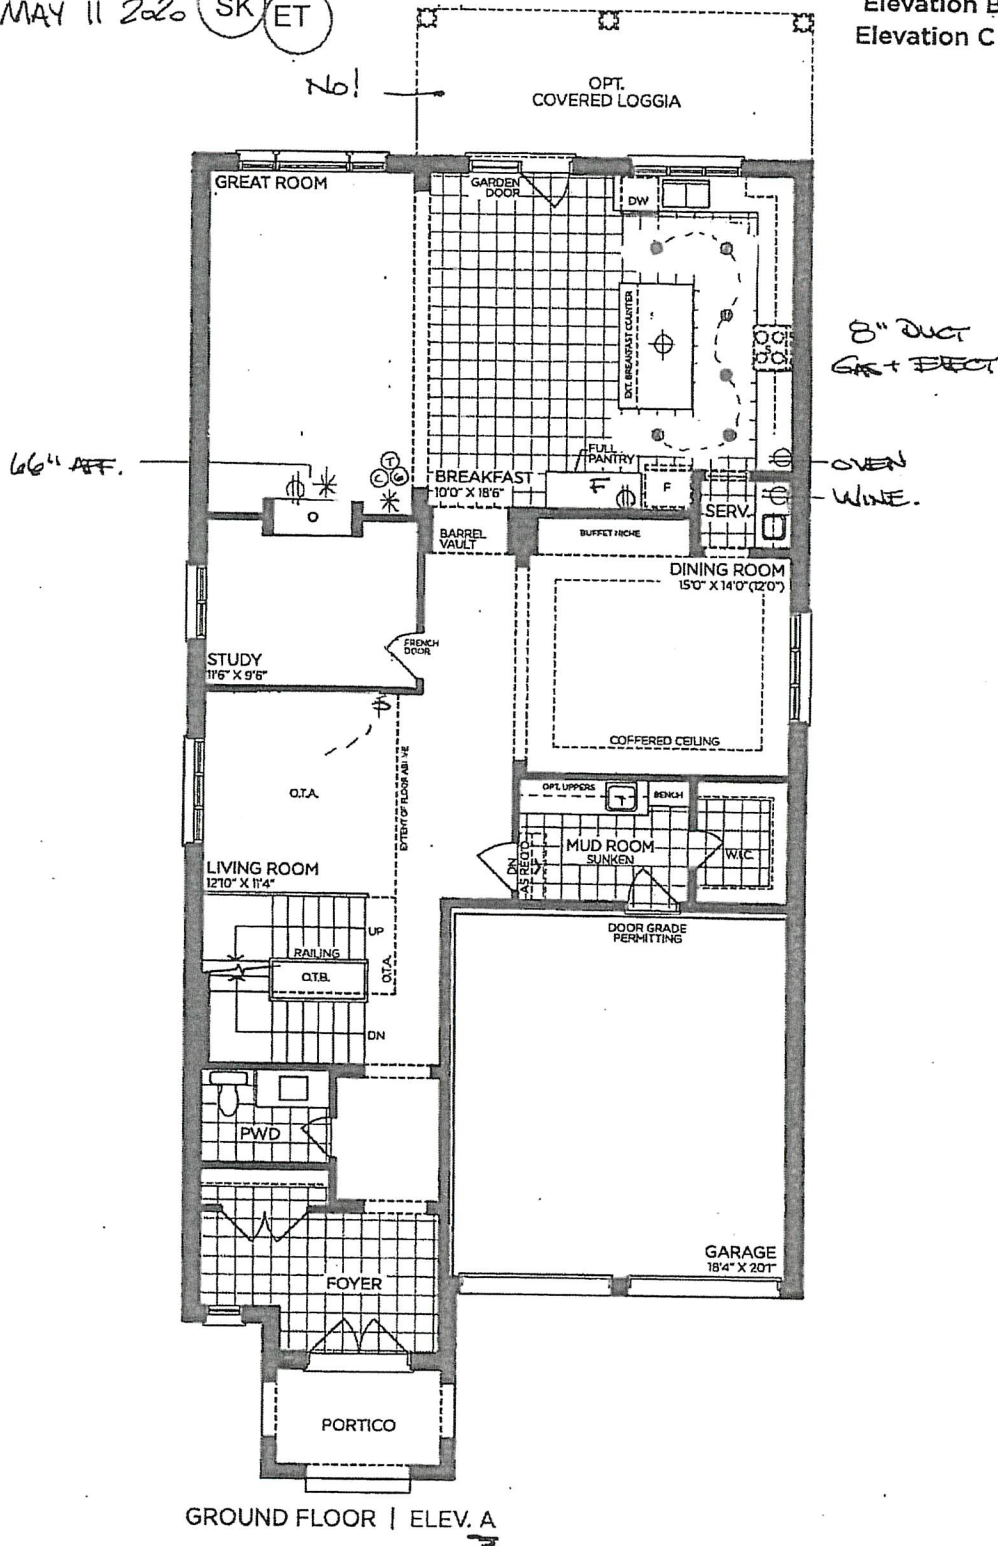

VENDOR

PURCHASER

PURCHASER

GOLDPARK
 WORTH MORE™

Prices, figures, illustrations, sizes, features and finishes are subject to change without notice. Areas and dimensions are approximate and actual usable floor space may vary from the stated area. Layout may be reverse of the unit purchased. E. & O.E. 4203

SCHEDULE 'F'




PV-100 (SK) (ET)
MAY 11 2020

The Forestcrest

42' SERIES

→ Elevation A • 3,800 sq.ft.
Elevation B • 3,785 sq.ft.
Elevation C • 3,800 sq.ft.

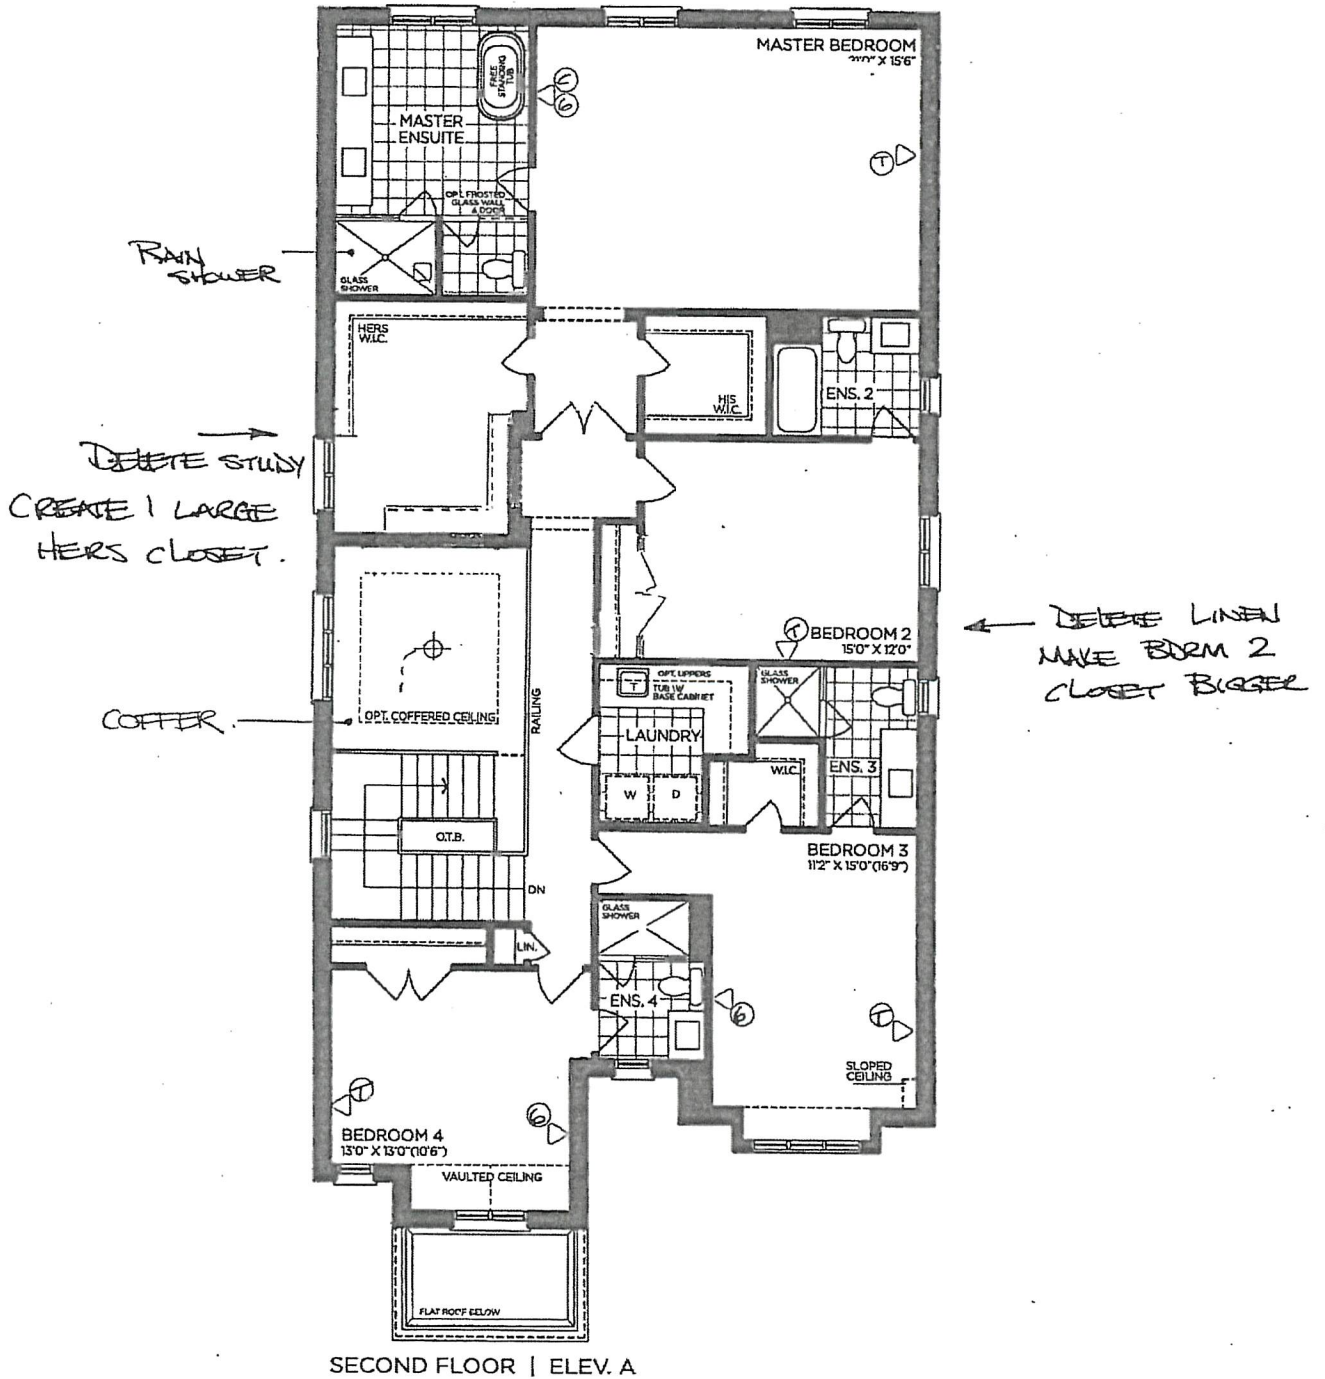

VENDOR

PURCHASER

PURCHASER

GOLDPARK
WORTH MORE™

Prices, figures, illustrations, sizes, features and finishes are subject to change without notice. Areas and dimensions are approximate and actual usable floor space may vary from the stated area. Layout may be reverse of the unit purchased. E. & O.E. 4203

SCHEDULE 'F'



see attach
 PV-100
 MARCH 22 2020

PV-100
 MAY 11 2020 (SK) (ET)

The Forestcrest


42' SERIES

→ Elevation A • 3,800 sq.ft.
 Elevation B • 3,785 sq.ft.
 Elevation C • 3,800 sq.ft.

LOB

*Back Flow
 Preventer Valve*

*9' CEILING
 in BASEMENT*

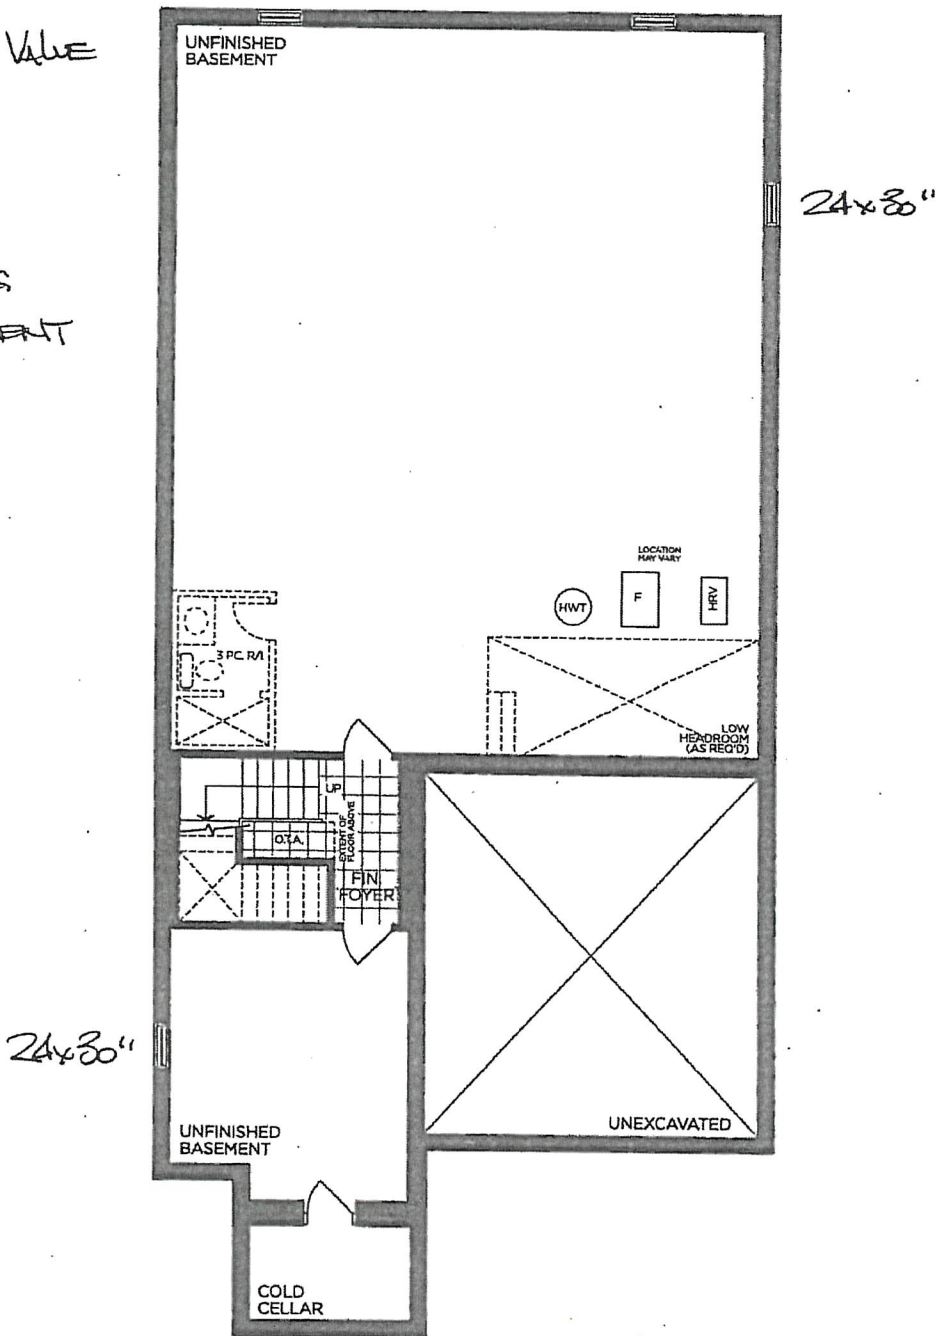

BASEMENT | ELEV. A

VENDOR

PURCHASER

PURCHASER

GOLDPARK
 WORTH MORE™


Prices, figures, illustrations, sizes, features and finishes are subject to change without notice. Areas and dimensions are approximate and actual usable floor space may vary from the stated area. Layout may be reverse of the unit purchased. E. & O.E. 4203

PLUMBING UPGRADES



POSI-TEMP SHOWER ONLY* W/3 FUNCTION TRANSFER VALVE
TRIM AND SLIDE BAR W/HAND SHOWER

MOEN - ARRIS

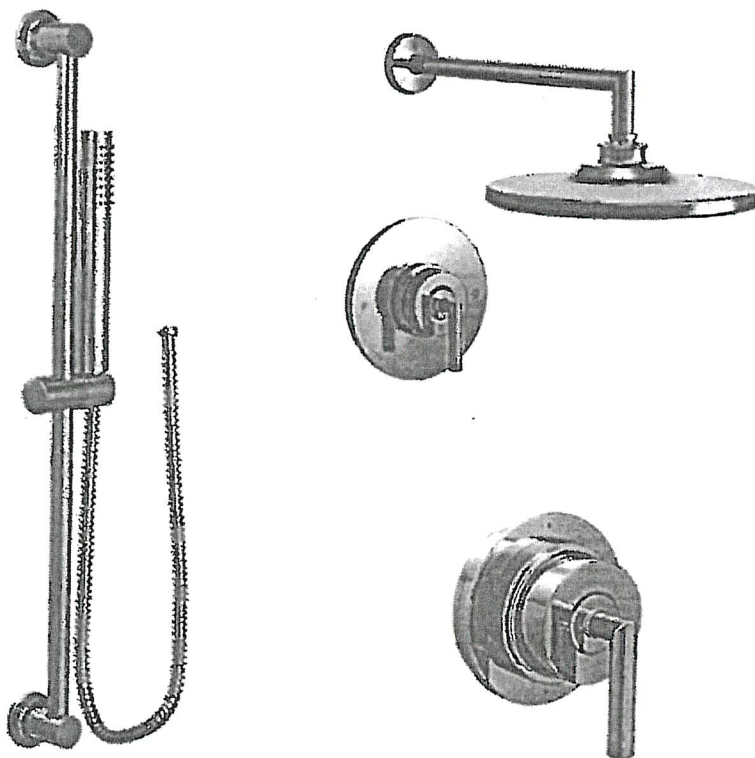

CHROME

BRUSHED NICKEL

MATTE BLACK

from WALL

from CEILING

MODEL TS22002EP / 3372 / TS23005 / 62320 / 3887EP / A725

Lot# 100

Room: MASTER ENSUITE

Signature: *Selby*


Date: MAY 11 2020

Signature: *Clamann*


TUB UPGRADES

Mirolin - SABLE Two Piece Soaker


CF2012

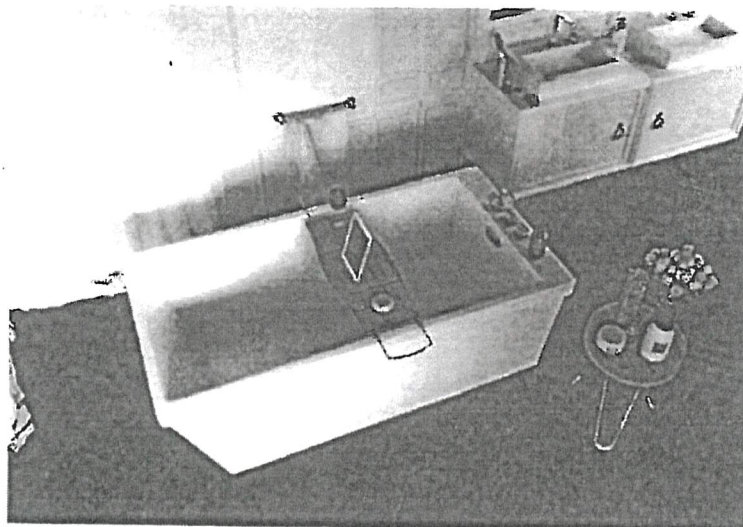

FRONT VIEW

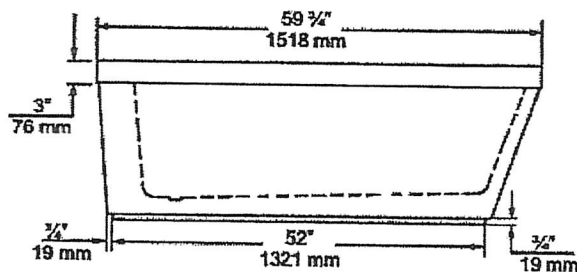

TOP VIEW

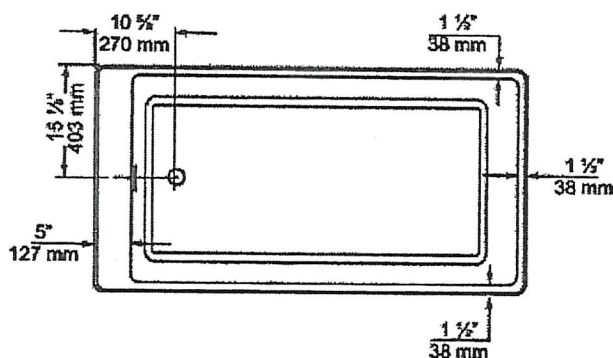

Lot#
100

Room:
MASTER ENSUITE

Signature: *Selvy*

Date:
MAY 11 2020

Signature: *Elamaran*