

APPLIANCES		
Invoice	Qty.	Description
2352 33545 19May20 NoCat	1	APPLIANCE PACKAGE: FRIDGE/STOVE/DISHWASHER - STAINLESS STEEL + WASHER/DRYER - WHITE  INCLUDED IN APS

CENTRAL VAC AND WIRING		
Invoice	Qty.	Description
2273 32059 01May20	1	FAMILY ROOM: CONDUIT PIPE- FOR TELEVISION- LOCATE APPROX. 66" A.F.F. ABOVE FIREPLACE, TERMINATING AT CABLE LOCATION.

CERAMIC		
Invoice	Qty.	Description
2273 33052 01May20 NoCat	1	ENSUITE 2: UPGRADE SHOWER IN LIEU OF TUB- INCLUDES FRAMED GLASS SHOWER ENCLOSURE WITH TILE BASE AND POTLIGHT IN SHOWER

CONCRETE AND DRAIN		
Invoice	Qty.	Description
2273 32087 01May20 NoCat	1	BACK-FLOW PREVENTER VALVE
2352 33547 19May20 **	1	ROUGH-IN - 3PC BASEMENT ROUGH-IN  INCLUDED IN APS

DRYWALL		
Invoice	Qty.	Description
2273 32062 01May20	1	2ND FLOOR: SMOOTH CEILINGS - (2-Story Design) 2ND FLOOR



GOLDPARK

WORTH MORE™

CONSTRUCTION SUMMARY

Lot: 122

Model: 38-11 Elev B Schumann

Project/Phase: Brampton Encore / 2

ELECTRICAL

Invoice	Qty.	Description
2273 32203 01May20 NoCat	1	FRONT ELEVATION: ADD 1 LED SOFFIT LIGHT, SEE ELEVATION FOR LOCATION. COMPLETE WITH SINGLE POLE SWITCH IN FOYER
2273 33048 01May20 NoCat	1	ENSUITE 2: UPGRADE SHOWER IN LIEU OF TUB- INCLUDES FRAMED GLASS SHOWER ENCLOSURE WITH TILE BASE AND POTLIGHT IN SHOWER

ELECTRICAL POTLIGHT

Invoice	Qty.	Description
2273 33051 01May20 NoCat	1	ENSUITE 2: UPGRADE SHOWER IN LIEU OF TUB- INCLUDES FRAMED GLASS SHOWER ENCLOSURE WITH TILE BASE AND POTLIGHT IN SHOWER

EXTERIOR COLOURS

Invoice	Qty.	Description
2273 33061 01May20 NoCat	1	EXTERIOR COLOUR PACKAGE # 8

FORMING

Invoice	Qty.	Description
2273 32081 01May20 **	3	BASEMENT WINDOWS - UPGRADE EXISTING BASEMENT WINDOW TO 30 INCH X 24 INCH - MAY REQUIRE INSTALLATION OF WINDOW WELL
2352 33548 19May20 **	1	MANDOOR - GARAGE TO HOUSE- AS PER PLAN AND GRADE PERMITTING  INCLUDED IN APS
2352 33549 19May20	1	SIDE DOOR- HOME TO EXTERIOR- AS PER PLAN AND GRADE PERMITTING  INCLUDED IN APS
2352 33562 19May20 ** NoCat	1	SIDE DOOR- HOME TO EXTERIOR- AS PER PLAN AND GRADE PERMITTING
2352 33563 19May20 ** NoCat	1	MANDOOR - GARAGE TO HOUSE- AS PER PLAN AND GRADE PERMITTING
2352 33564 19May20 ** NoCat	1	SIDE DOOR- HOME TO EXTERIOR- AS PER PLAN AND GRADE PERMITTING


ryDiscipline.rpt 06May20

Page 3 of 8

Printed and Sent: 19-May-20







CONSTRUCTION SUMMARY

Lot: 122

Model: 38-11 Elev B Schumann

Project/Phase: Brampton Encore / 2

MISC.		
Invoice	Qty.	Description
2273 32089  01May20 NoCat	1	BONUS PACKAGE: \$10,000.00 (INCLUDING TAXES) WORTH OF UPGRADES FROM GOLD PARK HOMES DÉCOR CENTRE IS BEING APPLIED TOWARD THIS ORDER. PURCHASER HAS A REMAINING AMOUNT OF \$00 (INCLUDING TAXES).
2273 32389  01May20 NoCat	1	Purchaser has attended a phone appointment at the Decor Centre & has DECLINED any additional upgrades and accepts and acknowledges that there will be no further changes/additions/deletions to be made upon signing on April 16, 2020.

PAINT		
Invoice	Qty.	Description
2273 33042  01May20 NoCat	1	2ND FLOOR: SMOOTH CEILINGS - (2-Story Design) 2ND FLOOR
2273 33044  01May20 NoCat	1	***CUSTOM LAYOUT*** KITCHEN: ADD APPROX 30" TO KITCHEN/DINING WALL - MAKING ARCHWAY NARROWER SEE PLAN FOR LOCATION
2273 33045  01May20 NoCat	1	FAMILY ROOM: OPTIONAL COFFERED CEILING - FAMILY ROOM (PER ROOM AS PER PLAN)
2273 33055  01May20 NoCat	1	***CUSTOM LAYOUT*** MASTER ENSUITE: RELOCATE DOOR, SEE PLAN FOR LOCATION
2352 33548  19May20 **	1	MANDOOR - GARAGE TO HOUSE- AS PER PLAN AND GRADE PERMITING  INCLUDED IN APS
2352 33563  19May20 ** NoCat	1	MANDOOR - GARAGE TO HOUSE- AS PER PLAN AND GRADE PERMITING



WINDOWS AND DOORS

InvoiceQty. Description

2273 32086 01May20	1	BREAKFAST: FRENCH DOORS IN LIEU OF PATIO SLIDERS - 6FT X 80 INCH FRENCH DOORS - NO SCREEN CLEAR GLASS
2273 33054 01May20 NoCat	1	***CUSTOM LAYOUT*** MASTER ENSUITE: RELOCATE DOOR, SEE PLAN FOR LOCATION
2300 33057 01May20 NoCat	1	***CUSTOM LAYOUT*** MASTER BEDROOM: RELOCATE DOUBLE DOORS APPROX. 4', CLOSER TO WIC DOOR - SEE PLAN FOR LOCATION
2352 33548 19May20 **	1	MANDOOR - GARAGE TO HOUSE- AS PER PLAN AND GRADE PERMITTING  INCLUDED IN APS
2352 33549 19May20 **	1	SIDE DOOR- HOME TO EXTERIOR- AS PER PLAN AND GRADE PERMITTING  INCLUDED IN APS
2352 33562 19May20 ** NoCat	1	SIDE DOOR- HOME TO EXTERIOR- AS PER PLAN AND GRADE PERMITTING
2352 33563 19May20 ** NoCat	1	MANDOOR - GARAGE TO HOUSE- AS PER PLAN AND GRADE PERMITTING
2352 33564 19May20 ** NoCat	1	SIDE DOOR- HOME TO EXTERIOR- AS PER PLAN AND GRADE PERMITTING

The  
Schumann  
38' SERIES

Elevation A • 3,050 sq.ft.  
Elevation B • 3,050 sq.ft.

BEZ-122.  
APRIL 16 2020

BEZ-122  
APRIL 20 2020

\*HOT/COLD HOSE B.B.

see attached

COFFERED  
CEILING

FRENCH  
DOORS.

SMOOTH CEILING.

66"  
ATT

GAS+ELECT

BUILT-IN OVENS.  
FRIDGE WATER LINE

YES!

GROUND FLOOR  
ELEVATION A

HOT/COLD HOSE B.B.

PART. GROUND FLOOR  
ELEVATION B

VENDOR  
PURCHASER  
PURCHASER

GOLDPARK  
WORTH MORE™

Prices, figures, illustrations, sizes, features and finishes are subject to change without notice. Areas and dimensions are approximate and actual usable floor space may vary from the stated area. Layout may be reverse of the unit purchased. E. & O.E.


The  
Schumann  
38' SERIES

Elevation A • 3,050 sq.ft.

→ Elevation B • 3,050 sq.ft.

BEZ-122 *see attached*  
April 16 2020

BEZ 122  
APRIL 20 2020 *see attached*

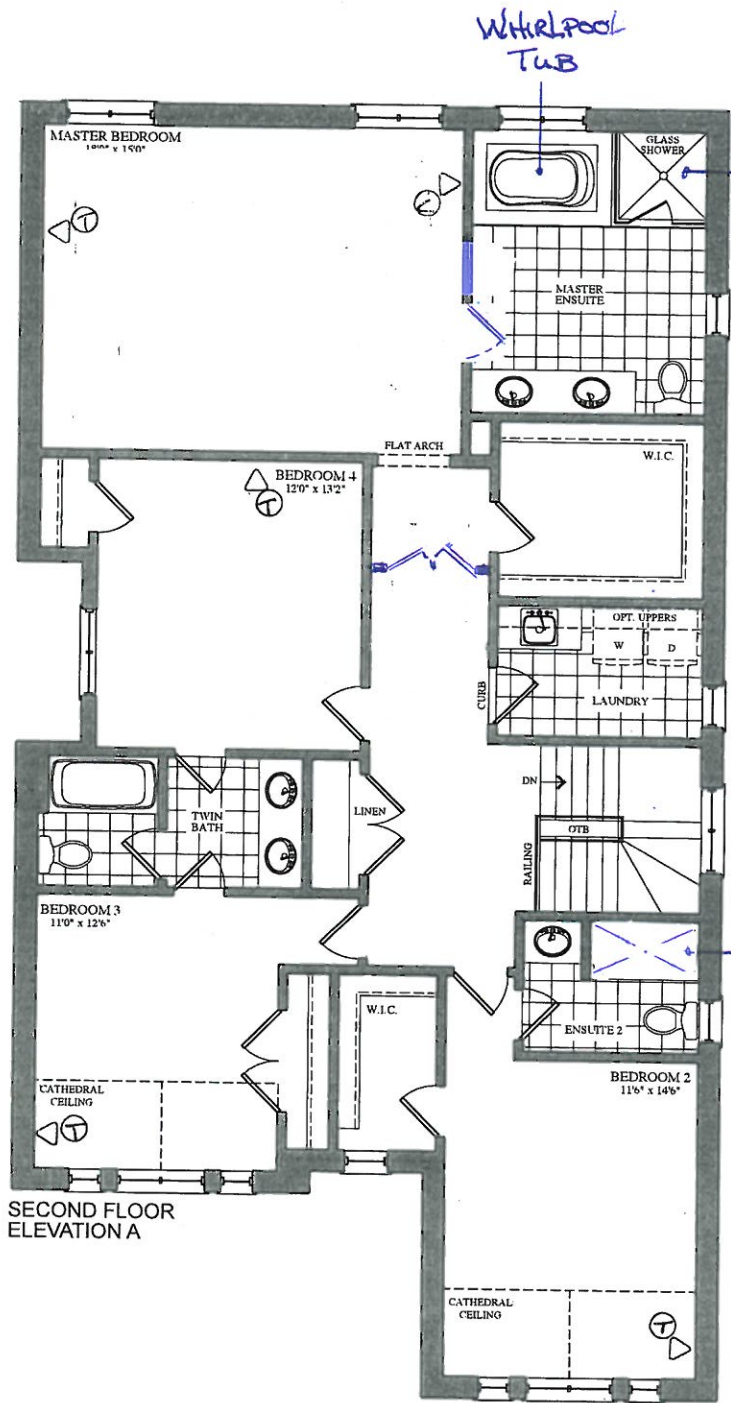


SECOND FLOOR  
ELEVATION A

SHOWER  
FAUCET

RELOCATE DOOR

SMOOTH  
CEILINGS

RELOCATE DOORS

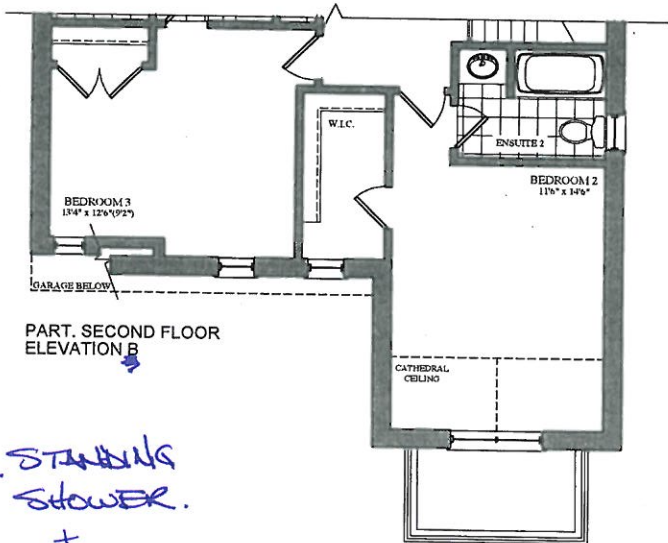

PART. SECOND FLOOR  
ELEVATION B

STANDING  
SHOWER.  
+  
SHOWER  
FAUCET

VENDOR

PURCHASER

PURCHASER


GOLDPARK  
WORTH MORE™

Prices, figures, illustrations, sizes, features and finishes are subject to change without notice. Areas and dimensions are approximate and actual usable floor space may vary from the stated area. Layout may be reverse of the unit purchased. E. & O.E.

The  
**Schumann**  
38' SERIES

Elevation A • 3,050 sq.ft.  
→ Elevation B • 3,050 sq.ft.

BE2-122 *see attached*  
April 16 2020  
BE2-122 *see attached*  
April 20 2020

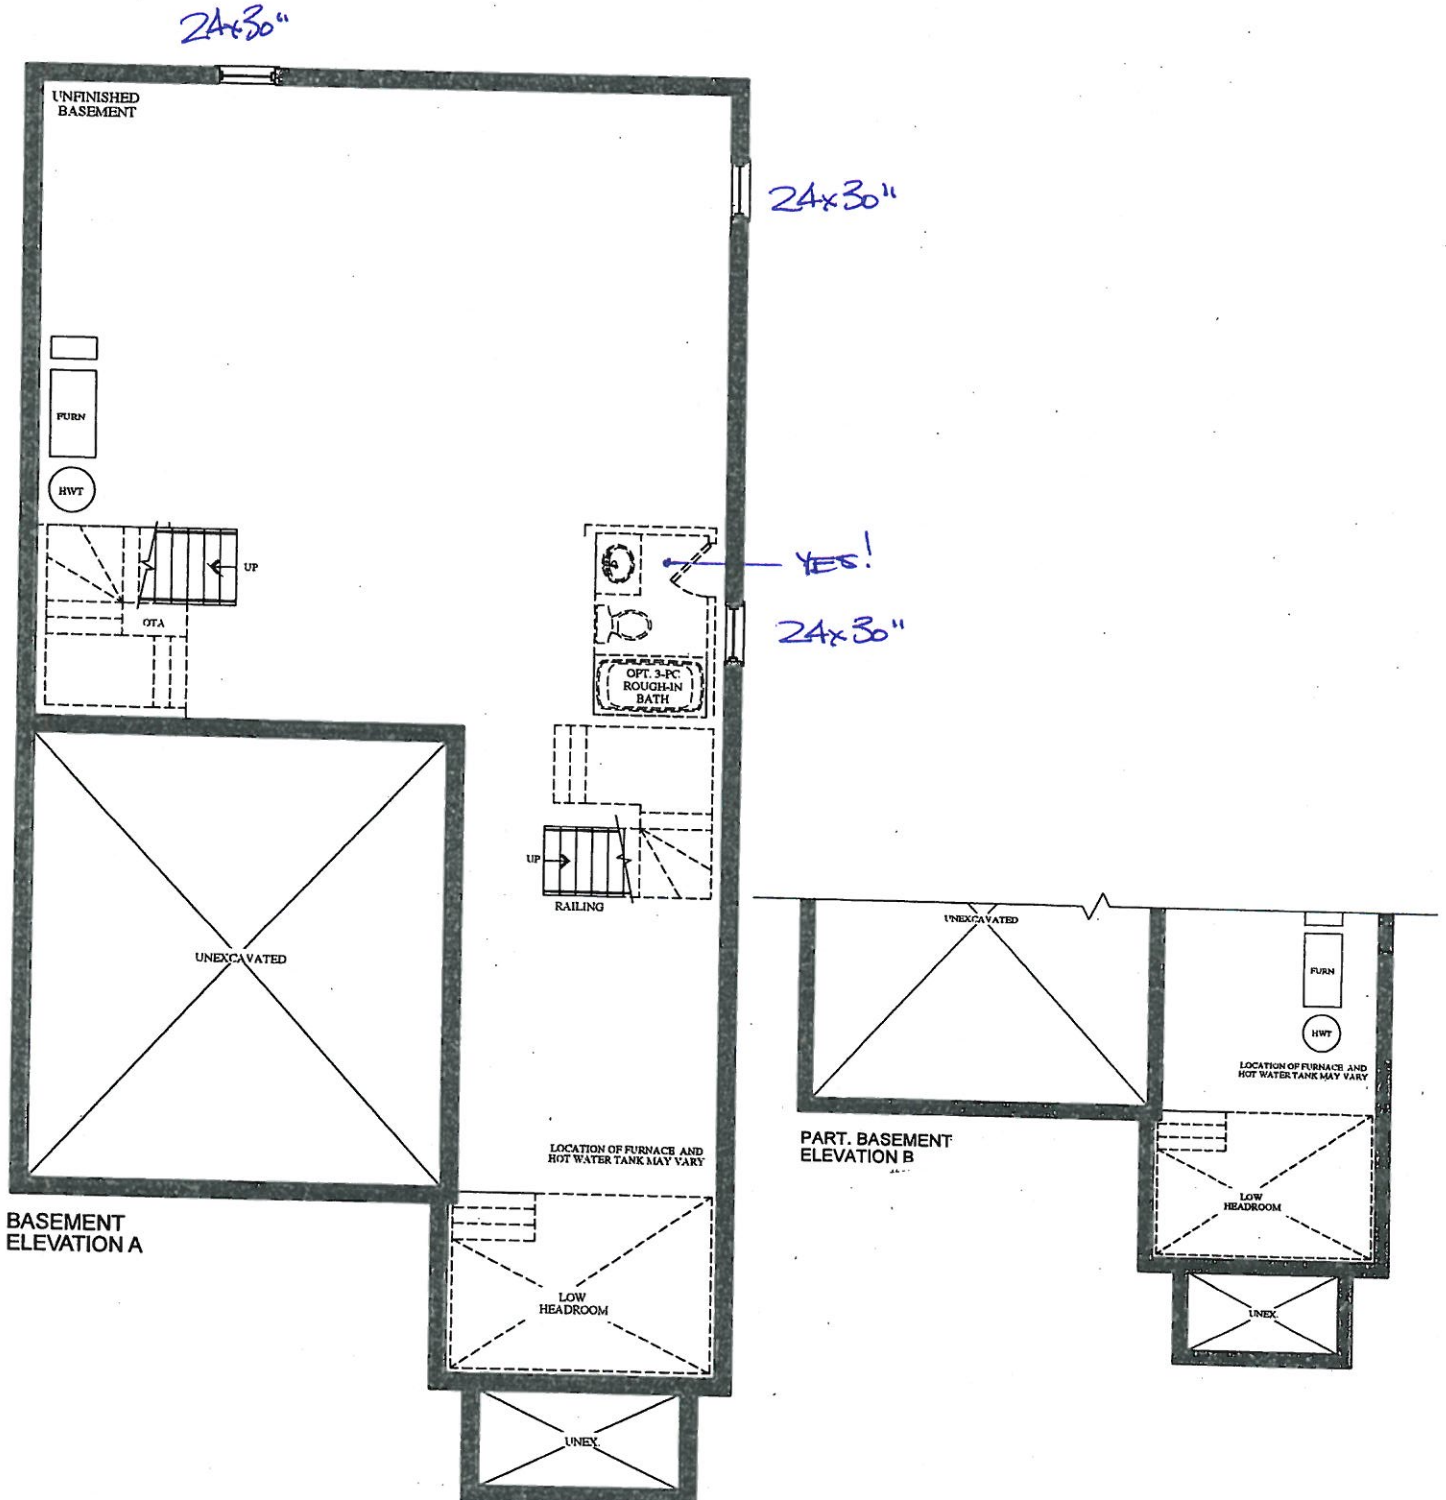


VENDOR

PURCHASER

PURCHASER

**GOLDPARK**  
WORTH MORE™



Prices, figures, illustrations, sizes, features and finishes are subject to change without notice. Areas and dimensions are approximate and actual usable floor space may vary from the stated area. Layout may be reverse of the unit purchased. E. & O.E.

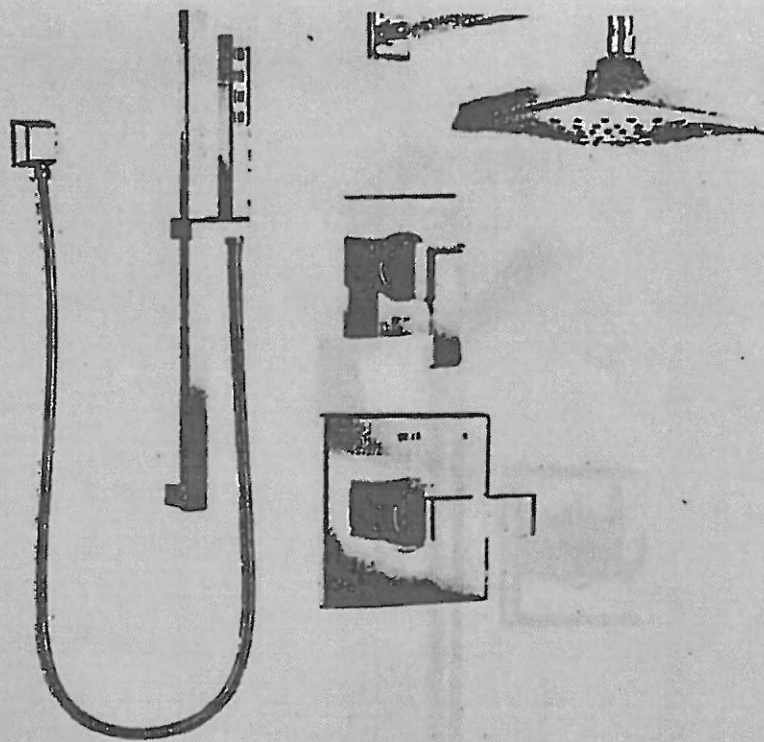


Ara Monitor 14 Series Shower Kit  
DF-KIT4-WS - Chrome

Includes:

- # T14067 Valve Only Trim
- # R10000-UNWS MultiChoice Universal Valve w/Stops
- # T11867 Diverter Trim
- # R11000 Diverter Rough
- # 52684 Shower Head
- # RP46870 Shower Arm
- # RP52144 Shower Arm Flange
- # 51567 Wallbar Hand Shower
- # 50570 Wall Elbow

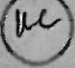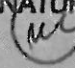LOT # 122.	
ROOM: MASTER ENSUITE	SIGNATURE: 
DATE: APRIL 8 2020	SIGNATURE: 

DRYDEN

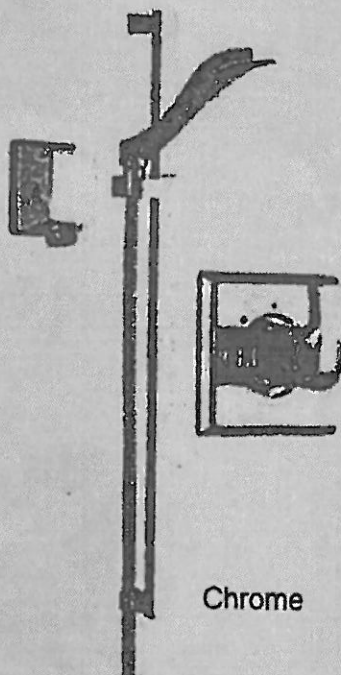

Chrome

### Handshower Components


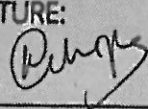
Chrome:

Wall Elbow - # 50570


Slide Bar Hand Shower - # 57051

3-Setting 2-Port Diverter Trim - # T11851

Rough-In - # R11000

LOT # 122.	
ROOM: ENSUITE 2	SIGNATURE: 
DATE: APRIL 16 2020	SIGNATURE: 

## Hudson 6

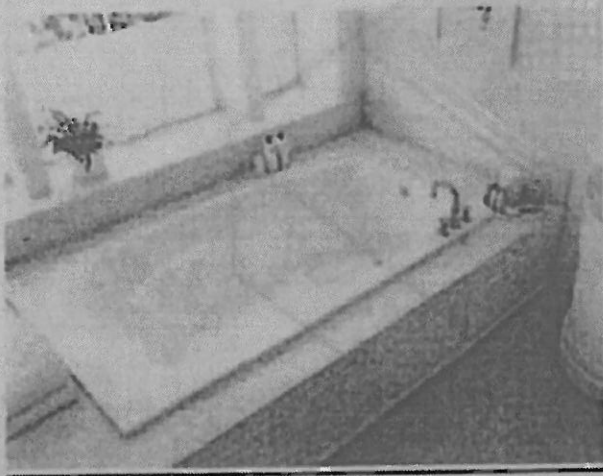

MASTER  
ENSUITE

60" x 42" x 20"

Whirlpool  
6 side jets, 2 foot jets

H7242AW


### Features & Benefit

Accepts deck mounted faucet  
Sloped lumbar support  
Spacious bathing well  
Convenient dual armrests  
Above floor rough-in  
Patterned bottom

BEZ-122. *ML*  
APRIL 16, 2020 *8:00*

BB-122. (7)  
April 16 2020

SOFFIT  
LIGHT  
LOCATION

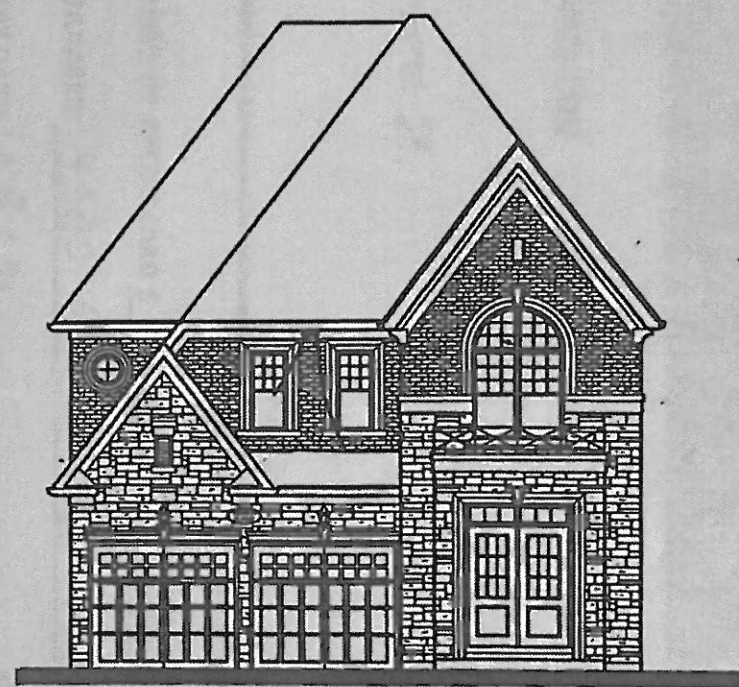

FRONT ELEVATION 'B'

encore  
BRAMPTON


SCHEDULE 'F'

BEZ-122. (K-L)  
April 16 2020

# The Schumann 38' SERIES

Elevation A • 3,050 sq.ft.  
→ Elevation B • 3,050 sq.ft.

\*HOT/COLD H2O B.B.

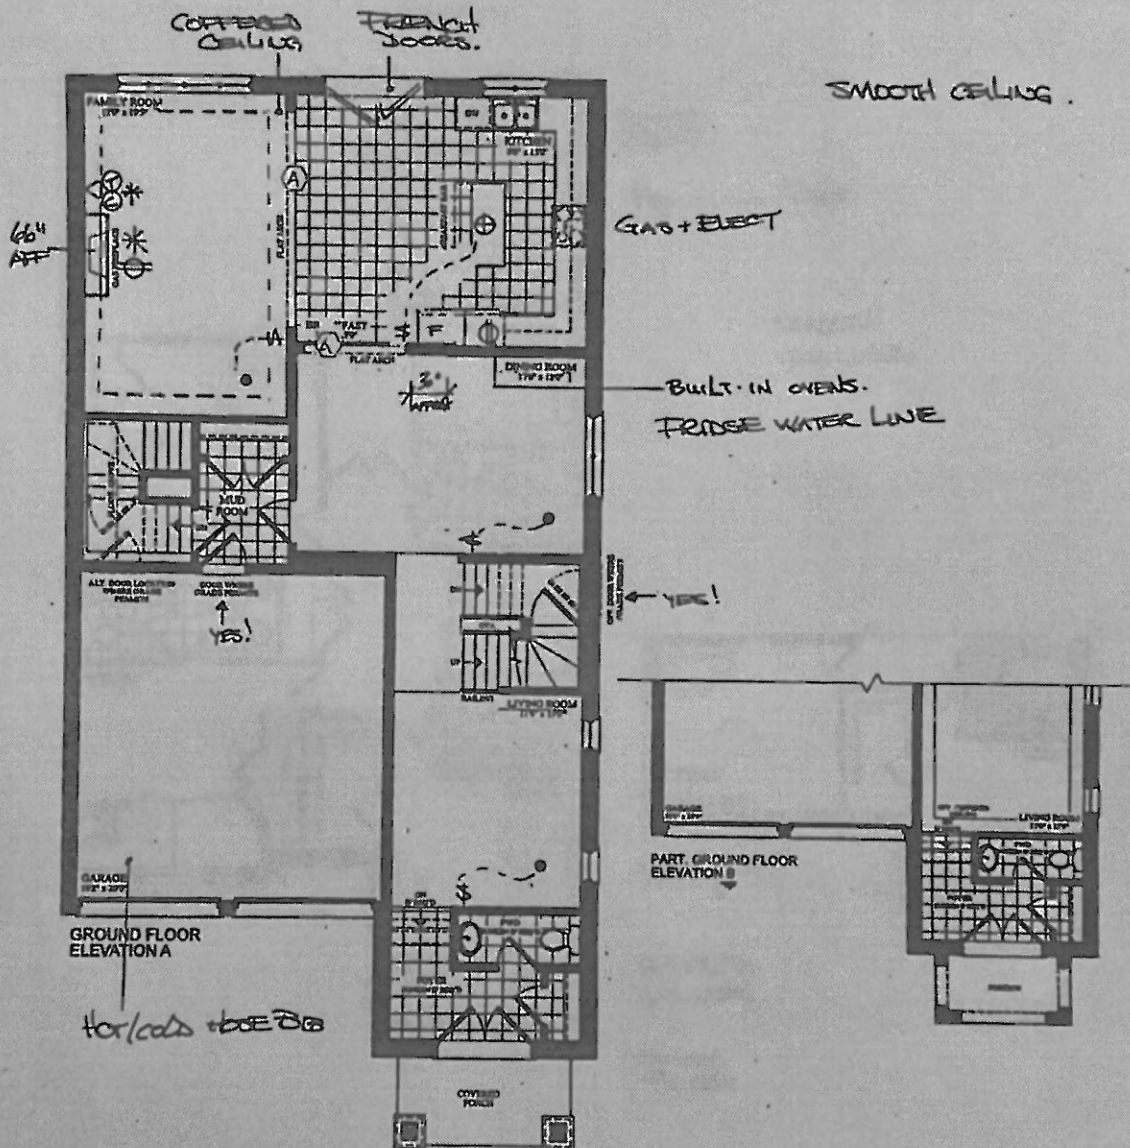

VENDOR

PURCHASER

PURCHASER

GOLDPARK  
WORTH MORE™

Prices, figures, illustrations, sizes, features and finishes are subject to change without notice. Areas and dimensions are approximate and actual usable floor space may vary from the stated area. Layout may be reverse of the unit purchased. E. & O.E.


encore  
BRAMPTON

SCHEDULE 'F'

REZ-122 (KC)  
April 16 2020

# The Schumann 38' SERIES

Elevation A • 3,050 sq.ft.  
→ Elevation B • 3,050 sq.ft.

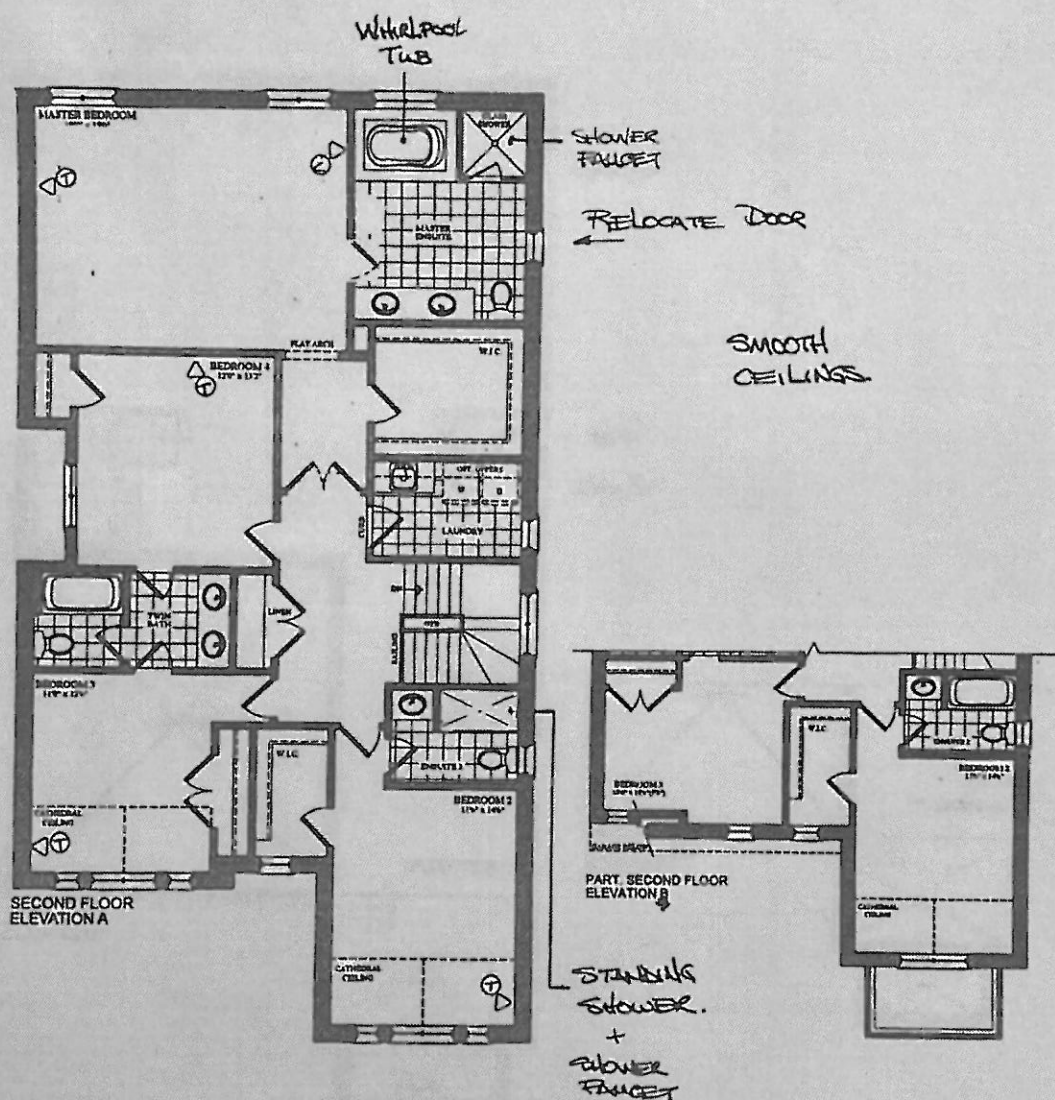

VENDOR \_\_\_\_\_  
PURCHASER \_\_\_\_\_  
PURCHASER \_\_\_\_\_

**GOLDPARK**  
WORTH MORE™

Prices, figures, illustrations, sizes, features and finishes are subject to change without notice. Areas and dimensions are approximate and actual usable floor space may vary from the stated area. Layout may be reverse of the unit purchased. E. & O.E.

