

ELECTRICAL

Invoice	Qty.	Description
2362 33837 25May20 NoCat	1	GREAT ROOM : INTERIOR WALL OUTLET - ADDITIONAL 110V WALL RECEPTACLE ON EXISTING CIRCUIT - LOCATE APPROX. 66" A.F.F, ABOVE FIREPLACE
2362 33842 25May20 NoCat	1	CONDUIT PIPE - FROM ATTIC TO BASEMENT - FROM APPROX. CENTER OF ATTIC TO ELECTRICAL PANEL IN BASEMENT
2362 33856 25May20 ** NoCat	1	GREAT ROOM - OPT. WAFFLE CEILING, BEAM DETAIL AS PER PLAN (9 BOXES) OPTION # 1 CTR-B07
2362 33878 25May20 NoCat	1	GREAT ROOM- FIREPLACE: ADD HEAT ACTIVATED FAN
2362 33890 25May20 NoCat	1	ENSUITE 2: UPGRADE TO STANDING SHOWER IN LIEU OF TUB (INCLUDES TILE BASE, POTLIGHT IN CEILING & FRAMELESS GLASS ENCLOSURE)
2362 33894 25May20 NoCat	6	GREAT ROOM: 4" E/S LED INTERIOR POT LIGHT - GROUND FLOOR - EACH - INCLUDES 1 SWITCH

ELECTRICAL POTLIGHT

Invoice	Qty.	Description
2362 33891 25May20 NoCat	1	ENSUITE 2: UPGRADE TO STANDING SHOWER IN LIEU OF TUB (INCLUDES TILE BASE, POTLIGHT IN CEILING & FRAMELESS GLASS ENCLOSURE)
2362 33895 25May20 NoCat	6	GREAT ROOM: 4" E/S LED INTERIOR POT LIGHT - GROUND FLOOR - EACH - INCLUDES 1 SWITCH

FIREPLACE

Invoice	Qty.	Description
2362 33877 25May20 NoCat	1	GREAT ROOM- FIREPLACE: ADD HEAT ACTIVATED FAN

FORMING

Invoice	Qty.	Description
2362 33822 25May20 NoCat	1	BASEMENT WINDOWS - UPGRADE WINDOW SIZE TO: (30" X 24") - 8" FRAME

NETWORK AND WIRING

Invoice	Qty.	Description
2362 33826 25May20 NoCat	2	GREAT ROOM & MASTER BEDROOM - ADDITIONAL CAT6 ETHERNET OUTLET - SEE PLAN FOR LOCATION
2362 33835 25May20 NoCat	1	GREAT ROOM : CONDUIT PIPE - FOR WALL MOUNT TV - LOCATE APPROX. 66" A.F.F, ABOVE FIREPLACE, TERMINATING AT CABLE LOCATION
2362 33839 25May20 NoCat	1	CONDUIT PIPE - FROM ATTIC TO BASEMENT - FROM APPROX. CENTER OF ATTIC TO ELECTRICAL PANEL IN BASEMENT
2362 33863 25May20 NoCat	1	NOTE: DO *NOT* INSTALL STANDARD TELEPHONE

PAINT

Invoice	Qty.	Description
2362 33847 25May20 NoCat	1	GREAT ROOM - OPT. COFFERED CEILING AS PER PLAN
2362 33851 25May20 NoCat	1	GREAT ROOM - OPT. WAFFLE CEILING, BEAM DETAIL AS PER PLAN (9 BOXES) OPTION # 1 CTR-B07
2362 33874 25May20 NoCat	1	2ND FLOOR: UPGRADE DOORS TO 8' SOLID-CORE INTERIOR DOORS *NOTE: EXTENDED DOOR HEIGHT & SOLID CORE REQUESTED*
2362 33875 25May20 NoCat	1	MAIN FLOOR: UPGRADE DOORS TO 9' SOLID-CORE INTERIOR DOORS
2362 33856 25May20 ** NoCat	1	GREAT ROOM - OPT. WAFFLE CEILING, BEAM DETAIL AS PER PLAN (9 BOXES) OPTION # 1 CTR-B07

GOLDPARK

WORTH MORE™

CONSTRUCTION SUMMARY

Lot: 15

Model: 40.06 A LILAC

Project/Phase: Pine Valley Forevergreen / 1

PLUMBING

Invoice	Qty.	Description
2362 33843 25May20 NoCat	1	KITCHEN : ROUGH IN - 1/4" COLD WATERLINE TO FRIDGE
2362 33885 25May20 NoCat	1	MASTER ENSUITE: SHOWER BENCH COMPLETE WITH STANDARD TILE AND MATCHING MARBLE JAMB COLOUR SEAT TOP
2362 33888 25May20 NoCat	1	ENSUITE 2: UPGRADE TO STANDING SHOWER IN LIEU OF TUB (INCLUDES TILE BASE, POTLIGHT IN CEILING & FRAMELESS GLASS ENCLOSURE)
2362 33892 25May20 NoCat	1	MASTER ENSUITE: UPGRADE TO MOEN 'ARRIS' POSI-TEMP 3-FUNCTION RAIN SHOWER (from ceiling) + HAND SHOWER WITH SLIDE BAR - CHROME #TS2200EP/ 3372/ TS23005/ 62320/ 3887EP/ A725

PLUMBING FIXTURES

Invoice	Qty.	Description
2362 33893 25May20 NoCat	1	MASTER ENSUITE: UPGRADE TO MOEN 'ARRIS' POSI-TEMP 3-FUNCTION RAIN SHOWER (from ceiling) + HAND SHOWER WITH SLIDE BAR - CHROME #TS2200EP/ 3372/ TS23005/ 62320/ 3887EP/ A725

ROUGH CARPENTRY

Invoice	Qty.	Description
2362 33856 25May20 ** NoCat	1	GREAT ROOM - OPT. WAFFLE CEILING, BEAM DETAIL AS PER PLAN (9 BOXES) OPTION # 1 CTR-B07

WINDOWS - BASEMENT

Invoice	Qty.	Description
2362 33821 25May20 NoCat	1	BASEMENT WINDOWS - UPGRADE WINDOW SIZE TO: (30" X 24") - 8" FRAME

WINDOWS AND DOORS

Invoice	Qty.	Description
2362 33861 25May20 NoCat	1	MASTER BEDROOM - DRESSING ROOM - SUN TUNNEL EXTENSION, 6' RIGID TUNNEL EXTENSION [2TR 6'] - UP TO 6' MAX.
2362 33867 25May20 NoCat	7	MAIN FLOOR: UPGRADE DOORS TO 9' SOLID-CORE INTERIOR DOORS
2362 33868 25May20 NoCat	18	2ND FLOOR: UPGRADE DOORS TO 8' SOLID-CORE INTERIOR DOORS *NOTE: EXTENDED DOOR HEIGHT & SOLID CORE REQUESTED*

ryDiscipline.rpt 06May20

Page 8 of 8

Printed and Sent: 25-May-20

SCHEDULE 'F'



PV-15 ^{see attached}
APRIL 9 2020

PV-15
MAY 5 2020 (WS)

The Lilac

40' SERIES

→ Elevation A • 3,425 sq.ft.
Elevation B • 3,385 sq.ft.

24x30"

~~35x47~~

UNFINISHED BASEMENT

24x30"

LOCATION MAY VARY

HWT

F

HRV

FIN. FOYER

3 PC. R/I

UP

LOW HEADROOM

BACK-FLOW PREVENTER VALVE

COLD CELLAR

UNFINISHED BASEMENT

UNEXCAVATED

BASEMENT | ELEV. A

VENDOR	
PURCHASER	
PURCHASER	

GOLDPARK
WORTH MORE™

Prices, figures, illustrations, sizes, features and finishes are subject to change without notice. Areas and dimensions are approximate and actual usable floor space may vary from the stated area. Layout may be reverse of the unit purchased. E. & O.E. 4006



SCHEDULE 'F'

PV-15 *see attached*
April 9 2020

PV-15 *WS*
May 5 2020

The Lilac

40' SERIES


→ Elevation A • 3,425 sq.ft.
Elevation B • 3,385 sq.ft.

No PHONE
THRU OUT

COFFER +
WAFFLE

9' DOORS
ON MAIN
FLOOR

COFFER

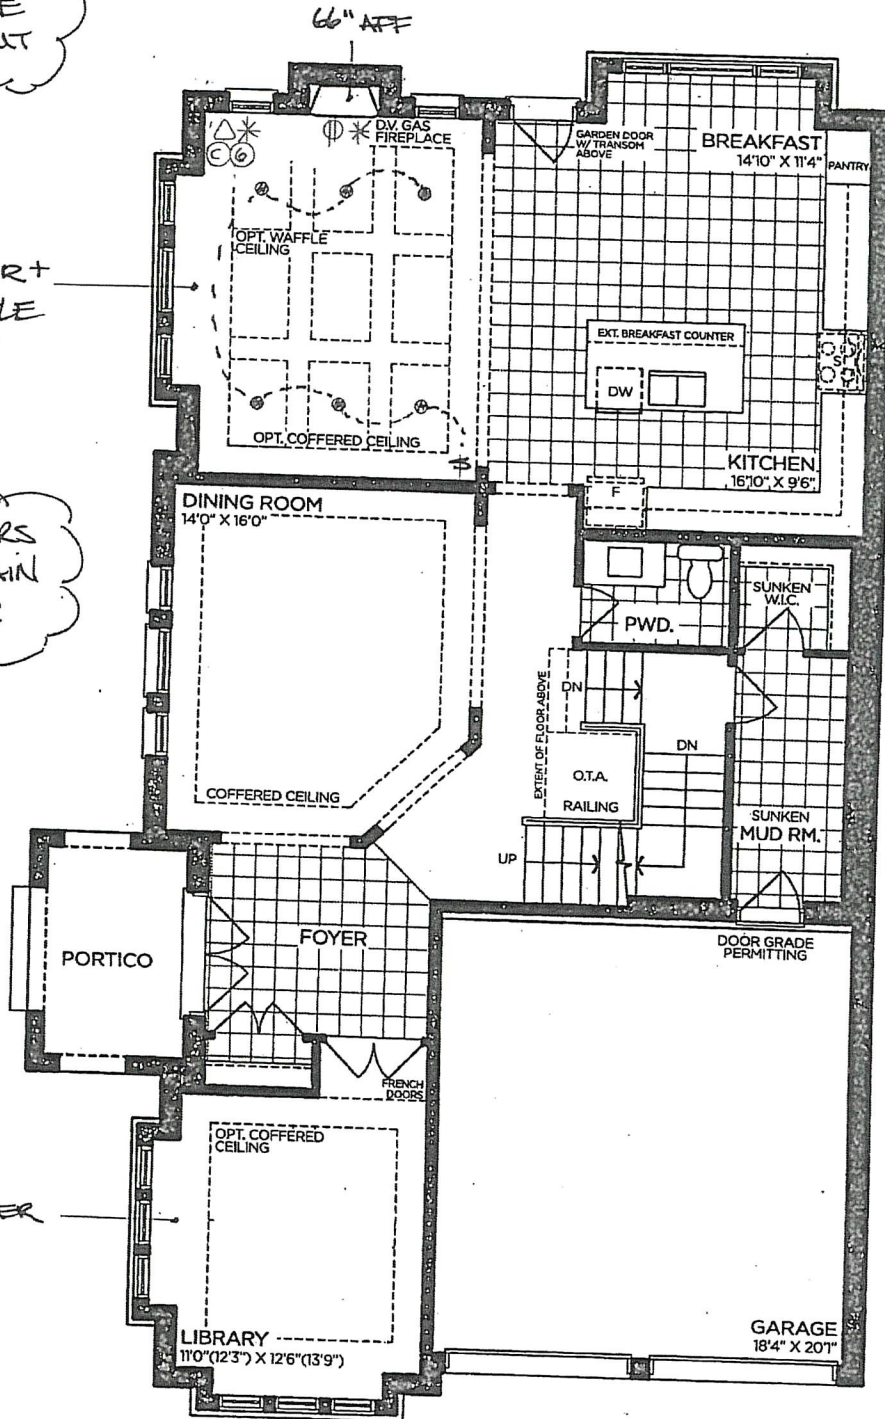

GROUND FLOOR | ELEV. A

VENDOR	
PURCHASER	
PURCHASER	

GOLDPARK
WORTH MORE™

Prices, figures, illustrations, sizes, features and finishes are subject to change without notice. Areas and dimensions are approximate and actual usable floor space may vary from the stated area. Layout may be reverse of the unit purchased. E. & O.E. 4006

SCHEDULE 'F'



PV-15. *see attached*

April 9, 2020

PV-15


MAY 5, 2020 *(WS)*

The Lilac

40' SERIES

→ Elevation A • 3,425 sq.ft.
Elevation B • 3,385 sq.ft.

8' doors
on 2nd
floor

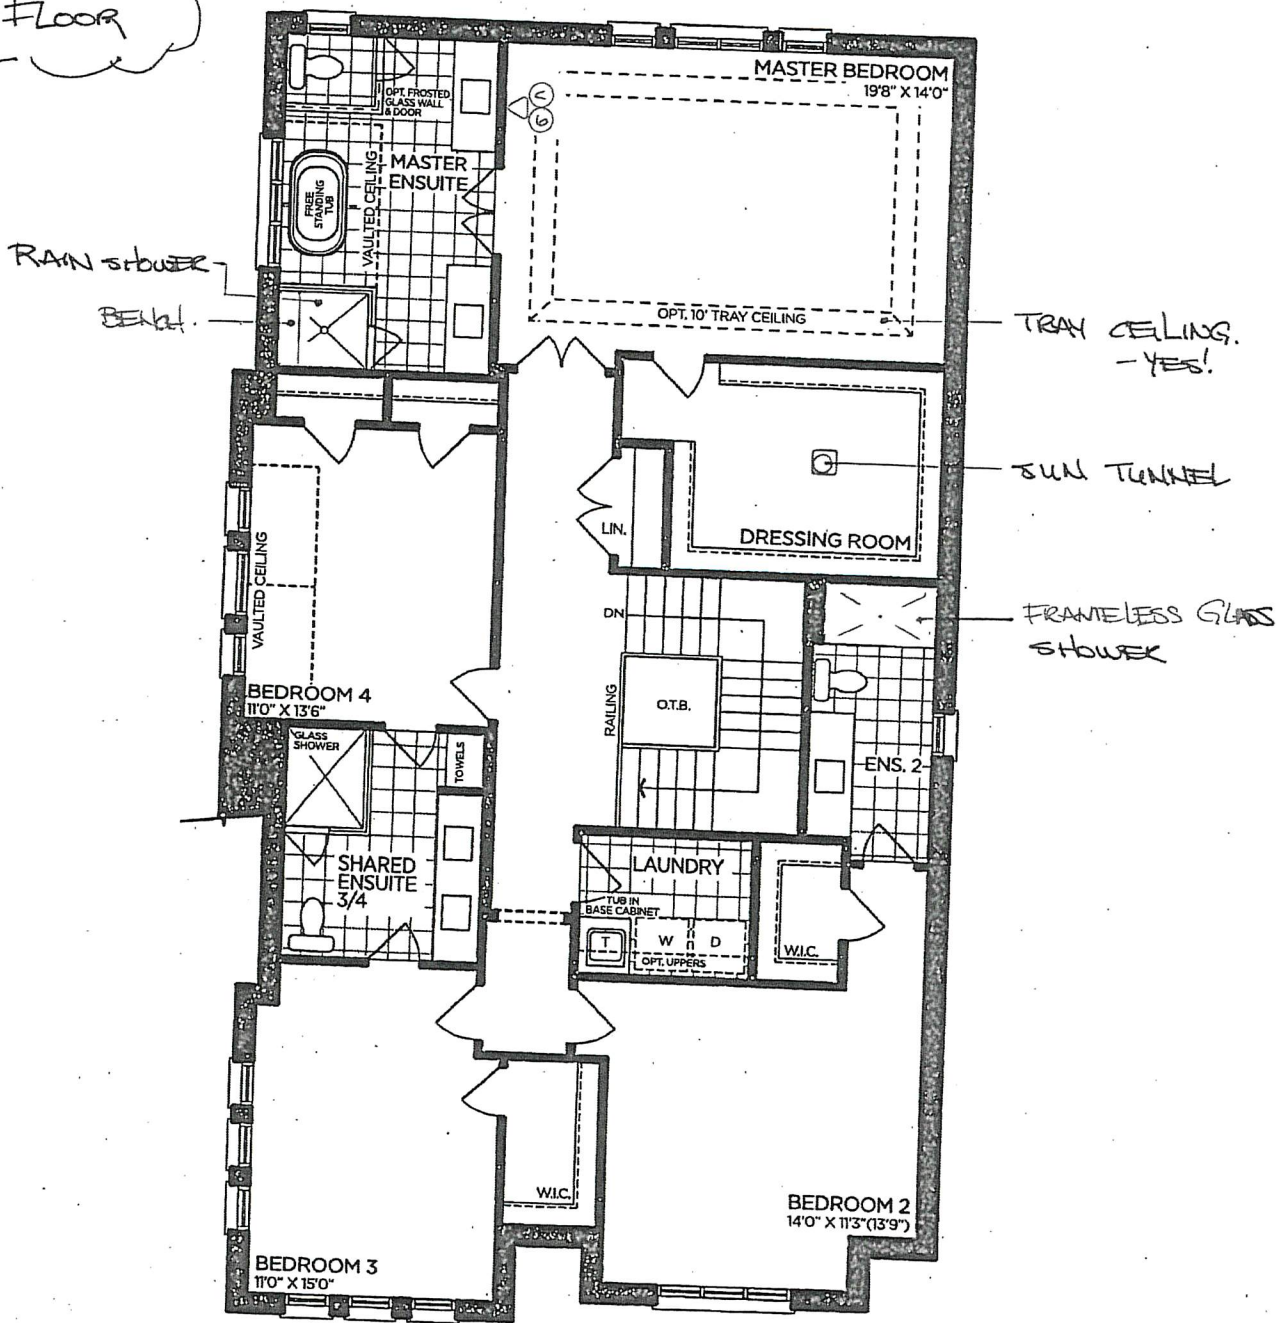

SECOND FLOOR | ELEV. A

VENDOR	
PURCHASER	
PURCHASER	

GOLDPARK
WORTH MORE™

Prices, figures, illustrations, sizes, features and finishes are subject to change without notice. Areas and dimensions are approximate and actual usable floor space may vary from the stated area. Layout may be reverse of the unit purchased. E. & O.E. 4006

POSI-TEMP SHOWER ONLY* W/3 FUNCTION TRANSFER VALVE
TRIM AND SLIDE BAR W/HAND SHOWER

MOEN - ARRIS



☒ CHROME

☐ BRUSHED NICKEL

☐ MATTE BLACK

☐ from WALL

☒ from CEILING

MODEL TS22002EP / 3372 / TS23005 / 62320 / 3887EP / A725

Lot#
15

Room:
MASTER EN SUITE

Signature:
(WS)

Date:
MAY 5 2020

Signature: