

**DRYWALL**

Invoice	Qty.	Description
2338 33937 25May20 NoCat	1	- GREAT ROOM - OPT. COFFERED CEILING AS PER PLAN
2338 33941 25May20 NoCat	1	- GREAT ROOM - OPT. WAFFLE CEILING, BEAM DETAIL AS PER PLAN (9 BOXES) OPTION # 1 CTR-B07
2338 33945 25May20 NoCat	1	- LIBRARY - OPT. LIBRARY COFFERED CEILING AS PER PLAN
2338 33949 25May20 NoCat	1	- LIBRARY - OPT. WAFFLE CEILING, BEAM DETAIL AS PER PLAN (4 BOXES) OPTION #1 CTR-B07
2338 33953 25May20 NoCat	1	- GREAT ROOM/KITCHEN: REDUCE WIDTH OF ARCHWAY - LEAVE NIBB WALLS EVEN ON BOTH SIDES - APPROX. 30" - SEE PLAN FOR LOCATION
2338 33957 25May20 NoCat	1	- MASTER BEDROOM - OPT. 10 FOOT TRAY CEILING AS PER PLAN - SQUARE OFF LIKE ELEVATION C
2338 33961 25May20 NoCat	1	- DRESSING ROOM: SUN TUNNEL EXTENSION, 6 FOOT RIGID TUNNEL EXTENSION [2TR 6 FOOT ] - UP TO 6 FOOT MAX.

**ELECTRICAL**

**Invoice Qty. Description**

2338 33903 25May20 NoCat	2	- KITCHEN: ROUGH-IN FOR CAPPED CEILING OUTLET ( FUTURE LIGHT FIXTURE) - EACH
2338 33904 25May20 NoCat	1	- KITCHEN: ADDITIONAL INTERIOR SWITCH - FOR ISLAND LIGHTS
2338 33905 25May20 NoCat	6	- KITCHEN: 4" E/S LED INTERIOR POT LIGHT - GROUND FLOOR - EACH INCLUDES 1 SWITCH
2338 33912 25May20 NoCat	1	- KITCHEN: ADDITIONAL 220V RECEPTACLE ON A SEPARATE CIRCUIT - FOR BUILT-IN WALL OVEN - APPLIANCE NOT INCLUDED - DOES NOT INCLUDE BREAKER THAT IS TO BE INSTALLED BY LICENSED ELECTRICIAN AND ARRANGED BY HOMEOWNER AFTER CLOSING
2338 33913 25May20 NoCat	1	- KITCHEN: 110V WALL RECEPTACLE ON SEPARATE CIRCUIT - GAS FIRED APPLIANCE - FOR AUX. EQUIPMENT - NOT A STOVE PLUG
2338 33918 25May20 NoCat	8	- GREAT ROOM: 4" E/S LED INTERIOR POT LIGHT - GROUND FLOOR - EACH
2338 33919 25May20 NoCat	1	- GREAT ROOM: ADDITIONAL INTERIOR SWITCH - FOR POTLIGHTS
2338 33920 25May20 NoCat	1	- LIBRARY: UPGRADE STANDARD CEILING MOUNT FIXTURE TO (1) LED POT LIGHT - GROUND FLOOR
2338 33921 25May20 NoCat	3	- LIBRARY: 4" E/S LED INTERIOR POT LIGHT - GROUND FLOOR - EACH
2338 33923 25May20 NoCat	1	- GREAT ROOM: INTERIOR WALL OUTLET: ADDITIONAL 110V WALL INTERIOR RECEPTACLE ON EXISTING CIRCUIT FOR WALL MOUNTED TV - LOCATE APPROX. 66" A.F.F. ABOVE FIREPLACE

**FORMING**

**Invoice Qty. Description**

2257 33927 25May20 NoCat	1	- BASEMENT WINDOWS - EGRESS BASEMENT WINDOW 47 " X 35" - 8" FRAME
2257 33928 25May20 NoCat	1	- BASEMENT WINDOWS - UPGRADE BASEMENT WINDOW SIZE TO 30 " X 24" - 8" FRAME

**FRAMING**

Invoice	Qty.	Description
2257 33934 25May20 NoCat	1	- BASEMENT WINDOWS - UPGRADE BASEMENT WINDOW SIZE TO 30 " X 24" - 8" FRAME
2257 33935 25May20 NoCat	1	- BASEMENT WINDOWS - EGRESS BASEMENT WINDOW 47 " X 35" - 8" FRAME
2338 33901 25May20 NoCat	1	- GREAT ROOM - OPT. COFFERED CEILING AS PER PLAN
2338 33902 25May20 NoCat	1	- GREAT ROOM - OPT. WAFFLE CEILING, BEAM DETAIL AS PER PLAN (9 BOXES) OPTION # 1 CTR-B07
2338 33906 25May20 NoCat	1	- LIBRARY - OPT. LIBRARY COFFERED CEILING AS PER PLAN
2338 33907 25May20 NoCat	1	- LIBRARY - OPT. WAFFLE CEILING, BEAM DETAIL AS PER PLAN (4 BOXES) OPTION #1 CTR-B07
2338 33910 25May20 NoCat	1	- GREAT ROOM/KITCHEN: REDUCE WIDTH OF ARCHWAY - LEAVE NIBB WALLS EVEN ON BOTH SIDES - APPROX. 30" - SEE PLAN FOR LOCATION
2338 33915 25May20 NoCat	1	- MASTER BEDROOM - OPT. 10 FOOT TRAY CEILING AS PER PLAN - SQUARE OFF LIKE ELEVATION C
2338 33924 25May20 NoCat	1	- DRESSING ROOM: SUN TUNNEL EXTENSION, 6 FOOT RIGID TUNNEL EXTENSION [2TR 6 FOOT ] - UP TO 6 FOOT MAX.
2338 33964 25May20 NoCat	18	- 2ND FLOOR: INCREASE HEIGHT OF DOOR TO 8FT SECOND FLOOR - 18 DOORS TOTAL
2338 33967 25May20 NoCat	5	- MAIN FLOOR: UPGRADE TO 9' DOORS **EXCLUDING** MUD ROOM AND MUDROOM WIC

**HVAC**

Invoice	Qty.	Description
2338 33917 25May20 NoCat	1	- KITCHEN: GAS LINE ROUGH-IN - MAIN FLOOR FOR GAS COOKTOP - SEE PLAN FOR LOCATION

**INTERIOR TRIM AND DOORS**

Invoice	Qty.	Description
2338 33930 25May20 NoCat	1	GREAT ROOM/KITCHEN: REDUCE WIDTH OF ARCHWAY - LEAVE NIBB WALLS EVEN ON BOTH SIDES - APPROX. 30" - SEE PLAN FOR LOCATION
2338 33936 25May20 NoCat	1	- GREAT ROOM - OPT. COFFERED CEILING AS PER PLAN
2338 33940 25May20 NoCat	1	- GREAT ROOM - OPT. WAFFLE CEILING, BEAM DETAIL AS PER PLAN (9 BOXES) OPTION # 1 CTR-B07
2338 33944 25May20 NoCat	1	- LIBRARY - OPT. LIBRARY COFFERED CEILING AS PER PLAN
2338 33948 25May20 NoCat	1	- LIBRARY - OPT. WAFFLE CEILING, BEAM DETAIL AS PER PLAN (4 BOXES) OPTION #1 CTR-B07
2338 33952 25May20 NoCat	1	- GREAT ROOM/KITCHEN: REDUCE WIDTH OF ARCHWAY - LEAVE NIBB WALLS EVEN ON BOTH SIDES - APPROX. 30" - SEE PLAN FOR LOCATION
2338 33956 25May20 NoCat	1	- MASTER BEDROOM - OPT. 10 FOOT TRAY CEILING AS PER PLAN - SQUARE OFF LIKE ELEVATION C
2338 33960 25May20 NoCat	1	- DRESSING ROOM: SUN TUNNEL EXTENSION, 6 FOOT RIGID TUNNEL EXTENSION [2TR 6 FOOT ] - UP TO 6 FOOT MAX.
2338 33963 25May20 NoCat	18	- 2ND FLOOR: INCREASE HEIGHT OF DOOR TO 8FT SECOND FLOOR - 18 DOORS TOTAL
2338 33966 25May20 NoCat	5	- MAIN FLOOR: UPGRADE TO 9' DOORS **EXCLUDING** MUD ROOM AND MUDROOM WIC

**MISC.**

Invoice	Qty.	Description
2257 31991 25May20 NoCat	1	BONUS PACKAGE: \$30,000.00 (INCLUDING TAXES) WORTH OF UPGRADES FROM GOLD PARK HOMES DÉCOR CENTRE IS BEING APPLIED TOWARD THIS ORDER. PURCHASER HAS A REMAINING AMOUNT OF \$29,355.90 (INCLUDING TAXES).

**MODEL OPTIONS 40.06.A**

Invoice	Qty.	Description
2338 33939 25May20 NoCat	1	- GREAT ROOM - OPT. COFFERED CEILING AS PER PLAN
2338 33943 25May20 NoCat	1	- GREAT ROOM - OPT. WAFFLE CEILING, BEAM DETAIL AS PER PLAN (9 BOXES) OPTION # 1 CTR-B07
2338 33947 25May20 NoCat	1	- LIBRARY - OPT. LIBRARY COFFERED CEILING AS PER PLAN
2338 33951 25May20 NoCat	1	- LIBRARY - OPT. WAFFLE CEILING, BEAM DETAIL AS PER PLAN (4 BOXES) OPTION #1 CTR-B07
2338 33955 25May20 NoCat	1	- GREAT ROOM/KITCHEN: REDUCE WIDTH OF ARCHWAY - LEAVE NIBB WALLS EVEN ON BOTH SIDES - APPROX. 30" - SEE PLAN FOR LOCATION
2338 33959 25May20 NoCat	1	- MASTER BEDROOM - OPT. 10 FOOT TRAY CEILING AS PER PLAN - SQUARE OFF LIKE ELEVATION C

**NETWORK AND WIRING**

Invoice	Qty.	Description
2338 33922 25May20 NoCat	1	- GREAT ROOM: CONDUIT PIPE - FOR WALL MOUNT TV - LOCATE APPROX. 66" A.F.F. TERMINATING AT CABLE. SEE PLAN FOR LOCATION

**PAINT**

**Invoice Qty. Description**

2338 33938 25May20 NoCat	1	- GREAT ROOM - OPT. COFFERED CEILING AS PER PLAN
2338 33942 25May20 NoCat	1	- GREAT ROOM - OPT. WAFFLE CEILING, BEAM DETAIL AS PER PLAN (9 BOXES) OPTION # 1 CTR-B07
2338 33946 25May20 NoCat	1	- LIBRARY - OPT. LIBRARY COFFERED CEILING AS PER PLAN
2338 33950 25May20 NoCat	1	- LIBRARY - OPT. WAFFLE CEILING, BEAM DETAIL AS PER PLAN (4 BOXES) OPTION #1 CTR-B07
2338 33954 25May20 NoCat	1	- GREAT ROOM/KITCHEN: REDUCE WIDTH OF ARCHWAY - LEAVE NIBB WALLS EVEN ON BOTH SIDES - APPROX. 30" - SEE PLAN FOR LOCATION
2338 33958 25May20 NoCat	1	- MASTER BEDROOM - OPT. 10 FOOT TRAY CEILING AS PER PLAN - SQUARE OFF LIKE ELEVATION C
2338 33965 25May20 NoCat	18	- 2ND FLOOR: INCREASE HEIGHT OF DOOR TO 8FT SECOND FLOOR - 18 DOORS TOTAL
2338 33968 25May20 NoCat	5	- MAIN FLOOR: UPGRADE TO 9' DOORS **EXCLUDING** MUD ROOM AND MUDROOM WIC

**WINDOWS - BASEMENT**

**Invoice Qty. Description**

2257 33932 25May20 NoCat	1	- BASEMENT WINDOWS - EGRESS BASEMENT WINDOW 47 " X 35" - 8" FRAME
2257 33933 25May20 NoCat	1	- BASEMENT WINDOWS - UPGRADE BASEMENT WINDOW SIZE TO 30 " X 24" - 8" FRAME

**WINDOWS AND DOORS**

Invoice	Qty.	Description
2338 33908 25May20 NoCat	18	- 2ND FLOOR: INCREASE HEIGHT OF DOOR TO 8FT SECOND FLOOR - PER DOOR
2338 33909 25May20 NoCat	5	- MAIN FLOOR: UPGRADE TO 9' DOORS **EXCLUDING** MUD ROOM AND MUDROOM WIC
2338 33911 25May20 NoCat	1	- THRU OUT: UPGRADE TO BLACK INTERIOR WINDOWS
2338 33962 25May20 NoCat	1	- DRESSING ROOM: SUN TUNNEL EXTENSION, 6 FOOT RIGID TUNNEL EXTENSION [2TR 6 FOOT ] - UP TO 6 FOOT MAX.

SCHEDULE 'F'




PV-124  
 March 30 2020  
 MAY 8 2020

The Lilac

40' SERIES

→ Elevation A • 3,425 sq.ft.  
 Elevation B • 3,385 sq.ft.

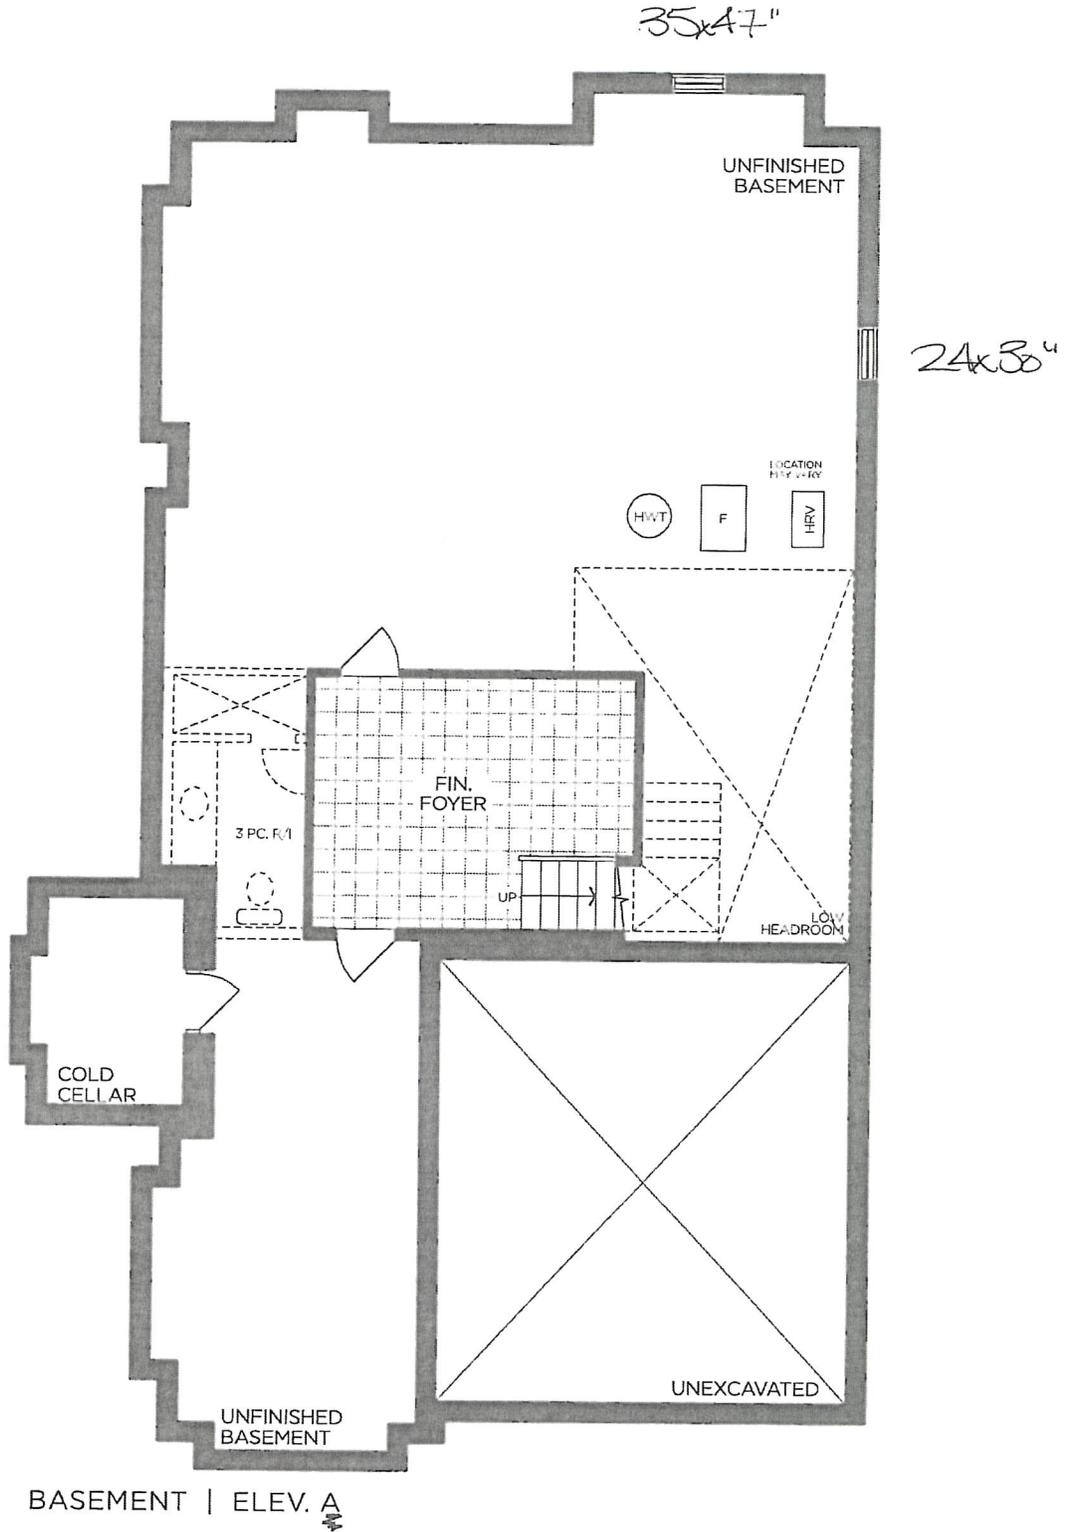

BASEMENT | ELEV. A

VENDOR

PURCHASER

PURCHASER

**GOLDPARK**  
 WORTH MORE™

Prices, figures, illustrations, sizes, features and finishes are subject to change without notice. Areas and dimensions are approximate and actual usable floor space may vary from the stated area. Layout may be reverse of the unit purchased. E. & O.E. 4006

SCHEDULE 'F'




PV-124  
MAY 8 2020

The Lilac  
40' SERIES

Elevation A • 3,425 sq.ft.  
Elevation B • 3,385 sq.ft.

BLACK INTERIOR Windows

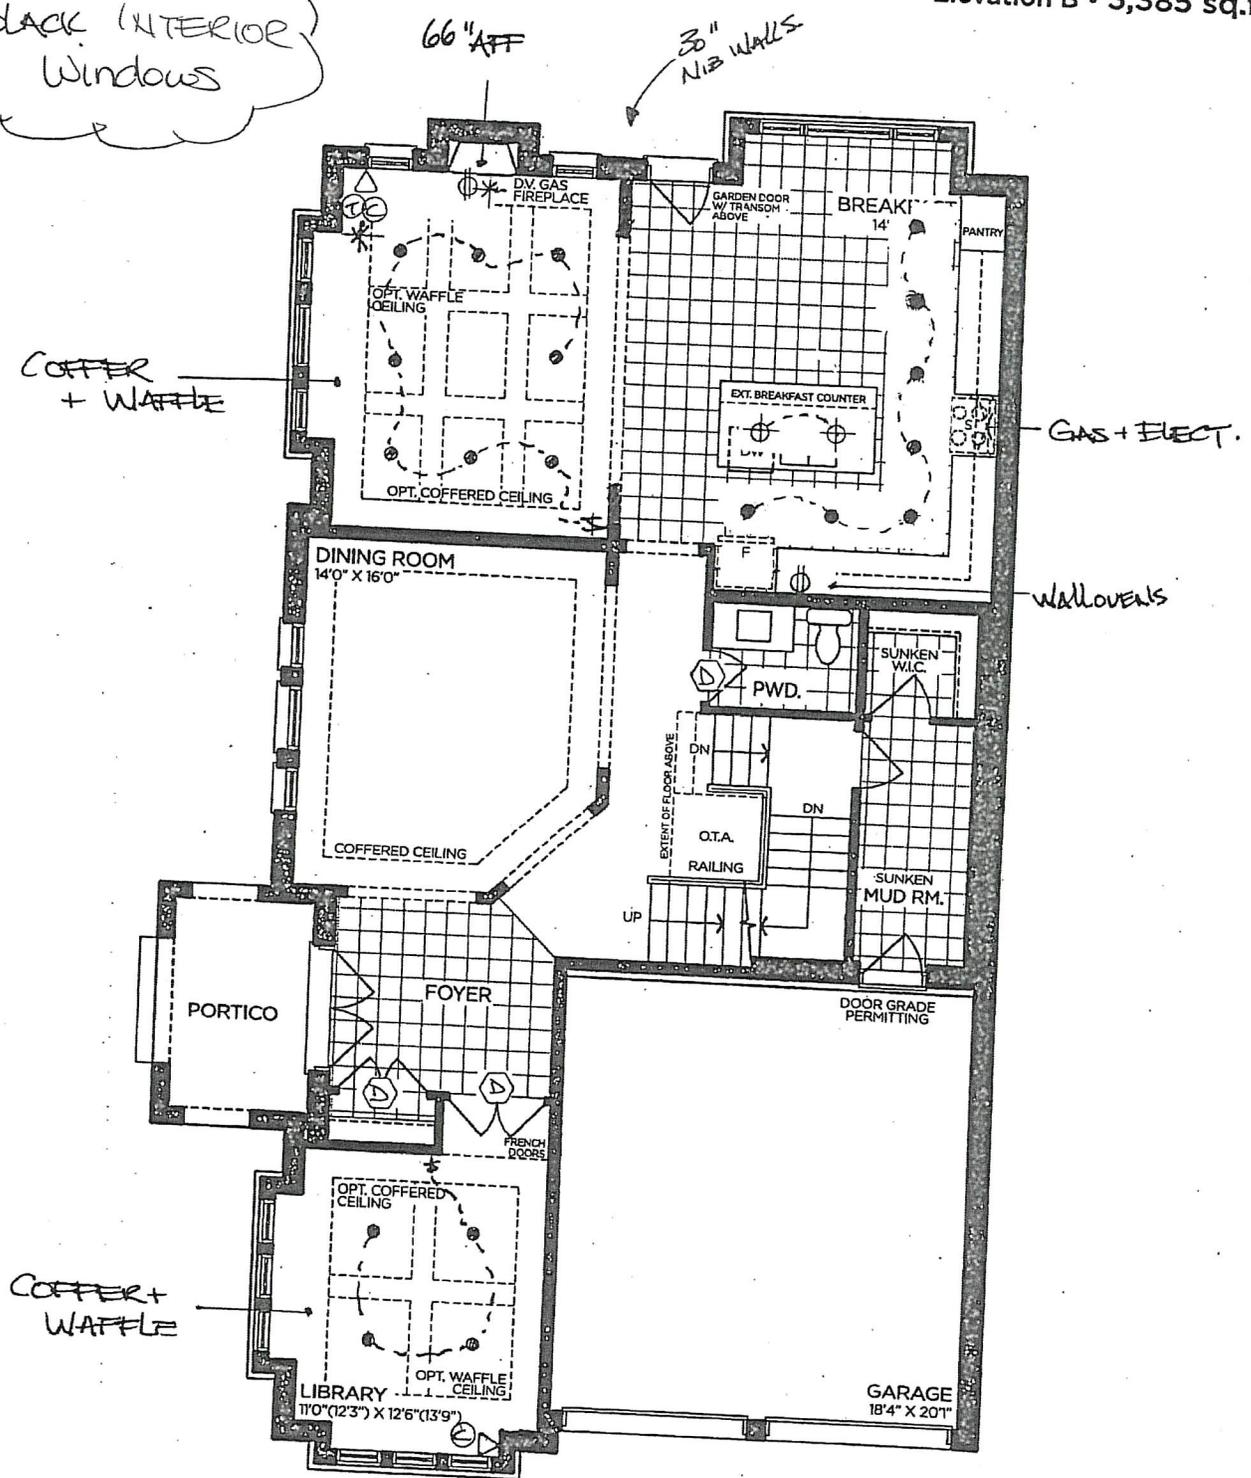

GROUND FLOOR | ELEV. A

VENDOR

PURCHASER

PURCHASER

**GOLDPARK**  
WORTH MORE™

Prices, figures, illustrations, sizes, features and finishes are subject to change without notice. Areas and dimensions are approximate and actual usable floor space may vary from the stated area. Layout may be reverse of the unit purchased. E. & O.E. 4006

SCHEDULE 'F'




PV-124  
MAY 8 2020

The Lilac  
40' SERIES

Elevation A • 3,425 sq.ft.  
Elevation B • 3,385 sq.ft.

8' doors on 2nd floor

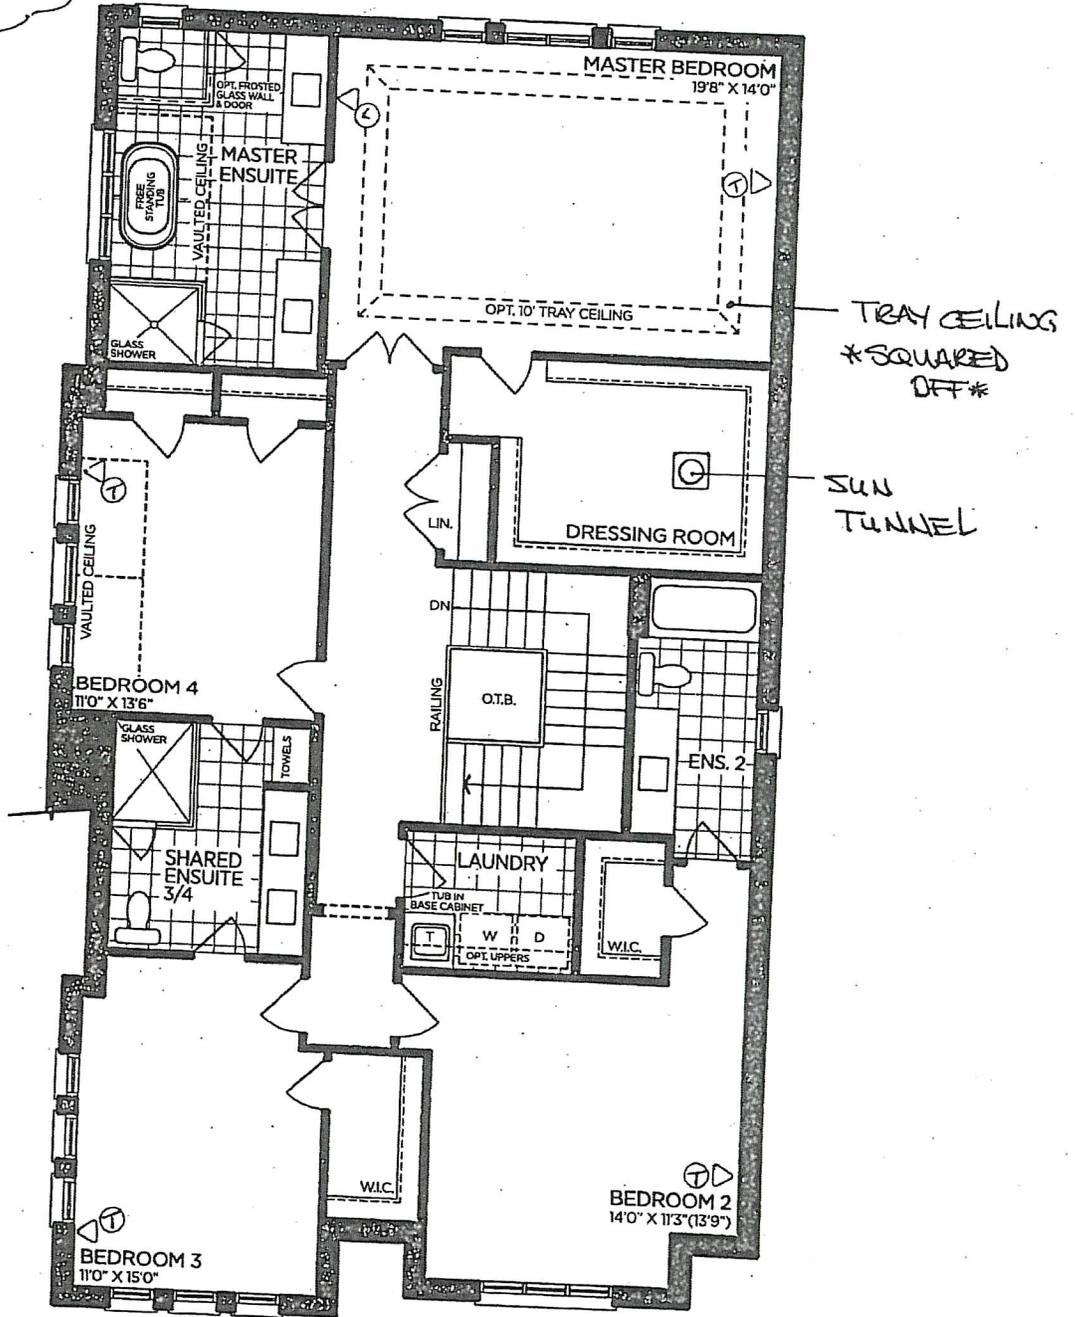

SECOND FLOOR | ELEV. A

VENDOR

PURCHASER

PURCHASER

**GOLDPARK**  
WORTH MORE™

Prices, figures, illustrations, sizes, features and finishes are subject to change without notice. Areas and dimensions are approximate and actual usable floor space may vary from the stated area. Layout may be reverse of the unit purchased. E. & O.E. 4006