



CONSTRUCTION SUMMARY

Lot: 127

Model: 40.03 A BROOKSIDE
Project/Phase: Pine Valley Forevergreen / 1

CERAMIC

Invoice	Qty.	Description
2323 33972 26May20 NoCat	1	ENSUITE 2: **REPLACE STANDARD TUB TO STANDING SHOWER - INCLUDES TILE ON SHOWER BASE AND POT LIGHT IN CEILING - **NO GLASS ENCLOSURE** LEAVE OPEN FOR PURCHASER TO INSTALL OWN AFTER CLOSING..

ELECTRICAL

Invoice	Qty.	Description
2323 32949 26May20	6	MAIN HALL: 4" E/S LED INTERIOR POT LIGHT - GROUND FLOOR - EACH. INSTALL IN LIEU OF STANDARD CEILING LIGHTS - USE STANDARD SWITCH INCLUDED IN APS

FRAMING

Invoice	Qty.	Description
2323 33974 26May20 NoCat	1	ENSUITE 2: **REPLACE STANDARD TUB TO STANDING SHOWER - INCLUDES TILE ON SHOWER BASE AND POT LIGHT IN CEILING - **NO GLASS ENCLOSURE** LEAVE OPEN FOR PURCHASER TO INSTALL OWN AFTER CLOSING.

GLASS AND MIRROR

Invoice	Qty.	Description
2323 33973 26May20 NoCat	1	ENSUITE 2: **REPLACE STANDARD TUB TO STANDING SHOWER - INCLUDES TILE ON SHOWER BASE AND POT LIGHT IN CEILING - **NO GLASS ENCLOSURE** LEAVE OPEN FOR PURCHASER TO INSTALL OWN AFTER CLOSING.

NETWORK AND WIRING

Invoice	Qty.	Description
2323 32951 26May20 NoCat	1	GREAT ROOM: INSTALL STANDARD CABLE APPROX. 66" A.F.F. ABOVE FIREPLACE . (NO ELECTRICAL FOR TV WAS PURCHASED)
2323 32952 26May20 NoCat	1	LOWER MEDIA ROOM: INSTALL STANDARD CABLE APPROX. 66" A.F.F. SEE PLAN FOR LOCATION. NO ELECTRICAL WAS PURCHASED

PLUMBING

Invoice	Qty.	Description
2323 32950 26May20	1	ENSUITE 2: **REPLACE STANDARD TUB TO STANDING SHOWER - INCLUDES TILE ON SHOWER BASE AND POT LIGHT IN CEILING - **NO GLASS ENCLOSURE** LEAVE OPEN FOR PURCHASER TO INSTALL OWN AFTER CLOSING.



SCHEDULE 'F'

PV-127


MAY 13 2020

See attached

The Brookside

40' SERIES

Elevation A • 3,380 sq.ft.
Elevation B • 3,350 sq.ft.

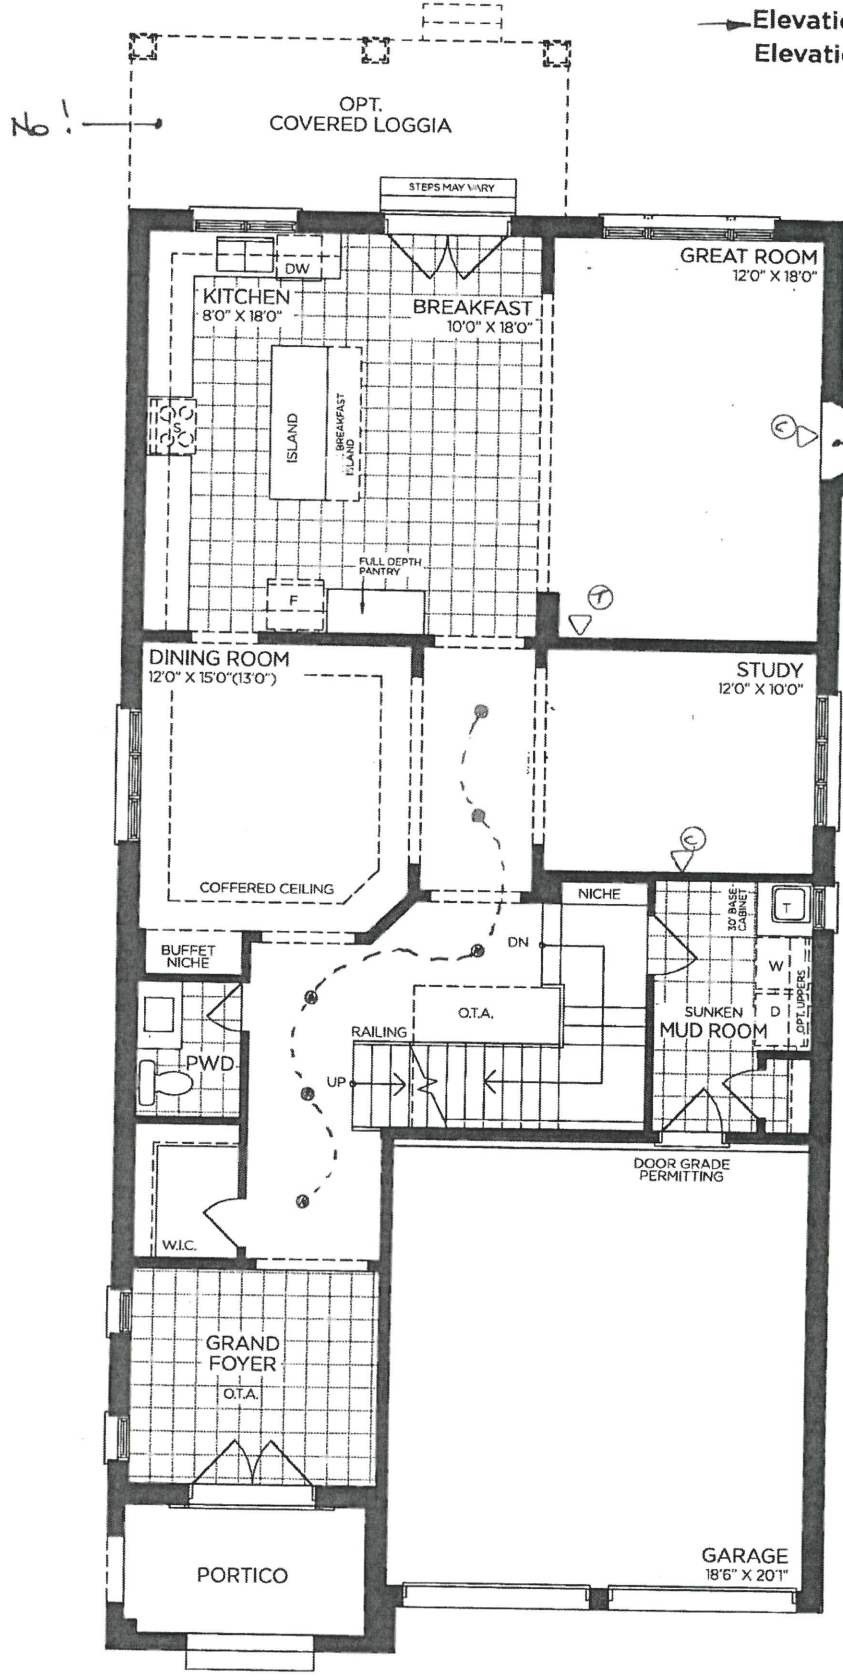

GROUND FLOOR | ELEV. A

VENDOR

PURCHASER

PURCHASER

GOLDPARK
WORTH MORE™

Prices, figures, illustrations, sizes, features and finishes are subject to change without notice. Areas and dimensions are approximate and actual usable floor space may vary from the stated area. Layout may be reverse of the unit purchased. E. & O.E. 4003



SCHEDULE 'F'

PN-127


MAY 13 2020

See attached

The Brookside

40' SERIES

→ Elevation A • 3,380 sq.ft.
Elevation B • 3,350 sq.ft.

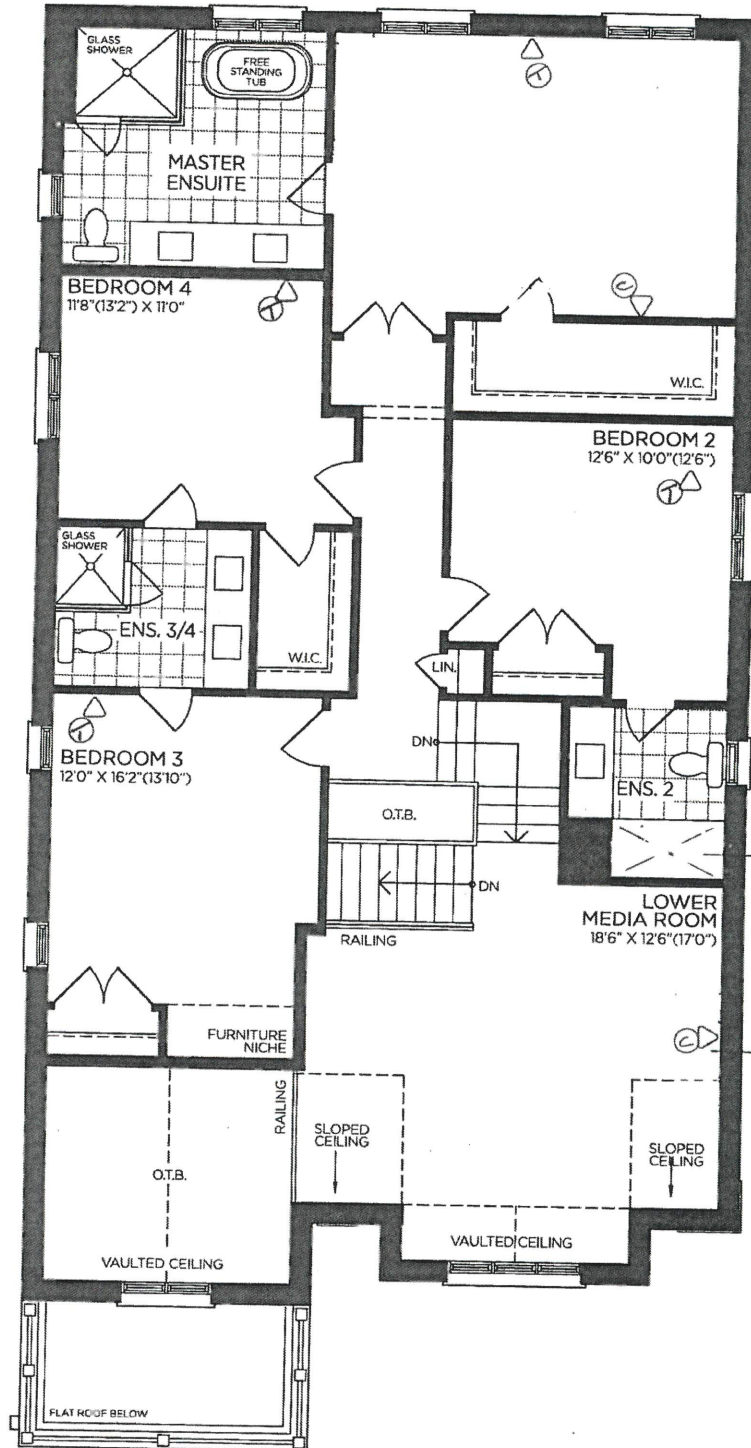

STANDING SHOWER
(NO GLASS ENCLOSURE)

66" AFF
(NO ELECTRICAL
PURCHASED).

SECOND FLOOR | ELEV. A

VENDOR

PURCHASER

PURCHASER

GOLDPARK

WORTH MORE™

Prices, figures, illustrations, sizes, features and finishes are subject to change without notice. Areas and dimensions are approximate and actual usable floor space may vary from the stated area. Layout may be reverse of the unit purchased. E. & O.E. 4003


SCHEDULE 'F'



See attached.
PV-127
MAY 13 2022

The Brookside
40' SERIES

Elevation A • 3,380 sq.ft.
Elevation B • 3,350 sq.ft.

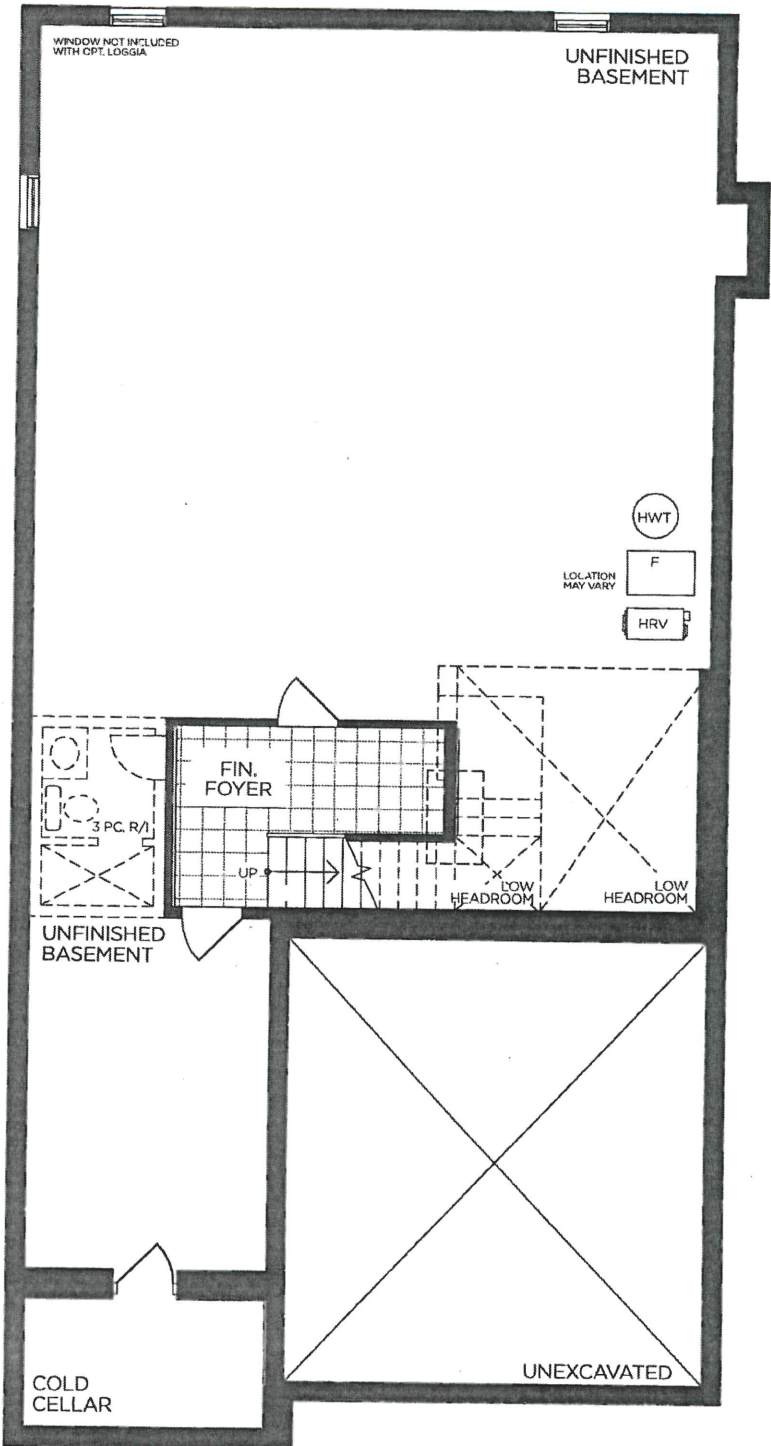

BASEMENT | ELEV. A

VENDOR

PURCHASER

PURCHASER

GOLDPARK
WORTH MORE™

Prices, figures, illustrations, sizes, features and finishes are subject to change without notice. Areas and dimensions are approximate and actual usable floor space may vary from the stated area. Layout may be reverse of the unit purchased. E. & O.E. 4003




SCHEDULE 'F'

PV-127

MAY 13 2020

The Brookside
40' SERIES

Elevation A • 3,380 sq.ft.
Elevation B • 3,350 sq.ft.

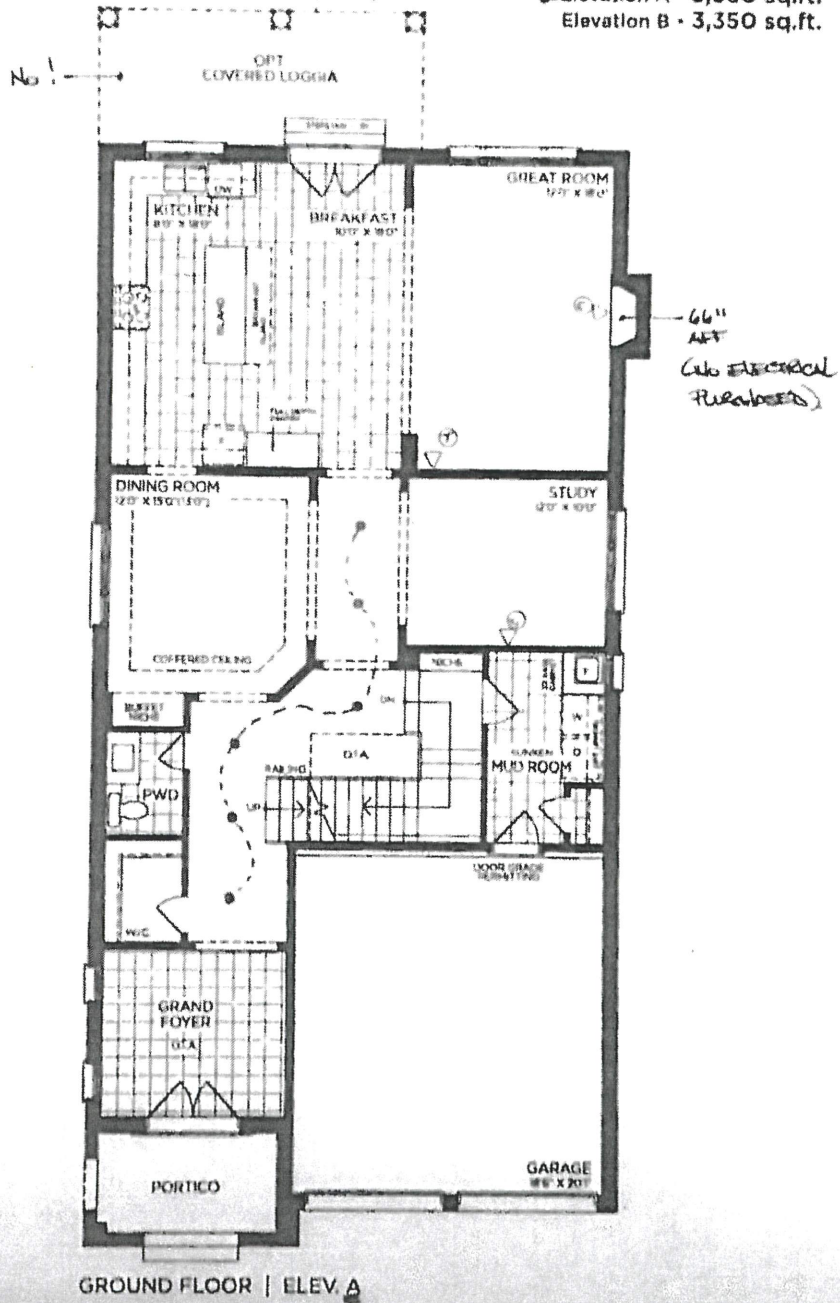

VENDOR
PURCHASER
PURCHASER

GOLDPARK
WORTH MORE®


Prices, figures, illustrations, sizes, features and finishes are subject to change without notice. Areas and dimensions are approximate and actual inside floor space may vary from the stated area. Layout may be reverse of the unit purchased. E & OE 4003

SCHEDULE 'F'



TV-127 **B**
MAY 15 2020

The Brookside
40' SERIES
Elevation A • 3,380 sq.ft.
Elevation B • 3,350 sq.ft.

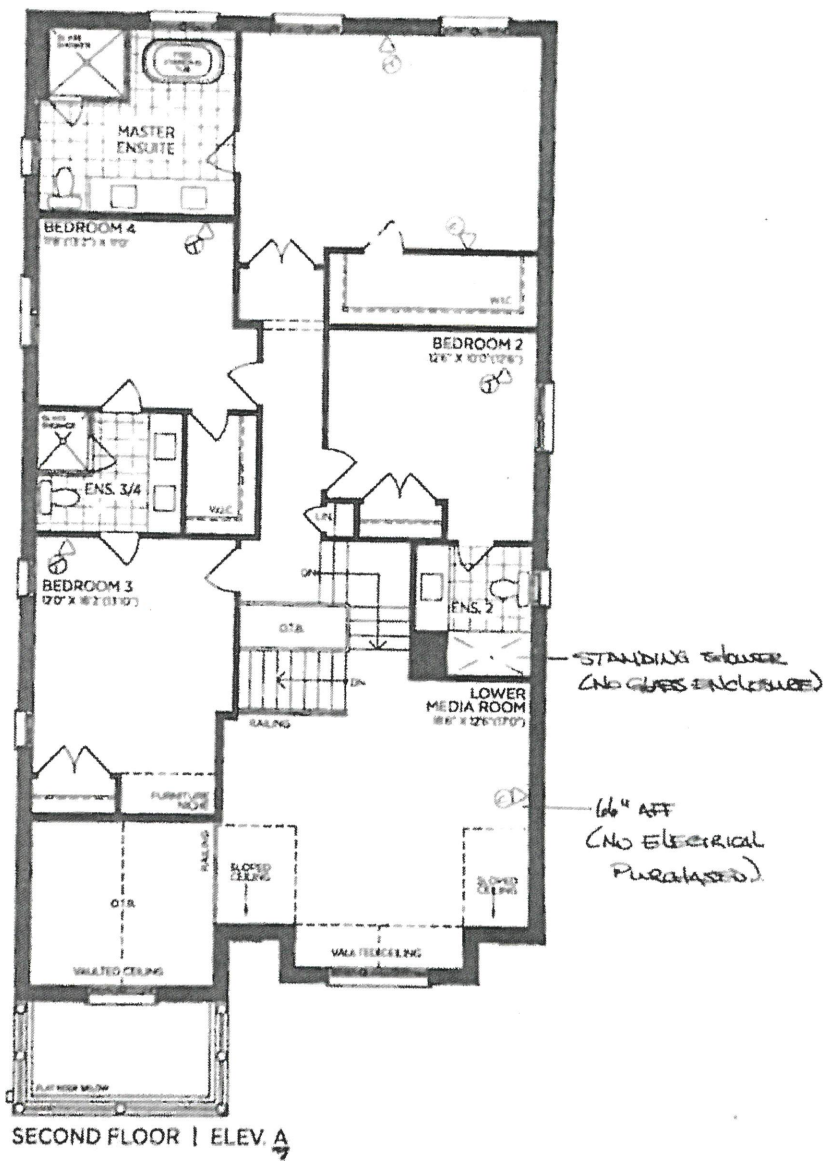

VENDOR

PURCHASER

PURCHASER

GOLDPARK
WORTH MORE


Prices, figures, illustrations, sizes, features and finishes are subject to change without notice. Areas and dimensions are approximate and actual usable floor space may vary from the stated area. Layout may be reverse of the unit purchased. E. & O.E. 4003

SCHEDULE 'F'



PN-127
MAY 13 2022

The Brookside
40' SERIES
Elevation A • 3,380 sq.ft.
Elevation B • 3,350 sq.ft.

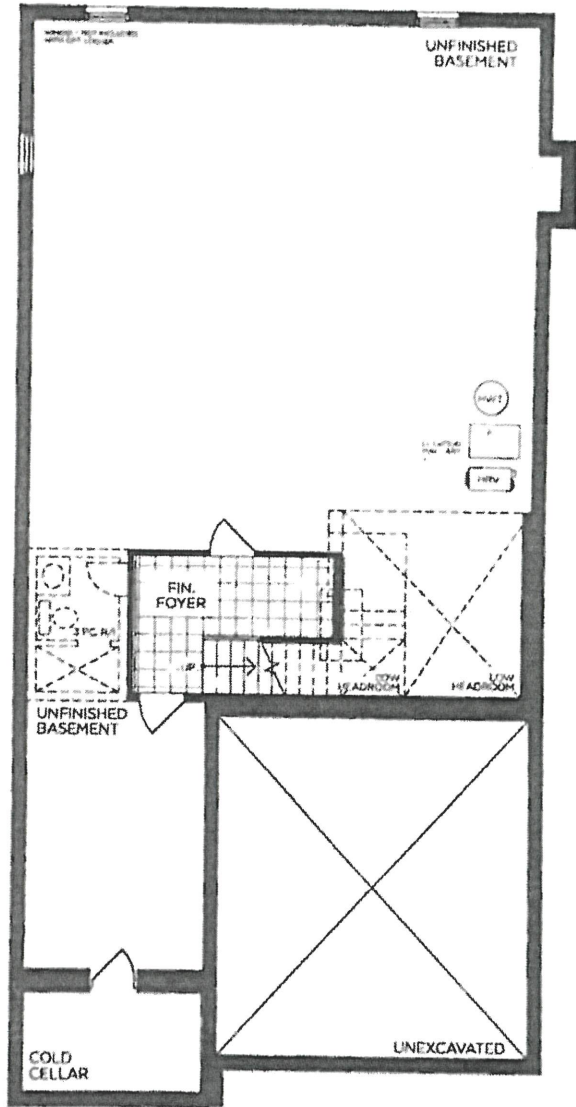

BASEMENT | ELEV. A

VENDOR

PURCHASER

PURCHASER

GOLDPARK
WORTH MORE™

Prices, figures, illustrations, sizes, features and finishes are subject to change without notice. Areas and dimensions are approximate and actual usable floor space may vary from the stated area. Layout may be reverse of the unit purchased. E. & O.E. 4003