



CONSTRUCTION SUMMARY

Lot: 135
Model: 40.03 B BROOKSIDE
Project/Phase: Pine Valley Forevergreen / 1

FORMING

Invoice	Qty.	Description
2270 33985 26May20 NoCat	1	BASEMENT WINDOWS - UPGRADE BASEMENT WINDOW SIZE TO 30 " X 24" - 8" FRAME.

FRAMING

Invoice	Qty.	Description
2270 33986 26May20 NoCat	1	BASEMENT WINDOWS - UPGRADE BASEMENT WINDOW SIZE TO 30 " X 24" - 8" FRAME.
2325 33103 26May20	1	MASTER ENSUITE: SHOWER NICHE [SHAMPOO SHELF] - COMPLETE WITH MATCHING MARBLE JAMBS ON 4 SIDES, STANDARD TILE, APPROX. 12 X 18 INSTALLED VERTICALLY
2325 33983 26May20 NoCat	1	STUDY - OPT. 8 FOOT HIGH DOUBLE FRENCH DOORS WITH FLAT CLEAR GLASS COMPLETE WITH BUILDERS STANDARD OFFERINGS. (#203 FLAT GLASS)

INTERIOR TRIM AND DOORS

Invoice	Qty.	Description
2325 33987 26May20 NoCat	1	STUDY - OPT. 8 FOOT HIGH DOUBLE FRENCH DOORS WITH FLAT CLEAR GLASS COMPLETE WITH BUILDERS STANDARD OFFERINGS. (#203 FLAT GLASS)

NETWORK AND WIRING

Invoice	Qty.	Description
2325 33037 26May20 NoCat	1	THRU OUT: DO NOT INSTALL STANDARD PHONE LINES.
2325 33038 26May20	1	MEDIA ROOM: ADDITIONAL CAT6 ETHERNET OUTLET - SEE PLAN FOR LOCATION.
2325 33039 26May20	1	MEDIA ROOM: CONDUIT PIPE - FOR WALL MOUNT TV - LOCATE APPROX. 66" A.F.F., TERMINATING DIRECTLY BELOW AT CABLE LOCATION.
2325 33092 26May20	1	GREAT ROOM: CONDUIT PIPE - FOR WALL MOUNT TV - LOCATE APPROX 66" A.F.F. ABOVE FIREPLACE, THRU TO BASEMENT AND BACK TO CABLE LOCATION. (SEE PLAN FOR LOCATION) SEE PLAN FOR LOCATION
2325 33102 26May20	1	CONDUIT PIPE - FROM ATTIC TO BASEMENT - FROM ELECTRICAL PANEL TO APPROX CENTER OF ATTIC



CONSTRUCTION SUMMARY

Lot: 135
Model: 40.03 B BROOKSIDE
Project/Phase: Pine Valley Forevergreen / 1

PLUMBING

Invoice	Qty.	Description
2270 33995 26May20 NoCat	1	BACK-FLOW PREVENTER VALVE.
2325 33107 26May20	1	MASTER ENSUITE: 3/4" WATER SUPPLY LINE TO ENSUITE SHOWER IN LIEU OF STANDARD.
2348 33467 26May20 NoCat	1	MASTER ENSUITE: UPGRADE TO MOEN 'ARRIS' RAIN SHOWER (from ceiling) + HANDSHOWER + SLIDE BAR 'CHROME' #TS2200EP/3372/TS23005/62320/3887EP/A725

PLUMBING FIXTURES

Invoice	Qty.	Description
2348 33994 26May20 NoCat	1	MASTER ENSUITE: UPGRADE TO MOEN 'ARRIS' RAIN SHOWER (from ceiling) + HANDSHOWER + SLIDE BAR 'CHROME' #TS2200EP/3372/TS23005/62320/3887EP/A725

WINDOWS - BASEMENT

Invoice	Qty.	Description
2270 33984 26May20 NoCat	1	BASEMENT WINDOWS - UPGRADE BASEMENT WINDOW SIZE TO 30 " X 24" - 8" FRAME.

WINDOWS AND DOORS

Invoice	Qty.	Description
2325 33993 26May20 NoCat	1	STUDY - OPT. 8 FOOT HIGH DOUBLE FRENCH DOORS WITH FLAT CLEAR GLASS COMPLETE WITH BUILDERS STANDARD OFFERINGS. (#203 FLAT GLASS)

SCHEDULE 'F'



MAY 13 2020


PV-135
APRIL 3 2020

MAY 16 2020

The Brookside 40' SERIES

Elevation A • 3,380 sq.ft.

→ Elevation B • 3,350 sq.ft.

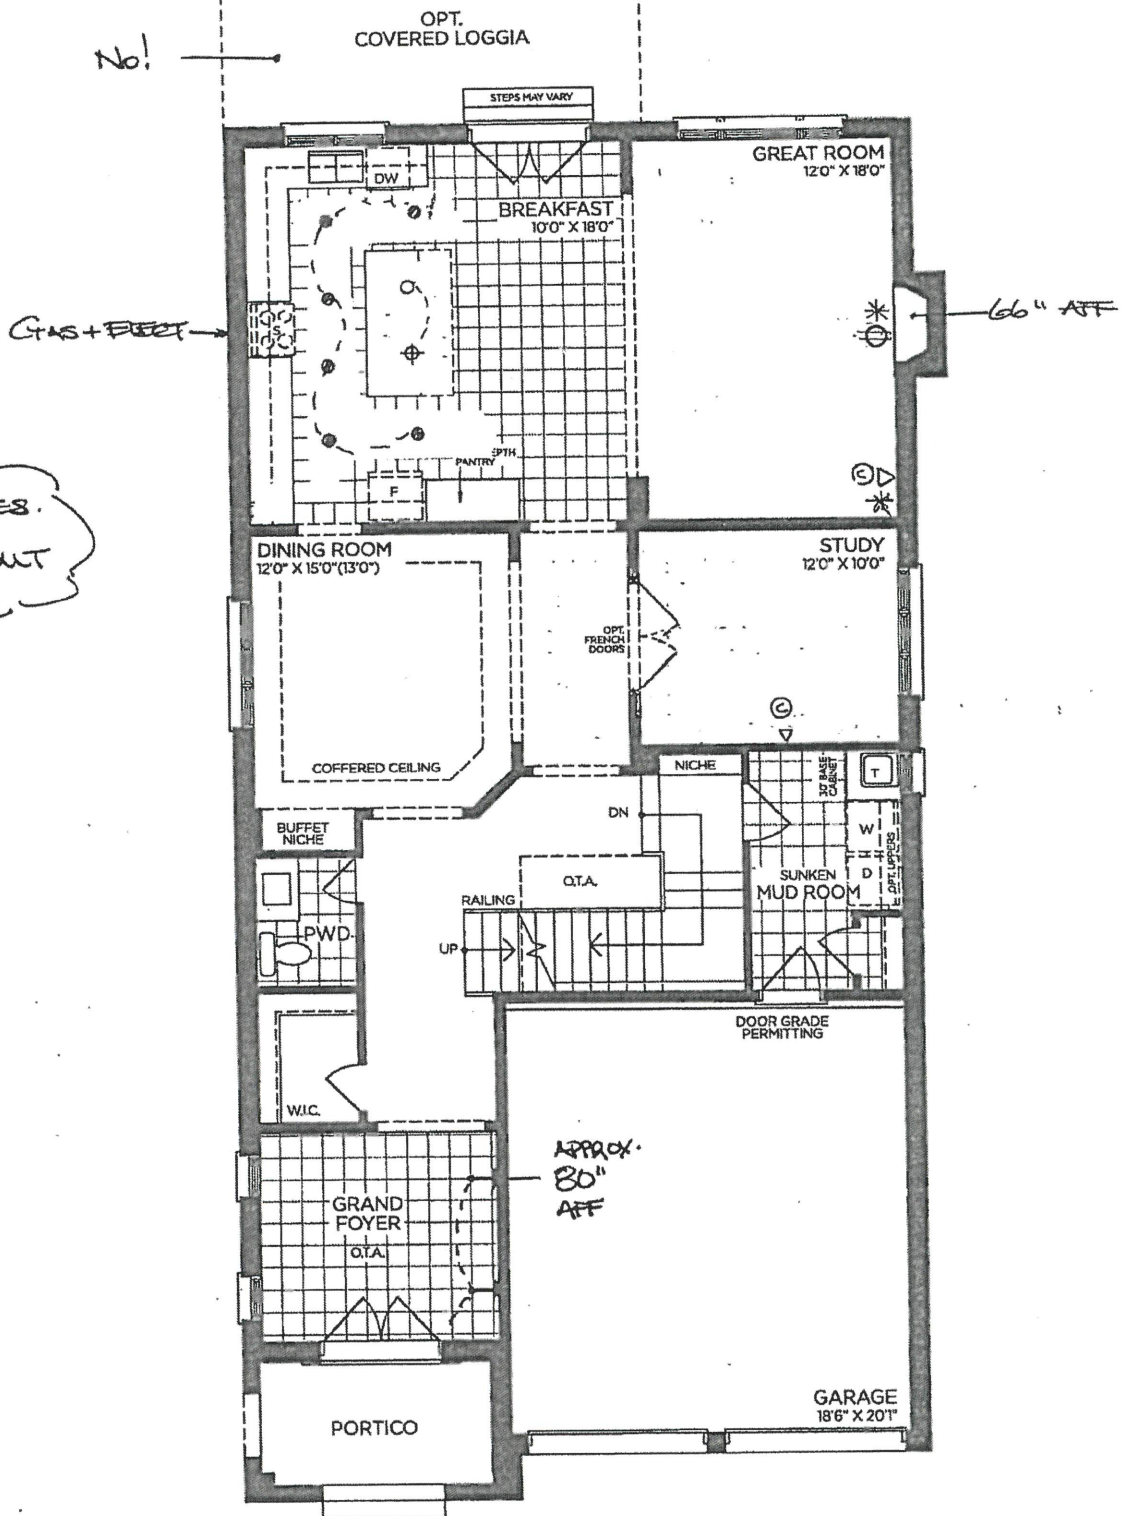

GROUND FLOOR | ELEV. A

VENDOR

PURCHASER

PURCHASER

GOLDPARK

WORTH MORE™

Prices, figures, illustrations, sizes, features and finishes are subject to change without notice. Areas and dimensions are approximate and actual usable floor space may vary from the stated area. Layout may be reverse of the unit purchased. E. & O.E. 4003

SCHEDULE 'F'



PV-135.
APRIL 3 2020

MAY 10 2020

MAY 13 2020


No RAINBOWS

The Brookside 40' SERIES

Elevation A • 3,380 sq.ft.

Elevation B • 3,350 sq.ft.

NICHE
+
RAINBOWS

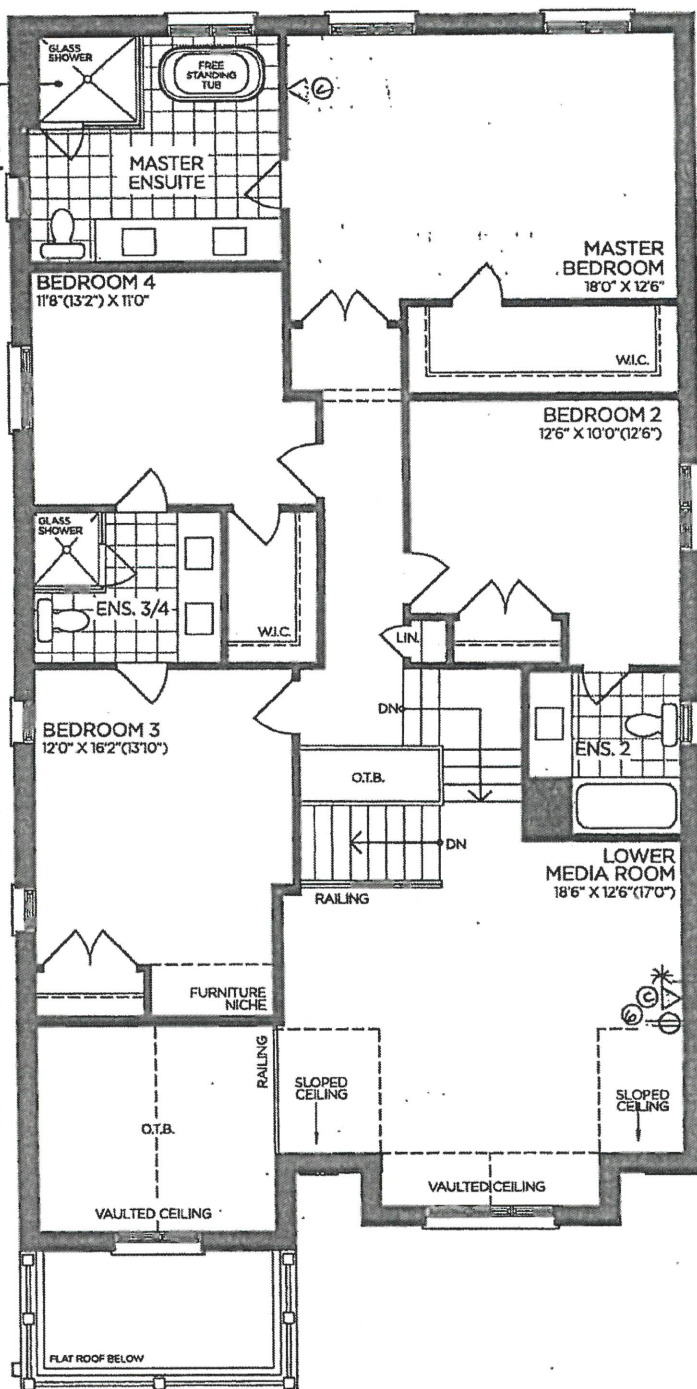

SECOND FLOOR | ELEV. A

VENDOR

PURCHASER

PURCHASER

GOLDPARK

WORTH MORE

Prices, figures, illustrations, sizes, features and finishes are subject to change without notice. Areas and dimensions are approximate and actual usable floor space may vary from the stated area. Layout may be reverse of the unit purchased. E. & O.E. 4003

SCHEDULE 'F'



PV-135

April 3 2020


MAY 10 2020

MAY 13 2020

The Brookside
40' SERIES

Elevation A • 3,380 sq.ft.

→ Elevation B • 3,350 sq.ft.

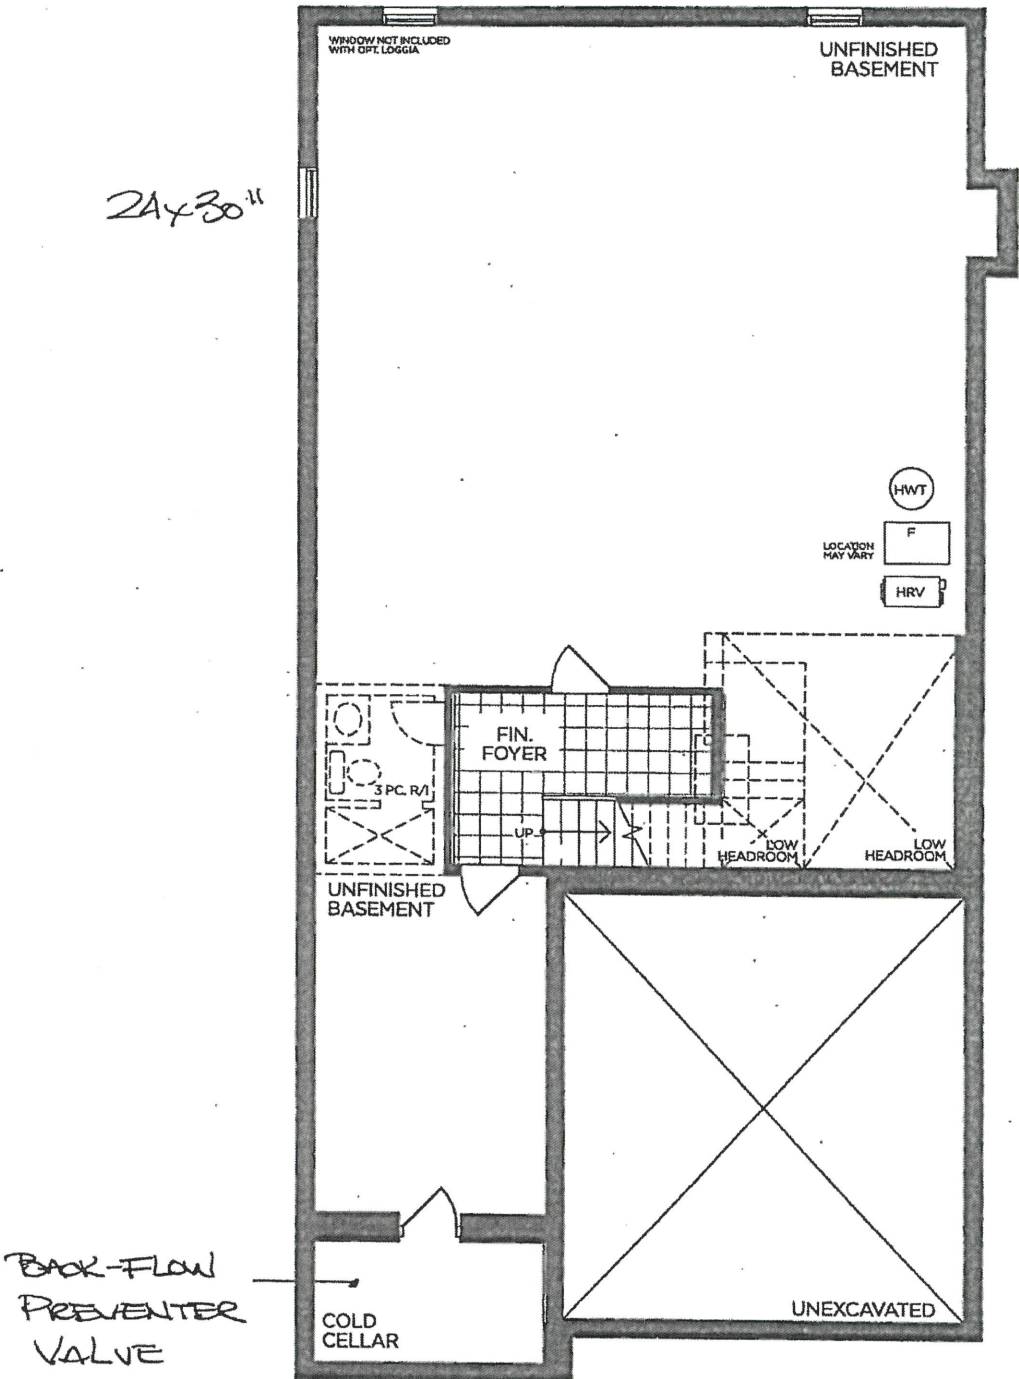

BASEMENT | ELEV. A

VENDOR

PURCHASER

PURCHASER

GOLDPARK
WORTH MORE™

Prices, figures, illustrations, sizes, features and finishes are subject to change without notice. Areas and dimensions are approximate and actual usable floor space may vary from the stated area. Layout may be reverse of the unit purchased. E. & O.E. 4003

SCHEDULE 'F'




FV-135
April 3 2020

MAY 16 2020
MAY 13 2020


The Brookside 40' SERIES

Elevation A • 3,380 sq.ft.


→ Elevation B • 3,350 sq.ft.

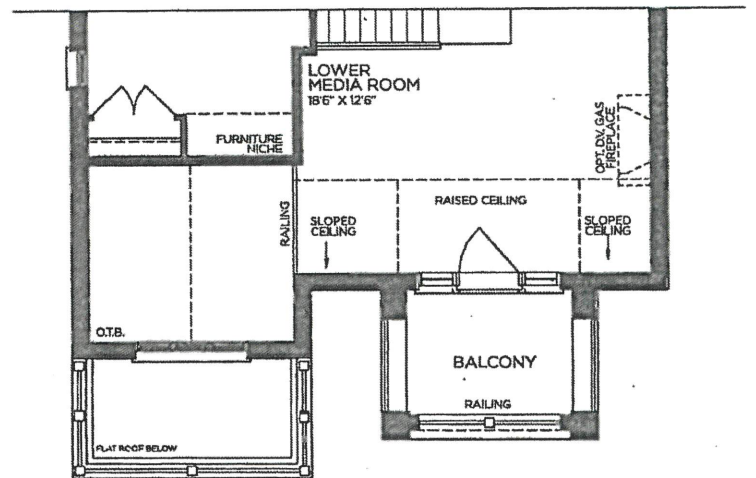


→ PART, SECOND FLOOR | ELEV. B

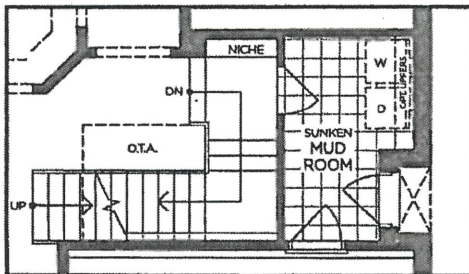

PART, OPT. GROUND FLOOR
W/ OPT. SIDE ENTRANCE | ELEV. A
(ELEV. B SIMILAR)

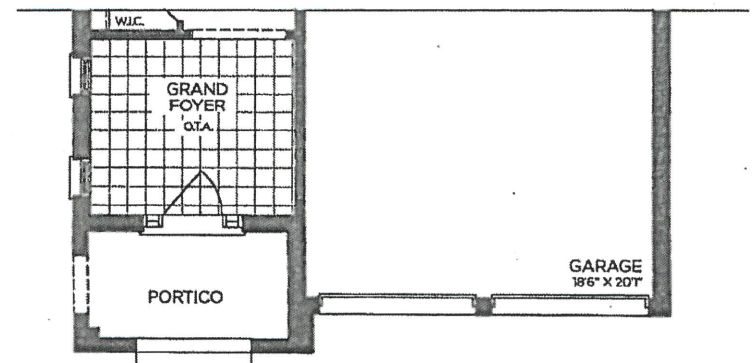

→ PART, GROUND FLOOR | ELEV. B

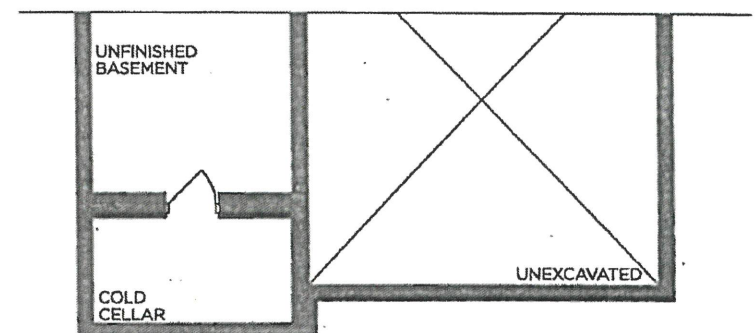

→ PART, BASEMENT | ELEV. B

VENDOR

PURCHASER

PURCHASER


GOLDPARK
WORTH MORE™

Prices, figures, illustrations, sizes, features and finishes are subject to change without notice. Areas and dimensions are approximate and actual usable floor space may vary from the stated area. Layout may be reverse of the unit purchased. E. & O.E. 4003

PLUMBING UPGRADES

POSI-TEMP SHOWER ONLY* W/3 FUNCTION TRANSFER VALVE
TRIM AND SLIDE BAR W/HAND SHOWER

MOEN - ARRIS

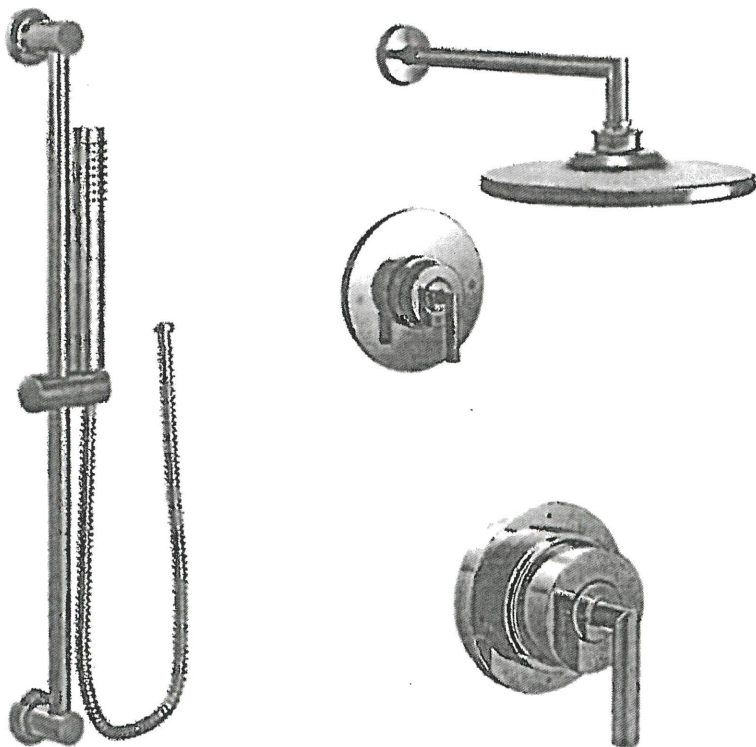

- ☒ CHROME
- ☐ BRUSHED NICKEL
- ☐ MATTE BLACK

- ☐ from WALL
- ☒ from CEILING

MODEL TS22002EP / 3372 / TS23005 / 62320 / 3887EP / A725

Lot# 135	
Room: MASTER ENSUITE	Signature: 
Date: MAY 13 2020	Signature: 