

CERAMIC

Invoice	Qty.	Description
2341 34040 26May20 NoCat	1	MASTER ENSUITE: SHOWER NICHE [SHAMPOO SHELF] - COMPLETE WITH MATCHING MARBLE JAMBS ON 4 SIDES, STANDARD TILE, APPROX. 12 X 18 INSTALLED VERTICALLY.

CONCRETE AND DRAIN

Invoice	Qty.	Description
2238 31751 26May20 NoCat	1	BACK-FLOW PREVENTER VALVE

DRYWALL

Invoice	Qty.	Description
2341 34043 26May20 NoCat	1	LAUNDRY ROOM: DELETE CLOSET - LEAVE OPEN SPACE



CONSTRUCTION SUMMARY

Lot: 140
Model: 40.02 B VALLEYVIEW
Project/Phase: Pine Valley Forevergreen / 1

ELECTRICAL

Invoice	Qty.	Description
2341 33353 26May20	1	GREAT ROOM; INTERIOR WALL OUTLET: ADDITIONAL 110V WALL INTERIOR RECEPTACLE ON EXISTING CIRCUIT FOR WALL MOUNTED TV - LOCATE APPROX. 66" A.F.F. ABOVE FIREPLACE.
2341 33356 26May20	1	.MASTER BEDROOM: INTERIOR WALL OUTLET: ADDITIONAL 110V WALL INTERIOR RECEPTACLE ON EXISTING CIRCUIT FOR WALL MOUNTED TV - LOCATE APPROX 54" A.F.F.
2341 33357 26May20	1	BEDROOM 4: INTERIOR WALL OUTLET: ADDITIONAL 110V WALL INTERIOR RECEPTACLE ON EXISTING CIRCUIT FOR WALL MOUNTED TV - LOCATE APPROX 54" A.F.F..
2341 33359 26May20	6	KITCHEN4" E/S LED INTERIOR POT LIGHT - GROUND FLOOR - EACH INCLUDES 1 SWITCH. INCLUDED IN APS
2341 33360 26May20	1	KITCHEN: FIXTURE: RELOCATE STANDARD CEILING MOUNT FIXTURE TO APPROX CENTERED ABOVE ISLAND.
2341 33361 26May20	1	KITCHEN: CEILING OUTLET: ADDITIONAL REINFORCED CEILING OUTLET - TO APPROX CENTERED ABOVE ISLAND - USE SAME SWITCH AS STANDARD.
2341 33362 26May20	1	KITCHEN: 110V WALL RECEPTACLE ON SEPARATE CIRCUIT - FOR MICROWAVE - MICROWAVE NOT INCLUDED.(BELOW COUNTER)
2341 33365 26May20	1	MASTER ENSUITE: FIXTURE: RELOCATE STANDARD CEILING MOUNT FIXTURE LOCATE APPROX. CENTER ABOVE TUB.
2341 33477 26May20	1	KITCHEN: FIXTURE: UNDER CABINET FLUORESCENT LIGHT FIXTURES - DOES NOT INCLUDE (AND REQUIRES) LIGHT VALANCE.
2341 33479 26May20	1	.KITCHEN: 240v WALL RECEPTACLE ON SEPARATE CIRCUIT FOR BUILT-INS. - APPROX. LOCATION AS PER ATTACHED DRAWINGS

FORMING

Invoice	Qty.	Description
2238 31750 26May20	2	BASEMENT WINDOWS - UPGRADE BASEMENT WINDOW SIZE TO 30 " X 24" - 8" FRAME.
2238 34035 26May20 NoCat	1	40.02-VALLEYVIEW-ELEV B - 9 FOOT BASEMENT CEILING HEIGHT IN LIEU OF STANDARD 8 FOOT CEILING.



CONSTRUCTION SUMMARY

Lot: 140
Model: 40.02 B VALLEYVIEW
Project/Phase: Pine Valley Forevergreen / 1

FRAMING

Invoice	Qty.	Description
2238 34029 26May20 NoCat	1	40.02-VALLEYVIEW-ELEV B - 9 FOOT BASEMENT CEILING HEIGHT IN LIEU OF STANDARD 8 FOOT CEILING.
2238 34033 26May20 NoCat	2	BASEMENT WINDOWS - UPGRADE BASEMENT WINDOW SIZE TO 30 " X 24" - 8" FRAME.
2341 33366 26May20	1	MASTER ENSUITE: SHOWER NICHE [SHAMPOO SHELF] - COMPLETE WITH MATCHING MARBLE JAMBS ON 4 SIDES, STANDARD TILE, APPROX. 12 X 18 INSTALLED VERTICALLY.
2341 33370 26May20	1	DELETE KITCHEN BULKHEAD, IF POSSIBLE, SITE APPROVAL REQUIRED.
2341 33375 26May20 NoCat	1	LAUNDRY ROOM: DELETE CLOSET - LEAVE OPEN SPACE

INTERIOR TRIM AND DOORS

Invoice	Qty.	Description
2238 34030 26May20 NoCat	1	40.02-VALLEYVIEW-ELEV B - 9 FOOT BASEMENT CEILING HEIGHT IN LIEU OF STANDARD 8 FOOT CEILING.
2238 34034 26May20 NoCat	2	BASEMENT WINDOWS - UPGRADE BASEMENT WINDOW SIZE TO 30 " X 24" - 8" FRAME.
2341 34041 26May20 NoCat	1	LAUNDRY ROOM: DELETE CLOSET - LEAVE OPEN SPACE

KITCHEN AND BATH CABINETRY

Invoice	Qty.	Description
2341 34042 26May20 NoCat	1	LAUNDRY ROOM: DELETE CLOSET - LEAVE OPEN SPACE

MODEL OPTIONS 40.02.B

Invoice	Qty.	Description
2238 31747 26May20	1	40.02-VALLEYVIEW-ELEV B - 9 FOOT BASEMENT CEILING HEIGHT IN LIEU OF STANDARD 8 FOOT CEILING.



CONSTRUCTION SUMMARY

Lot: 140
Model: 40.02 B VALLEYVIEW
Project/Phase: Pine Valley Forevergreen / 1

NETWORK AND WIRING

Invoice	Qty.	Description
2341 33354 26May20	1	GREAT ROOM: CONDUIT PIPE - FOR WALL MOUNT TV - LOCATE APPROX. 66" A.F.F. ABOVE FIREPLACE AND TERMINATING AT CABLE.
2341 33355 26May20	1	CONDUIT PIPE - FROM ATTIC TO BASEMENT - BY ELECTRICAL PANEL TO APPROX CENTER OF ATTIC
2341 33478 26May20	1	GREAT ROOM; ADDITIONAL CAT6 ETHERNET OUTLET - EACH SEE PLAN FOR LOCATION

PAINT

Invoice	Qty.	Description
2238 34049 26May20 NoCat	1	40.02-VALLEYVIEW-ELEV B - 9 FOOT BASEMENT CEILING HEIGHT IN LIEU OF STANDARD 8 FOOT CEILING.
2341 34044 26May20 NoCat	1	LAUNDRY ROOM: DELETE CLOSET - LEAVE OPEN SPACE

PLUMBING

Invoice	Qty.	Description
2238 34031 26May20 NoCat	1	BACK-FLOW PREVENTER VALVE.
2238 34048 26May20 NoCat	1	40.02-VALLEYVIEW-ELEV B - 9 FOOT BASEMENT CEILING HEIGHT IN LIEU OF STANDARD 8 FOOT CEILING.
2341 33368 26May20	1	KITCHEN: ROUGH-IN FOR KITCHEN POT FILLER (FIXTURE NOT INCLUDED).
2341 33369 26May20	1	MASTER ENSUITE: 3/4" WATER SUPPLY LINE TO ENSUITE SHOWER IN LIEU OF STANDARD.

WINDOWS - BASEMENT

Invoice	Qty.	Description
2238 34032 26May20 NoCat	2	BASEMENT WINDOWS - UPGRADE BASEMENT WINDOW SIZE TO 30 " X 24" - 8" FRAME.



CONSTRUCTION SUMMARY

Lot: 140

Model: 40.02 B VALLEYVIEW

Project/Phase: Pine Valley Forevergreen / 1

WINDOWS AND DOORS

Invoice	Qty.	Description
2341 33372 26May20 NoCat	1	THRU OUT: UPGRADE TO BLACK INTERIOR WINDOWS THRU OUT



SCHEDULE 'F'

PI-140
APRIL 8 2020
MAY 12 2020


see attach

The Valleyview

40' SERIES

Elevation A • 3,145 sq.ft.

→ Elevation B • 3,170 sq.ft.

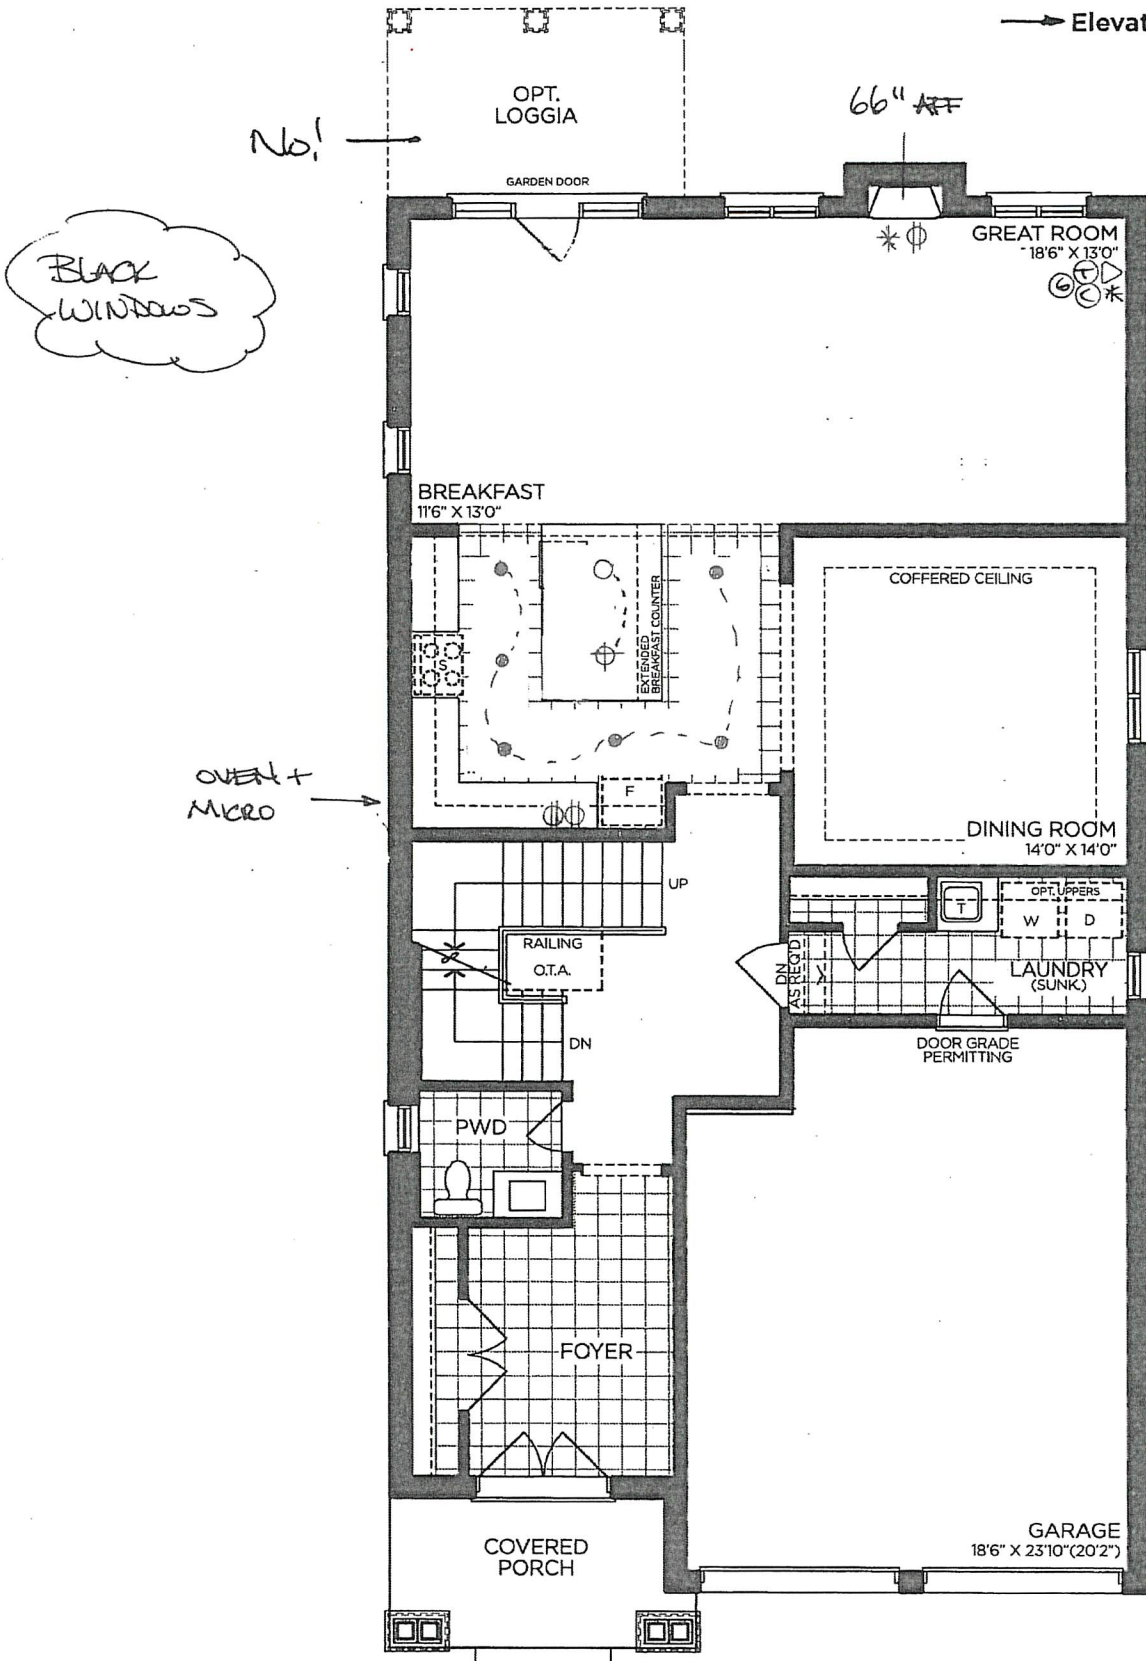

GROUND FLOOR | ELEV. A

VENDOR	
PURCHASER	
PURCHASER	

GOLDPARK

WORTH MORE™

Prices, figures, illustrations, sizes, features and finishes are subject to change without notice. Areas and dimensions are approximate and actual usable floor space may vary from the stated area. Layout may be reverse of the unit purchased. E. & O.E. 4002


SCHEDULE 'F'



PV-140
APRIL 8 2020
MAY 12 2020 *selbach*

The Valleyview
40' SERIES

Elevation A • 3,145 sq.ft.
Elevation B • 3,170 sq.ft.

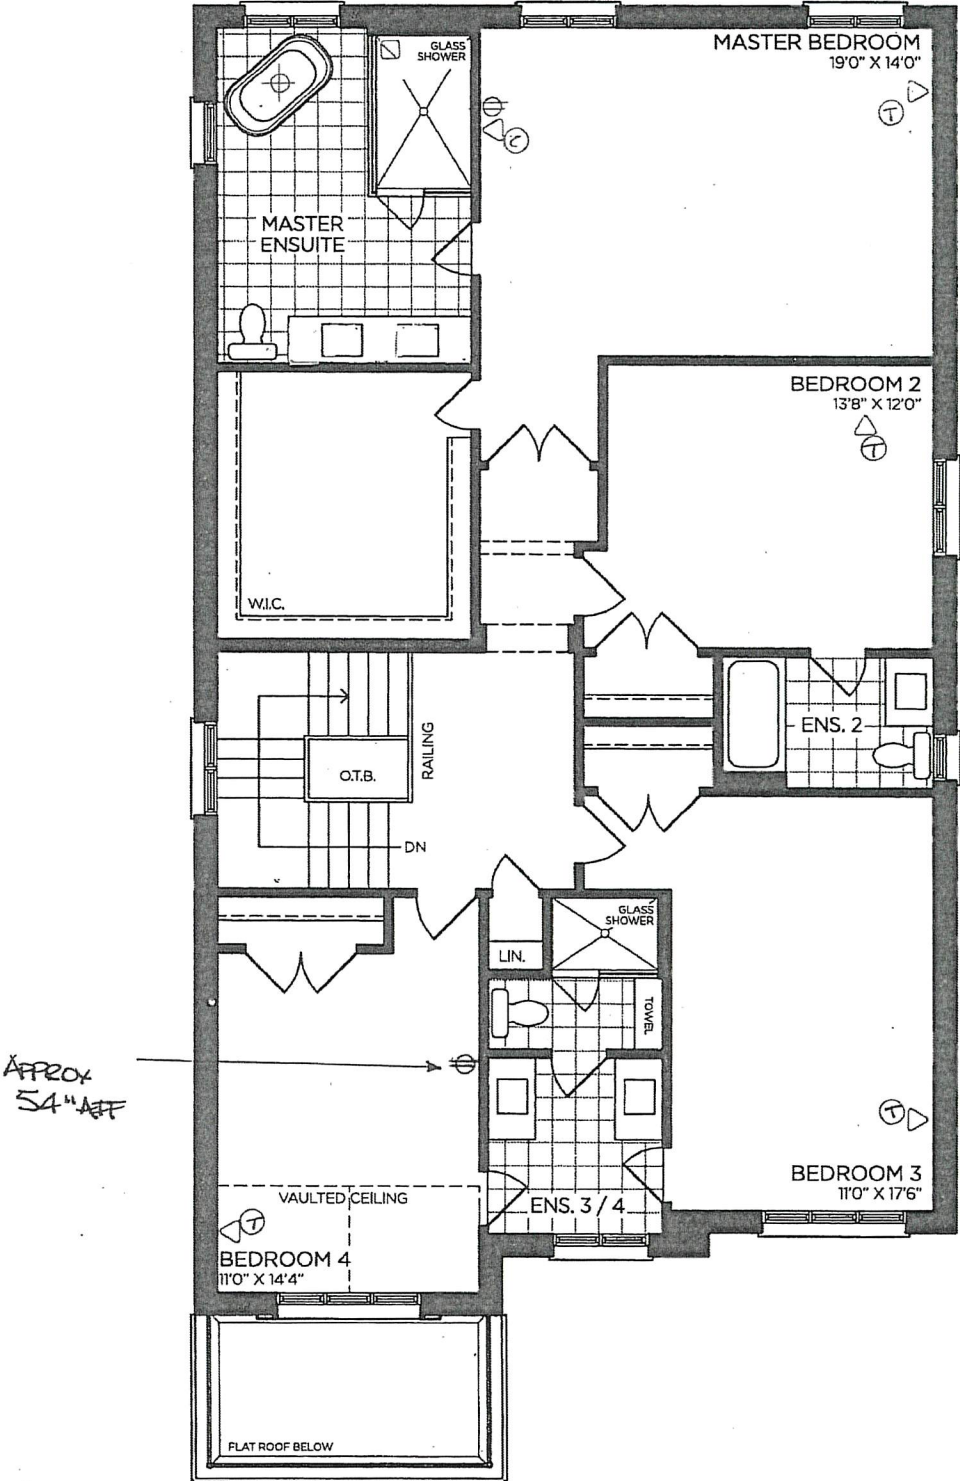

SECOND FLOOR | ELEV. A

VENDOR

PURCHASER

PURCHASER

GOLDPARK
WORTH MORE™

Prices, figures, illustrations, sizes, features and finishes are subject to change without notice. Areas and dimensions are approximate and actual usable floor space may vary from the stated area. Layout may be reverse of the unit purchased. E. & O.E. 4002

SCHEDULE 'F'



○ ○
PV-140
APRIL 8 2020

MAY 12 2020

see sketch


WLOD.

The
Valleyview
40' SERIES

Elevation A • 3,145 sq.ft.

→ Elevation B • 3,170 sq.ft.

9' BASEMENT

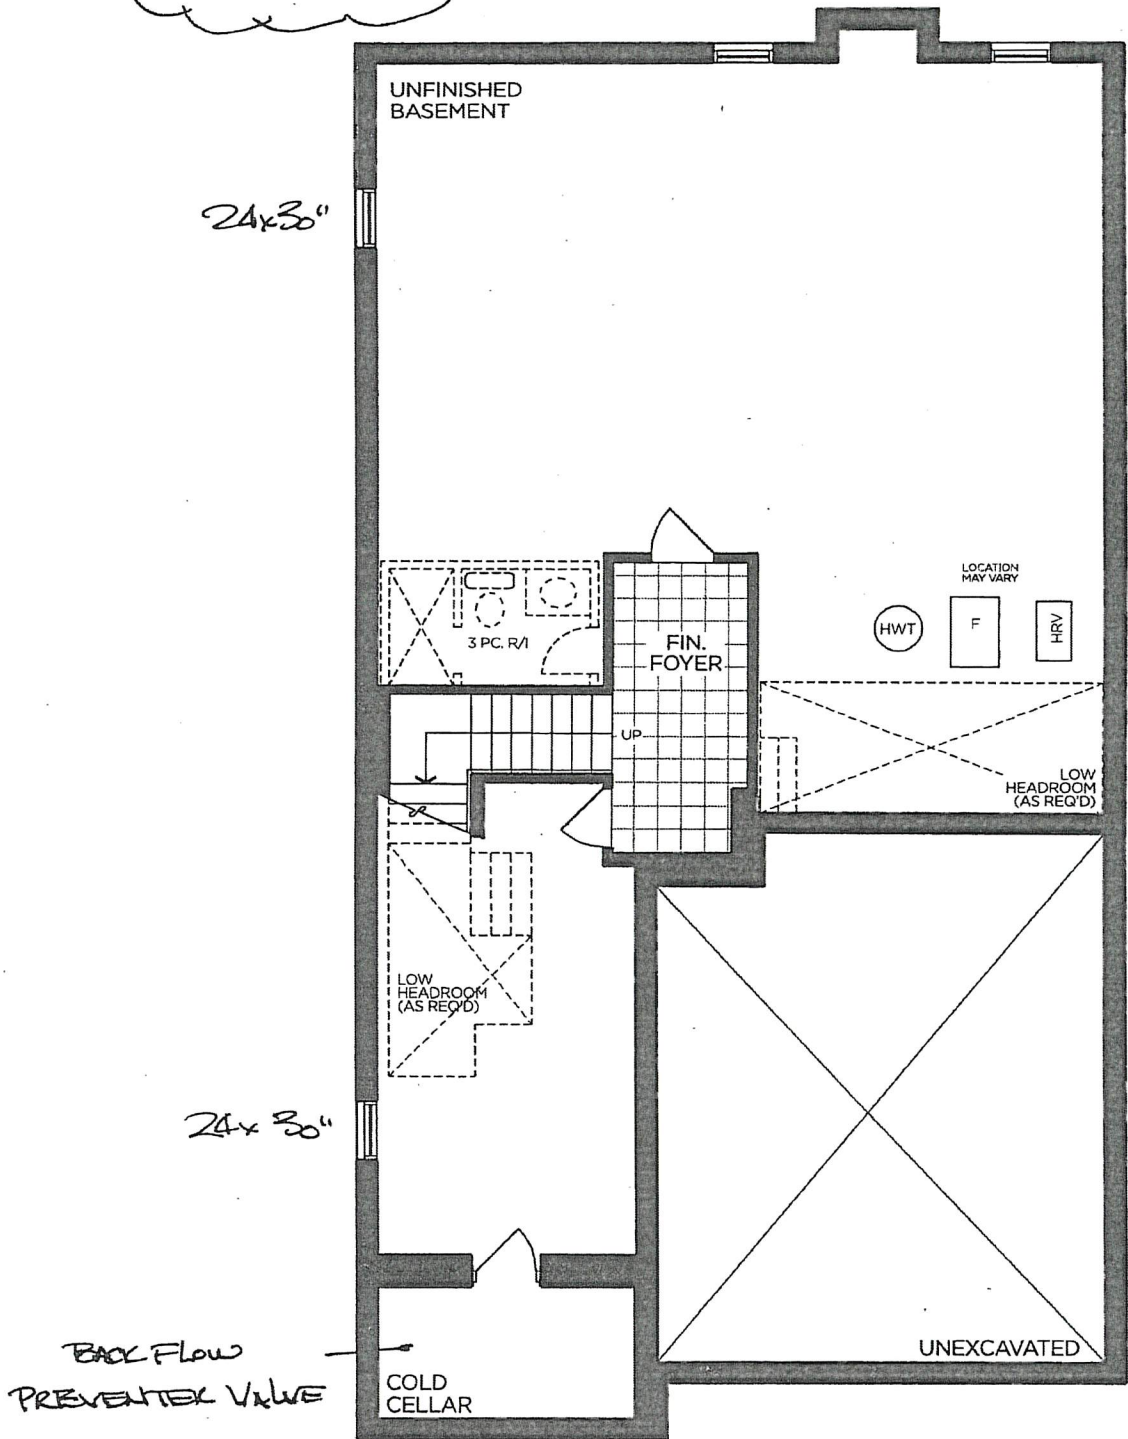

BASEMENT | ELEV. A

VENDOR	
PURCHASER	
PURCHASER	

GOLDPARK
WORTH MORE™

Prices, figures, illustrations, sizes, features and finishes are subject to change without notice. Areas and dimensions are approximate and actual usable floor space may vary from the stated area. Layout may be reverse of the unit purchased. E. & O.E. 4002




SCHEDULE 'F'

PN-140
APRIL 8 2020
MAY 12 2020

The Valleyview 40' SERIES

Elevation A • 3,145 sq.ft.
→ Elevation B • 3,170 sq.ft.

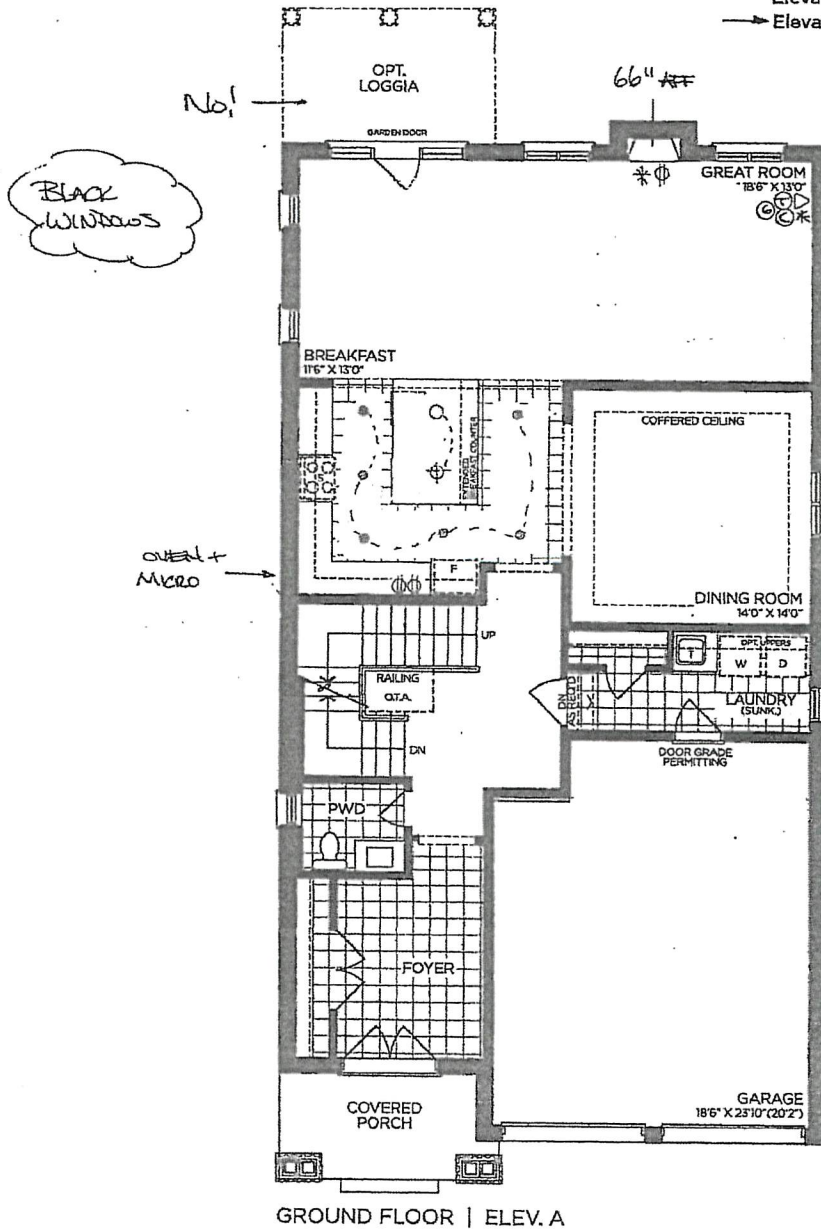

VENDOR
PURCHASER
PURCHASER

GOLDPARK
WORTH MORE™


Prices, figures, illustrations, sizes, features and finishes are subject to change without notice. Areas and dimensions are approximate and actual usable floor space may vary from the stated area. Layout may be reverse of the unit purchased. E. & O.E. 4002

SCHEDULE 'F'



PV-140
APRIL 8 2020
MAY 12 2020

The
Valleyview
40' SERIES
Elevation A - 3,145 sq.ft.
Elevation B - 3,170 sq.ft.

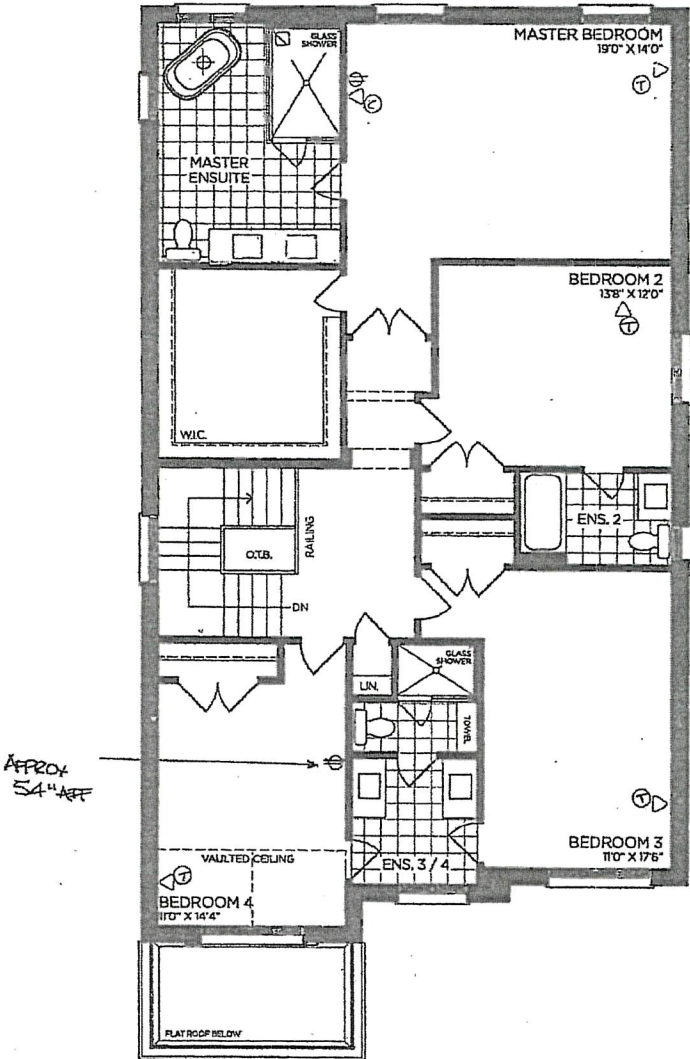

SECOND FLOOR | ELEV. A

VENDOR

PURCHASER

PURCHASER

GOLDPARK
WORTH MORE™

Prices, figures, illustrations, sizes, features and finishes are subject to change without notice. Areas and dimensions are approximate and actual usable floor space may vary from the stated area. Layout may be reverse of the unit purchased. E. & O.E. 4002

SCHEDULE 'F'



PV-140
APRIL 8 2020


MAY 12 2020

The Valleyview
40' SERIES

Elevation A • 3,145 sq.ft.
Elevation B • 3,170 sq.ft.

9' BASEMENT

W.O.D.

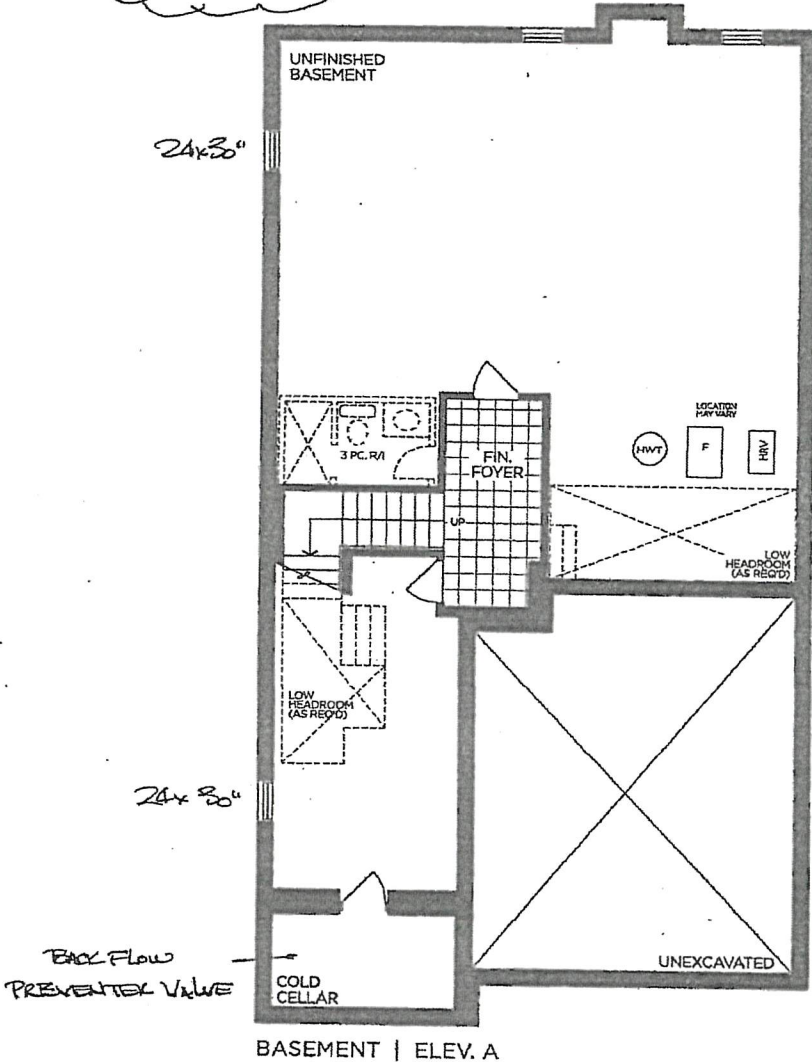

VENDOR

PURCHASER

PURCHASER

GOLDPARK
WORTH MORE™

Prices, figures, illustrations, sizes, features and finishes are subject to change without notice. Areas and dimensions are approximate and actual usable floor space may vary from the stated area. Layout may be reverse of the unit purchased. E. & O.E. 4002