

CERAMIC

Invoice	Qty.	Description
2327 34016 26May20 NoCat	1	**CUSTOM LAYOUT** MASTER ENSUITE: DELETE TUB, CREATE LARGER WIC BY EXTENDING WALL PAST WINDOW TO SHOWER. DELETE WATER CLOSET, RELOCATE TOILET. INCREASE VANITY LENGTH INCLUDING COUNTER TOP (not separate vanities) SEE PLAN FOR REVISED LAYOUT
2327 34023 26May20 NoCat	1	MASTER ENSUITE: SHOWER BENCH COMPLETE WITH STANDARD TILE AND MATCHING MARBLE JAMB COLOUR SEAT TOP
2327 34024 26May20 NoCat	1	MASTER ENSUITE: SHOWER NICHE [SHAMPOO SHELF] - COMPLETE WITH MATCHING MARBLE JAMBS ON 4 SIDES, STANDARD TILE, APPROX. 12 X 18 INSTALLED VERTICALLY
2327 34026 26May20 NoCat	1	SHARED BATH: SHOWER BENCH COMPLETE WITH STANDARD TILE AND MATCHING MARBLE JAMB COLOUR SEAT TOP
2327 34028 26May20 NoCat	1	SHARED BATH: SHOWER NICHE [SHAMPOO SHELF] - COMPLETE WITH MATCHING MARBLE JAMBS ON 4 SIDES, STANDARD TILE, APPROX. 12 X 18 INSTALLED VERTICALLY

CONCRETE AND DRAIN

Invoice	Qty.	Description
2278 32198 26May20 NoCat	1	BACK-FLOW PREVENTER VALVE

ELECTRICAL

Invoice	Qty.	Description
2278 34006 26May20 NoCat	1	BASEMENT: * 9 FOOT BASEMENT CEILING HEIGHT IN LIEU OF STANDARD 8 FOOT CEILING.
2327 33123 26May20	6	KITCHEN: 4" E/S LED INTERIOR POT LIGHT - GROUND FLOOR - EACH - INCLUDES 1 SWITCH INCLUDED IN APS
2327 34014 26May20 NoCat	1	**CUSTOM LAYOUT** MASTER ENSUITE: DELETE TUB, CREATE LARGER WIC BY EXTENDING WALL PAST WINDOW TO SHOWER. DELETE WATER CLOSET, RELOCATE TOILET. INCREASE VANITY LENGTH INCLUDING COUNTER TOP (not separate vanities) SEE PLAN FOR REVISED LAYOUT

FORMING

Invoice	Qty.	Description
2278 32195 26May20	1	BASEMENT: * 9 FOOT BASEMENT CEILING HEIGHT IN LIEU OF STANDARD 8 FOOT CEILING.

FRAMING

Invoice	Qty.	Description
2278 34001 26May20 NoCat	1	BASEMENT: 9 FOOT BASEMENT CEILING HEIGHT IN LIEU OF STANDARD 8 FOOT CEILING.
2327 33111 26May20	8	2ND FLOOR: INCREASE HEIGHT OF DOOR TO 8FT SECOND FLOOR - PER DOOR
2327 33118 26May20 NoCat	1	**CUSTOM LAYOUT** RELOCATE DOORS FROM LINEN CLOSET *TO* KITCHEN CREATING PANTRY ACCESSIBLE FROM KITCHEN
2327 33119 26May20 NoCat	1	**CUSTOM LAYOUT** MASTER ENSUITE: DELETE TUB, CREATE LARGER WIC BY EXTENDING WALL PAST WINDOW TO SHOWER. DELETE WATER CLOSET, RELOCATE TOILET. INCREASE VANITY LENGTH INCLUDING COUNTER TOP (not separate vanities) SEE PLAN FOR REVISED LAYOUT
2327 33480 26May20	1	MASTER ENSUITE: SHOWER BENCH COMPLETE WITH STANDARD TILE AND MATCHING MARBLE JAMB COLOUR SEAT TOP
2327 33481 26May20	1	MASTER ENSUITE: SHOWER NICHE [SHAMPOO SHELF] - COMPLETE WITH MATCHING MARBLE JAMBS ON 4 SIDES, STANDARD TILE, APPROX. 12 X 18 INSTALLED VERTICALLY
2327 33482 26May20	1	SHARED BATH: SHOWER BENCH COMPLETE WITH STANDARD TILE AND MATCHING MARBLE JAMB COLOUR SEAT TOP
2327 33483 26May20	1	SHARED BATH: SHOWER NICHE [SHAMPOO SHELF] - COMPLETE WITH MATCHING MARBLE JAMBS ON 4 SIDES, STANDARD TILE, APPROX. 12 X 18 INSTALLED VERTICALLY

GRANITE MARBLE QUARTZ

Invoice	Qty.	Description
2327 34015 26May20 NoCat	1	**CUSTOM LAYOUT** MASTER ENSUITE: DELETE TUB, CREATE LARGER WIC BY EXTENDING WALL PAST WINDOW TO SHOWER. DELETE WATER CLOSET, RELOCATE TOILET. INCREASE VANITY LENGTH INCLUDING COUNTER TOP (not separate vanities) SEE PLAN FOR REVISED LAYOUT

INTERIOR TRIM AND DOORS

Invoice	Qty.	Description
2278 34003 26May20 NoCat	1	BASEMENT: * 9 FOOT BASEMENT CEILING HEIGHT IN LIEU OF STANDARD 8 FOOT CEILING.
2327 34011 26May20 NoCat	1	**CUSTOM LAYOUT** MASTER ENSUITE: DELETE TUB, CREATE LARGER WIC BY EXTENDING WALL PAST WINDOW TO SHOWER. DELETE WATER CLOSET, RELOCATE TOILET. INCREASE VANITY LENGTH INCLUDING COUNTER TOP (not separate vanities) SEE PLAN FOR REVISED LAYOUT
2327 34018 26May20 NoCat	1	**CUSTOM LAYOUT** RELOCATE DOORS FROM LINEN CLOSET *TO* KITCHEN CREATING PANTRY ACCESSIBLE FROM KITCHEN

KITCHEN AND BATH CABINETRY

Invoice	Qty.	Description
2327 34017 26May20 NoCat	1	**CUSTOM LAYOUT** MASTER ENSUITE: DELETE TUB, CREATE LARGER WIC BY EXTENDING WALL PAST WINDOW TO SHOWER. DELETE WATER CLOSET, RELOCATE TOILET. INCREASE VANITY LENGTH INCLUDING COUNTER TOP (not separate vanities) SEE PLAN FOR REVISED LAYOUT
2327 34019 26May20 NoCat	1	**CUSTOM LAYOUT** RELOCATE DOORS FROM LINEN CLOSET *TO* KITCHEN CREATING PANTRY ACCESSIBLE FROM KITCHEN

MODEL OPTIONS 40.00

Invoice	Qty.	Description
2278 34007 26May20 NoCat	1	MODEL 40.00- ELEVATION A: BASEMENT: * 9 FOOT BASEMENT CEILING HEIGHT IN LIEU OF STANDARD 8 FOOT CEILING.

PAINT

Invoice	Qty.	Description
2278 34005 26May20 NoCat	1	BASEMENT: * 9 FOOT BASEMENT CEILING HEIGHT IN LIEU OF STANDARD 8 FOOT CEILING.
2327 34010 26May20 NoCat	8	2ND FLOOR: INCREASE HEIGHT OF DOOR TO 8FT SECOND FLOOR - PER DOOR
2327 34021 26May20 NoCat	1	**CUSTOM LAYOUT** RELOCATE DOORS FROM LINEN CLOSET *TO* KITCHEN CREATING PANTRY ACCESSIBLE FROM KITCHEN

PLUMBING

Invoice	Qty.	Description
2327 34013 26May20 NoCat	1	**CUSTOM LAYOUT** MASTER ENSUITE: DELETE TUB, CREATE LARGER WIC BY EXTENDING WALL PAST WINDOW TO SHOWER. DELETE WATER CLOSET, RELOCATE TOILET. INCREASE VANITY LENGTH INCLUDING COUNTER TOP (not separate vanities) SEE PLAN FOR REVISED LAYOUT
2327 34022 26May20 NoCat	1	MASTER ENSUITE: SHOWER BENCH COMPLETE WITH STANDARD TILE AND MATCHING MARBLE JAMB COLOUR SEAT TOP
2327 34027 26May20 NoCat	1	SHARED BATH: SHOWER BENCH COMPLETE WITH STANDARD TILE AND MATCHING MARBLE JAMB COLOUR SEAT TOP

WINDOWS AND DOORS

Invoice	Qty.	Description
2278 34004 26May20 NoCat	1	BASEMENT: * 9 FOOT BASEMENT CEILING HEIGHT IN LIEU OF STANDARD 8 FOOT CEILING.
2327 34009 26May20 NoCat	8	2ND FLOOR: INCREASE HEIGHT OF DOOR TO 8FT SECOND FLOOR - PER DOOR
2327 34012 26May20 NoCat	1	**CUSTOM LAYOUT** MASTER ENSUITE: DELETE TUB, CREATE LARGER WIC BY EXTENDING WALL PAST WINDOW TO SHOWER. DELETE WATER CLOSET, RELOCATE TOILET. INCREASE VANITY LENGTH INCLUDING COUNTER TOP (not separate vanities) SEE PLAN FOR REVISED LAYOUT
2327 34020 26May20 NoCat	1	**CUSTOM LAYOUT** RELOCATE DOORS FROM LINEN CLOSET *TO* KITCHEN CREATING PANTRY ACCESSIBLE FROM KITCHEN




PV-139. *see attached*
MAY 14 2020

THIS PLAN shows opt Ground Floor.

DELETE NIBS wall
(cheaper pantry)

DELETE TUB
BIGGER WIC
← LINEN to PANTRY
RELOCATE TOILET
→ VANITY
BENET

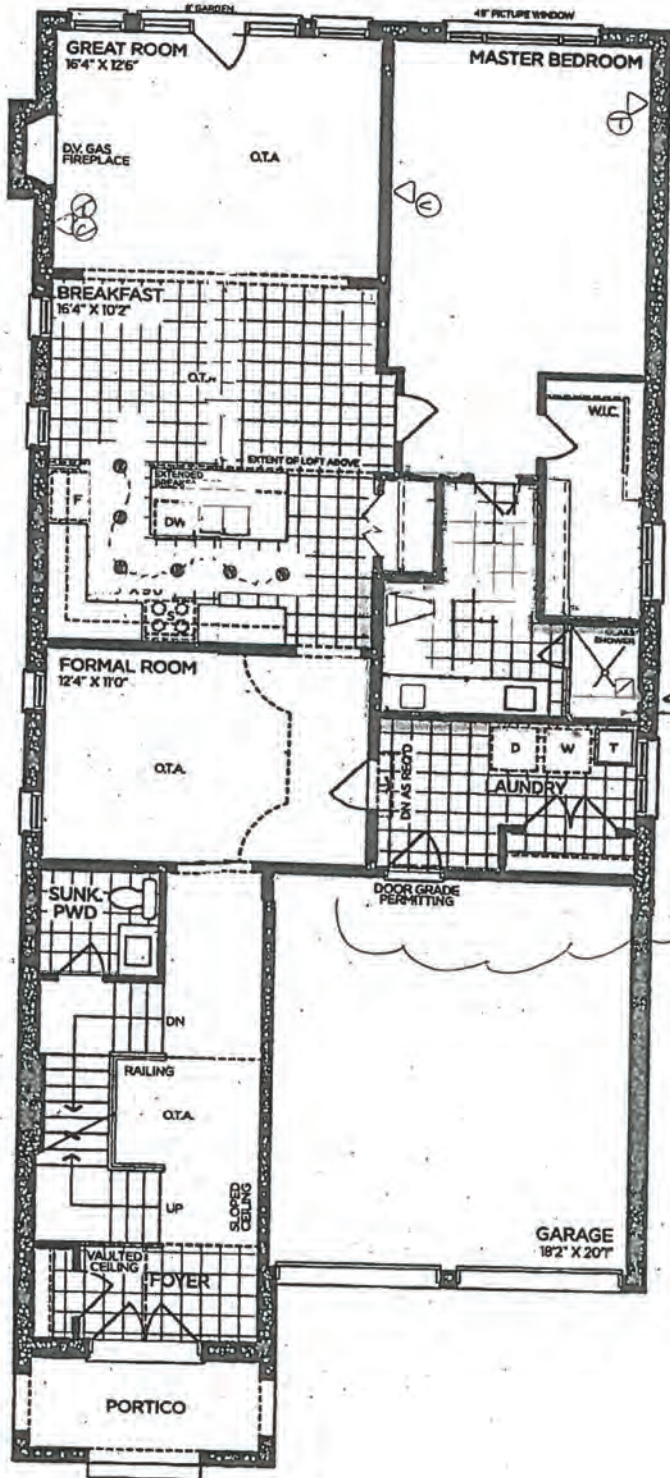

GROUND FLOOR | ELEV. A

VENDOR
PURCHASER
PURCHASER

GOLDPARK
WORTH MORE™

Prices, figures, illustrations, sizes, features and finishes are subject to change without notice. Areas and dimensions are approximate and actual usable floor space may vary from the stated area. Layout may be reverse of the unit purchased. E. & O.E. 4000

2
SCHEDULE 'F'



The Briarwood

40' SERIES


Elevation A • 2,870 sq.ft.

Elevation B • 2,860 sq.ft.

TV-139.
APRIL 8 2020
MAY 14 2020

See attached
See attached

8' DOORS
THRU OUT

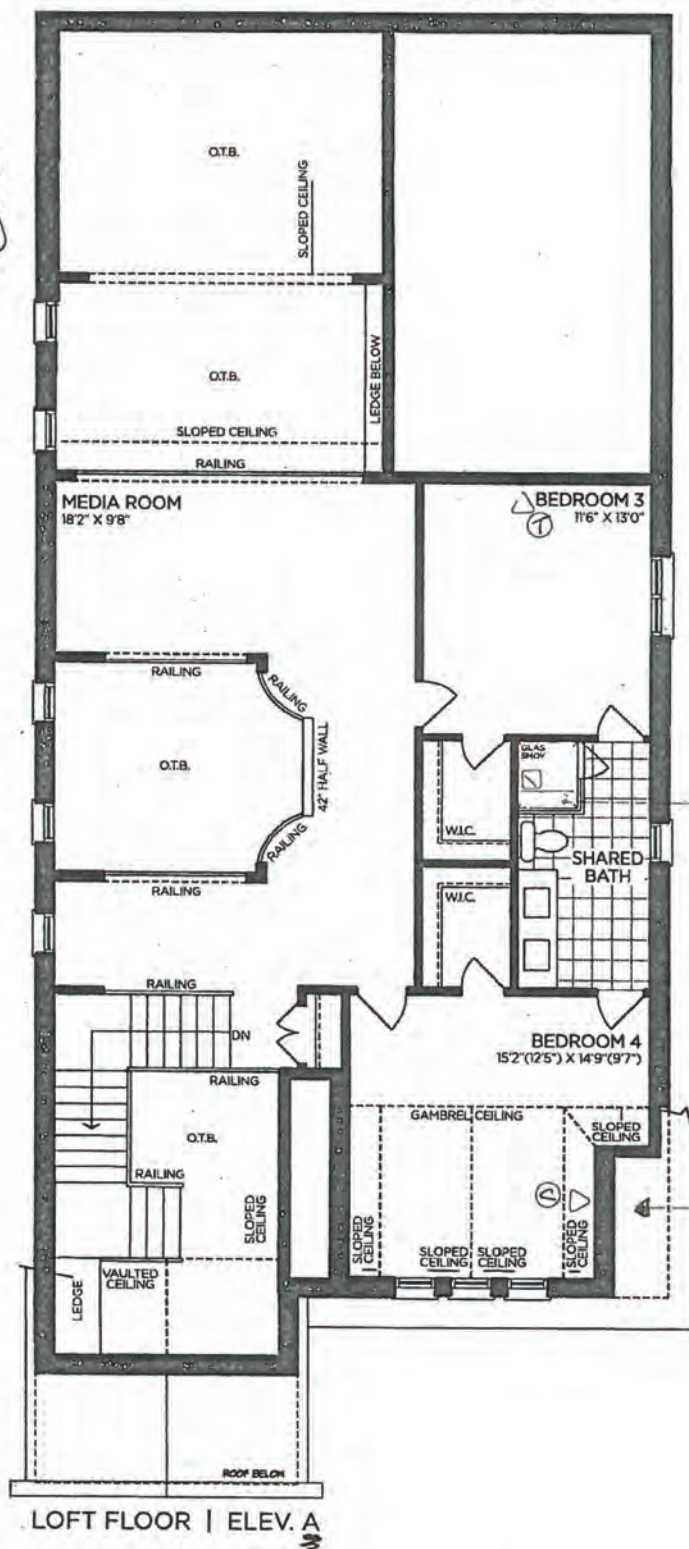

SHOWER BENCH

MOVE STD CABLE
FROM Media
LOCATE APPROX
50" APP (no electrical)

VENDOR

PURCHASER

PURCHASER

GOLDPARK
WORTH MORE™

Prices, figures, illustrations, sizes, features and finishes are subject to change without notice. Areas and dimensions are approximate and actual usable floor space may vary from the stated area. Layout may be reverse of the unit purchased. E. & O.E. 4000



SCHEDULE 'F'

PN-139.

April 8 2020

MAY 14 2020

see attach.

see attached.

The Briarwood

40' SERIES

Elevation A • 2,870 sq.ft.


Elevation B • 2,860 sq.ft.

W.O.D.

9' BASEMENT HEIGHT

16x30"

16x30"

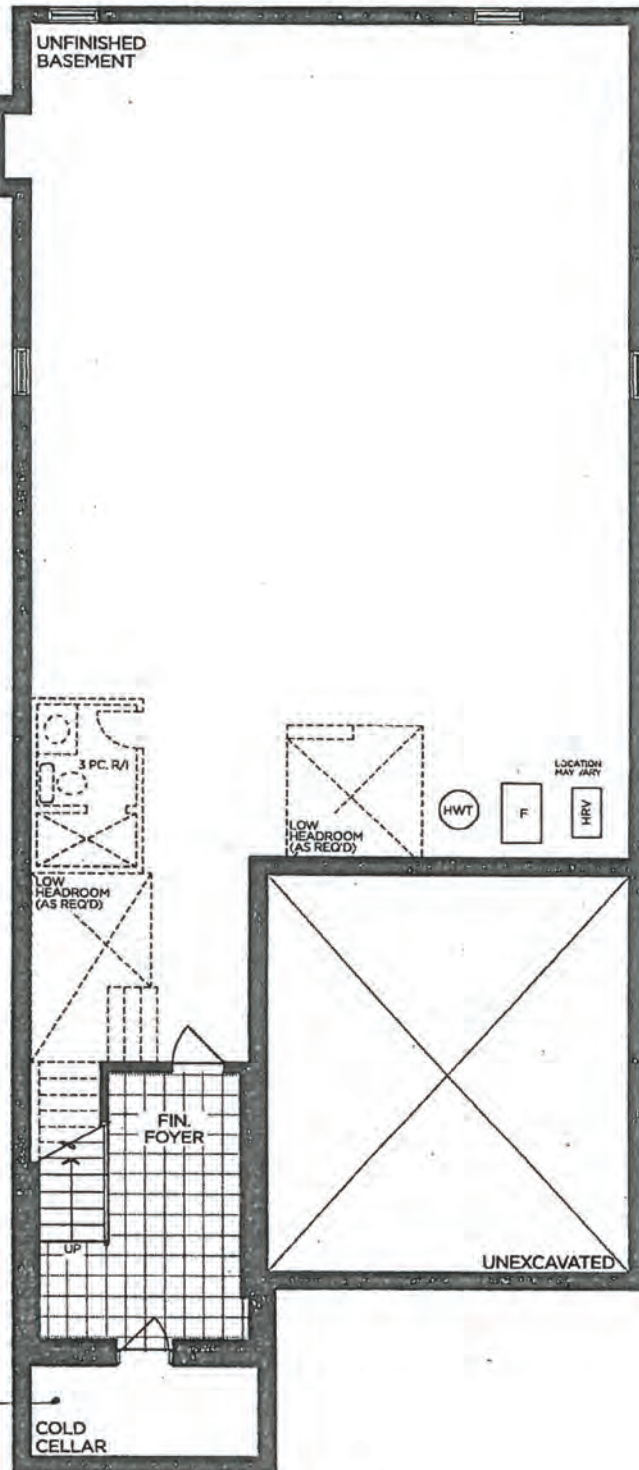

BASEMENT | ELEV. A & B

VENDOR

PURCHASER

PURCHASER

GOLDPARK
WORTH MORE™

Prices, figures, illustrations, sizes, features and finishes are subject to change without notice. Areas and dimensions are approximate and actual usable floor space may vary from the stated area. Layout may be reverse of the unit purchased. E. & O.E. 4000



PV-139.
MAY 14 2020

THIS PLAN
SHOWS OPT
GROUND FLOOR


DELETE ALFESS
WALL
(deeper pantry)

DELETE TUB
BIGGER WIC

← LOVEL TO PANTRY

RELOCATE TOILET
→ VANITY

BRAT

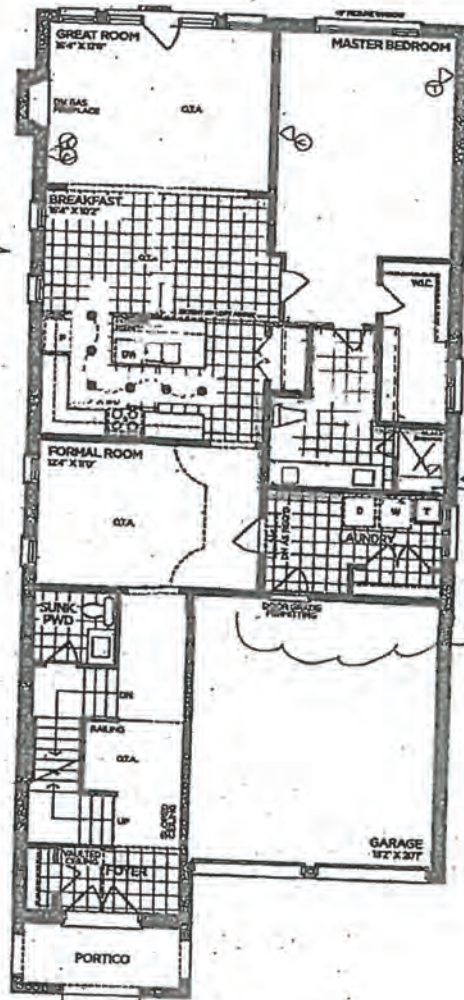

GROUND FLOOR | ELEV. A

VENDOR
PURCHASER
PURCHASER

GOLDPARK
WORTH MORE

Prices, figures, illustrations, sizes, features and finishes are subject to change without notice. Areas and dimensions are approximate and actual usable floor space may vary from the stated area. Layout may be reverse of the unit purchased. E. & O.E. 4000

2
SCHEDULE 'F'




The Briarwood

40' SERIES

Elevation A • 2,870 sq.ft.
Elevation B • 2,860 sq.ft.

TV-139.
APRIL 8 2020
MAY 14 2020

8' doors
THRU OUT

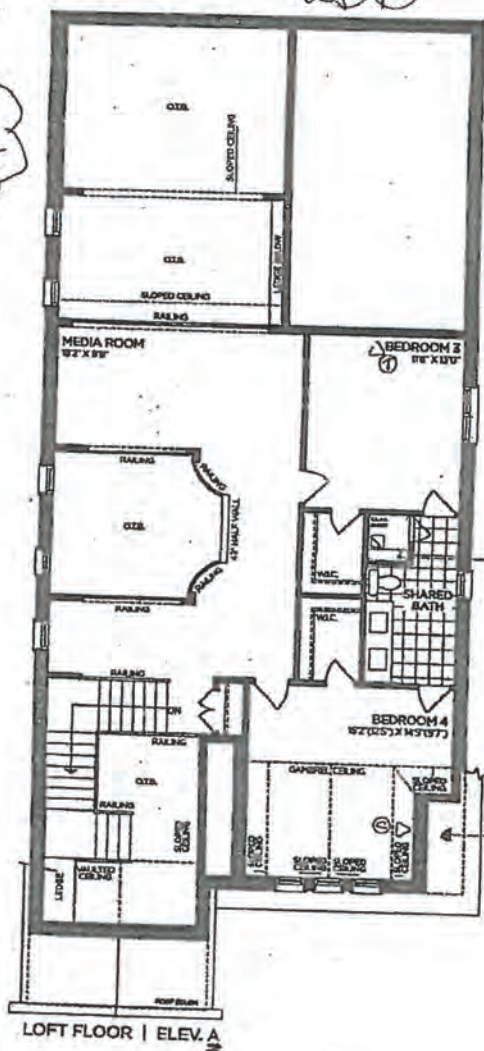

MOVE STD CABLE
from Media
LOCATE APPRX
50' APP (no electrical)

VENDOR

PURCHASER

PURCHASER

GOLDPARK

WORTH MORE™

Prices, figures, illustrations, sizes, features and finishes are subject to change without notice. Areas and dimensions are approximate and actual usable floor space may vary from the stated area. Layout may be reverse of the unit purchased. E & OE 4000

SCHEDULE 'F'



TV-139.

April 8 2020

MAY 14 2020

The Briarwood

40' SERIES

Elevation A • 2,870 sq.ft.


Elevation B • 2,860 sq.ft.

W.O.D.

9' BASEMENT
HEIGHT

16x30"

16x30"

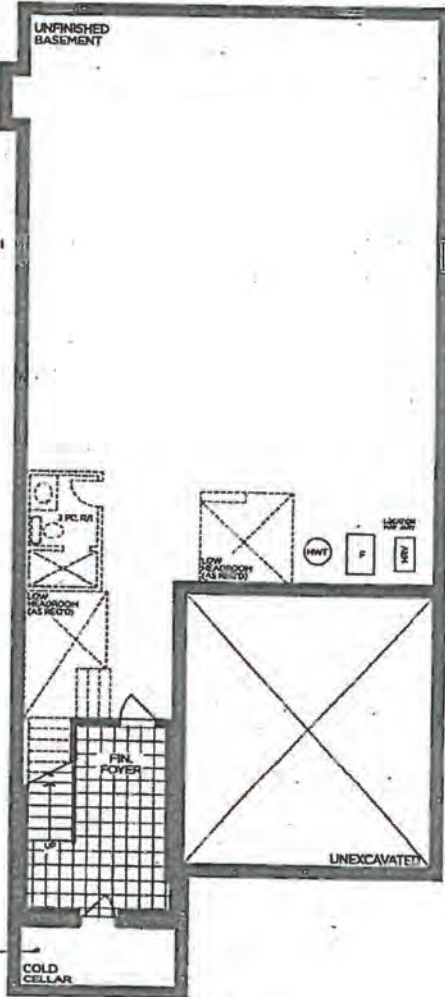

BASEMENT | ELEV. A & B

VENDOR
PURCHASER
PURCHASER

GOLDPARK
WORTH MORE

Prices, figures, illustrations, sizes, features and finishes are subject to change without notice. Areas and dimensions are approximate and actual usable floor space may vary from the stated area. Layout may be reverse of the unit purchased. E. & O.E. 4000