

**Lot: 99****Model: 50.03 B OAKGROVE****Project/Phase: Pine Valley Forevergreen / 1**

CERAMIC

Invoice	Qty.	Description
2365	1	**CUSTOM LAYOUT** INSTALL STANDING SHOWER IN LIEU OF TUB - INCLUDES POT LIGHT IN CEILING, TILE SHOWER BASE AND FRAMELESS GLASS SHOWER ENCLOSURE
NoCat		
2365	1	**CUSTOM LAYOUT** SHARED BATHROOM - REDUCE SIZE OF SHOWER AND ENLARGE SIZE OF VANITY TO APPROX 6' TO ALLOW FOR DOUBLE SINKS INCLUDES BUILDERS STANDARD OFFERING
NoCat		

CONCRETE AND DRAIN

Invoice	Qty.	Description
2234	1	.BACK FLOW PREVENTER VALVE
NoCat		

CROWN MOULDING

Invoice	Qty.	Description
2355	1	.GREAT ROOM - OPT. COFFERED CEILING - AS PER PLAN
NoCat		
2355	1	.GREAT ROOM - OPT. COFFERED CEILING - AS PER PLAN
NoCat		



CONSTRUCTION SUMMARY

Lot: 99
Model: 50.03 B OAKGROVE
Project/Phase: Pine Valley Forevergreen / 1

DRYWALL

Invoice	Qty.	Description
2234 NoCat	3	.BASEMENT WINDOWS - UPGRADE BASEMENT WINDOW SIZE TO 30 " X 24" - 10" FRAME (PINEVALLEY 50 FOOT LOTS ONLY)
2355 NoCat	1	.**CUSTOM LAYOUT** MOVE WALL BETWEEN SITTING ROOM AND BEDROOM 5 APPROX 24" - MAKING BEDROOM 5 LARGER
2355 NoCat	1	.GREAT ROOM - OPT. COFFERED CEILING - AS PER PLAN
2355 NoCat	6	.MAIN FLOOR: UPGRADE INTERIOR DOORS TO 9'-SOLID CORE
2355 NoCat	25	.2ND FLOOR: INCREASE HEIGHT OF DOOR TO 8FT SECOND FLOOR - PER DOOR
2365 NoCat	1	.**CUSTOM LAYOUT** INSTALL STANDING SHOWER IN LIEU OF TUB - INCLUDES POT LIGHT IN CEILING, TILE SHOWER BASE AND FRAMELESS GLASS SHOWER ENCLOSURE

GOLDPARK

WORTH MORE™

CONSTRUCTION SUMMARY

Lot: 99

Model: 50.03 B OAKGROVE

Project/Phase: Pine Valley Forevergreen / 1

ELECTRICAL

Invoice	Qty.	Description
2355 72,281	1	.GREAT ROOM: INTERIOR WALL OUTLET: ADDITIONAL 110V WALL INTERIOR RECEPTACLE ON EXISTING CIRCUIT FOR WALL MOUNTED TV - LOCATE APPROX. 66" A.F.F
2355 72,268	1	.GREAT ROOM: ADD AN ADDITIONAL INTERIOR WALL OUTLET: 110V WALL INTERIOR RECEPTACLE ON EXISTING CIRCUIT - LOCATE BY CABLE
2355 72,307	1	.KITCHEN: FIXTURE: RELOCATE STANDARD CEILING MOUNT FIXTURE & SWITCH *FROM* GREAT ROOM *TO* KITCHEN, APPROX CENTER ABOVE ISLAND
2355 72,286	1	.COVERED LOGGIA: EXTERIOR RECEPTACLE: ADDITIONAL EXTERIOR GFI RECEPTACLE WITH COVER - SEE PLAN FOR LOCATION
2355 NoCat	1	.2nd FLOOR LAUNDRY: PANASONIC 'WHISPER SENSE' #FV-11VQC5 EXHAUST FAN - with motion and humidity sensor
2365 72,302	1	.MASTER WIC: *ADD* BATHROOM FAN: ADDITIONAL 90CFM BATHROOM EXHAUST FAN COMPLETE WITH SWITCH
2365 72,302	1	.SERVERY- WALK-IN PANTRY - *ADD* BATHROOM FAN: ADDITIONAL 90CFM BATHROOM EXHAUST FAN COMPLETE WITH SWITCH
2365 NoCat	1	.**CUSTOM LAYOUT** INSTALL STANDING SHOWER IN LIEU OF TUB - INCLUDES POT LIGHT IN CEILING, TILE SHOWER BASE AND FRAMELESS GLASS SHOWER ENCLOSURE

EXTERIOR COLOURS

Invoice	Qty.	Description
2234 NoCat	1	EXTERIOR COLOUR PACKAGE # BR.4

FORMING

Invoice	Qty.	Description
2234 72,675	3	.BASEMENT WINDOWS - UPGRADE BASEMENT WINDOW SIZE TO 30 " X 24" - 10" FRAME (PINEVALLEY 50 FOOT LOTS ONLY)

Page 3 of 7

Printed and Sent: 14-Jun-20

GOLDPARK

WORTH MORE™

CONSTRUCTION SUMMARY

Lot: 99

Model: 50.03 B OAKGROVE

Project/Phase: Pine Valley Forevergreen / 1

HVAC

Invoice	Qty.	Description
2355	1	.2nd FLOOR LAUNDRY: PANASONIC 'WHISPER SENSE' #FV-11VQC5 EXHAUST FAN - with motion and humidity sensor
NoCat		
2365	1	.MASTER WIC: *ADD* BATHROOM FAN: ADDITIONAL 90CFM BATHROOM EXHAUST FAN COMPLETE WITH SWITCH
NoCat		
2365	1	.SERVERY- WALK-IN PANTRY - *ADD* BATHROOM FAN: ADDITIONAL 90CFM BATHROOM EXHAUST FAN COMPLETE WITH SWITCH
NoCat		

INTERIOR TRIM AND DOORS

Invoice	Qty.	Description
2234	3	.BASEMENT WINDOWS - UPGRADE BASEMENT WINDOW SIZE TO 30 " X 24" - 10" FRAME (PINEVALLEY 50 FOOT LOTS ONLY)
NoCat		
2355	1	.**CUSTOM LAYOUT** MOVE WALL BETWEEN SITTING ROOM AND BEDROOM 5 APPROX 24" - MAKING BEDROOM 5 LARGER
NoCat		
2355	1	.GREAT ROOM - OPT. COFFERED CEILING - AS PER PLAN
NoCat		
2355	6	.MAIN FLOOR: UPGRADE INTERIOR DOORS TO 9'-SOLID CORE
NoCat		
2355	25	.2ND FLOOR: INCREASE HEIGHT OF DOOR TO 8FT SECOND FLOOR - PER DOOR
NoCat		
2365	1	.**CUSTOM LAYOUT** INSTALL STANDING SHOWER IN LIEU OF TUB - INCLUDES POT LIGHT IN CEILING, TILE SHOWER BASE AND FRAMELESS GLASS SHOWER ENCLOSURE
NoCat		
2365	1	.**CUSTOM LAYOUT** SHARED BATHROOM - REDUCE SIZE OF SHOWER AND ENLARGE SIZE OF VANITY TO APPROX 6' TO ALLOW FOR DOUBLE SINKS INCLUDES BUILDERS STANDARD OFFERING
NoCat		

KITCHEN AND BATH CABINETRY

Invoice	Qty.	Description
2365	1	.**CUSTOM LAYOUT** SHARED BATHROOM - REDUCE SIZE OF SHOWER AND ENLARGE SIZE OF VANITY TO APPROX 6' TO ALLOW FOR DOUBLE SINKS INCLUDES BUILDERS STANDARD OFFERING.
NoCat		

Page 5 of 7

Printed and Sent: 14-Jun-20

SCHEDULE 'F'




PV-109

APRIL 23 2020

The Beaumont

50' SERIES

- Elevation A • 4,170 sq.ft.
4,315 sq.ft. Opt. Elevator
- Elevation B • 4,165 sq.ft.
4,315 sq.ft. Opt. Elevator
- Elevation C • 4,250 sq.ft.
4,400 sq.ft. Opt. Elevator

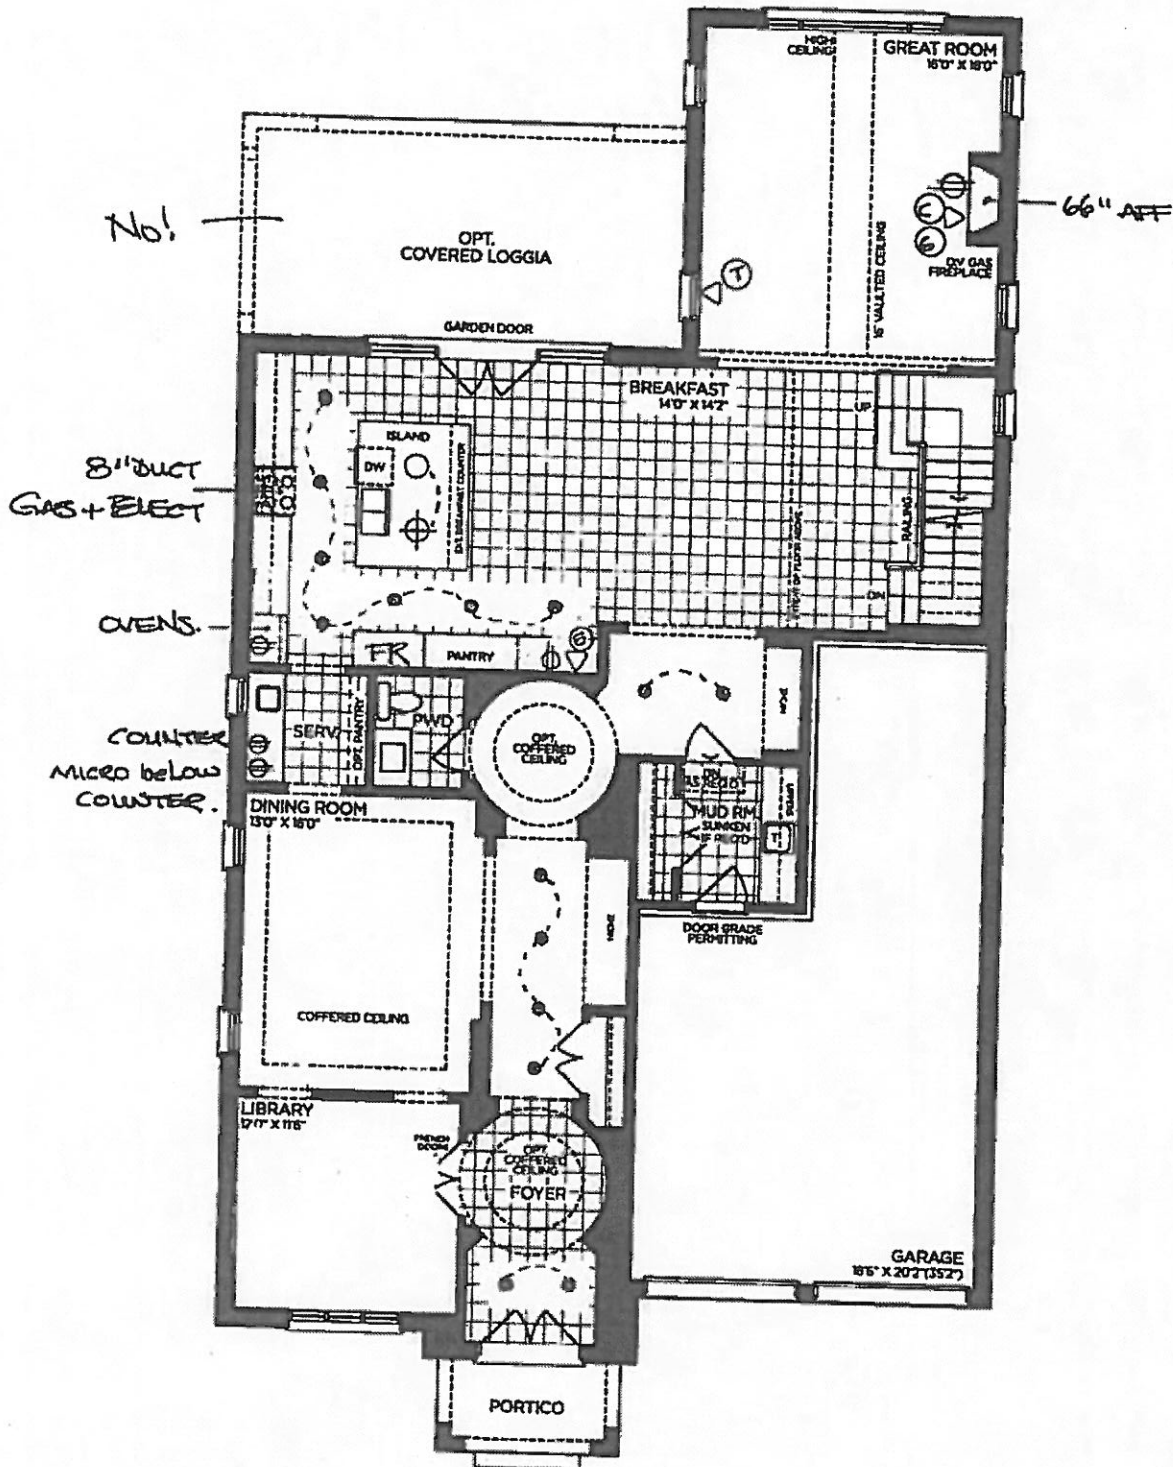

GROUND FLOOR | ELEV. A

VENDOR

PURCHASER

PURCHASER

GOLDPARK
WORTH MORE™

Prices, figures, illustrations, sizes, features and finishes are subject to change without notice. Areas and dimensions are approximate and actual usable floor space may vary from the stated area. Layout may be reverse of the unit purchased. E. & O.E. 5004

SCHEDULE 'F'




PV-109 *[Handwritten initials]*
 April 23 2020 *[Handwritten initials]*

The Beaumont

50' SERIES

→ Elevation A • 4,170 sq.ft.
 4,315 sq.ft. Opt. Elevator
 Elevation B • 4,165 sq.ft.
 4,315 sq.ft. Opt. Elevator
 Elevation C • 4,250 sq.ft.
 4,400 sq.ft. Opt. Elevator

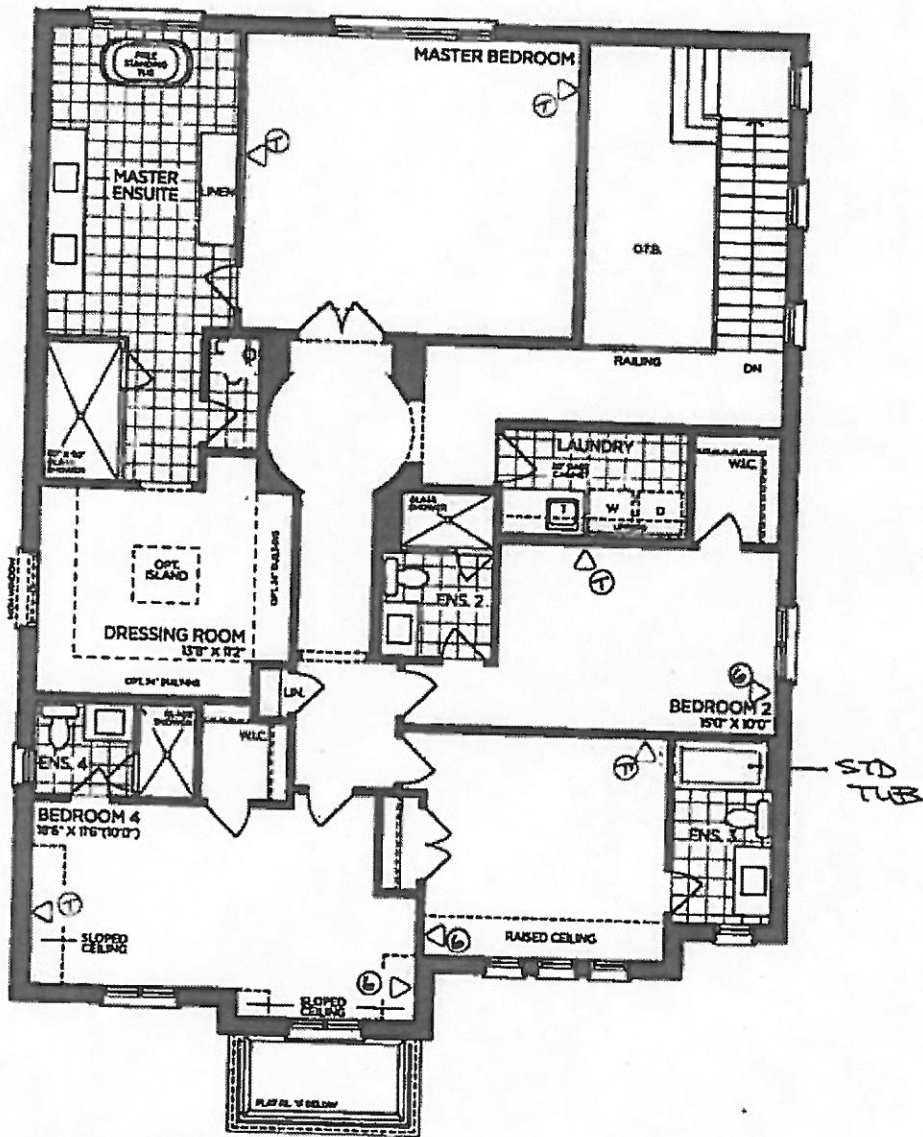

SECOND FLOOR | ELEV. A

VENDOR *[Signature]*
 PURCHASER *[Signature]*
 PURCHASER *[Signature]*

GOLDPARK
 WORTH MORE™

Prices, figures, illustrations, sizes, features and finishes are subject to change without notice. Areas and dimensions are approximate and actual usable floor space may vary from the stated area. Layout may be reverse of the unit purchased. E. & O.E. 5004


SCHEDULE 'F'



PV-109 ~~109~~
April 23 2020

The Beaumont 50' SERIES

Elevation A • 4,170 sq.ft.
4,315 sq.ft. Opt. Elevator
Elevation B • 4,165 sq.ft.
4,315 sq.ft. Opt. Elevator
Elevation C • 4,250 sq.ft.
4,400 sq.ft. Opt. Elevator

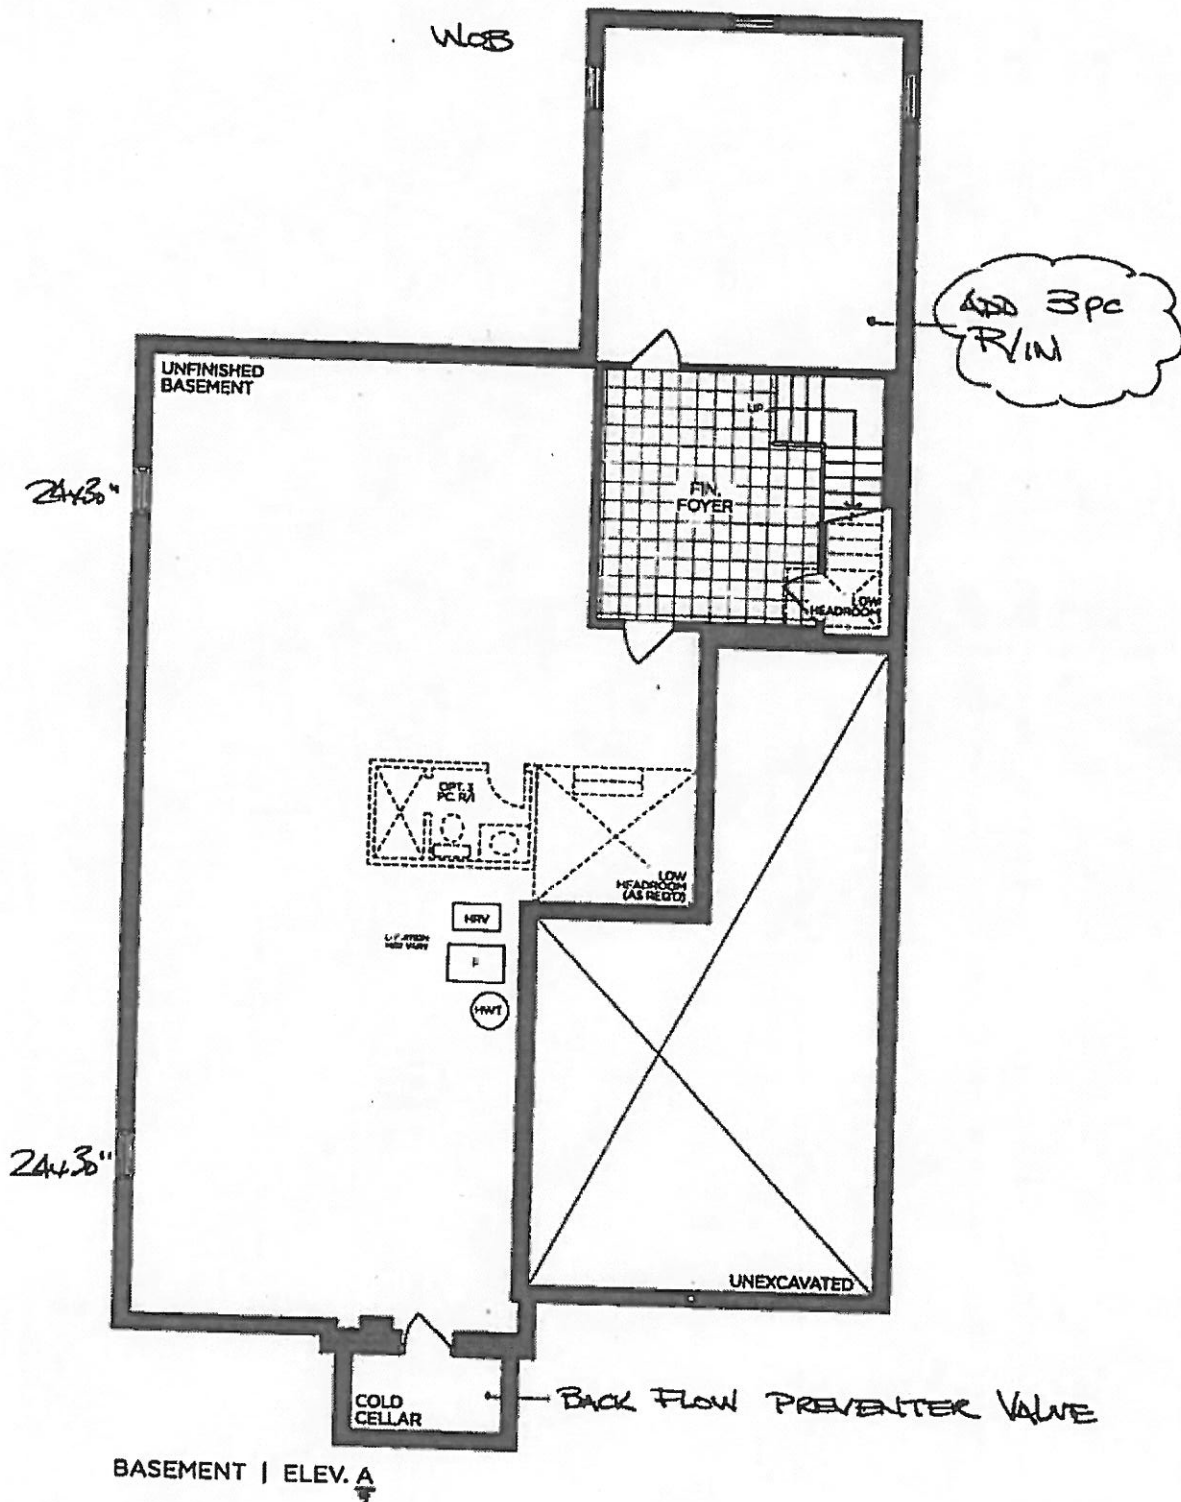

BASEMENT | ELEV. A

VENDOR

PURCHASER

PURCHASER

<i>[Signature]</i>
<i>[Signature]</i>

GOLDPARK
WORTH MORE™

Prices, figures, illustrations, sizes, features and finishes are subject to change without notice. Areas and dimensions are approximate and actual usable floor space may vary from the stated area. Layout may be reverse of the unit purchased. E. & O.E. 5004